


CURVE N1	
Δ	= 15° 06' 06.4"
D	= 1° 31' 31"
R	= 3756.70'
T	= 497.97'
L	= 990.17'
E	= 32.86'

STA N 6178+10.00 (MM 117.009)
 END RYEGATE IM 091-2(80)
 BEGIN APPROACH

STA N 6179+60.00 (MM 117.038)
 END APPROACH

HAND SCALING PHOTO
 (NB SC AT STA N 6177+50.0)

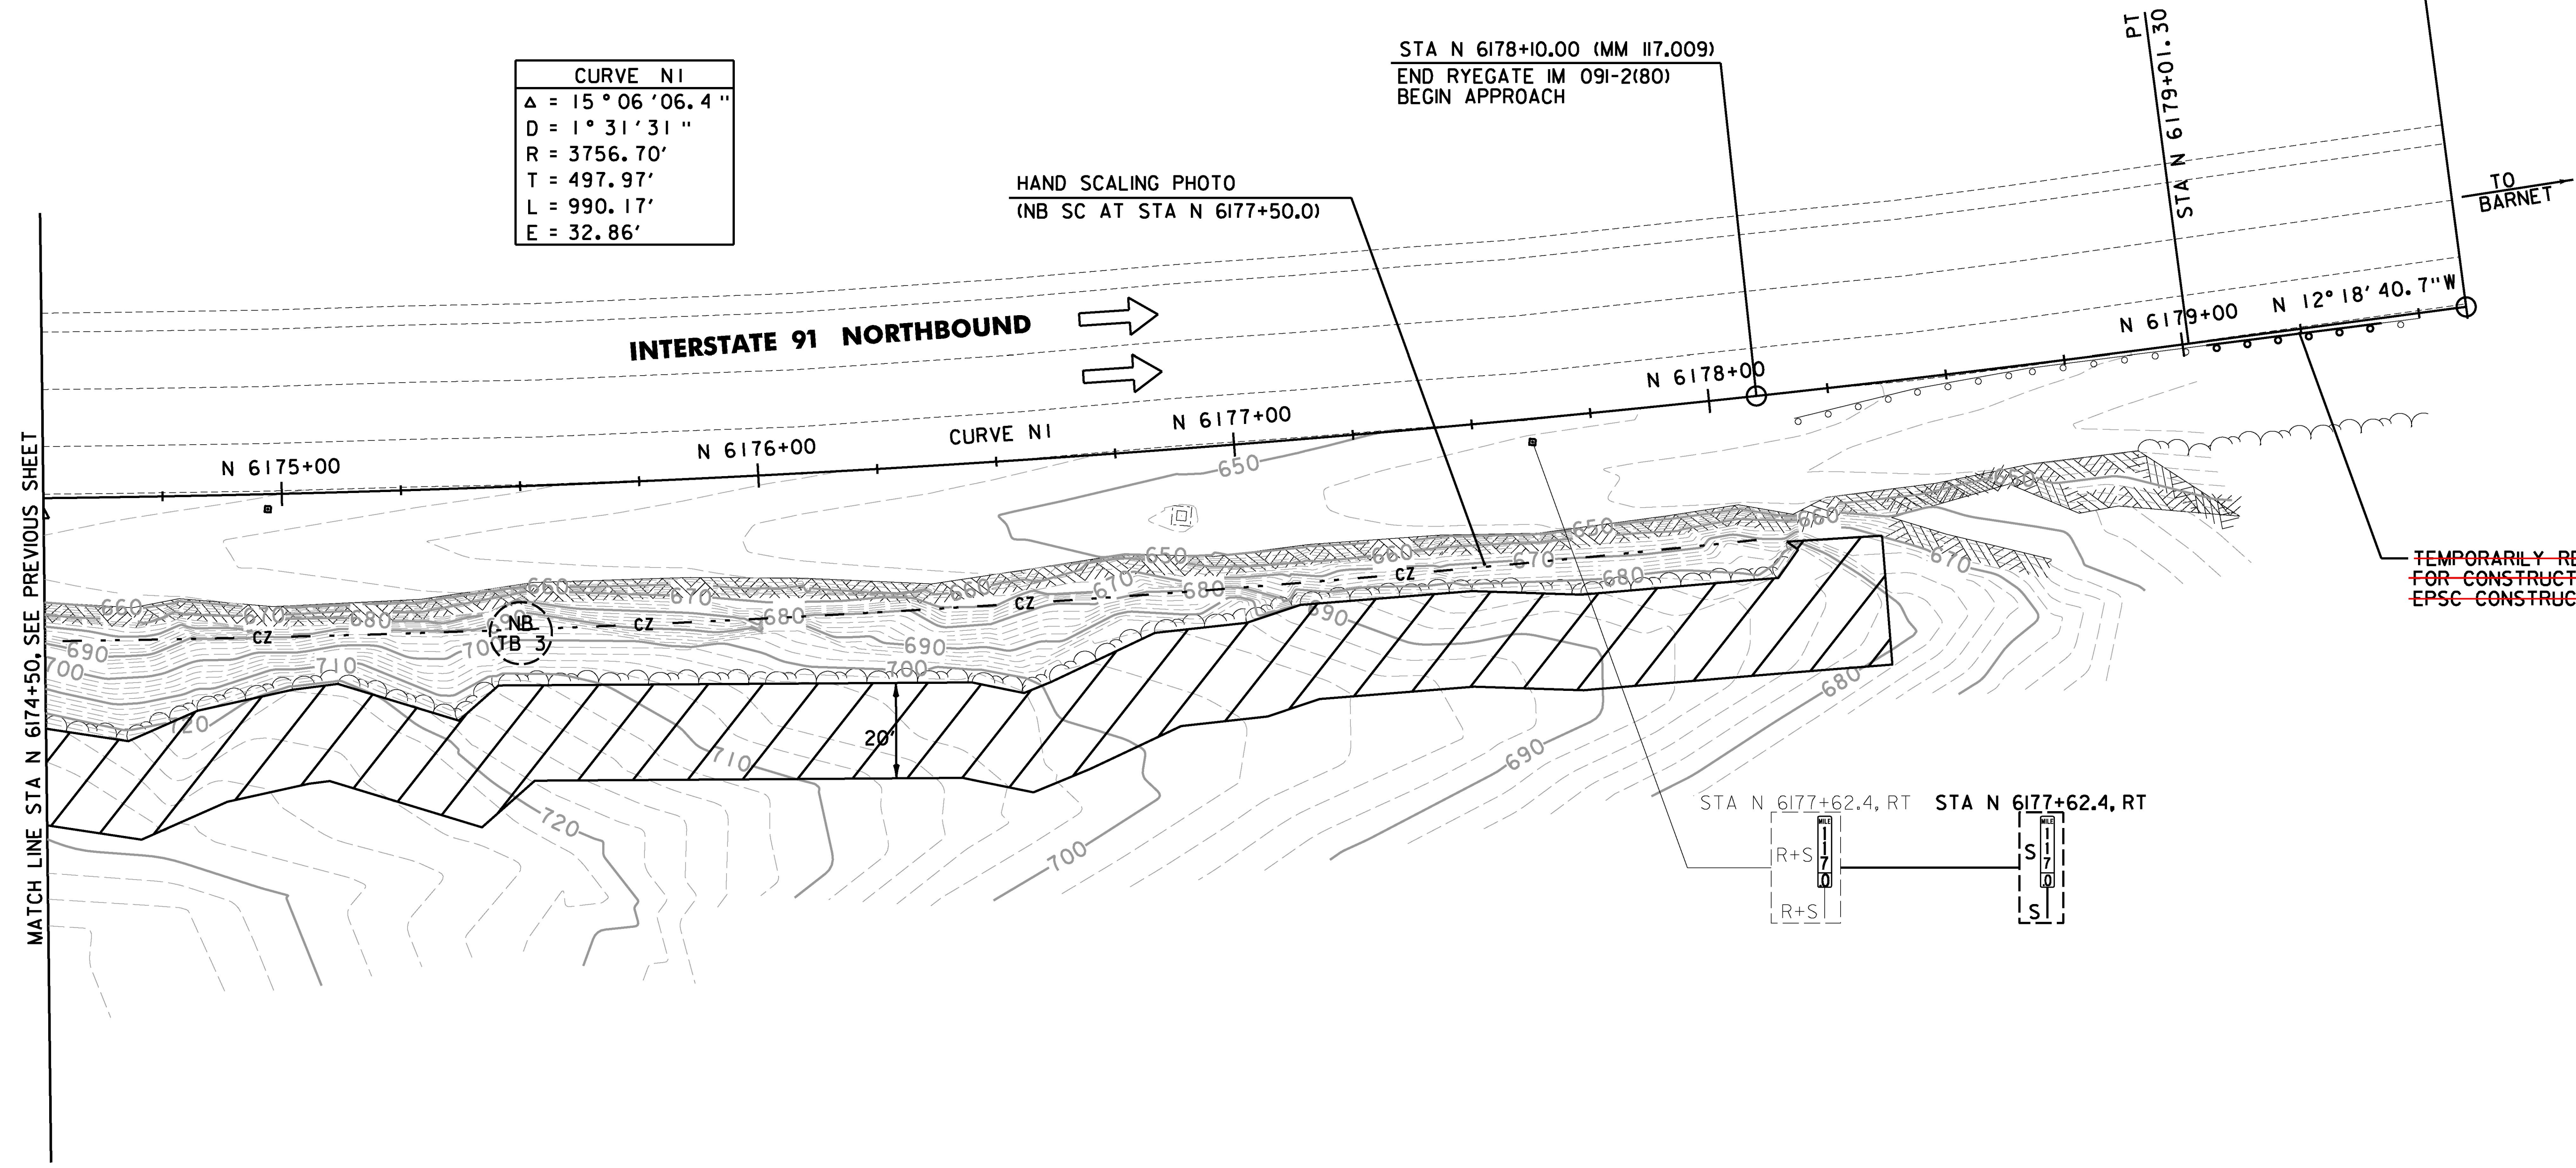

TEMPORARILY REMOVE GUARDRAIL
 FOR CONSTRUCTION ACCESS; SEE
 EPSC CONSTRUCTION PLAN SHEETS

MATCH LINE STA N 6174+50. SEE PREVIOUS SHEET

ROCK CUT TREATMENT LOCATION	PHOTO REFERENCE NUMBER				
	7	8	9	10	
NB TB3	X	X	X		
NB SC @ STA N 6177+50.0				X	

NOTE: REFER TO CONTRACT DOCUMENTS FOR PHOTOGRAPHS

LEGEND

- TRIM BLASTING LOCATION
- DIRECTION OF TRAFFIC
- CLEARING AND GRUBBING (BY THE ACRE)

SIGN LEGEND

- R = REMOVE
- S = SALVAGE
- N = NEW
- RET = RETAIN
- B-B = BACK TO BACK
- EXISTING = - - - - -
- NEW = _____

- SPECIAL PROVISION (HAND SCALING)
 STA N 6174+50.0 - STA N 6178+10.0 RT
- REMOVAL OF EXISTING DELINEATOR
 STA N 6174+97.0 RT (WHITE)
- DELINEATOR WITH STEEL POST
 STA N 6174+97.0 RT (WHITE)
- SPECIAL PROVISION (TRIM BLASTING)
 NB TB3 - STA N 6175+49.0 RT

- REMOVING SIGNS
 STA N 6177+62.4 RT
- ERECTING SALVAGED SIGNS
 STA N 6177+62.4 RT
- SETTING SALVAGED POST
 STA N 6177+62.4 RT
- REMOVE AND RESET GUARDRAIL
 STA N 6179+05.0 - STA N 6179+42.5 RT



PROJECT NAME: RYEGATE
 PROJECT NUMBER: IM 091-2(80)
 FILE NAME: z13a368bdr.dgn
 PROJECT LEADER: D. GOZALKOWSKI
 DESIGNED BY: J. OLSEN
 PLAN SHEET 2

PLOT DATE: 3/30/2017
 DRAWN BY: J. HEALD
 CHECKED BY: J. SHIELDS
 SHEET 13 OF 61

FILE NAME: W:\P\c\ess\213a368\CONSTRUCTION\IM091-2(80)\Highway\413a368bdr.dgn
 DATE/TIME: 3/30/2017 10:53:23
 USER: jolsen