


FILE NAME = W:\P\c\ess\ANY\KA\29741\CADD\ASTN\13a368\Consultants\Highway\13a368eccd.dgn
 DATE/TIME = 3/30/2017
 USER = 5323



NOT TO SCALE

| | |
|--------------------------------|------------------------|
| PROJECT NAME: RYEGATE | PLOT DATE: 3/30/2017 |
| PROJECT NUMBER: IM 091-2(80) | DRAWN BY: J. HEALD |
| FILE NAME: z13a368ecd.dgn | DESIGNED BY: J. OLSEN |
| PROJECT LEADER: D. GOZALKOWSKI | CHECKED BY: J. SHIELDS |
| EPSC DETAILS SHEET 3 | SHEET 35 OF 61 |

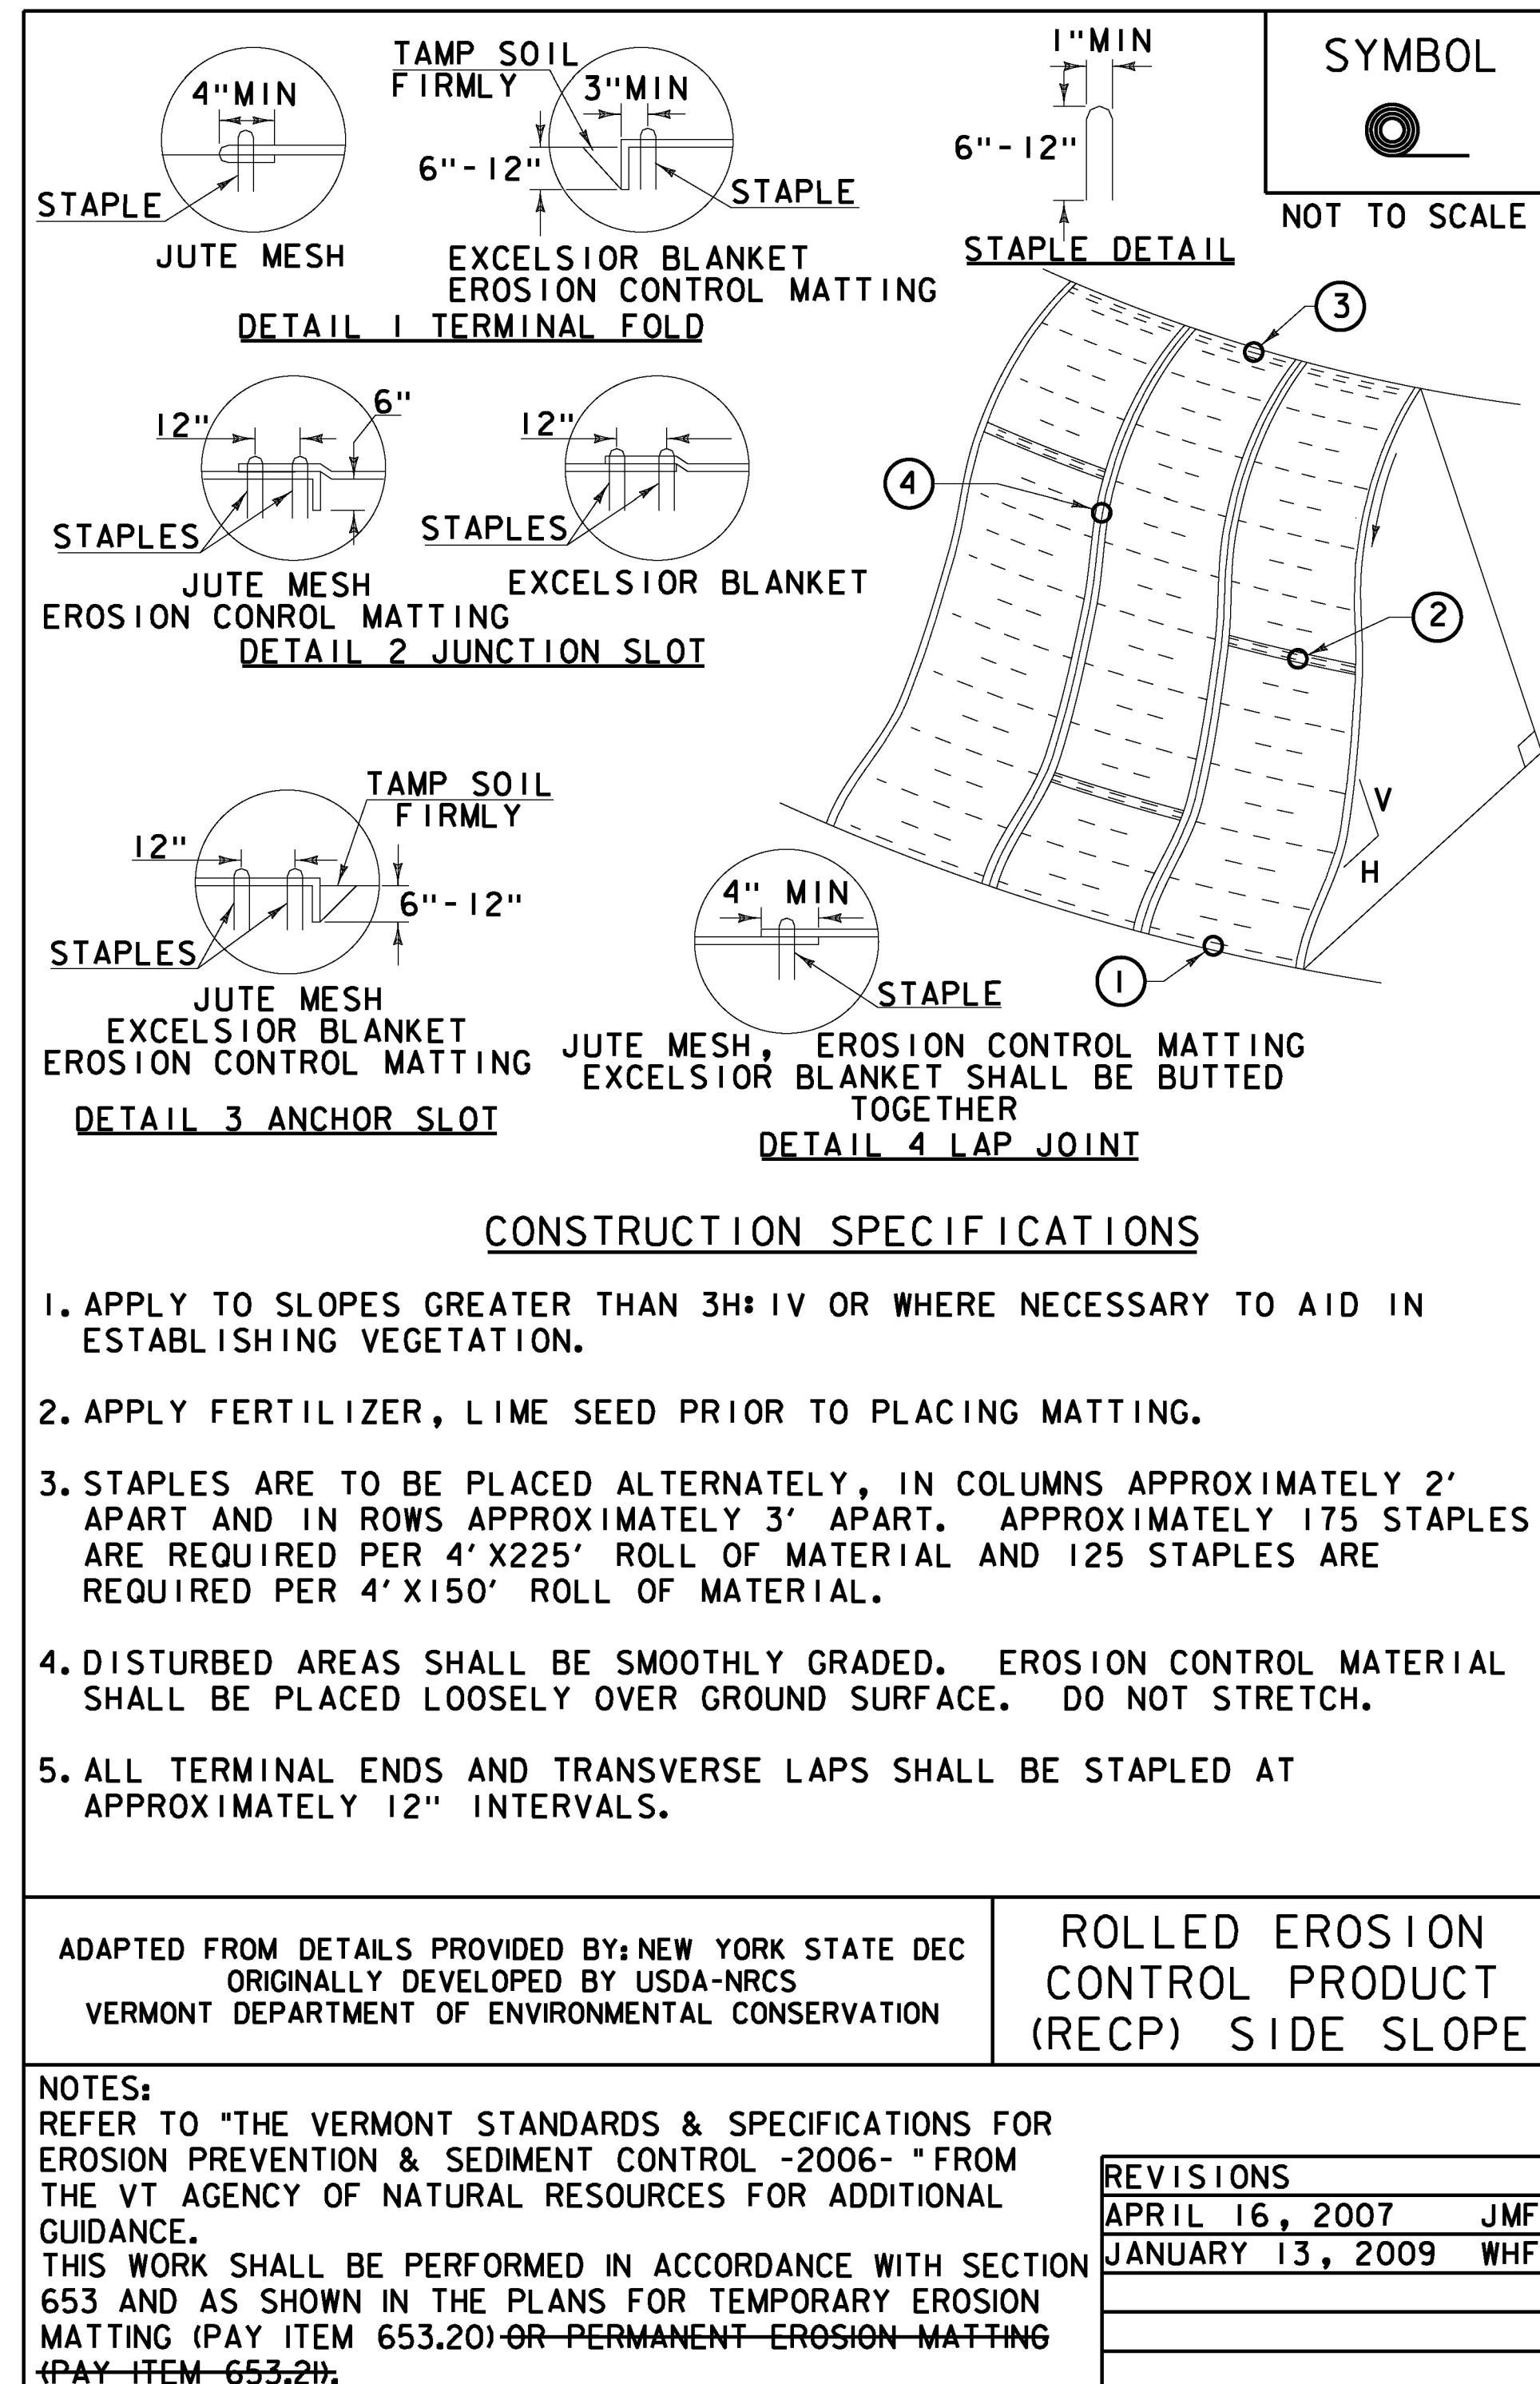