



FILE NAME = W:\P\c\users\jheald\My Documents\Highway\13a368\13a368.dgn
 DATE/TIME = 3/30/2017
 USER = JHEALD

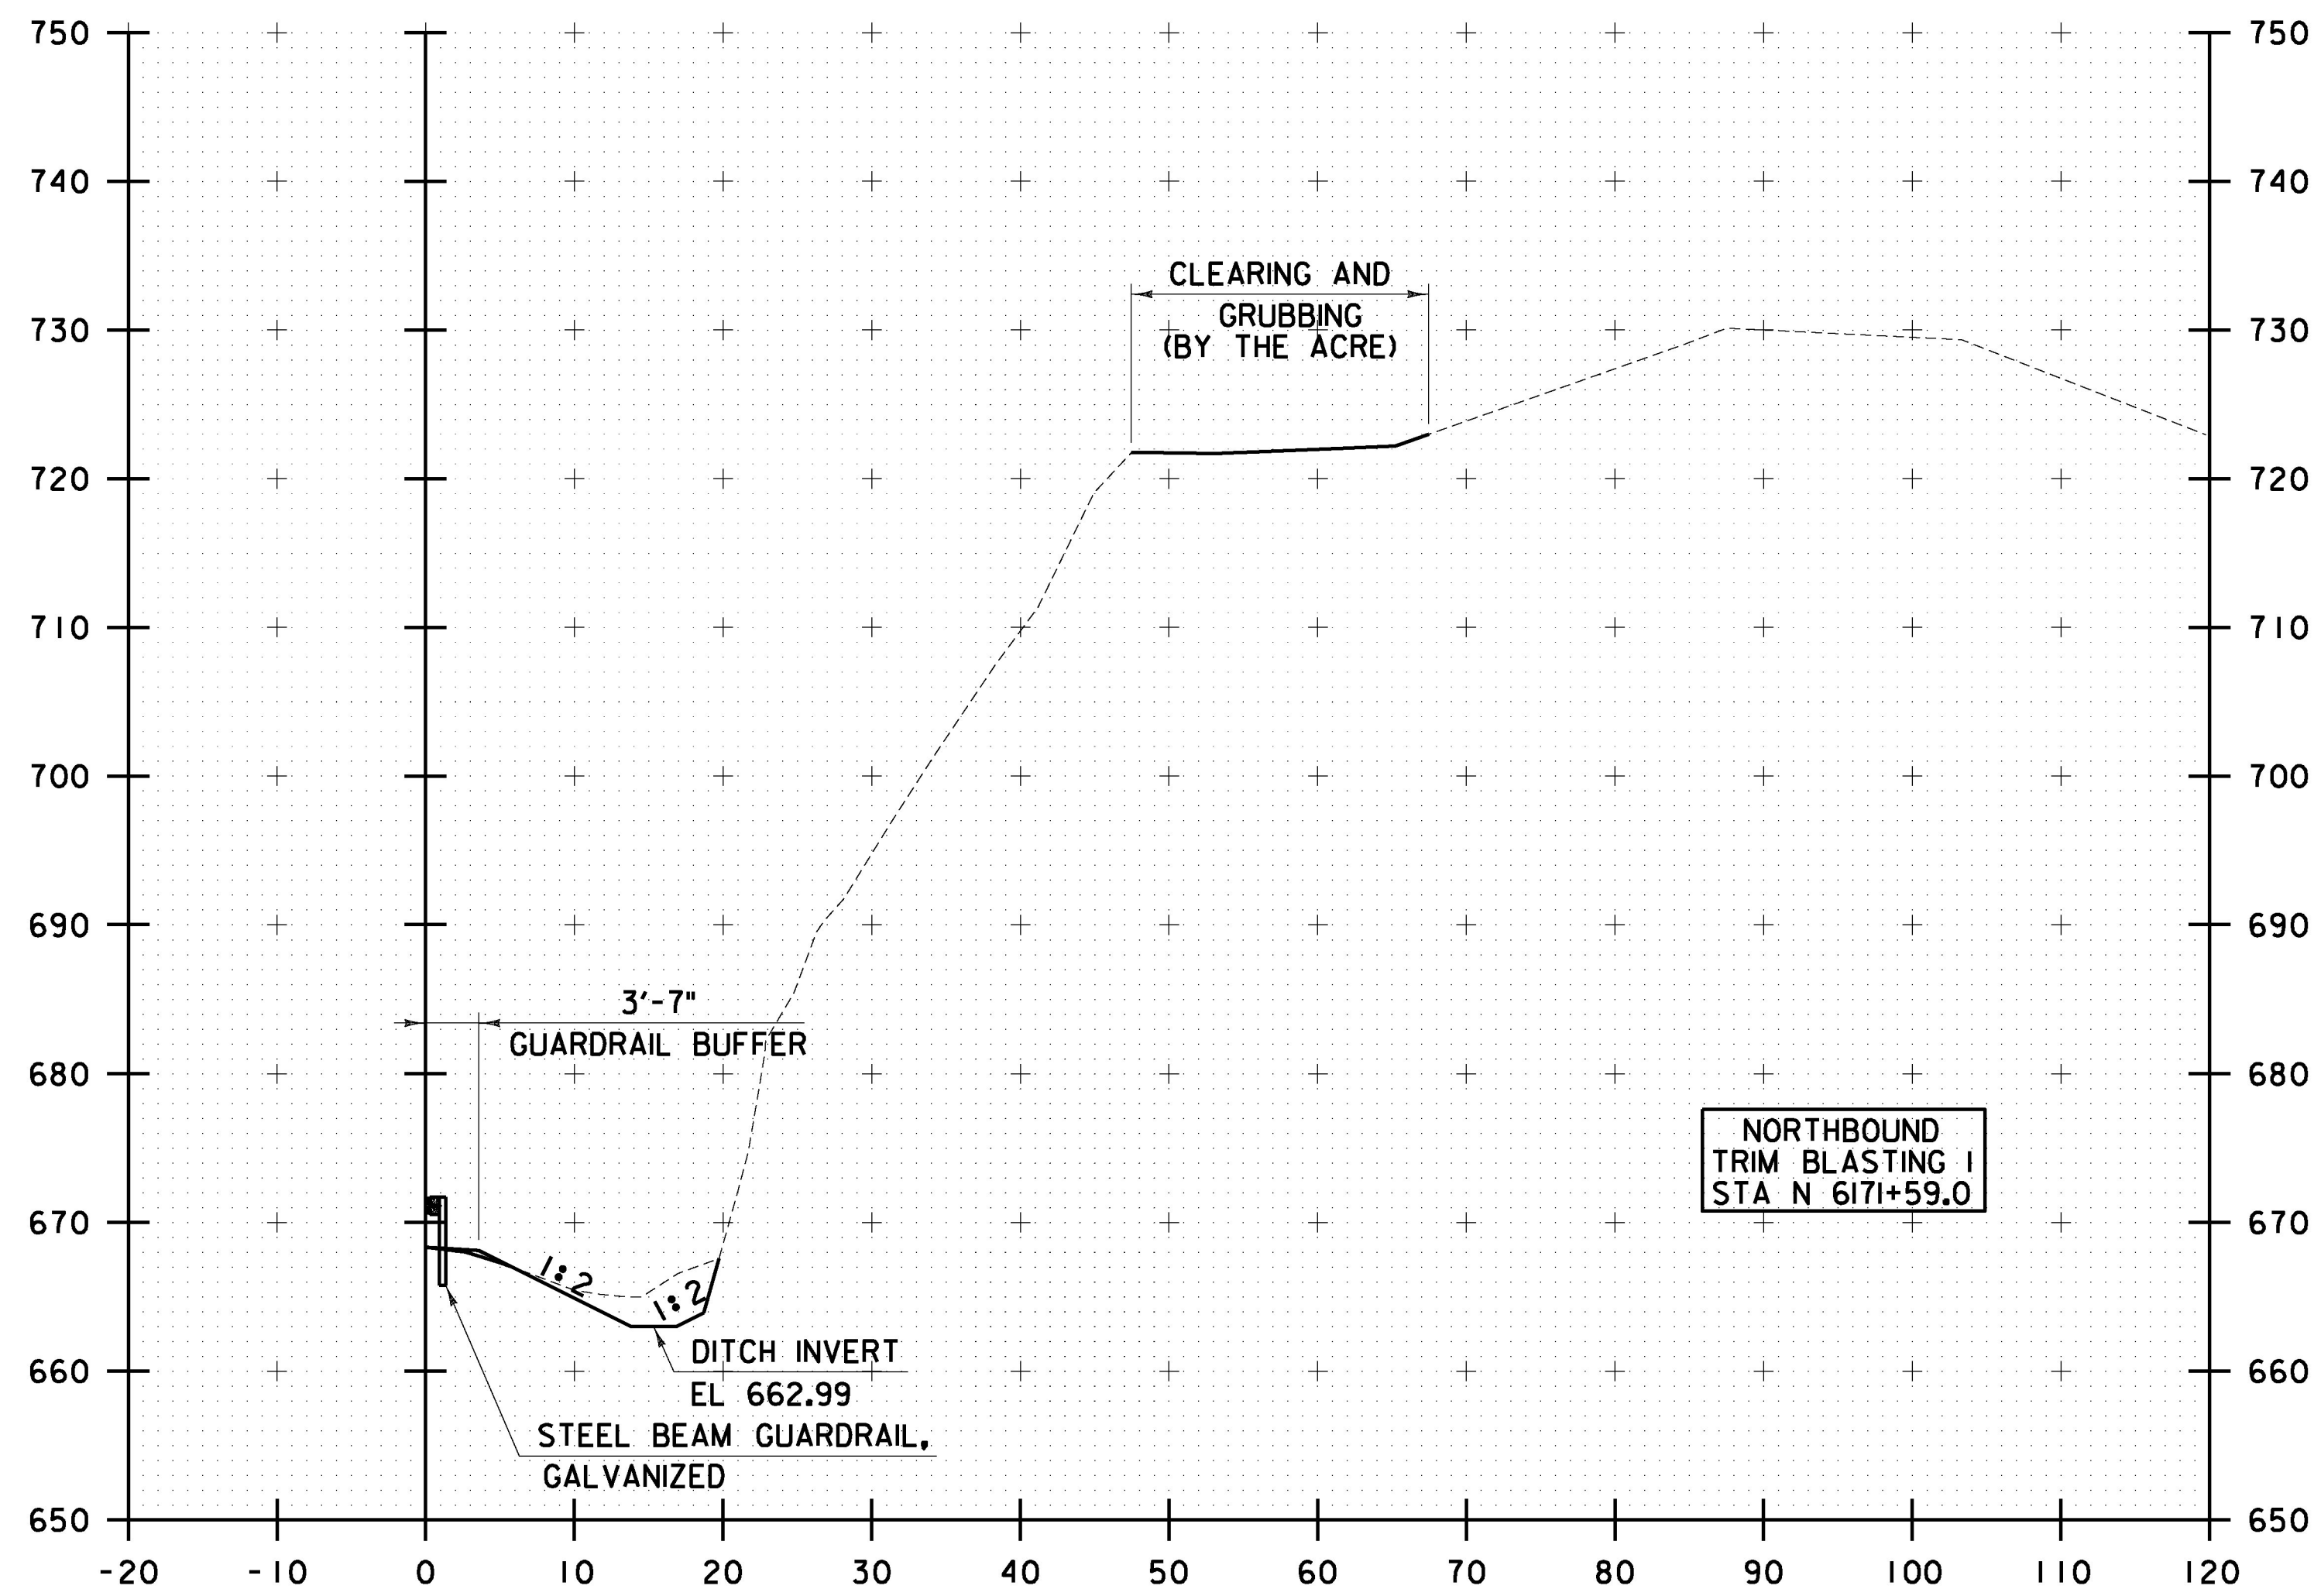


N 6171+50

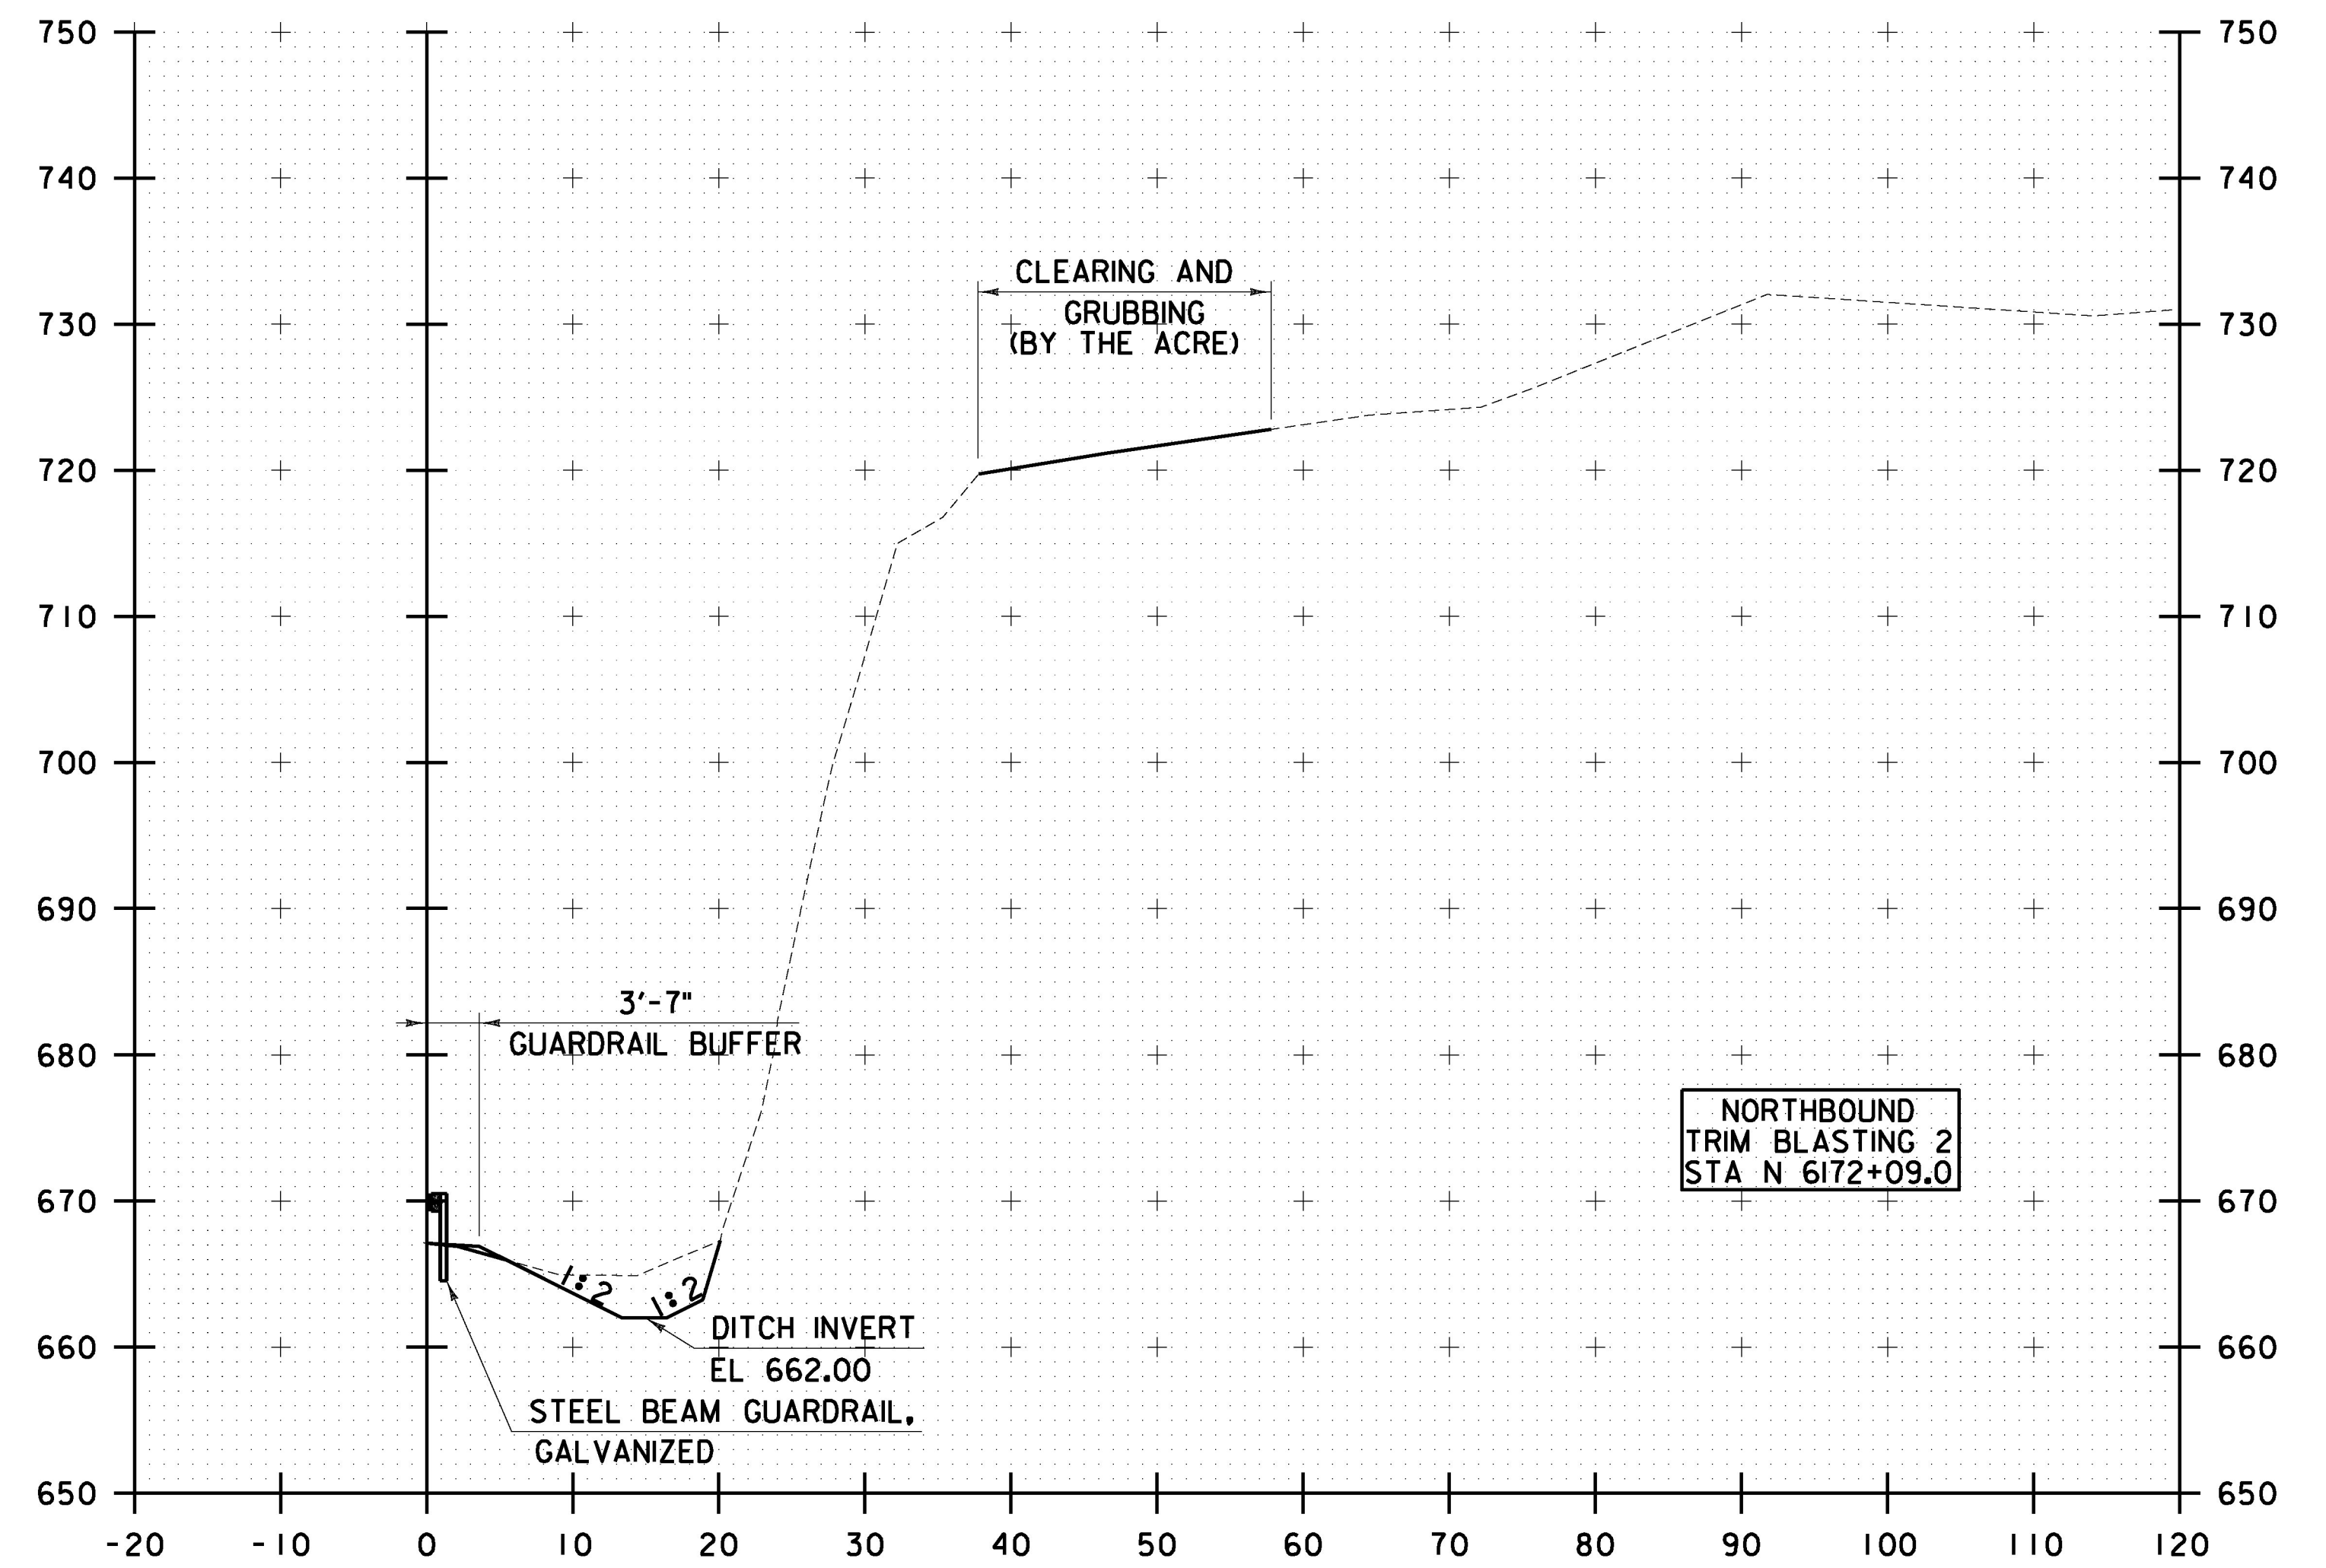

N 6172+00

STA. N 6171+50 TO STA. N 6172+00

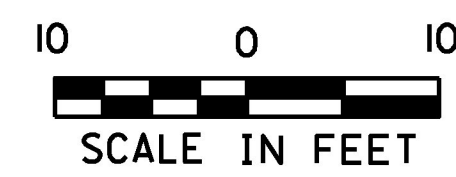

PROJECT NAME: RYEGATE	
PROJECT NUMBER: IM 091-2(80)	
FILE NAME: z13a368xsc.dgn	PLOT DATE: 3/30/2017
PROJECT LEADER: D. GOZALKOWSKI	DRAWN BY: J. HEALD
DESIGNED BY: J. OLSEN	CHECKED BY: J. SHIELDS
CROSS SECTION SHEET 3	SHEET 38 OF 61