



FILE NAME = W:\Projects\2017\IM 091-2(80)\STN\13a368\CrossSection\Highway\13a368.dgn
 DATE/TIME = 3/30/2017
 USER = 5323

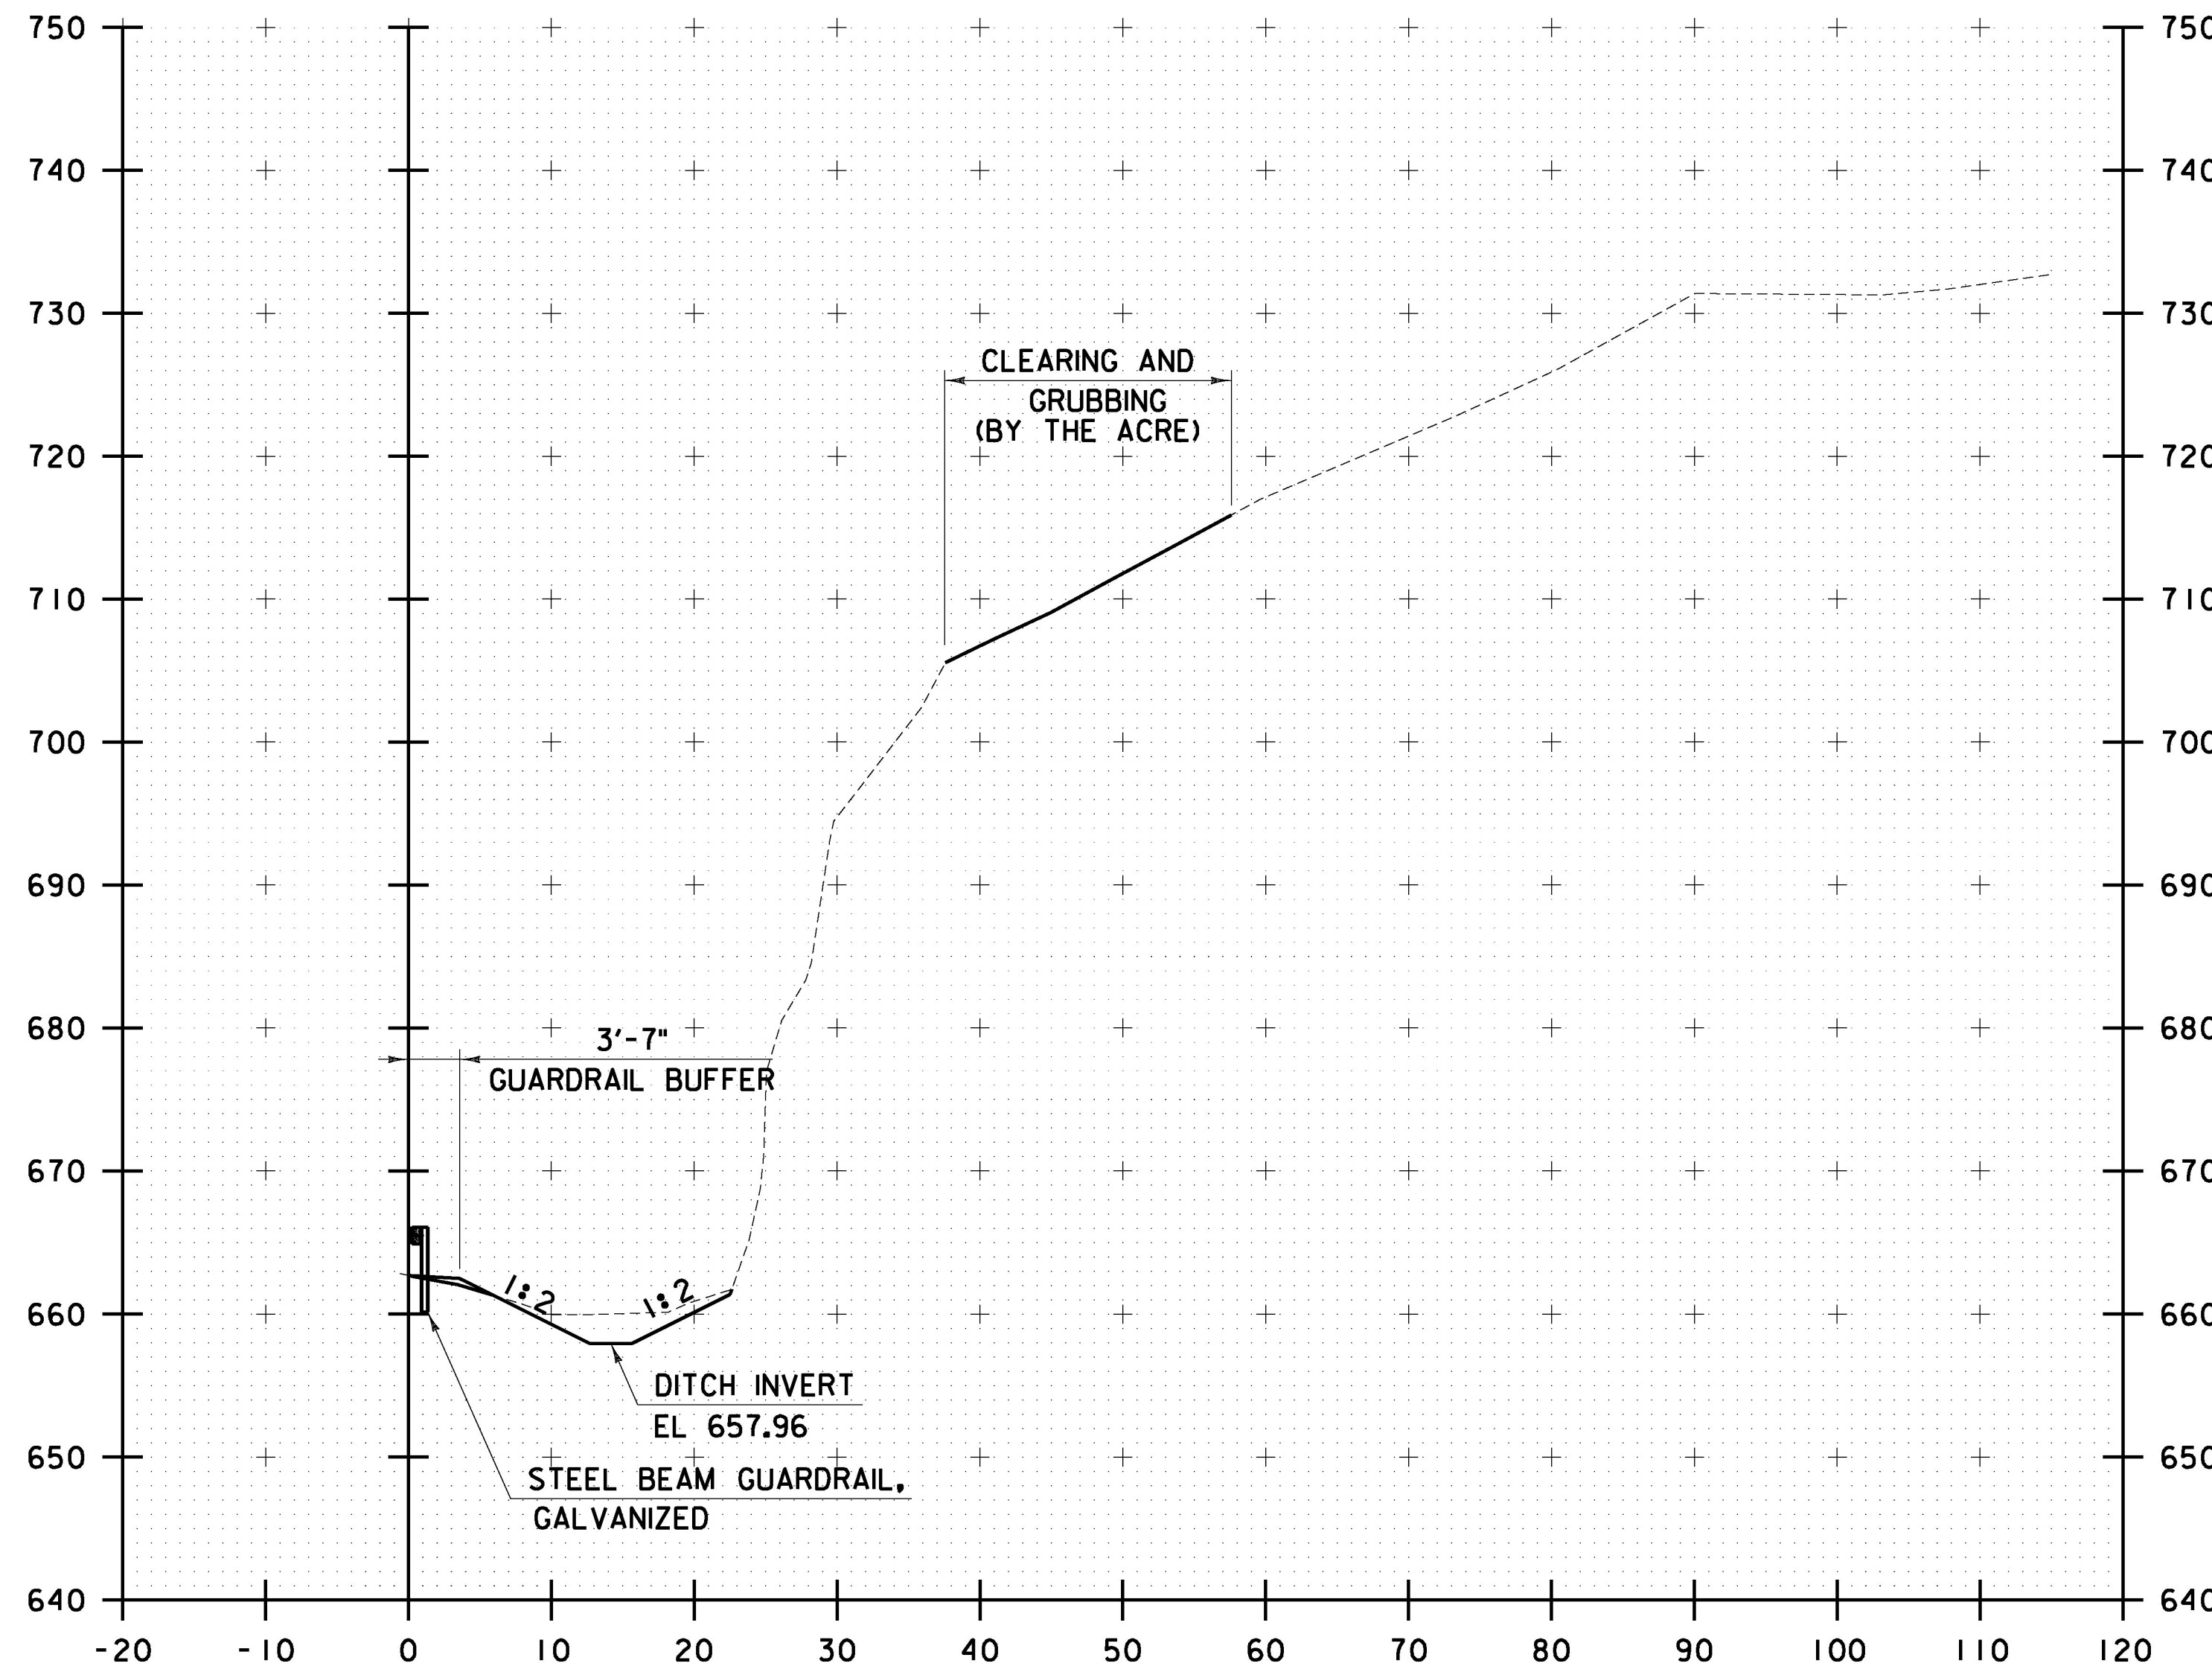


N 6173+50

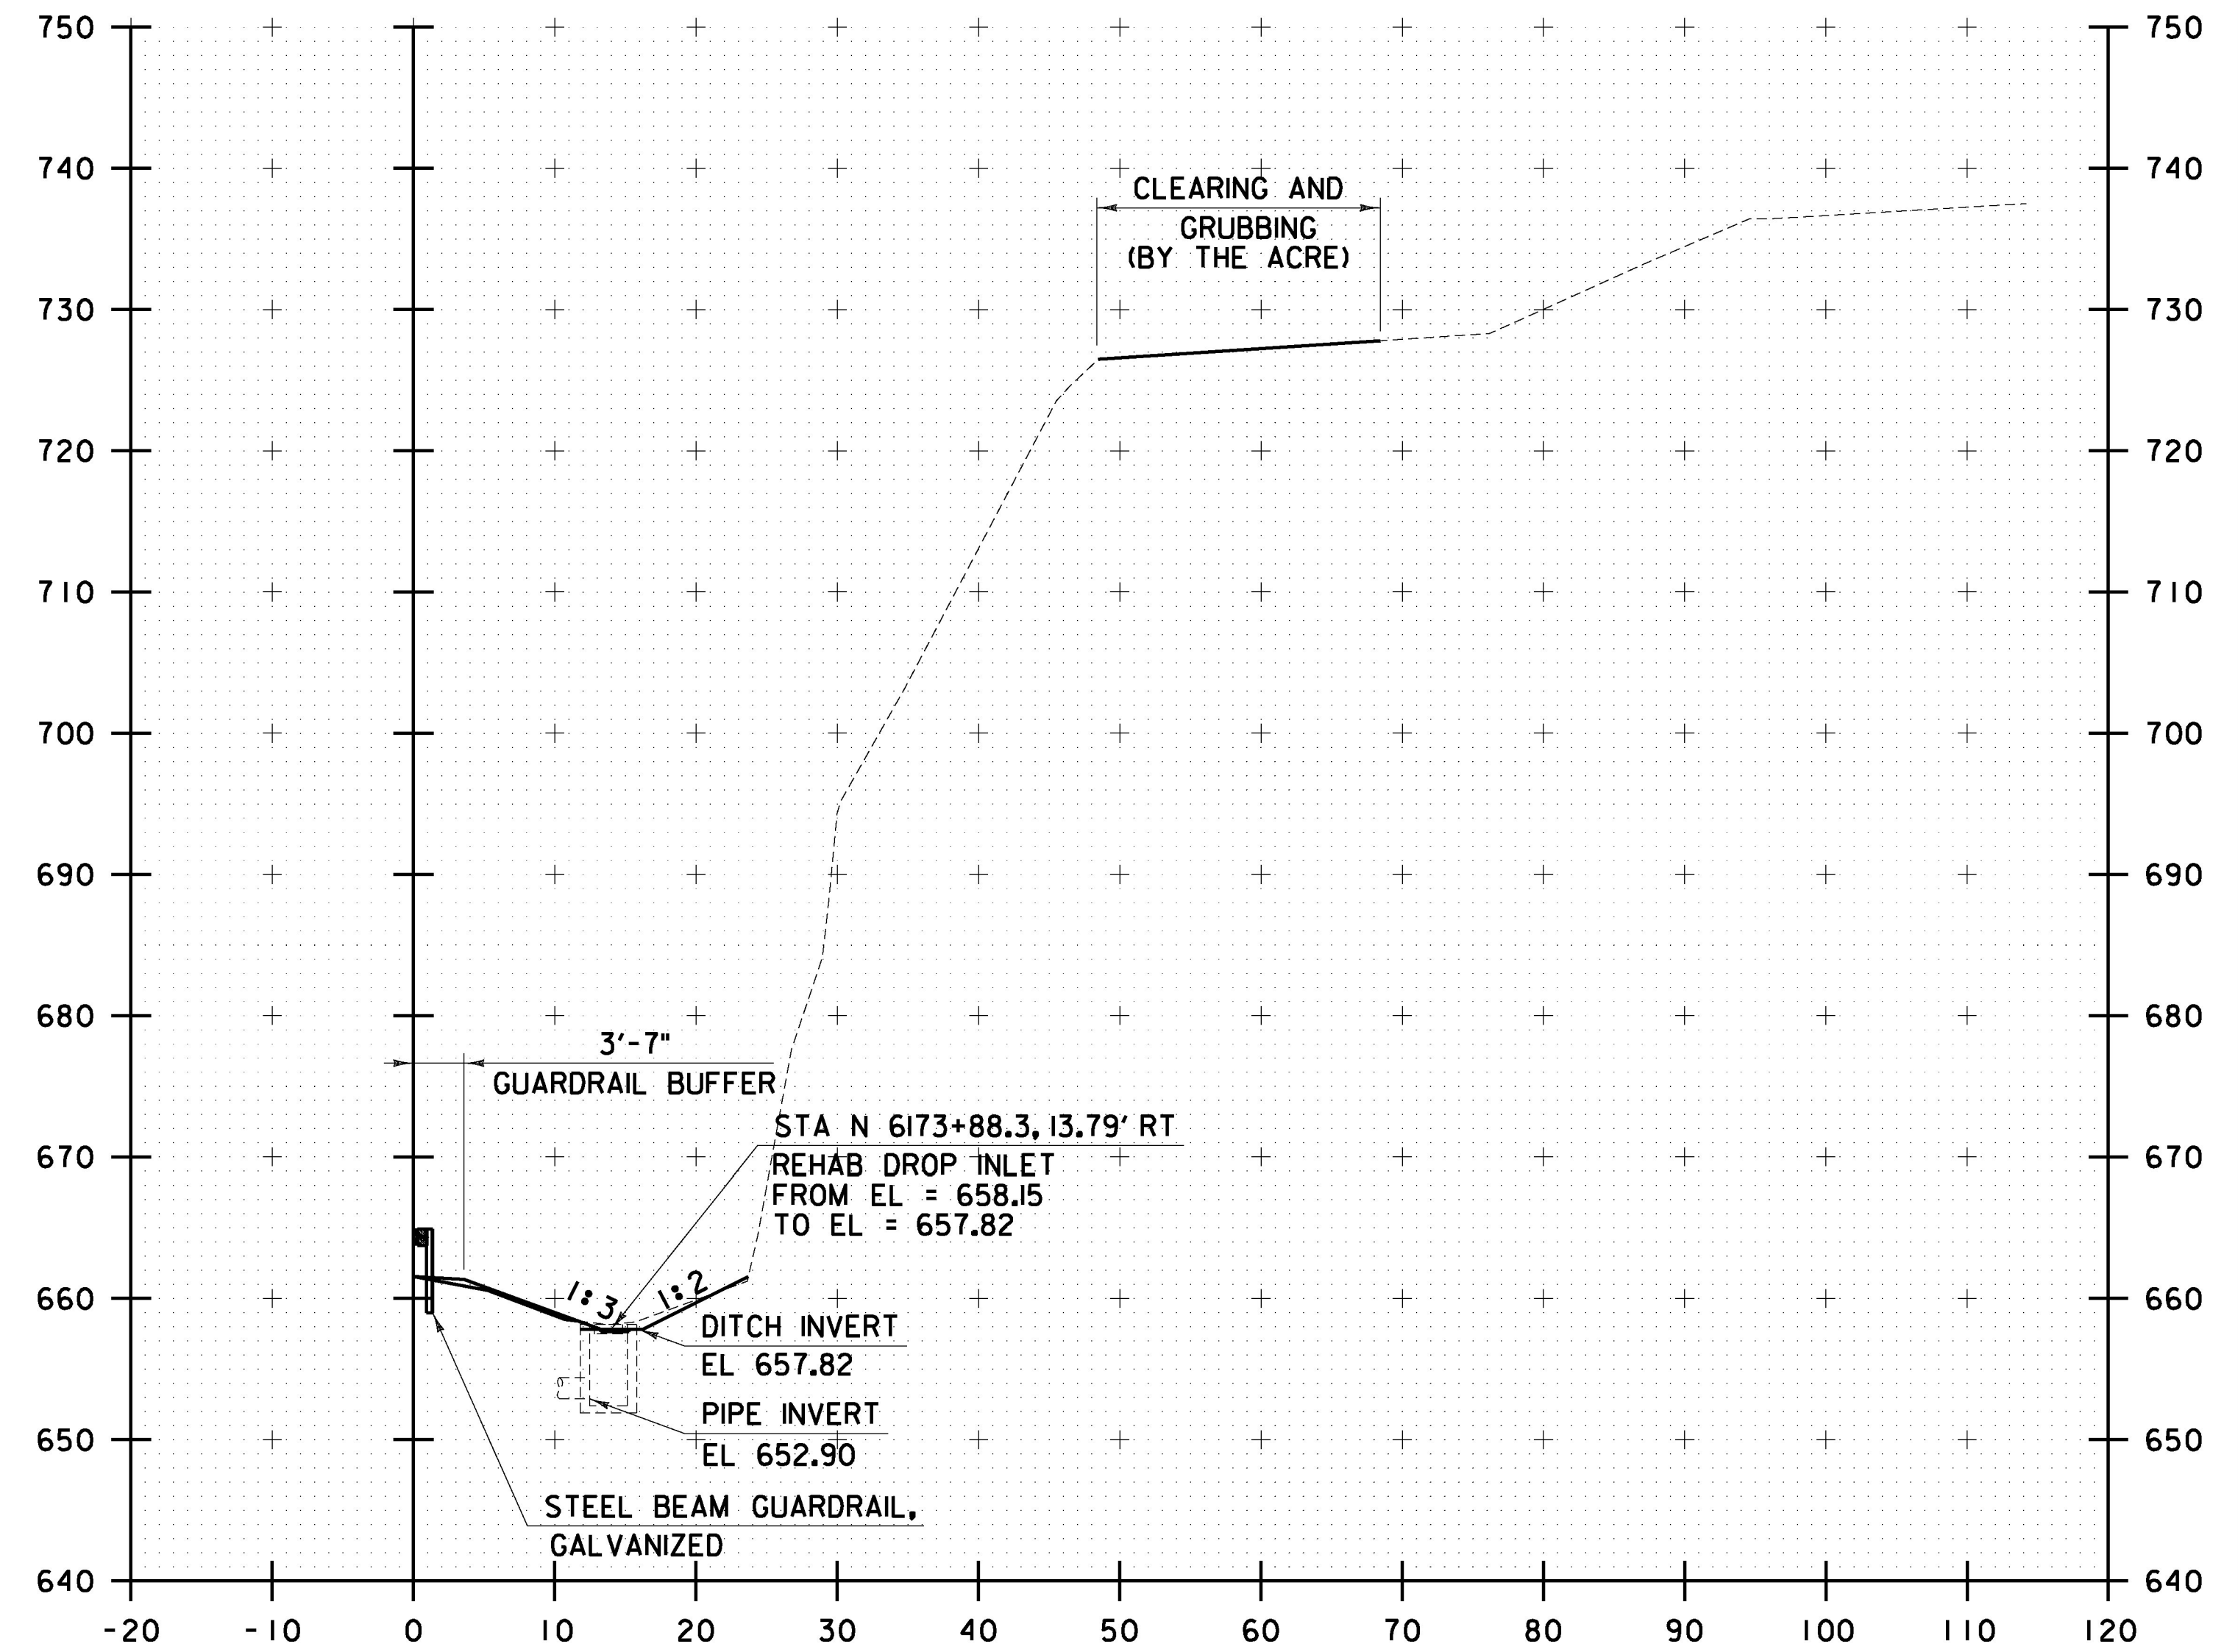

N 6173+88.3

STA. N 6173+50 TO STA. N 6173+88.3

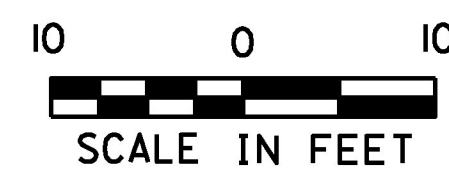

PROJECT NAME: RYEGATE	
PROJECT NUMBER: IM 091-2(80)	
FILE NAME: z13a368xsc.dgn	PLOT DATE: 3/30/2017
PROJECT LEADER: D. GOZALKOWSKI	DRAWN BY: J. HEALD
DESIGNED BY: J. OLSEN	CHECKED BY: J. SHIELDS
CROSS SECTION SHEET 5	SHEET 40 OF 61