



FILE NAME = W:\Projects\091-2(80)\091-2(80)\091-2(80)\091-2(80)\Highway\13a368xsc.dgn  
 DATE/TIME = 3/30/2017  
 USER = 5323

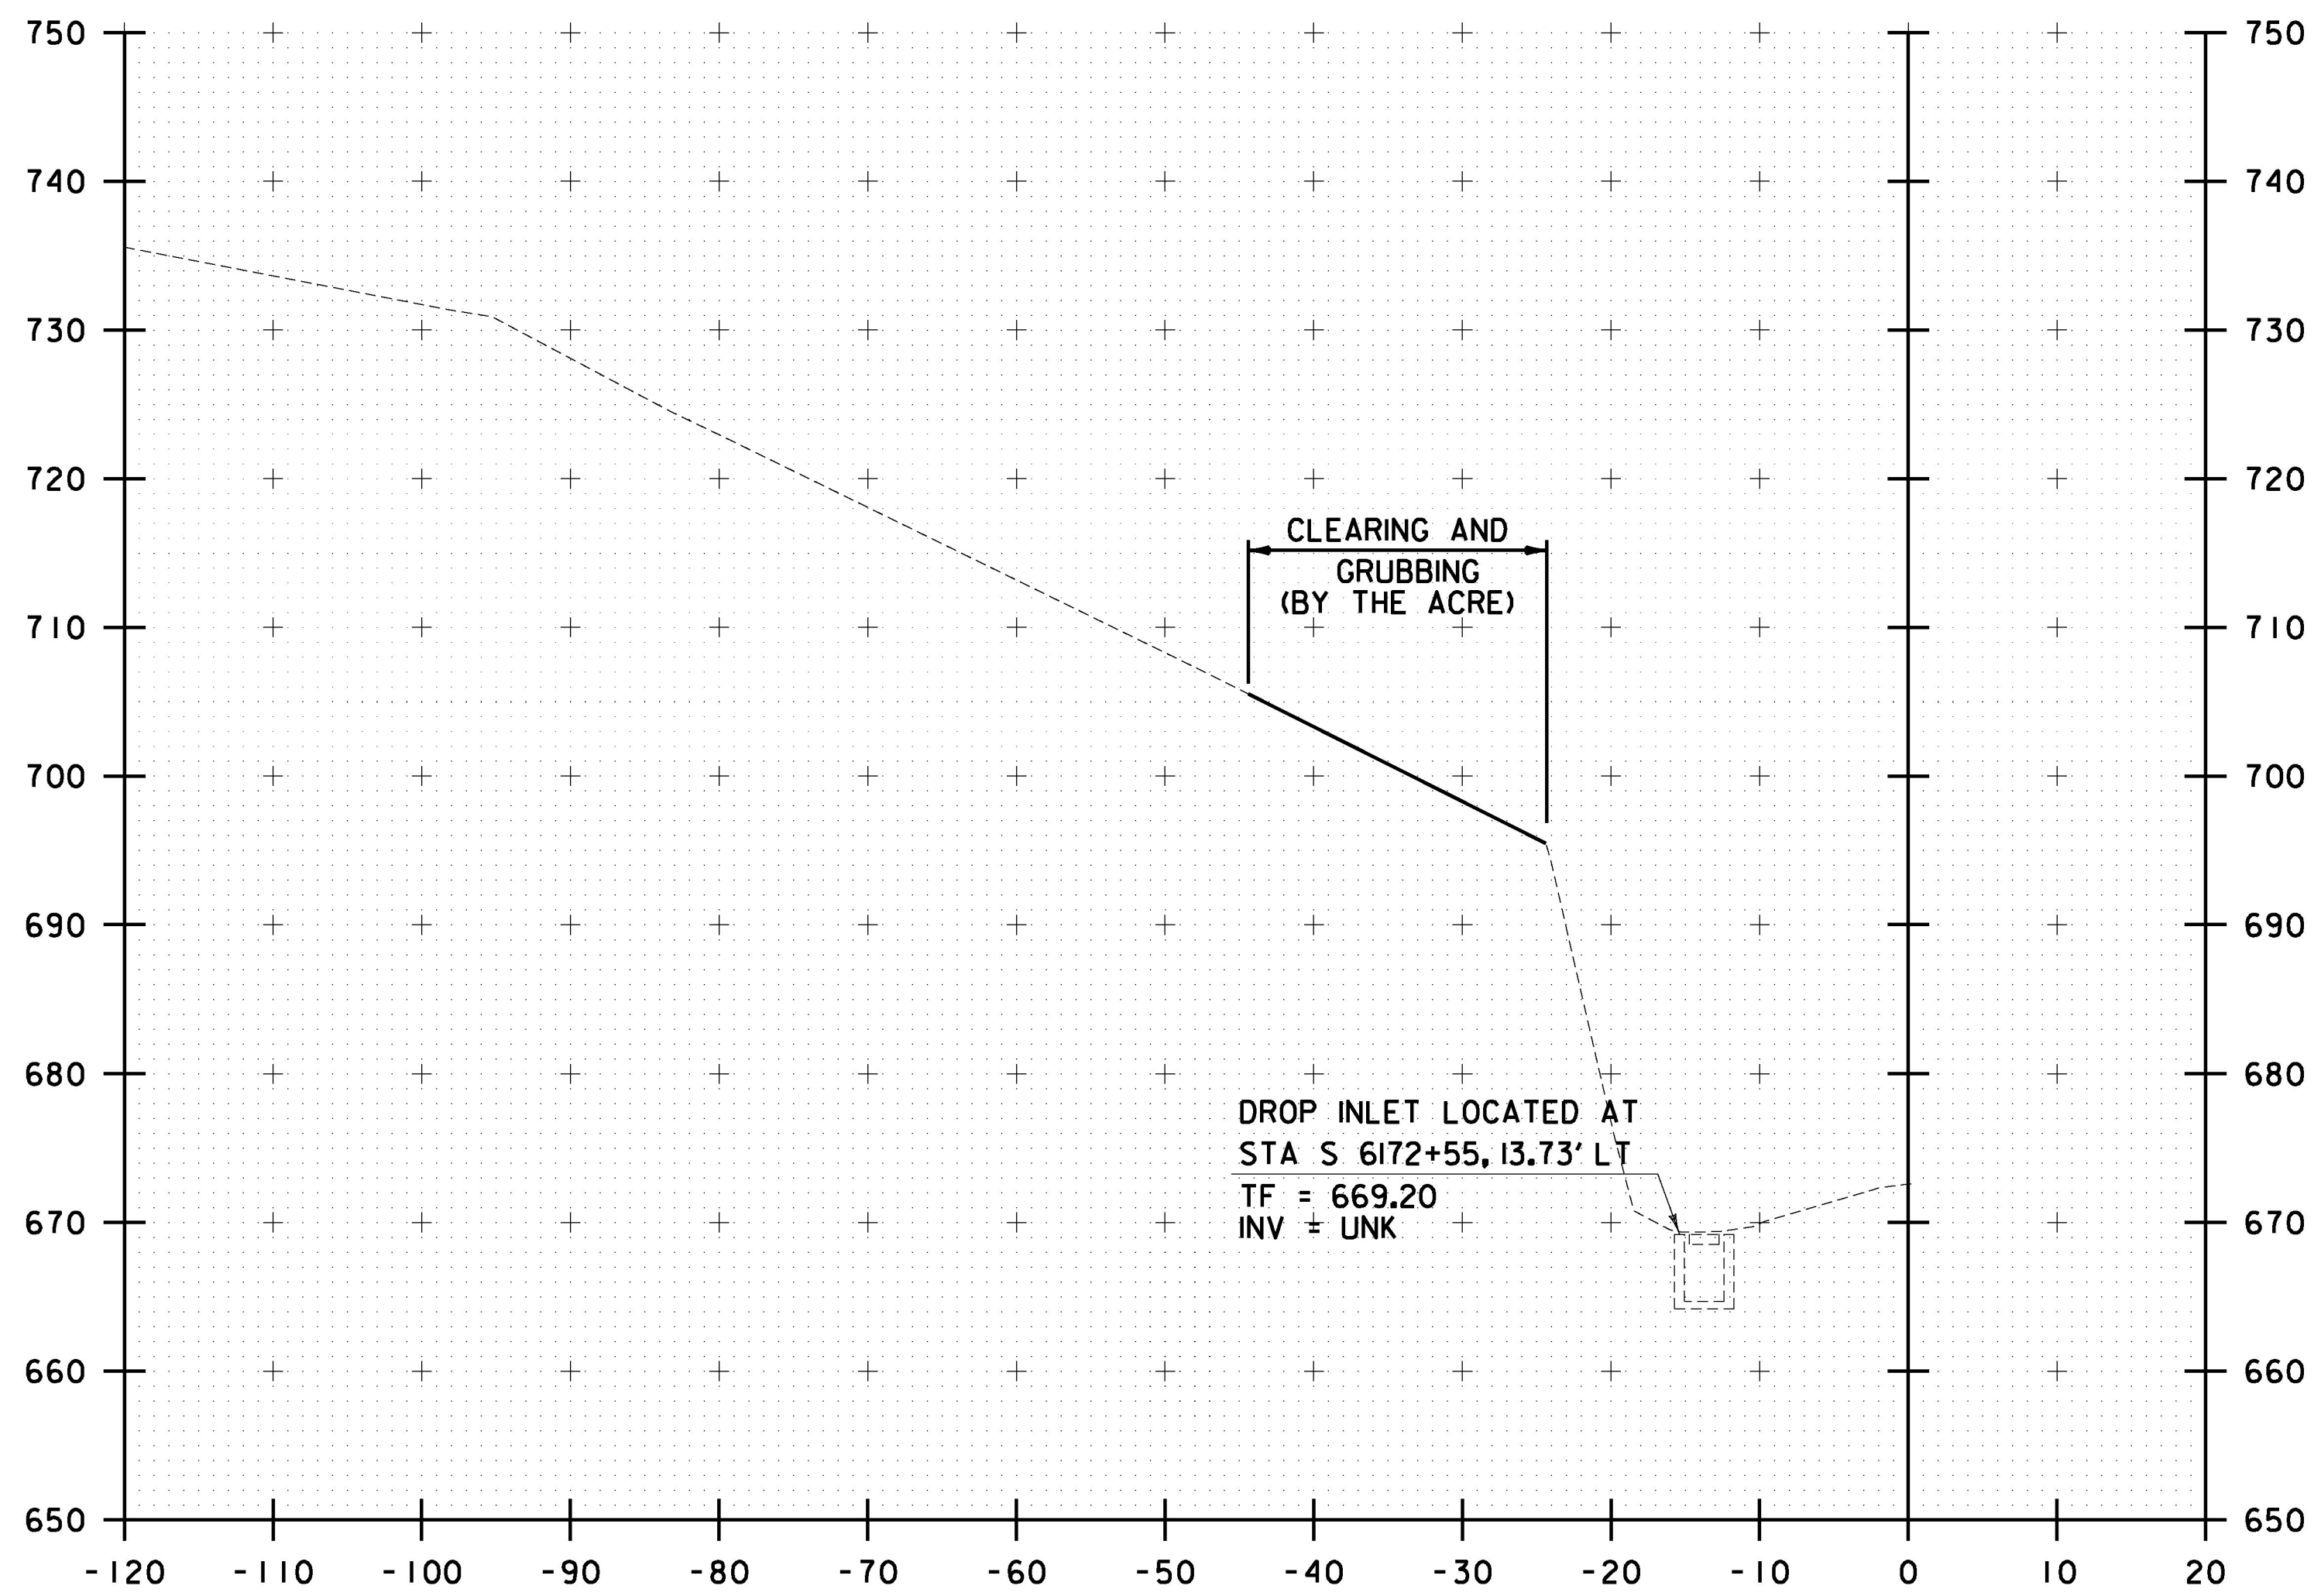


S 6172+50

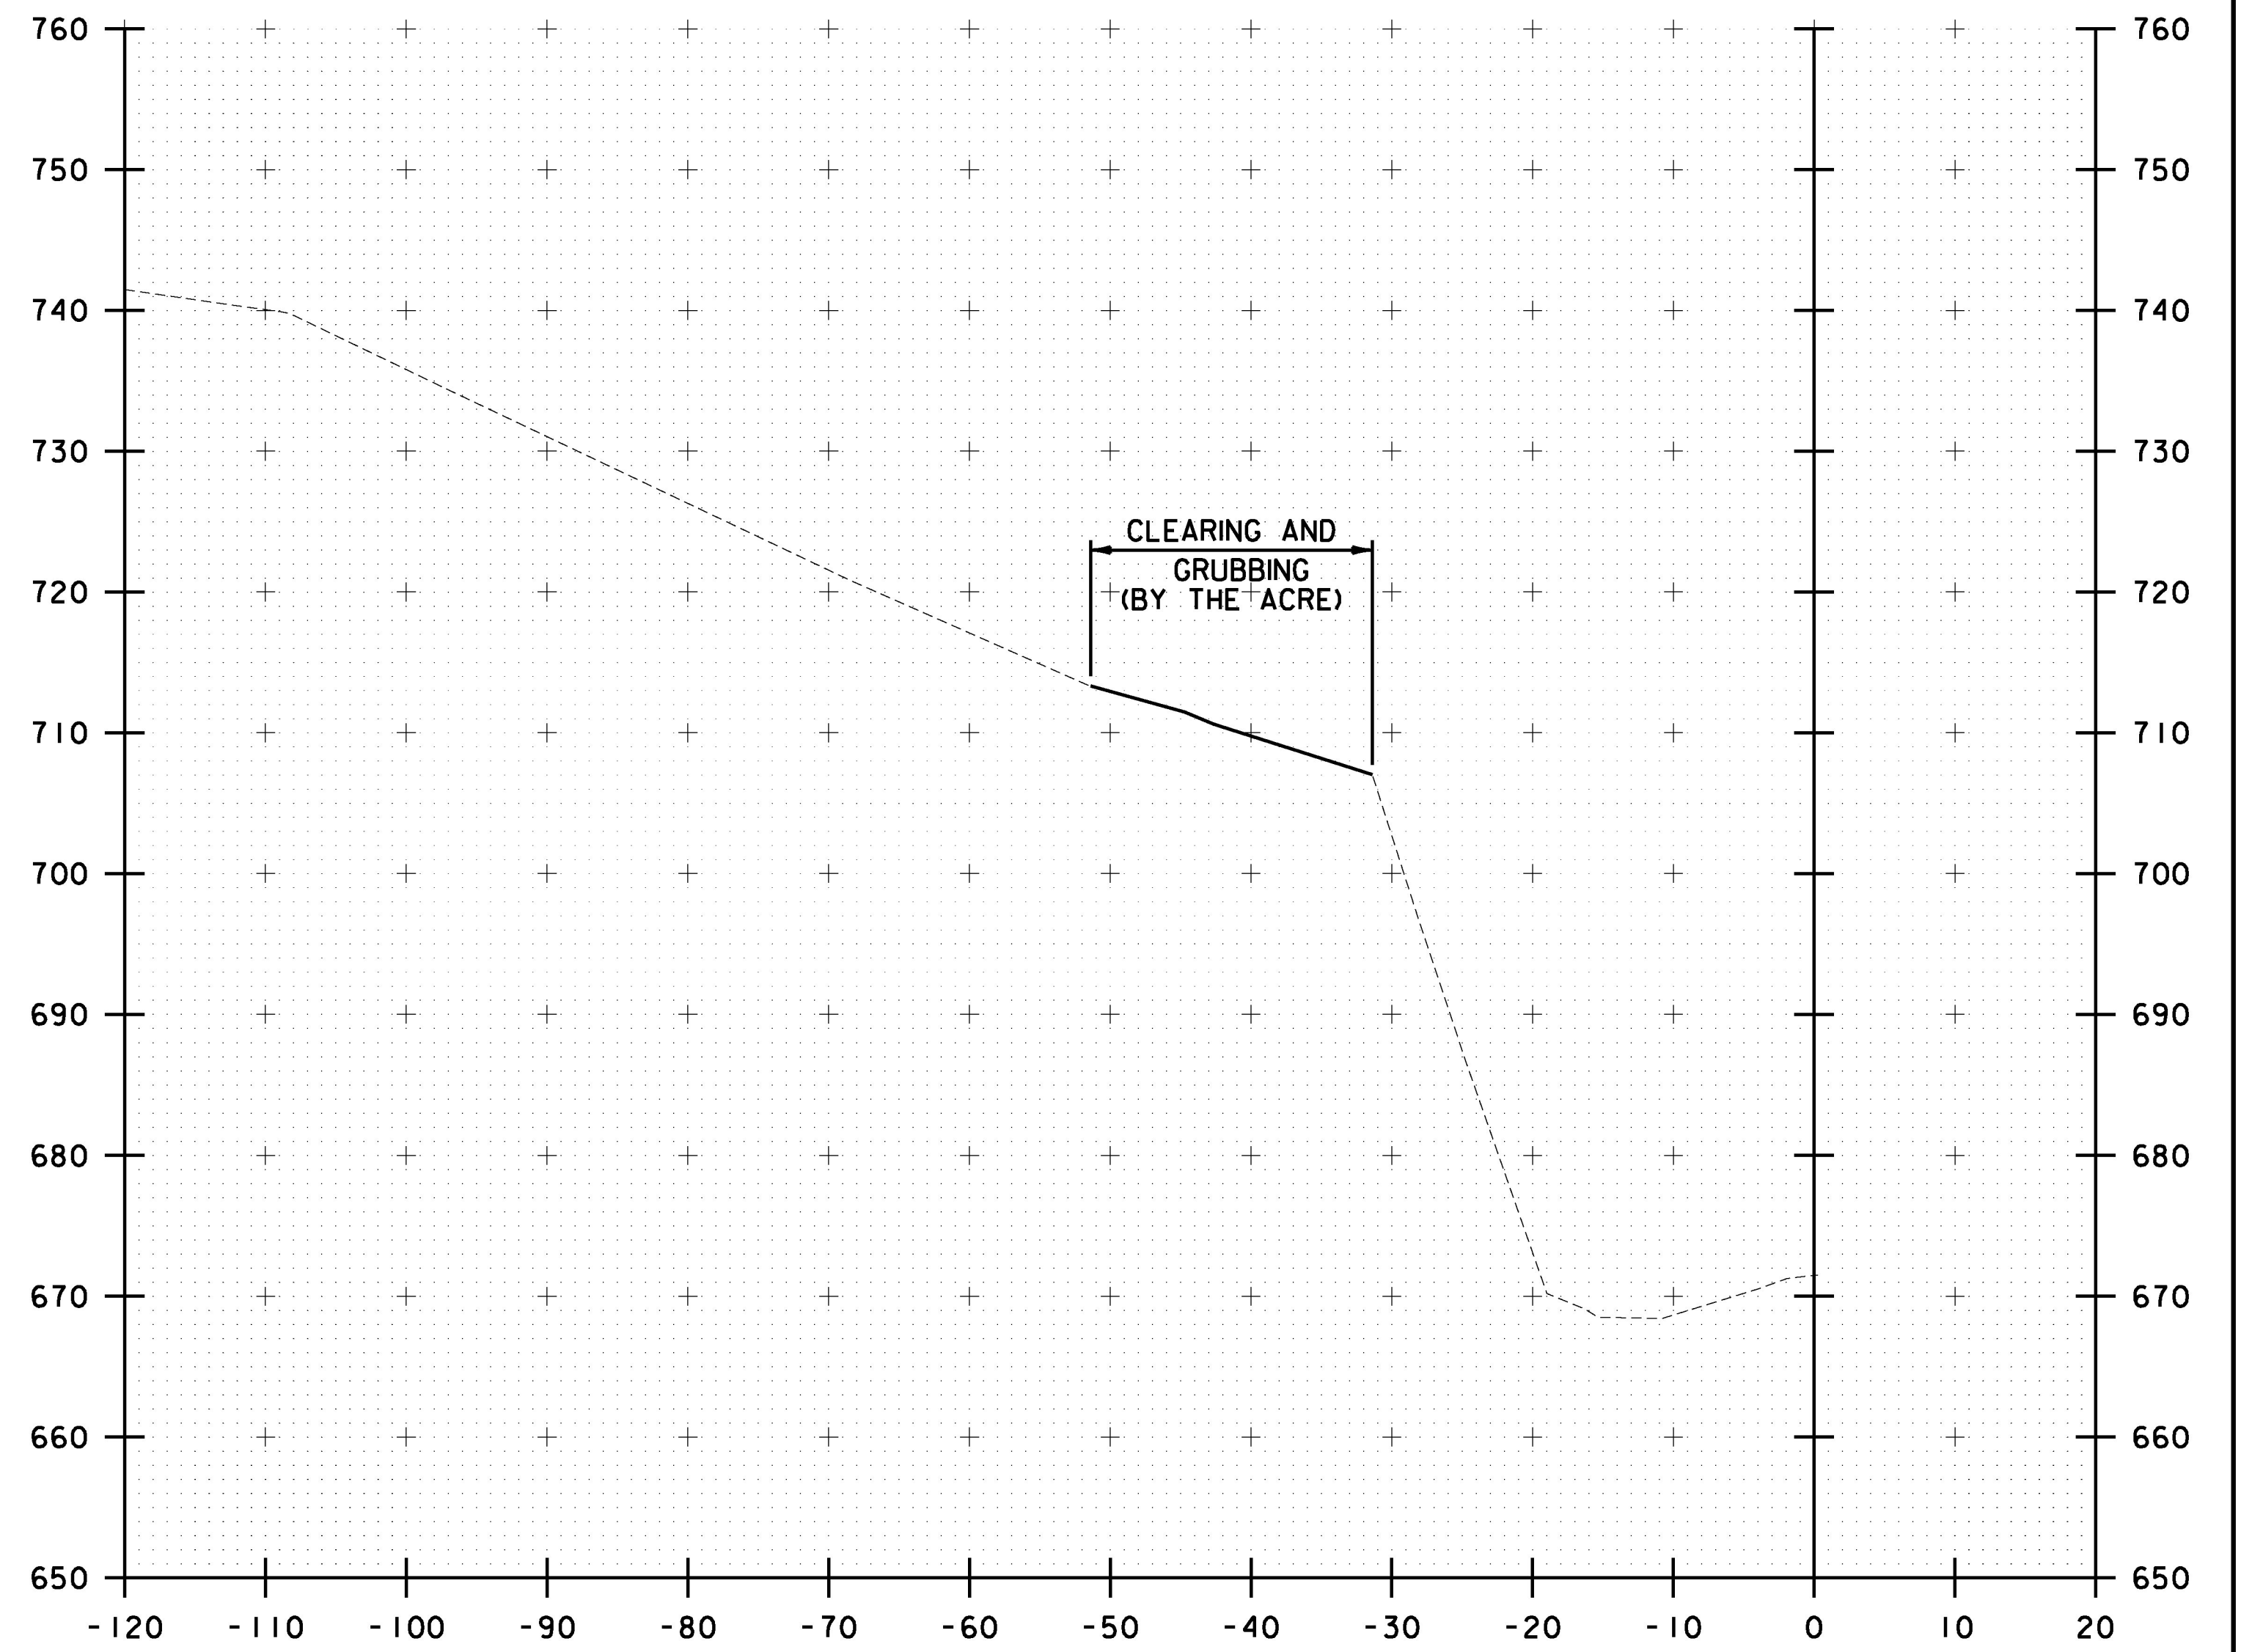

S 6173+00

STA. S 6172+50 TO STA. S 6173+00

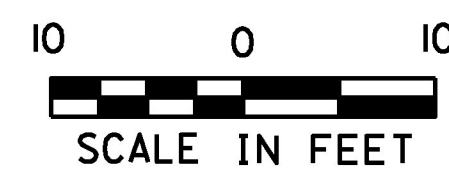

PROJECT NAME: RYEGATE	
PROJECT NUMBER: IM 091-2(80)	
FILE NAME: z13a368xsc.dgn	PLOT DATE: 3/30/2017
PROJECT LEADER: D. GOZALKOWSKI	DRAWN BY: J. HEALD
DESIGNED BY: J. OLSEN	CHECKED BY: J. SHIELDS
CROSS SECTION SHEET II	SHEET 46 OF 61