



FILE NAME = W:\p\c\jess\ANY\KA\29741\CADD\KSTN\13a368\Cross\13a368\Highway\13a368.dgn  
DATE/TIME = 3/30/2017  
USER = 5323

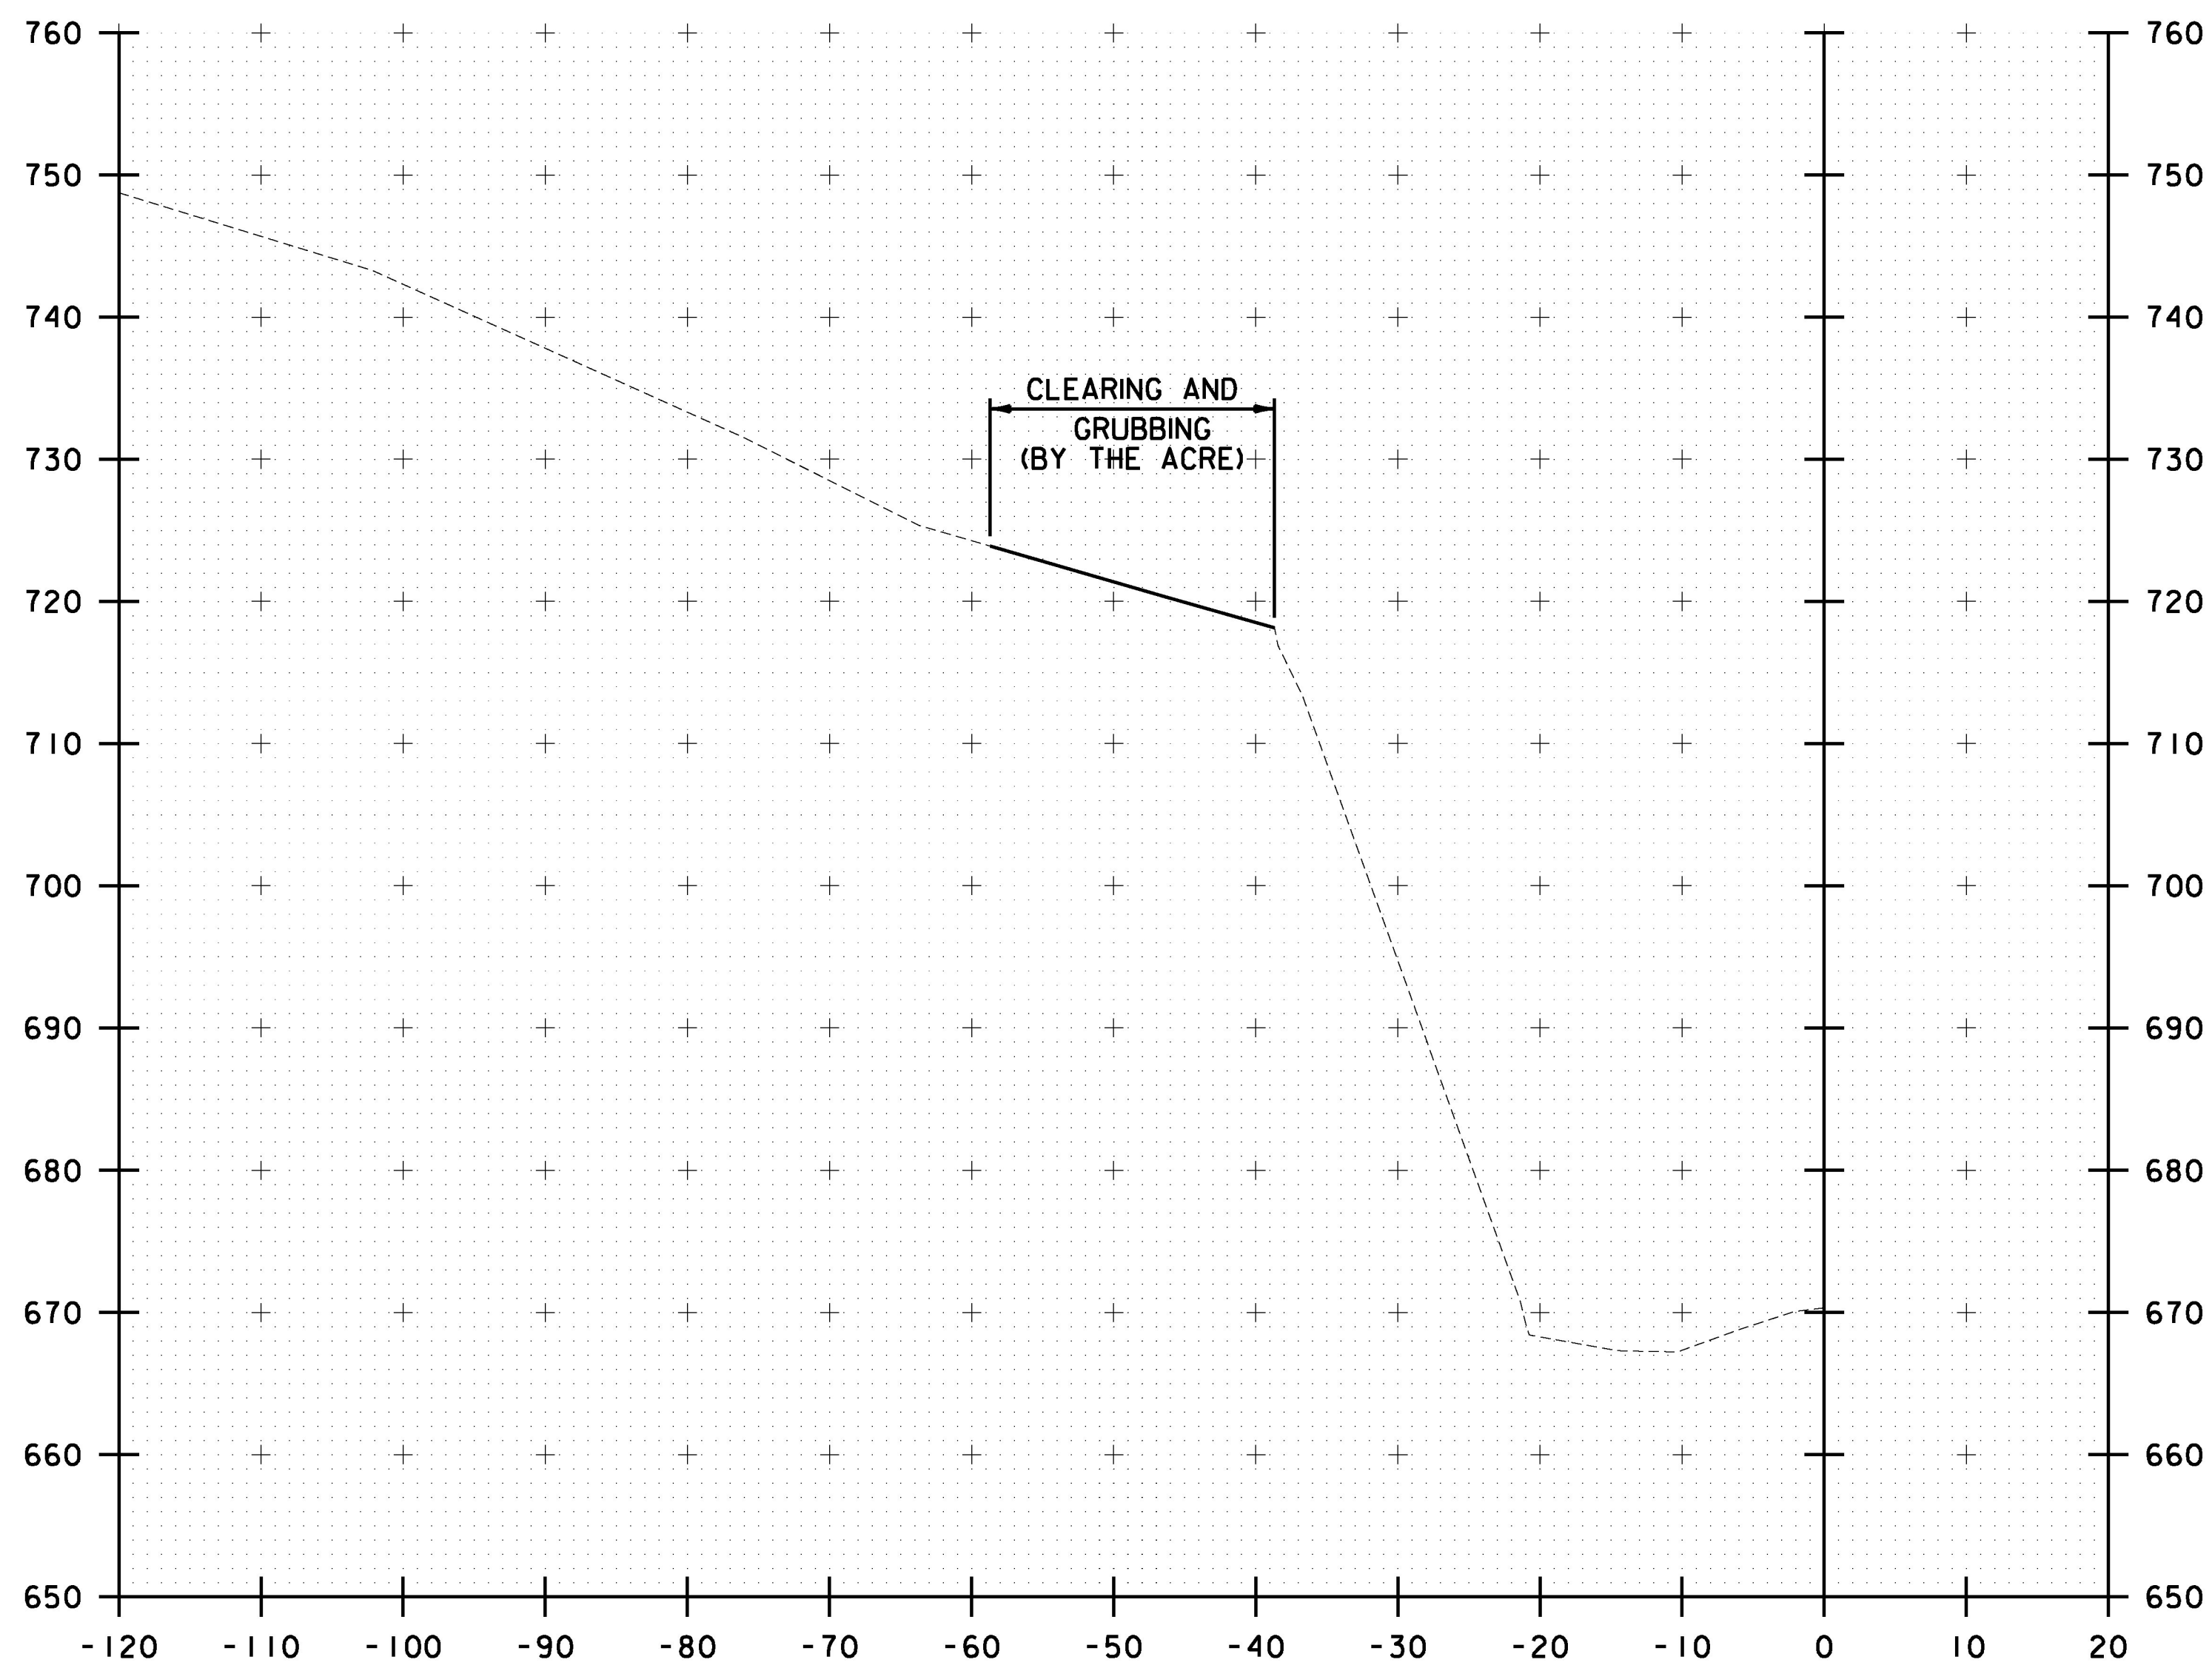


S 6173+50

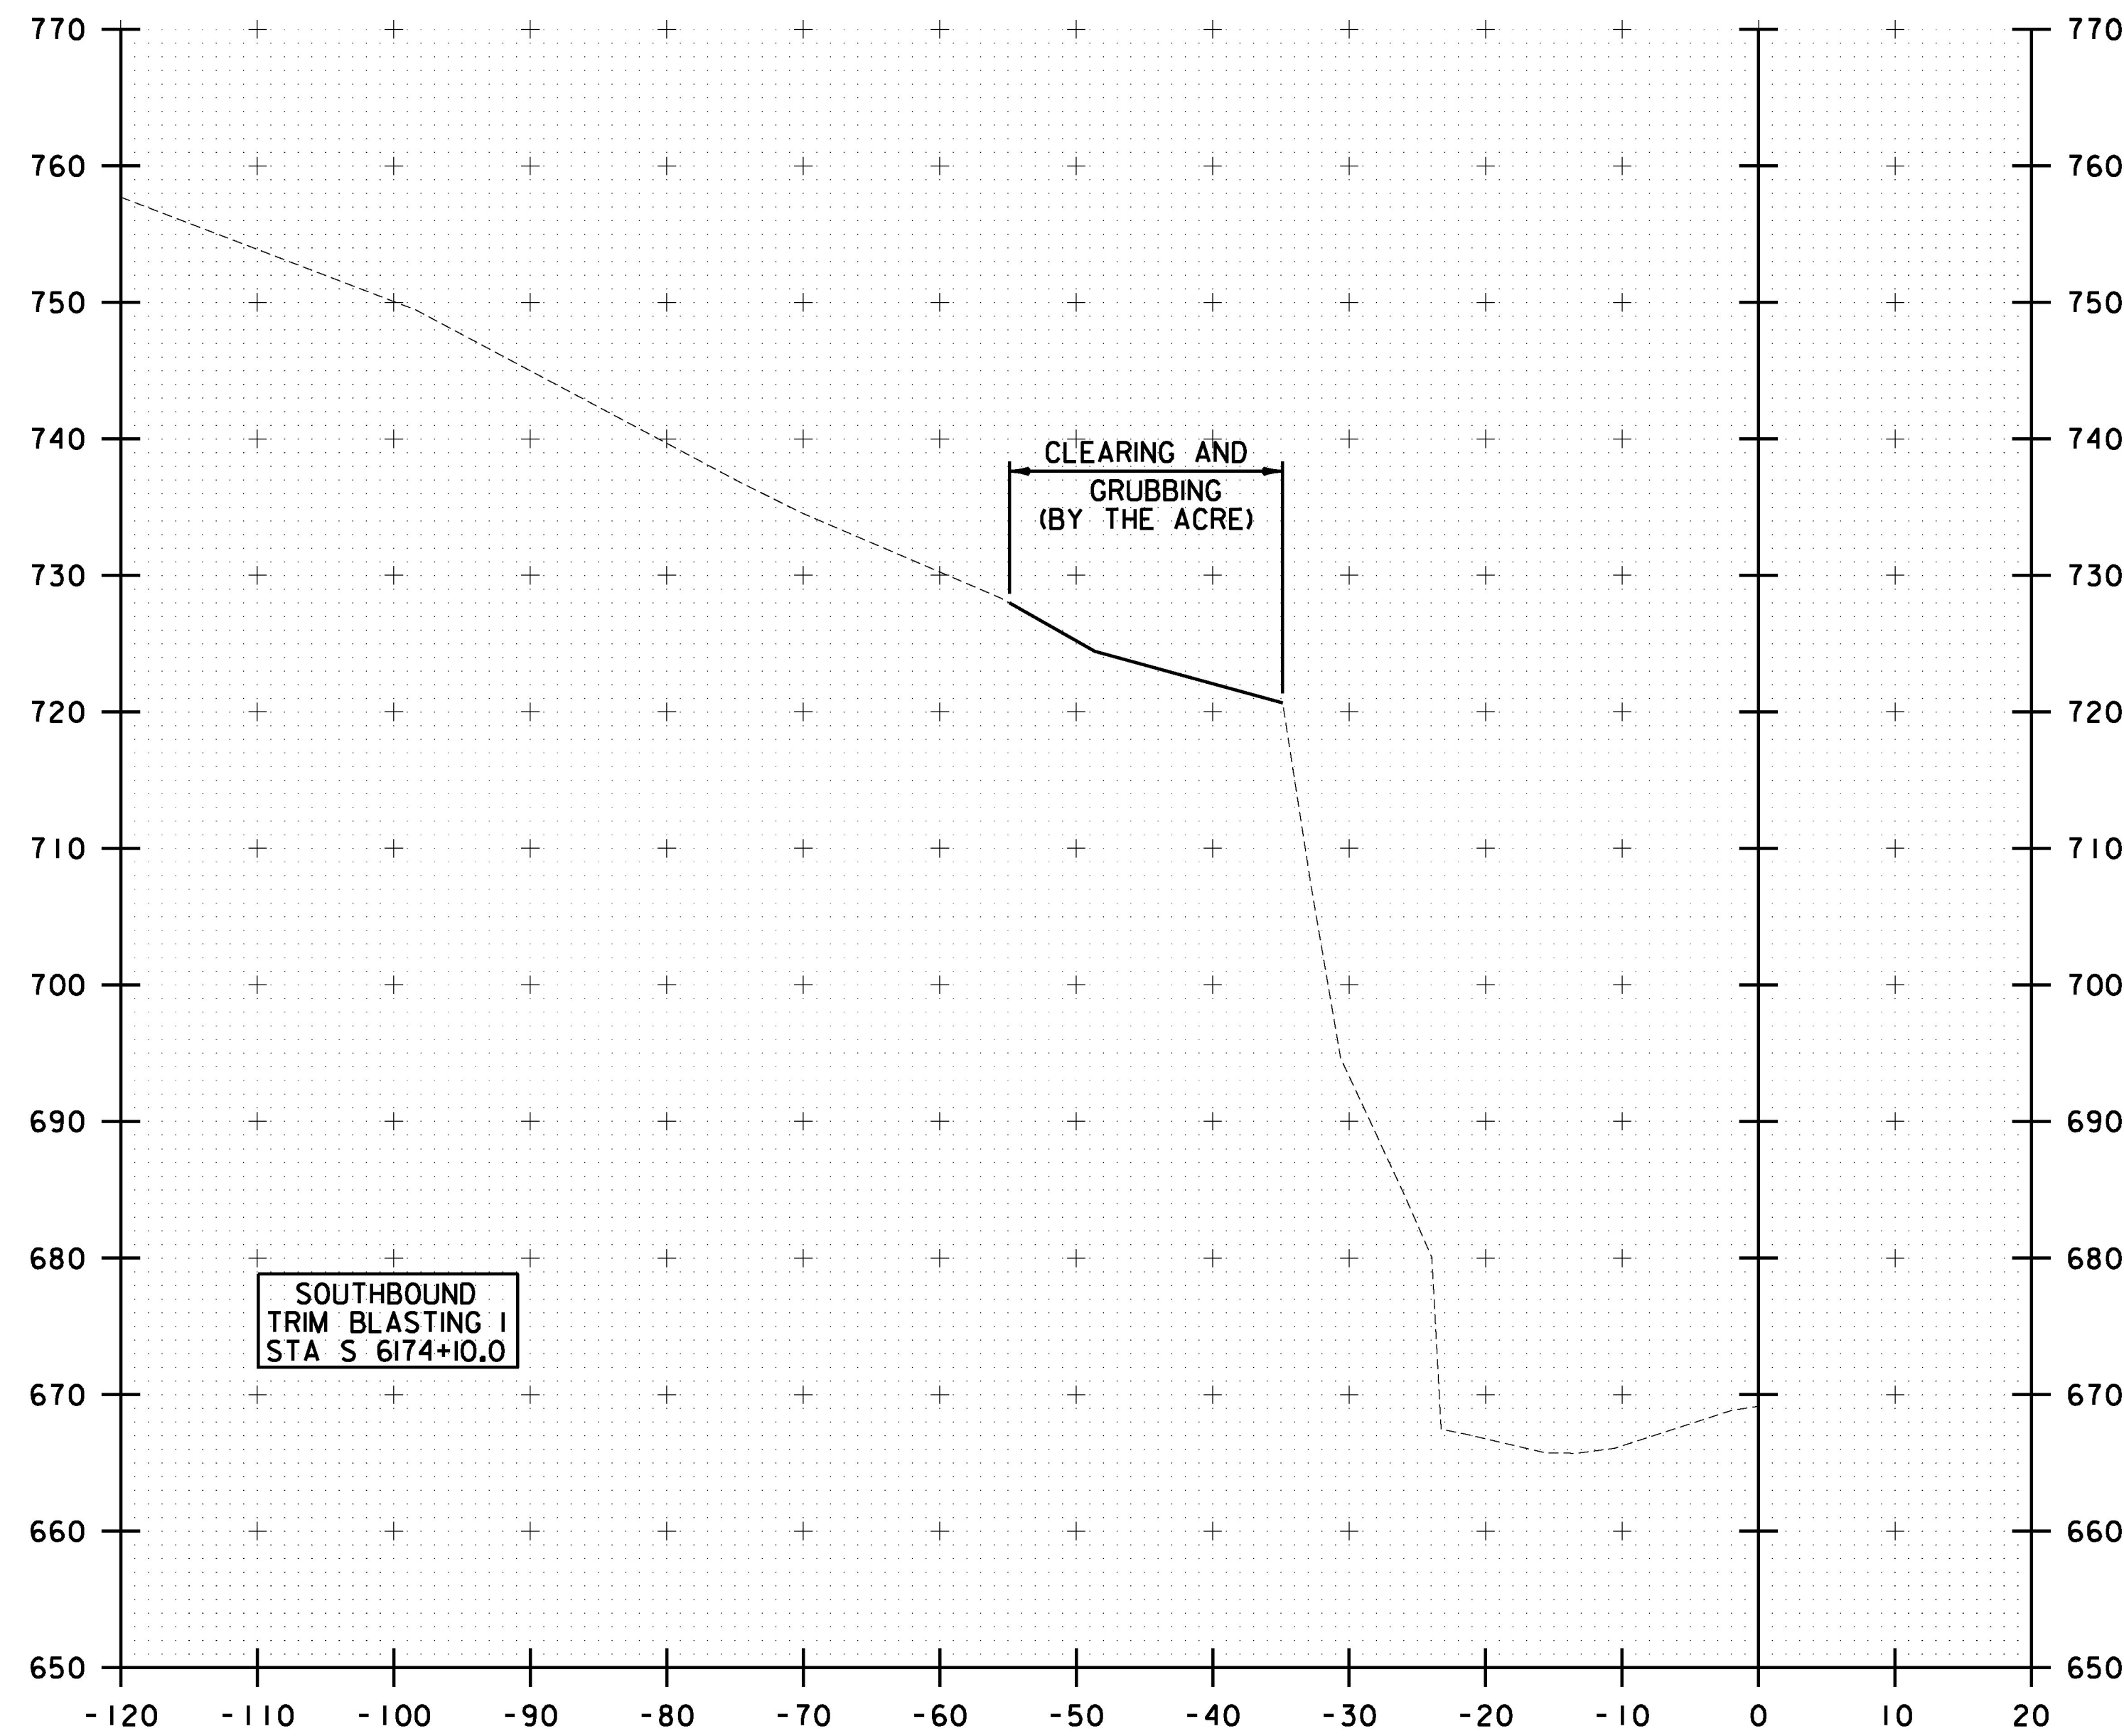

S 6174+00

STA. S 6173+50 TO STA. S 6174+00

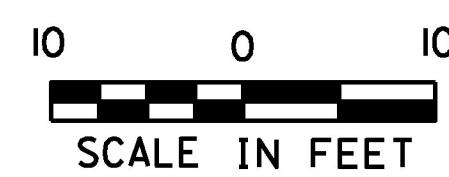

PROJECT NAME: RYEGATE	PLOT DATE: 3/30/2017
PROJECT NUMBER: IM 091-2(80)	DRAWN BY: J. HEALD
FILE NAME: z13a368xsc.dgn	CHECKED BY: J. SHIELDS
PROJECT LEADER: D. GOZALKOWSKI	SHEET 47 OF 61
DESIGNED BY: J. OLSEN	
CROSS SECTION SHEET 12	