



FILE NAME = W:\Projects\091-2(80)\R000\13a368\Consultants\Highway\13a368xsc.dgn
DATE/TIME = 3/30/2017
USER = 5323

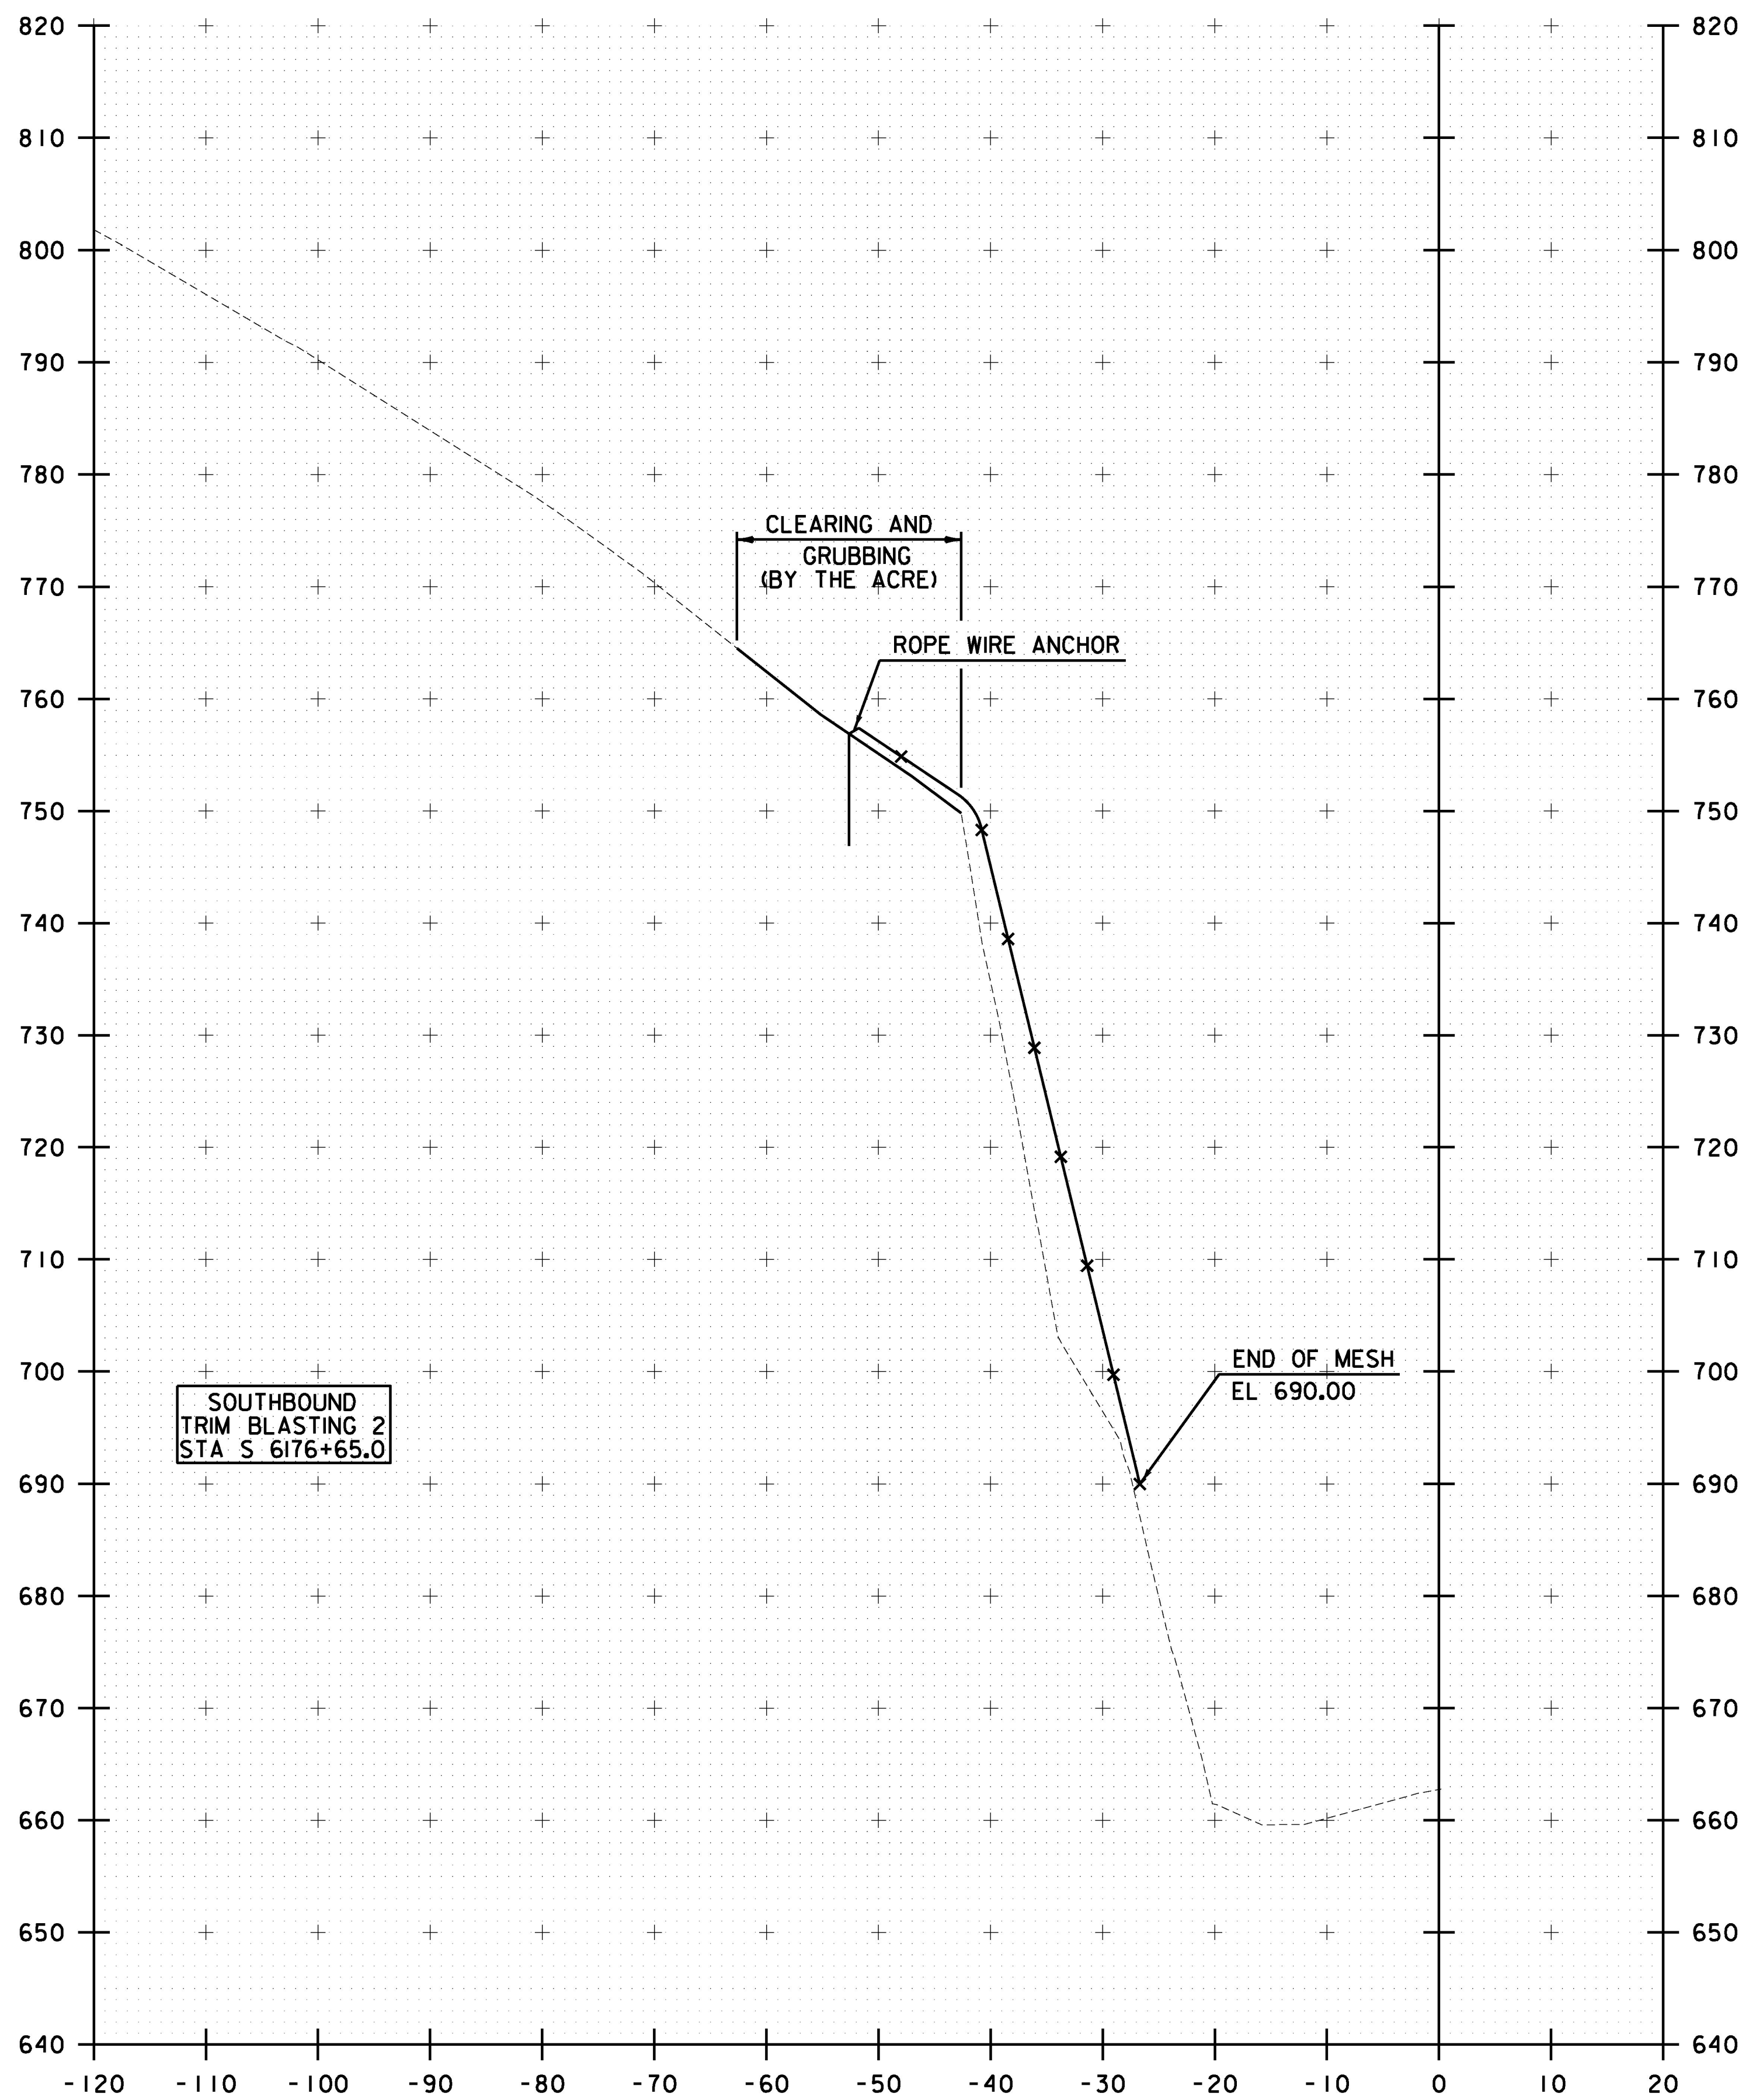

S 6176+50

STA. S 6176+50

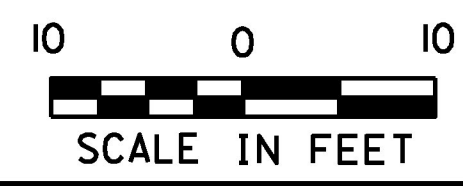

| | |
|--------------------------------|------------------------|
| PROJECT NAME: RYEGATE | PLOT DATE: 3/30/2017 |
| PROJECT NUMBER: IM 091-2(80) | DRAWN BY: J. HEALD |
| FILE NAME: z13a368xsc.dgn | DESIGNED BY: J. OLSEN |
| PROJECT LEADER: D. GOZALKOWSKI | CHECKED BY: J. SHIELDS |
| CROSS SECTION SHEET 15 | SHEET 50 OF 61 |