



FILE NAME: W:\P\c\jess\5\ANY\KA\29741\CRDD\1\STN\13a368\Consultants\Highway\413a368.asc.dgn
DATE/TIME: 3/30/2017
USER: 5323

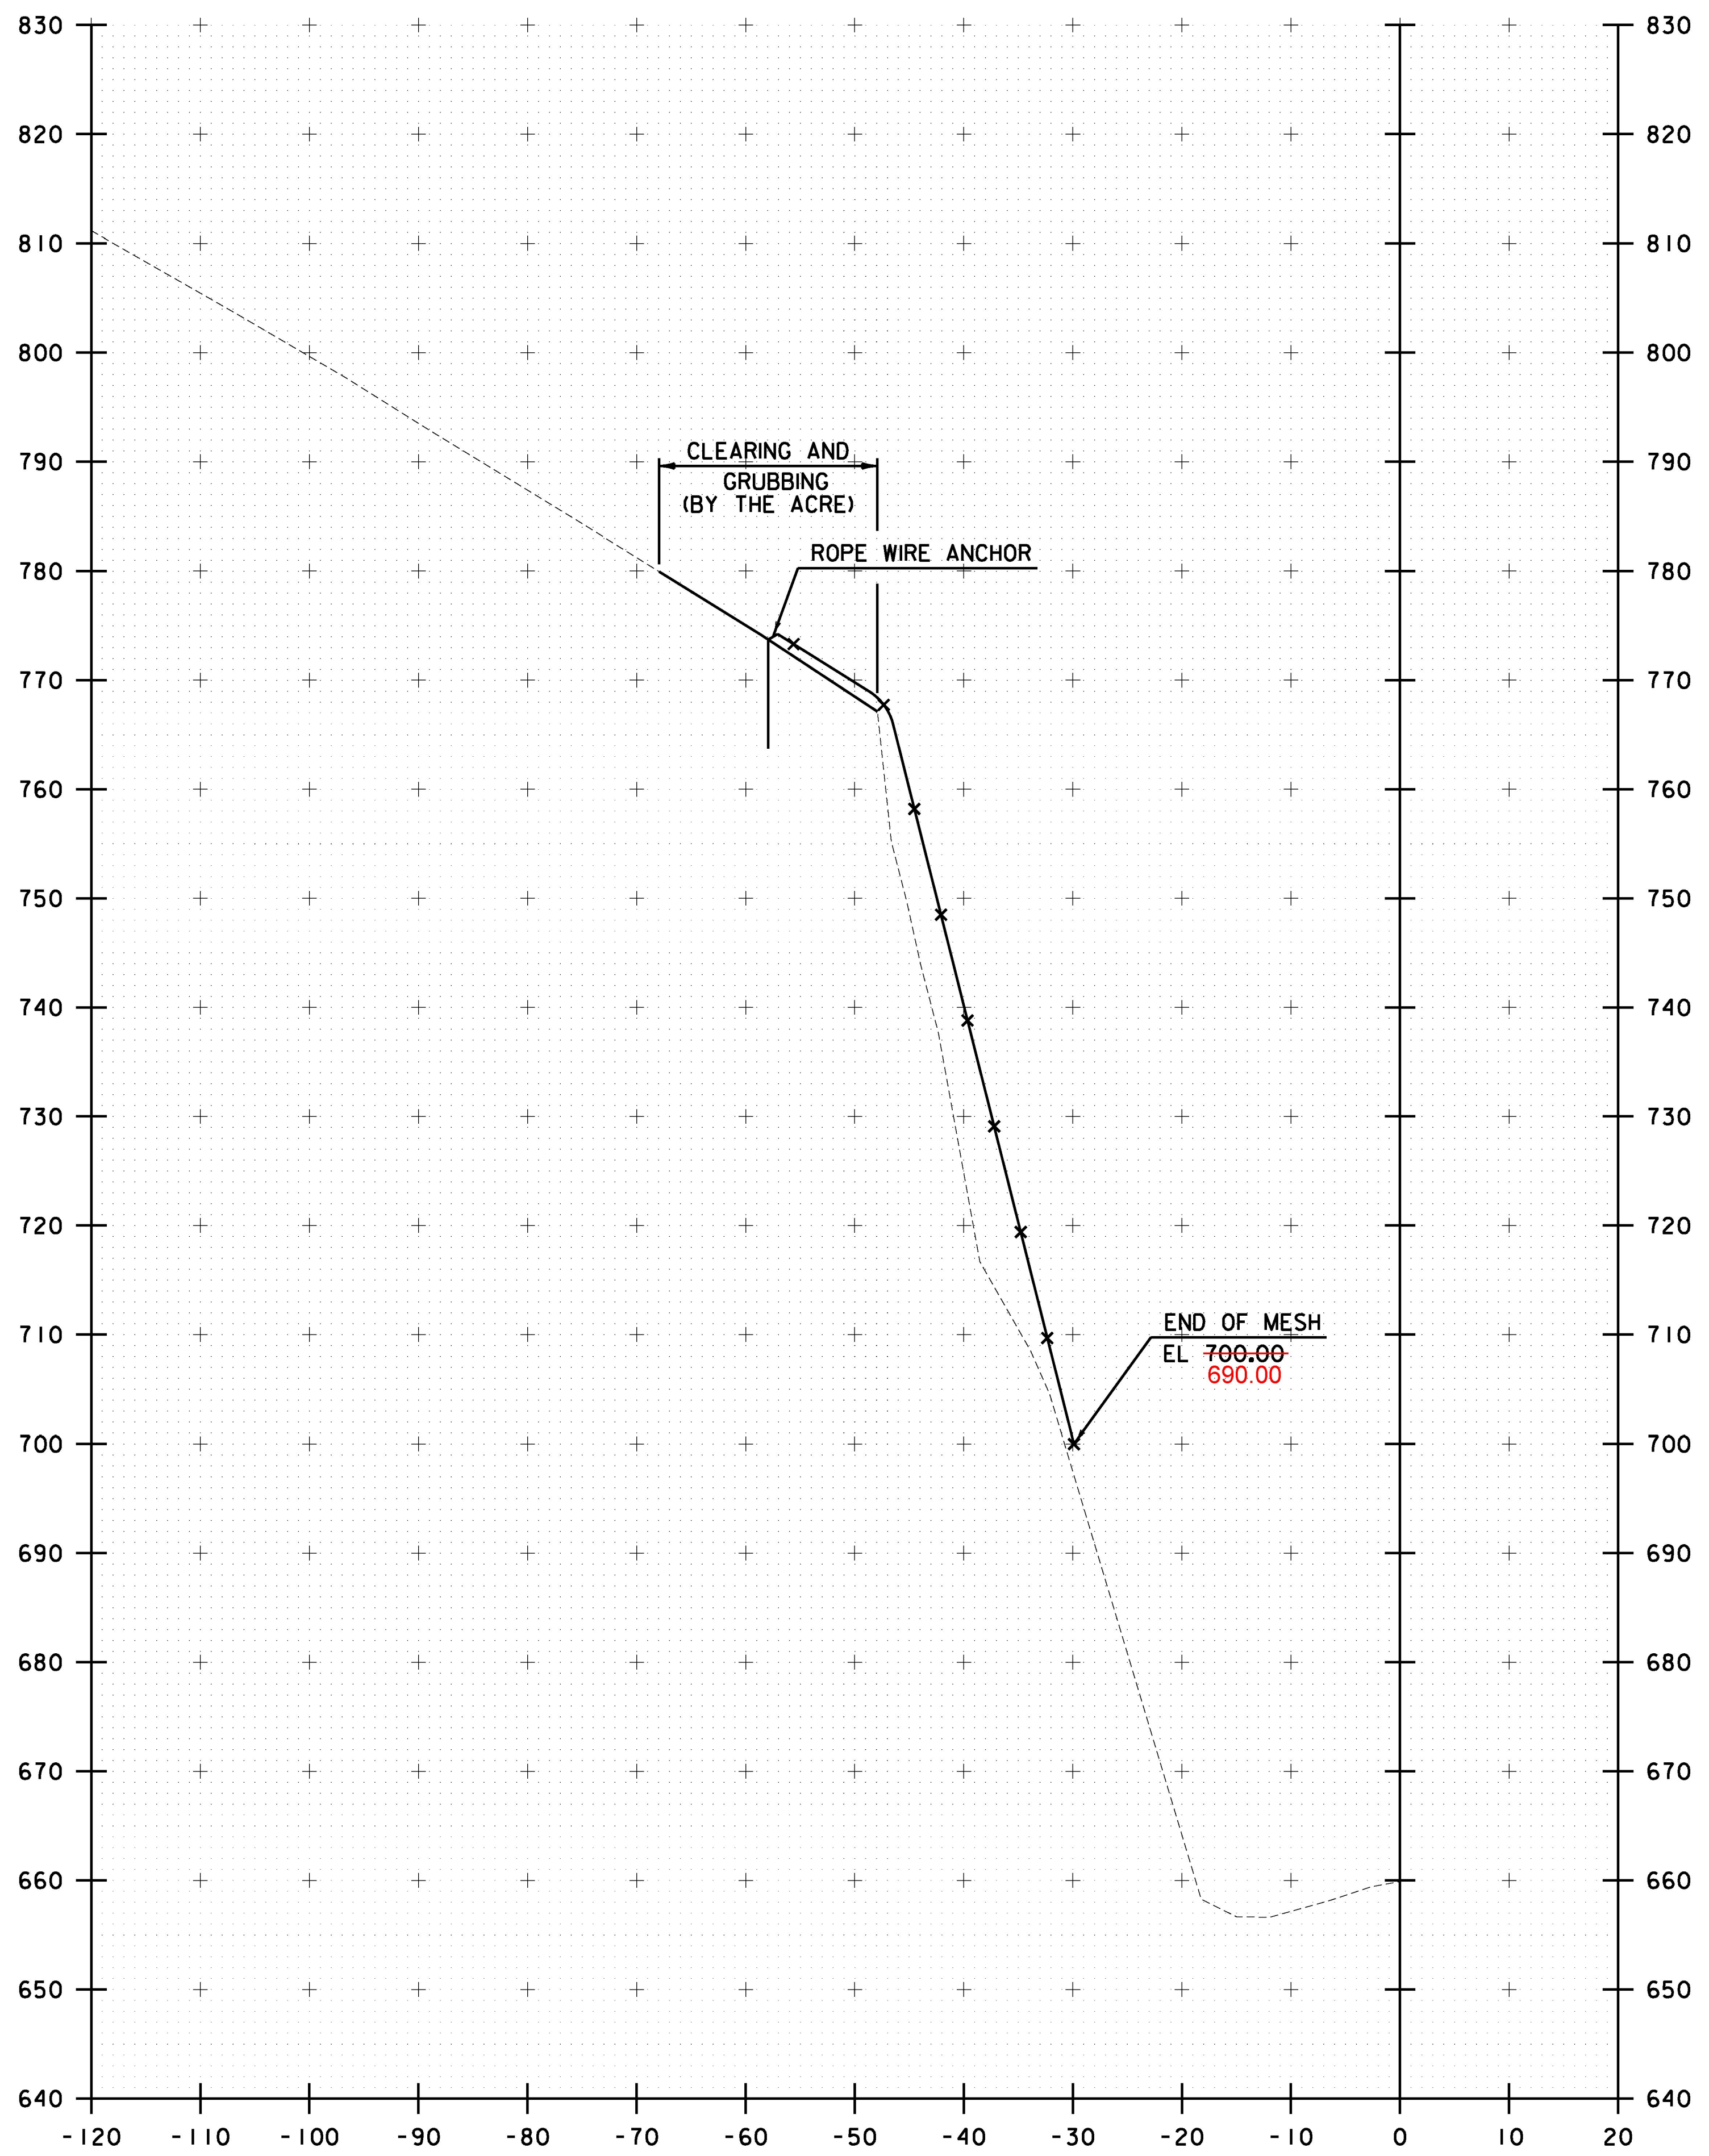

S 6177+50

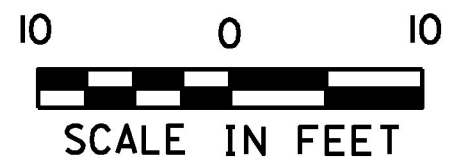

STA. S 6177+50

PROJECT NAME: RYEGATE	PLOT DATE: 3/30/2017
PROJECT NUMBER: IM 091-2(80)	DRAWN BY: J. HEALD
FILE NAME: z13a368xsc.dgn	DESIGNED BY: J. OLSEN
PROJECT LEADER: D. GOZALKOWSKI	CHECKED BY: J. SHIELDS
CROSS SECTION SHEET 17	SHEET 52 OF 61