

STATE OF VERMONT AGENCY OF TRANSPORTATION





PROPOSED IMPROVEMENT TOWN OF LYNDON COUNTY OF CALEDONIA I-91 (PRINCIPAL ARTERIAL - INTERSTATE) (NHS)

ADJACENT TO AND RIGHT OF INTERSTATE 91 NORTHBOUND BEGINNING AT
STA 7527+25.00 (MM 142.562) AND EXTENDING NORTHERLY 767.50 FEET
(0.145 MILE) TO AN ENDING POINT AT STA 7534+92.50 (MM 142.707).

LENGTH OF PROJECT = 767.50 FT (0.145 MILE)

WORK TO BE PERFORMED UNDER THIS PROJECT INCLUDES HAND SCALING,
TRIM BLASTING, ROCK ANCHORING, CATCHMENT DITCH EXCAVATION, TRAFFIC
CONTROL, GUARDRAIL INSTALLATION AND OTHER HIGHWAY RELATED ITEMS.

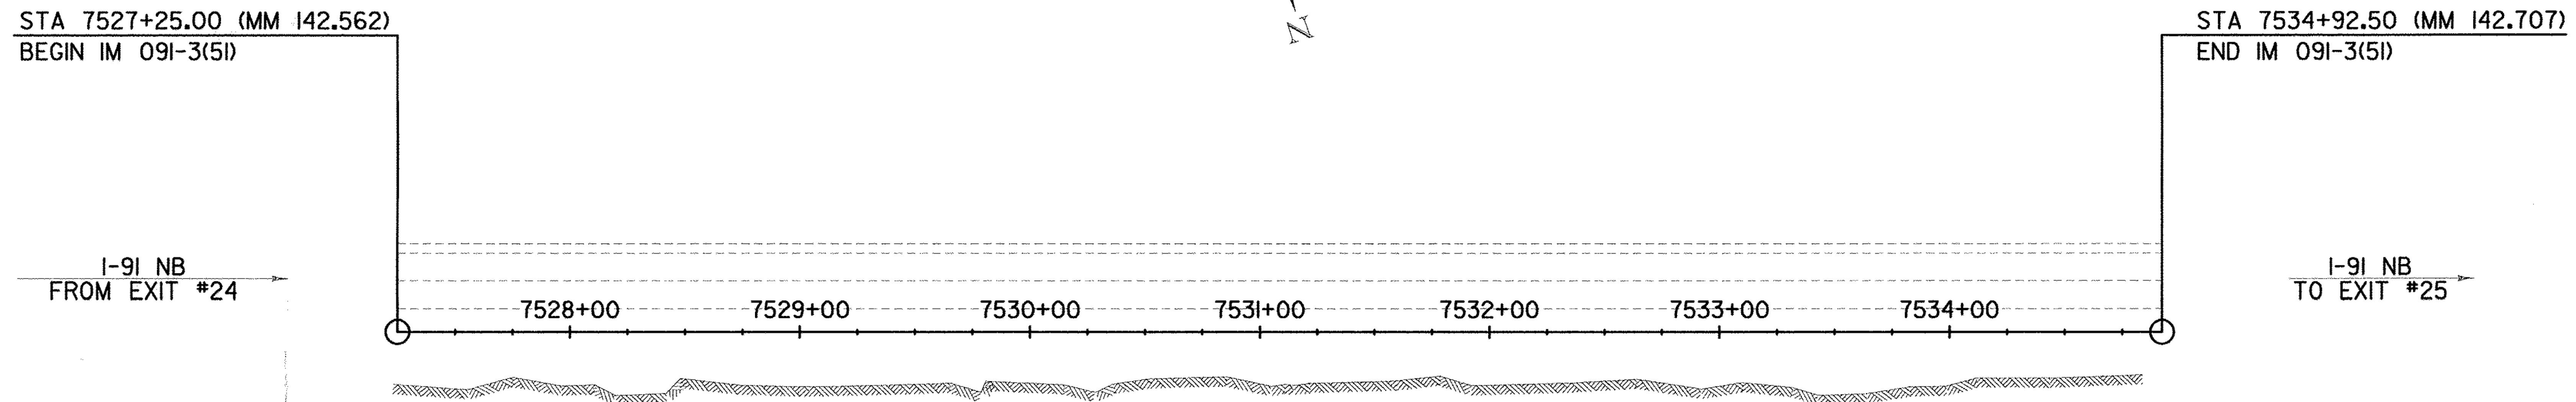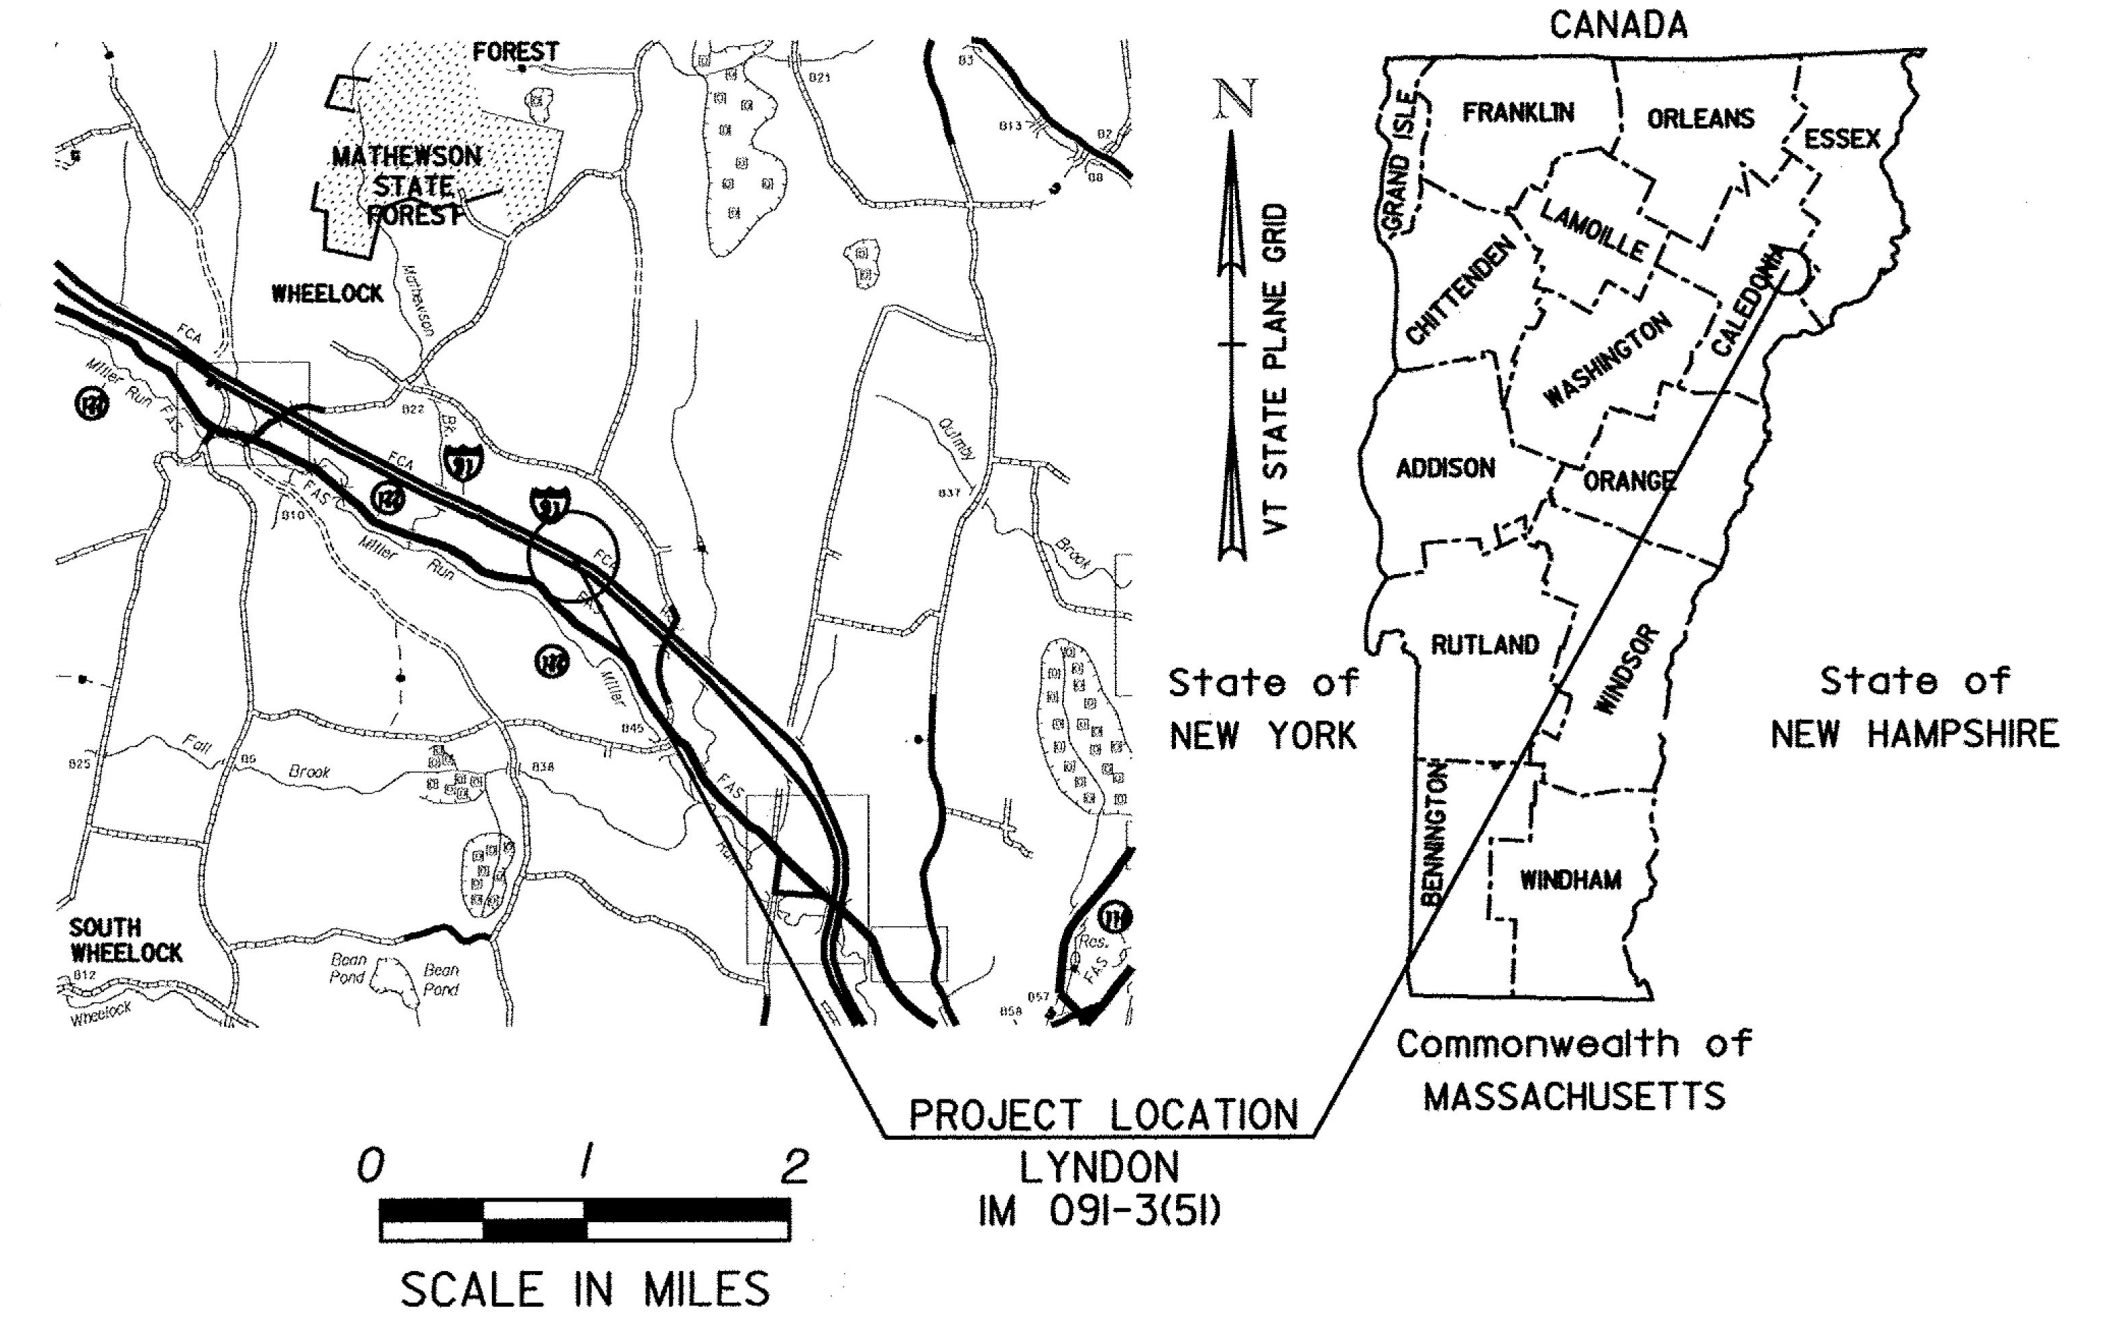

Record Plans
Contractor: J.P. SICARD, INC.
Resident Engineer: MIKE BOOTH
Construction Began: JUNE 26, 2017
Construction Complete: NOVEMBER 2, 2017
Record Plans By: MIKE BOOTH & JESSE IVES

I hereby certify that all construction required by this set of drawings has been accomplished as indicated herein.


BY: Resident Engineer

Date: October 25, 2018

NOTE: Any further information concerning final quantities, amounts or other details relative to this project may be found at Central Files in the electronic archives.

CONSTRUCTION IS TO BE CARRIED ON IN ACCORDANCE WITH THESE PLANS AND THE STANDARD SPECIFICATIONS FOR CONSTRUCTION DATED 2011, AS APPROVED BY THE FEDERAL HIGHWAY ADMINISTRATION ON JULY 20, 2011 FOR USE ON THIS PROJECT, INCLUDING ALL SUBSEQUENT REVISIONS AND SUCH REVISED SPECIFICATIONS AND SPECIAL PROVISIONS AS ARE INCORPORATED IN THESE PLANS.

| | |
|-------------------------------------|-----------------|
| QUALITY ASSURANCE PROGRAM : LEVEL I | |
| SURVEYED BY : | R. GILMAN, VAOT |
| SURVEYED DATE : | 05/2014 |
| DATUM | |
| VERTICAL | NAVD 88 |
| HORIZONTAL | NAD 83 (2011) |

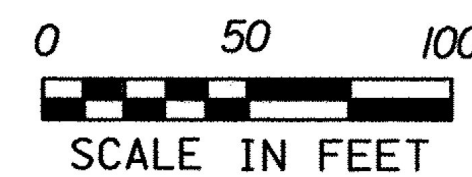

| | |
|---------------------------|--------------------------------------|
| PLANS PREPARED BY | DIRECTOR OF PROJECT DELIVERY |
| | APPROVED: DATE 12/21/2016 |
| | PROJECT MANAGER : BRUCE MARTIN, P.E. |
| | PROJECT NAME : LYNDON |
| | PROJECT NUMBER : IM 091-3(51) |
| | SHEET 1 OF 35 SHEETS |