
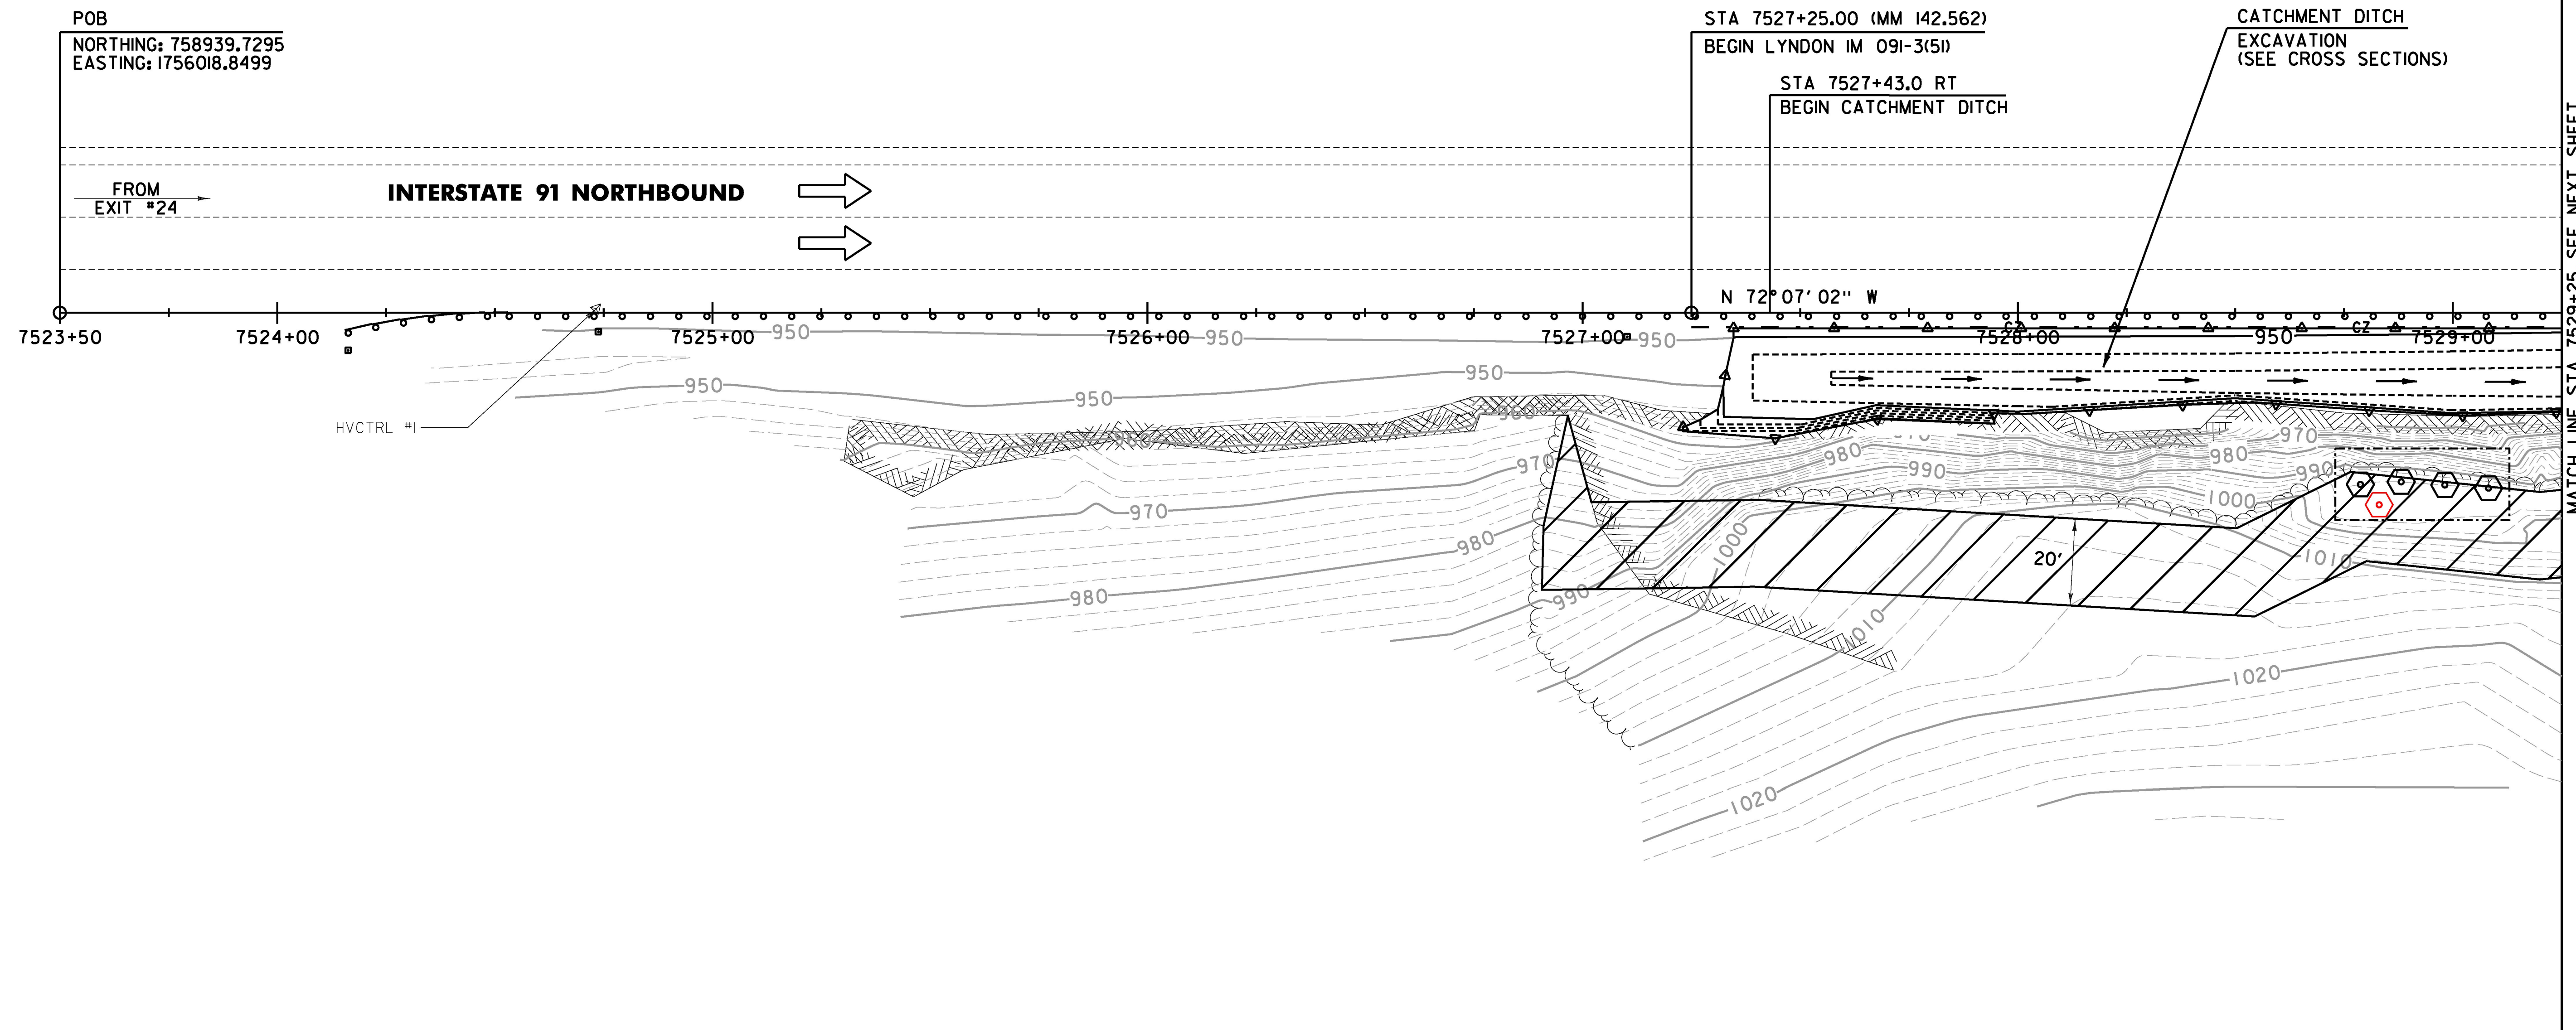


ROCK CUT TREATMENT LOCATION	PHOTO REFERENCE NUMBER															
	1	2	3	4	5	6	7	8	9	10	11	12	13	14	15	16
ROCK ANCHORS												X	X			

NOTE: REFER TO CONTRACT DOCUMENTS FOR PHOTOGRAPHS

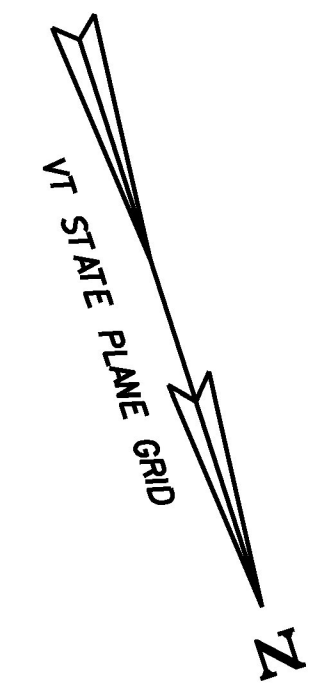

LEGEND	
	TRIM BLASTING LOCATION
	DIRECTION OF TRAFFIC
	ROCK ANCHOR LOCATION
	CLEARING AND GRUBBING (BY THE ACRE) (SEE NOTES ON SHEET 10)

MANUFACTURED TERMINAL SECTION, FLARED
STA 7524+15.5 - STA 7524+53.0 RT


SPECIAL PROVISION (HAND SCALING)
STA 7527+43.0 - STA 7529+25.0 RT

STEEL BEAM GUARDRAIL, GALVANIZED
STA 7524+53.0 - STA 7529+25.0 RT

SPECIAL PROVISION (ROCK ANCHOR)
STA 7528+73.0 - STA 7529+13.0 RT

REMOVAL OF EXISTING DELINEATOR
STA 7524+74.0 RT
STA 7527+10.0 RT

DELINEATOR WITH STEEL POST
STA 7524+15.5 RT (BLUE)
STA 7524+74.0 RT (WHITE)
STA 7527+10.0 RT (WHITE)

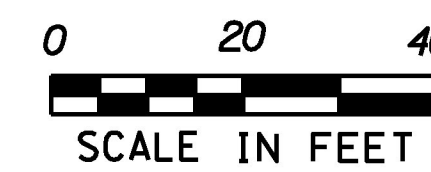

PROJECT NAME: LYNDON
PROJECT NUMBER: IM 091-3(51)

FILE NAME: z13a370bdr.dgn
PROJECT LEADER: D. GOZALKOWSKI
DESIGNED BY: J. OLSEN
PLAN SHEET I

PLOT DATE: 1/30/2017
DRAWN BY: J. HEALD
CHECKED BY: J. SHIELDS
SHEET II OF 35