

ROCK CUT TREATMENT LOCATION	PHOTO REFERENCE NUMBER															
	1	2	3	4	5	6	7	8	9	10	11	12	13	14	15	16
TB1	X	X														
TB2	X		X	X												
TB3					X											
TB4						X	X	X								
TB5						X	X	X	X							
TB6								X	X	X						
EXISTING HEADWALL													X	X	X	

NOTE: REFER TO CONTRACT DOCUMENTS FOR PHOTOGRAPHS

EXISTING ROW

SPECIAL PROVISION (HAND SCALING)
 STA 7529+25.0 - STA 7529+73.0 RT
 STA 7531+83.0 - STA 7533+53.0 RT

STEEL BEAM GUARDRAIL, GALVANIZED
 STA 7529+25.0 - STA 7535+05.0 RT

ANCHOR FOR STEEL BEAM RAIL
 STA 7534+98.5 RT

REMOVING SIGNS
 STA 7529+28.0 RT

ERECTING SALVAGED SIGNS
 STA 7529+28.0 RT


SETTING SALVAGED POST
 STA 7529+28.0 RT

REMOVAL OF EXISTING DELINEATOR
 STA 7531+99.8 RT
 STA 7534+24.8 RT

DELINEATOR WITH STEEL POST
 STA 7531+99.8 RT (WHITE)
 STA 7534+24.8 RT (WHITE)
 STA 7535+05.0 RT (GREEN)

SPECIAL PROVISION (TRIM BLASTING)
 TB1 - STA 7529+48.0 RT
 TB2 - STA 7529+88.0 RT
 TB3 - STA 7531+75.0 RT
 TB4 - STA 7532+36.0 RT
 TB5 - STA 7532+65.0 RT
 TB6 - STA 7533+29.0 RT

SIGN LEGEND
 R = REMOVE
 S = SALVAGE
 N = NEW
 RET = RETAIN
 B-B = BACK TO BACK
 EXISTING = - - - - -
 NEW = _____

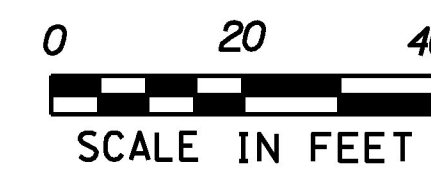

LEGEND

- TRIM BLASTING LOCATION
- DIRECTION OF TRAFFIC
- ROCK ANCHOR LOCATION
- CLEARING AND GRUBBING (BY THE ACRE) (SEE NOTES ON SHEET 10)

PROJECT NAME: LYNDON
 PROJECT NUMBER: IM 091-3(51)

FILE NAME: z13a370bdr.dgn
 PROJECT LEADER: D. GOZALKOWSKI
 DESIGNED BY: J. OLSEN
 PLAN SHEET 2

PLOT DATE: 12/13/2016
 DRAWN BY: J. HEALD
 CHECKED BY: J. SHIELDS
 SHEET 12 OF 35

FILE NAME = W:\P\13a370\13a370\CADD\13a370\13a370\13a370bdr.dgn
 DATE/TIME = 12/13/2016 10:53:23
 USER = jshields