

LEGEND

- | | | | |
|--|----------------------------------|--|-------------------------------------|
| | DIRECTION OF TRAFFIC | | FILTER FABRIC DROP INLET PROTECTION |
| | STABILIZED CONSTRUCTION ENTRANCE | | FILTER FABRIC PIPE INLET PROTECTION |
| | STONE - CHECK DAM | | ROCK ANCHOR LOCATION |
| | TRIM BLASTING LOCATION | | |

PROJECT DEMARCATION FENCE
 STA 7529+25.0 - STA 7535+15.0 RT

INLET PROTECTION DEVICE, TYPE I
 STA 7531+08.7 RT
 STA 7531+13.0 RT


VEHICLE TRACKING PAD
 STA 7535+00.0 RT

TEMPORARY STONE CHECK DAM, TYPE I
 STA 7531+79.0 RT
 STA 7532+27.3 RT
 STA 7533+41.0 RT
 STA 7534+92.0 RT

TEMPORARY EROSION MATTING
 STA 7529+25.0 - STA 7531+10.0 RT
 STA 7529+25.0 - STA 7532+30.0 RT
 STA 7531+71.0 - STA 7534+93.0 RT
 STA 7532+83.0 - STA 7534+89.0 RT

NOTES:

- FOR ESTIMATING PURPOSES ASSUME 25% OF THE AREAS SHOWN WILL NEED TO BE REVEGETATED AND NEED PROTECTION WITH EROSION CONTROL MATTING DUE TO TREE REMOVAL OPERATIONS.
- FOR ESTIMATING PURPOSES ASSUME 25% OF THE AREA SHOWN WILL NEED TO BE REVEGETATED DUE TO TREE REMOVAL OPERATIONS.

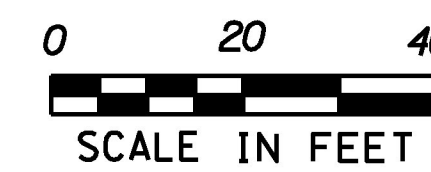

PROJECT NAME: LYNDON
 PROJECT NUMBER: IM 091-3(51)

FILE NAME: z13a370bdr_ero.dgn
 PROJECT LEADER: D. GOZALKOWSKI
 DESIGNED BY: J. OLSEN
 EPSC CONSTRUCTION PLAN SHEET 2

PLOT DATE: 12/13/2016
 DRAWN BY: J. HEALD
 CHECKED BY: J. SHIELDS
 SHEET 18 OF 35

FILE NAME: W:\P\13a370bdr_ero.dgn
 DATE/TIME: 12/13/2016 10:53:23
 USER: jolsen