




FILE NAME = W:\P\cs_jessica\ANY\KA\29756\CADD\MSTN13a370\Consult\taanta\Highway\z13a370xsc.dgn
 DATE/TIME = 12/13/2016
 USER = 5323

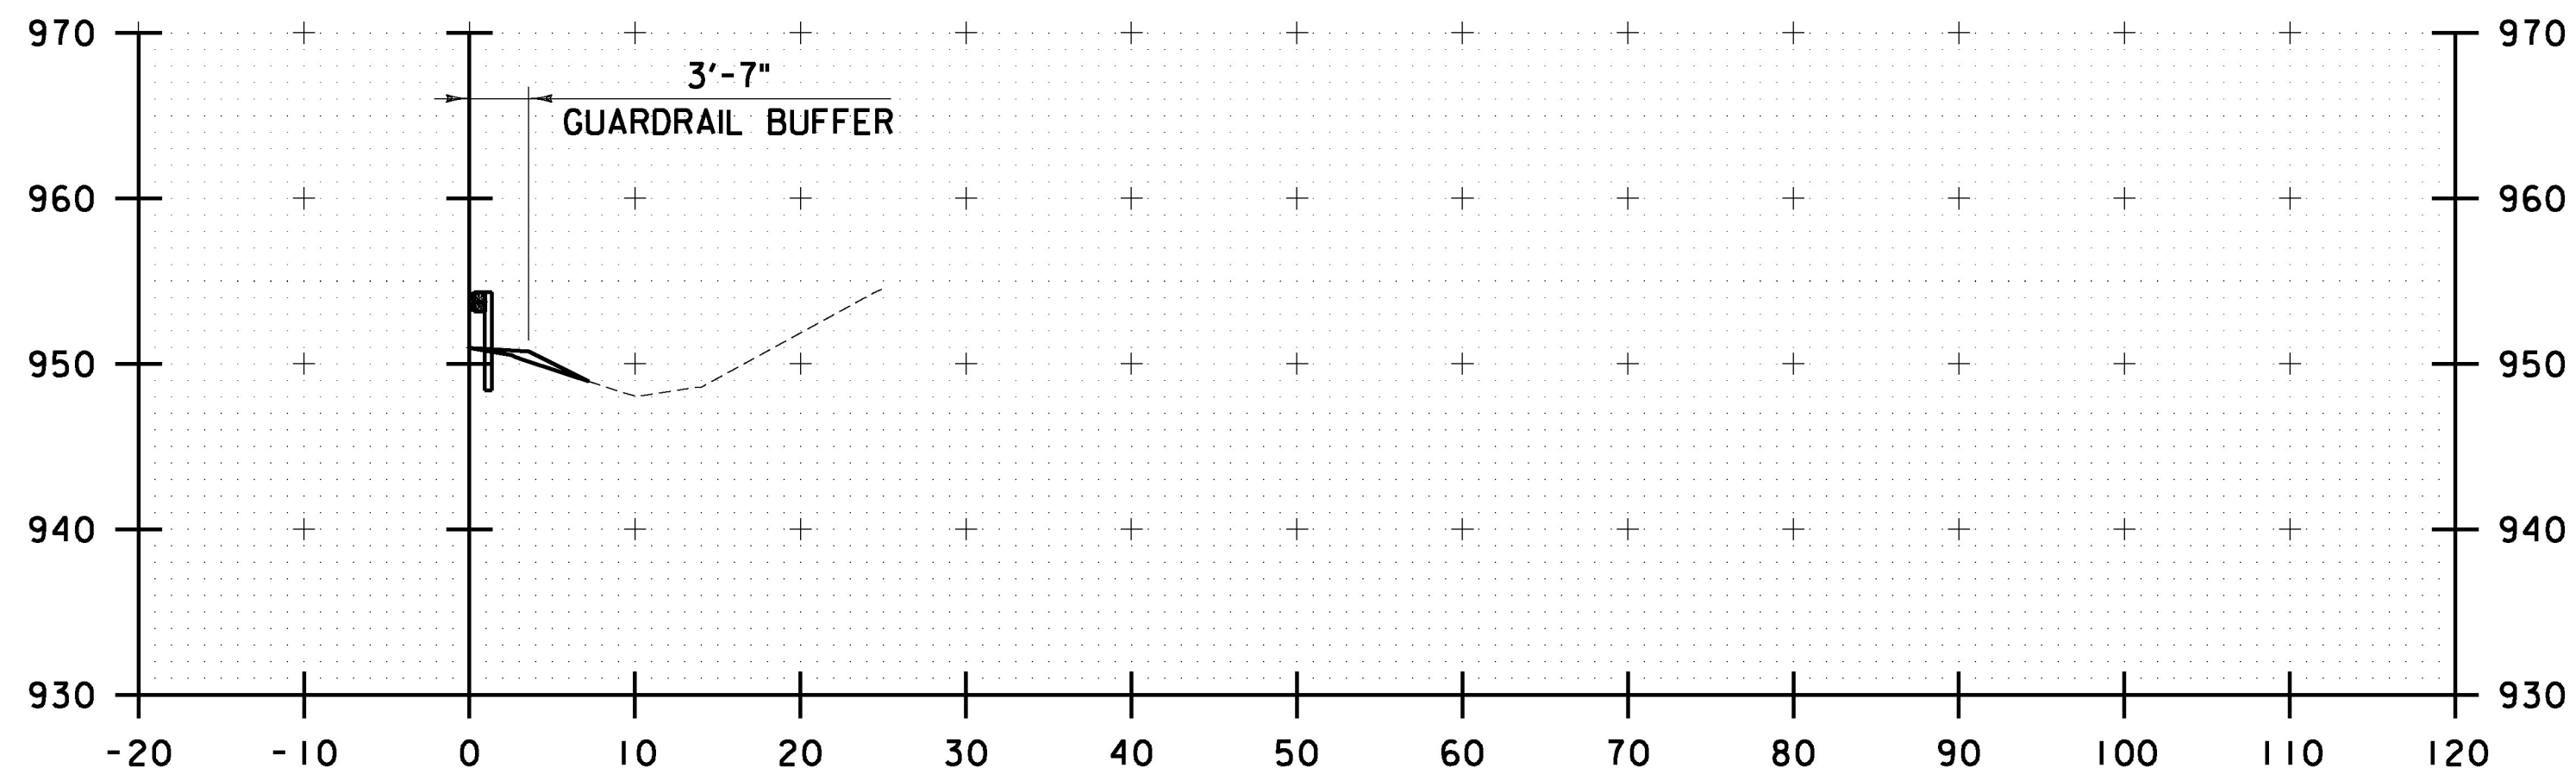


7525+00

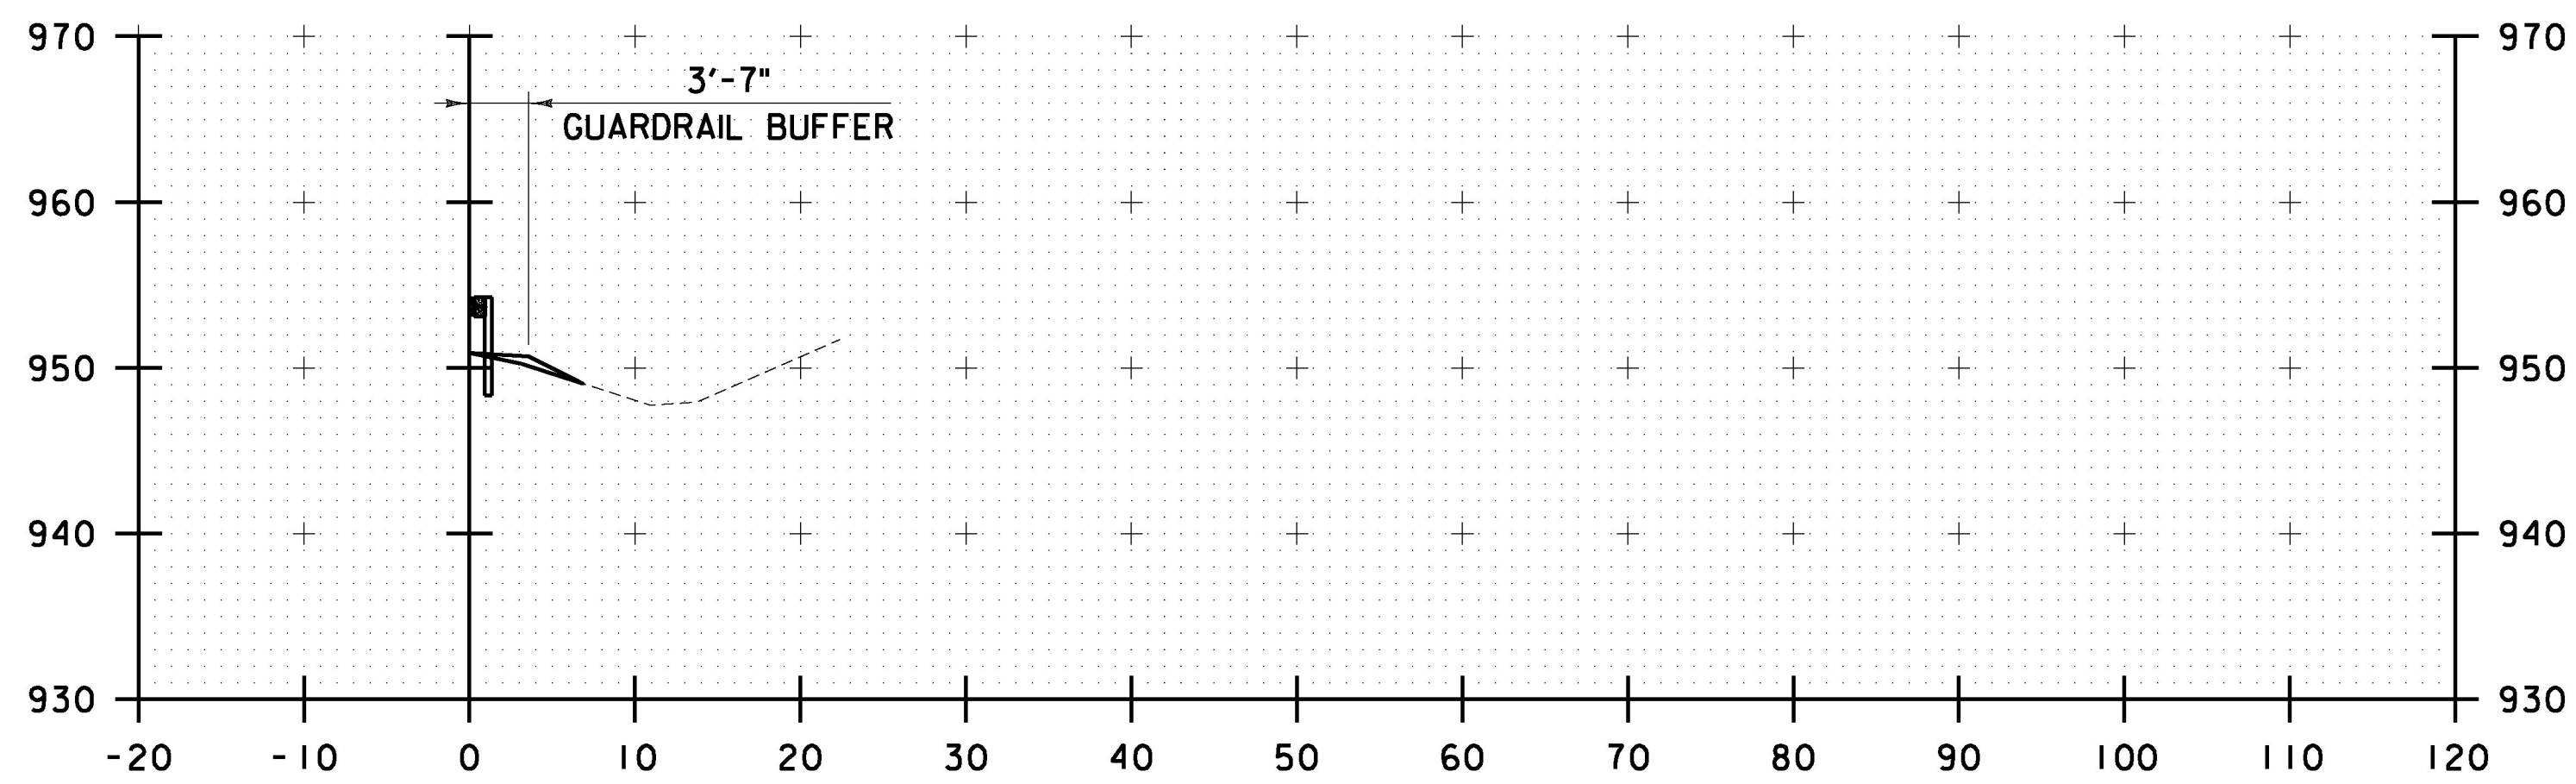

7524+53

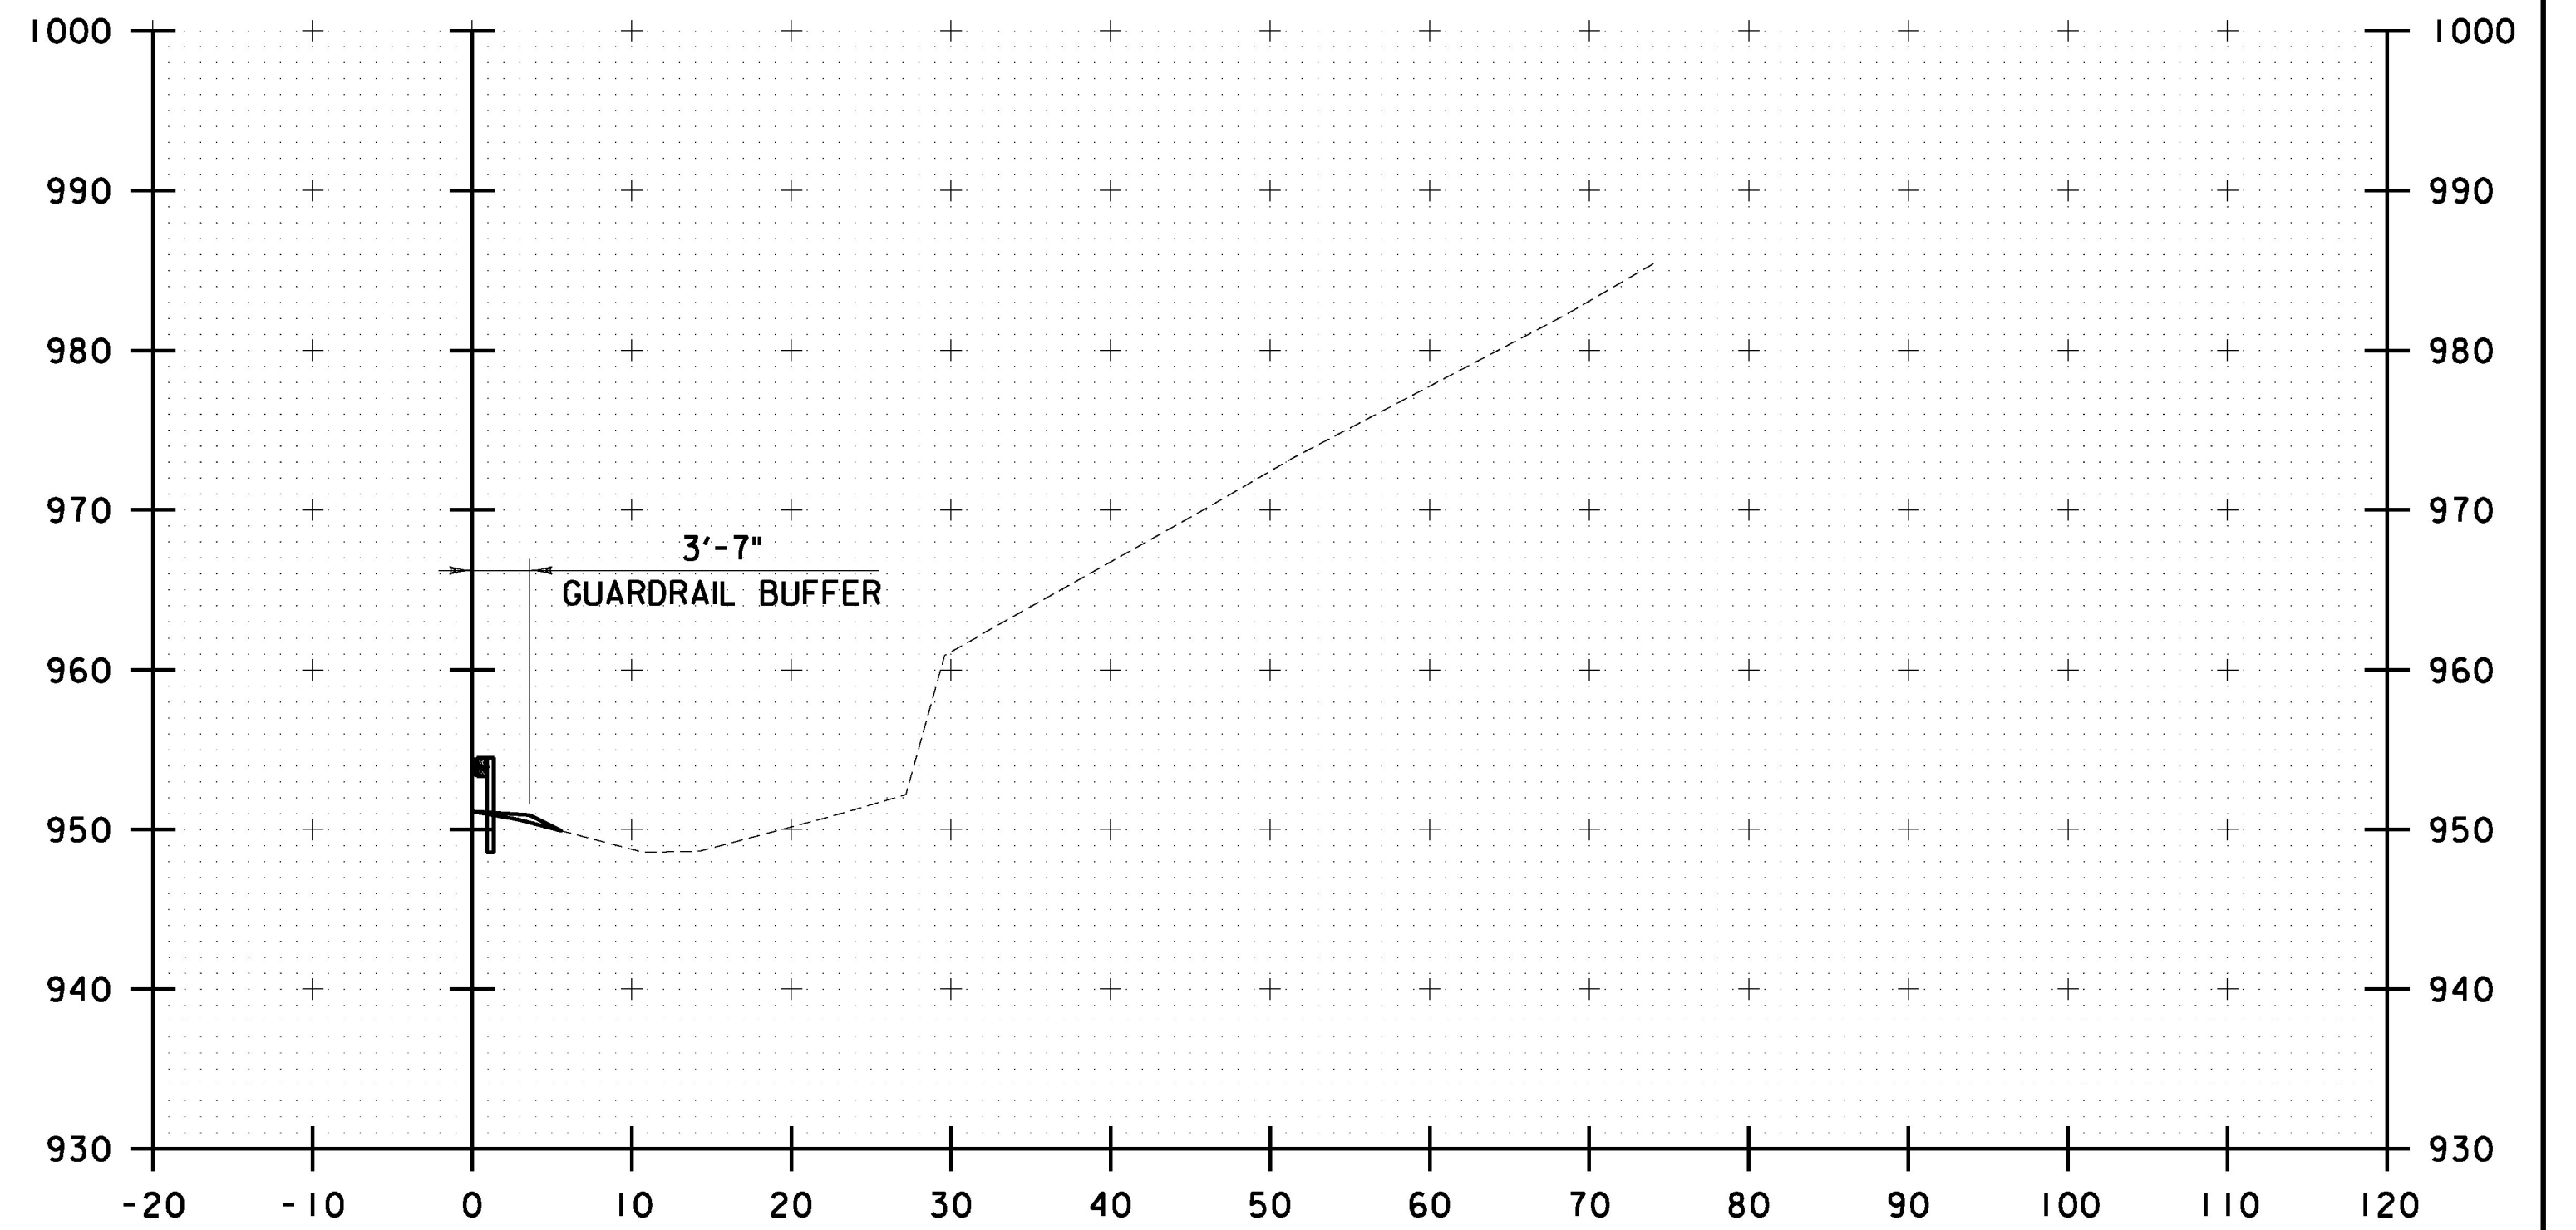


7526+00

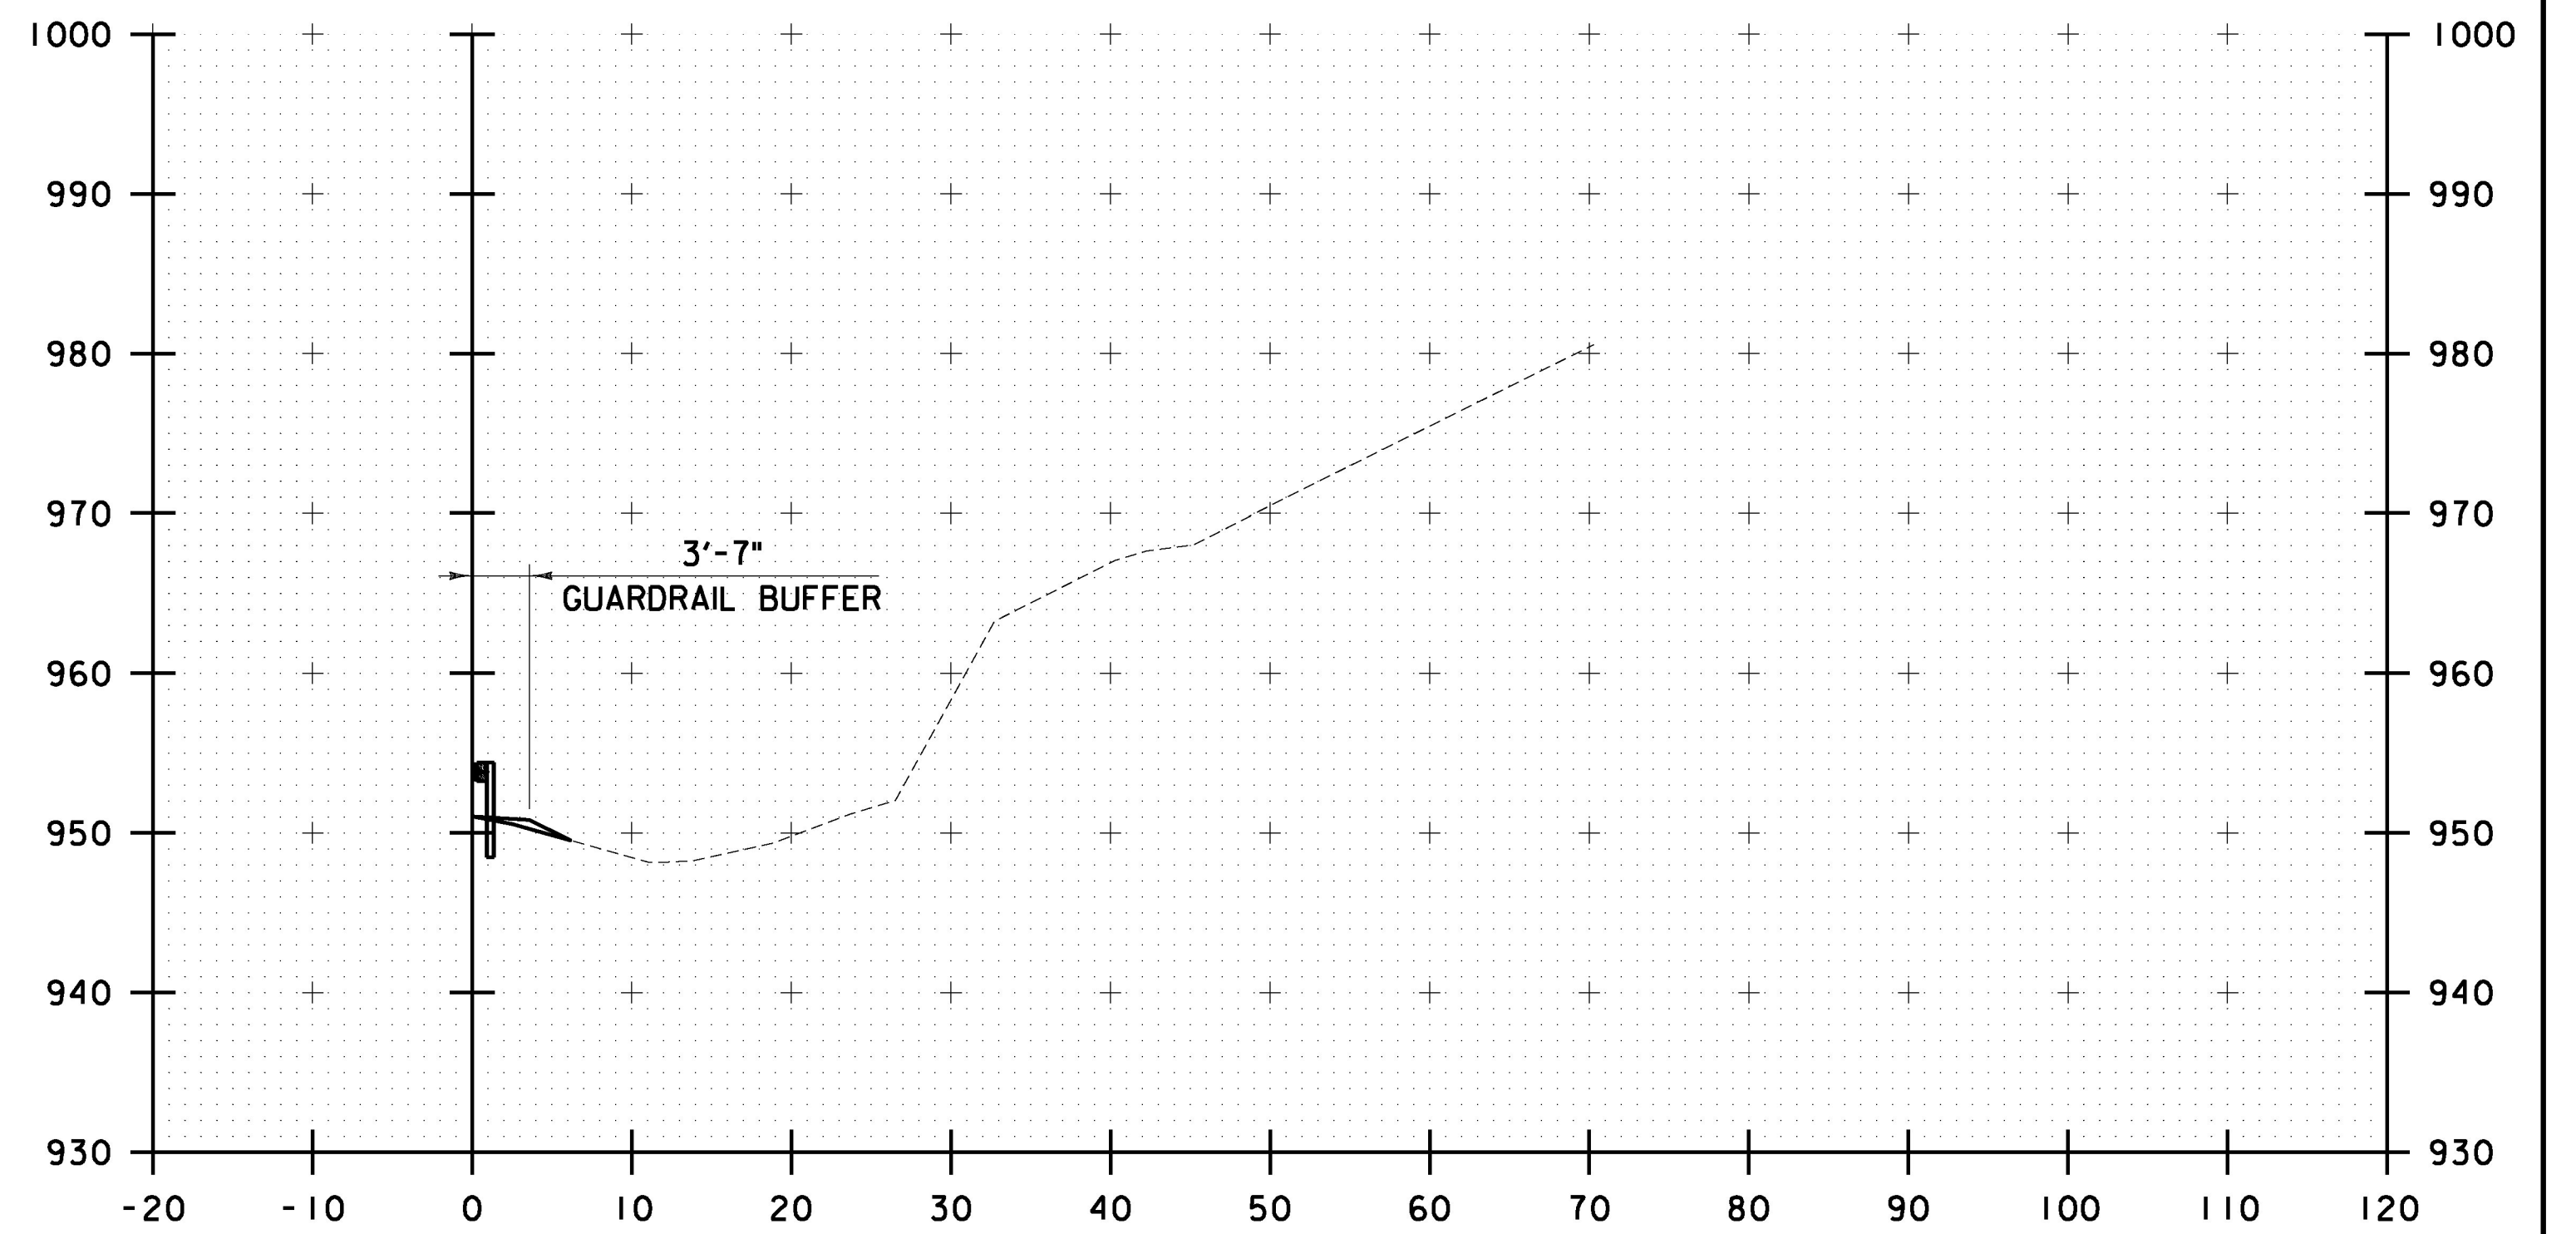

7525+50

STA. 7524+53 TO STA. 7526+00

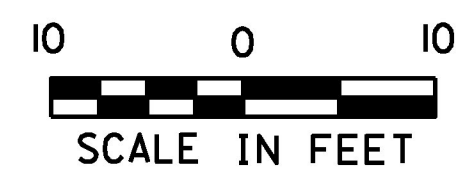

PROJECT NAME: LYNDON	PLOT DATE: 12/13/2016
PROJECT NUMBER: IM 091-3(51)	DRAWN BY: J. HEALD
FILE NAME: z13a370xsc.dgn	CHECKED BY: J. SHIELDS
PROJECT LEADER: D. GOZALKOWSKI	SHEET 24 OF 35
DESIGNED BY: J. OLSEN	
CROSS SECTIONS SHEET 1	