



FILE NAME = W:\P\cs\jessica\ANY\KA\29756\ADD\1\STN\13a370\Consult\taanta\Highway\13a370\ksc.dgn  
DATE/TIME = 12/13/2016  
USER = 5323

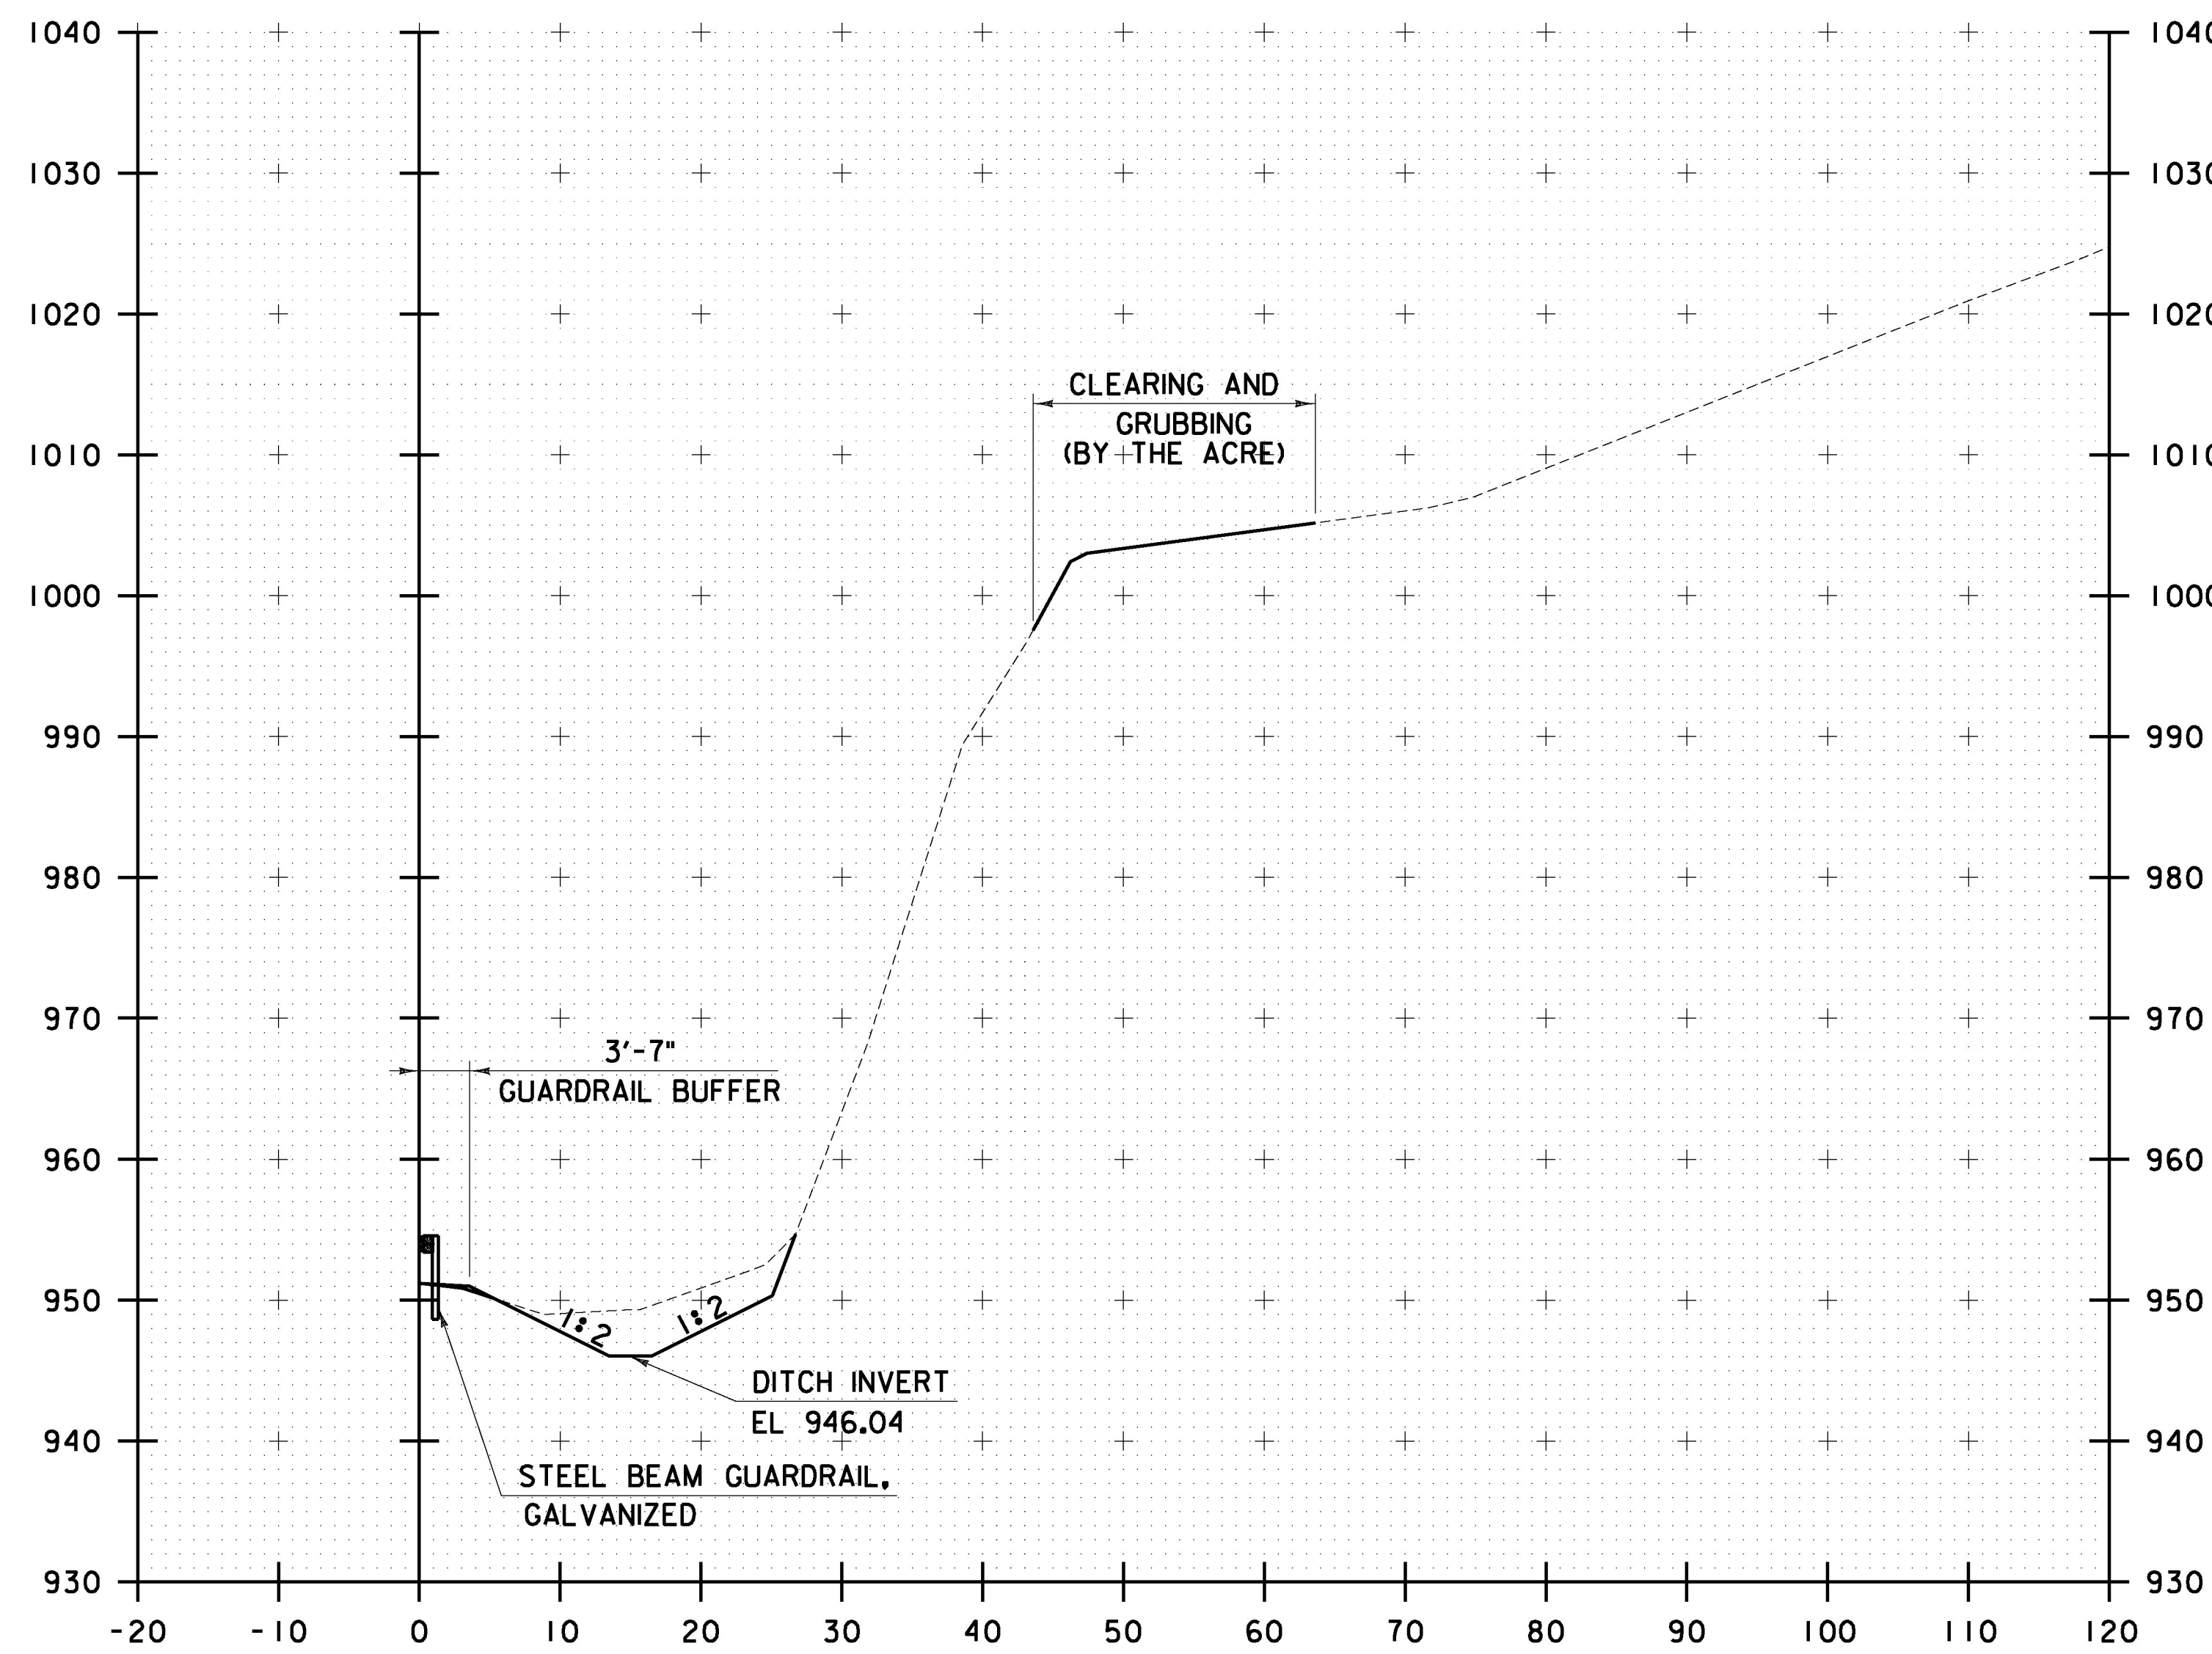


7527+50

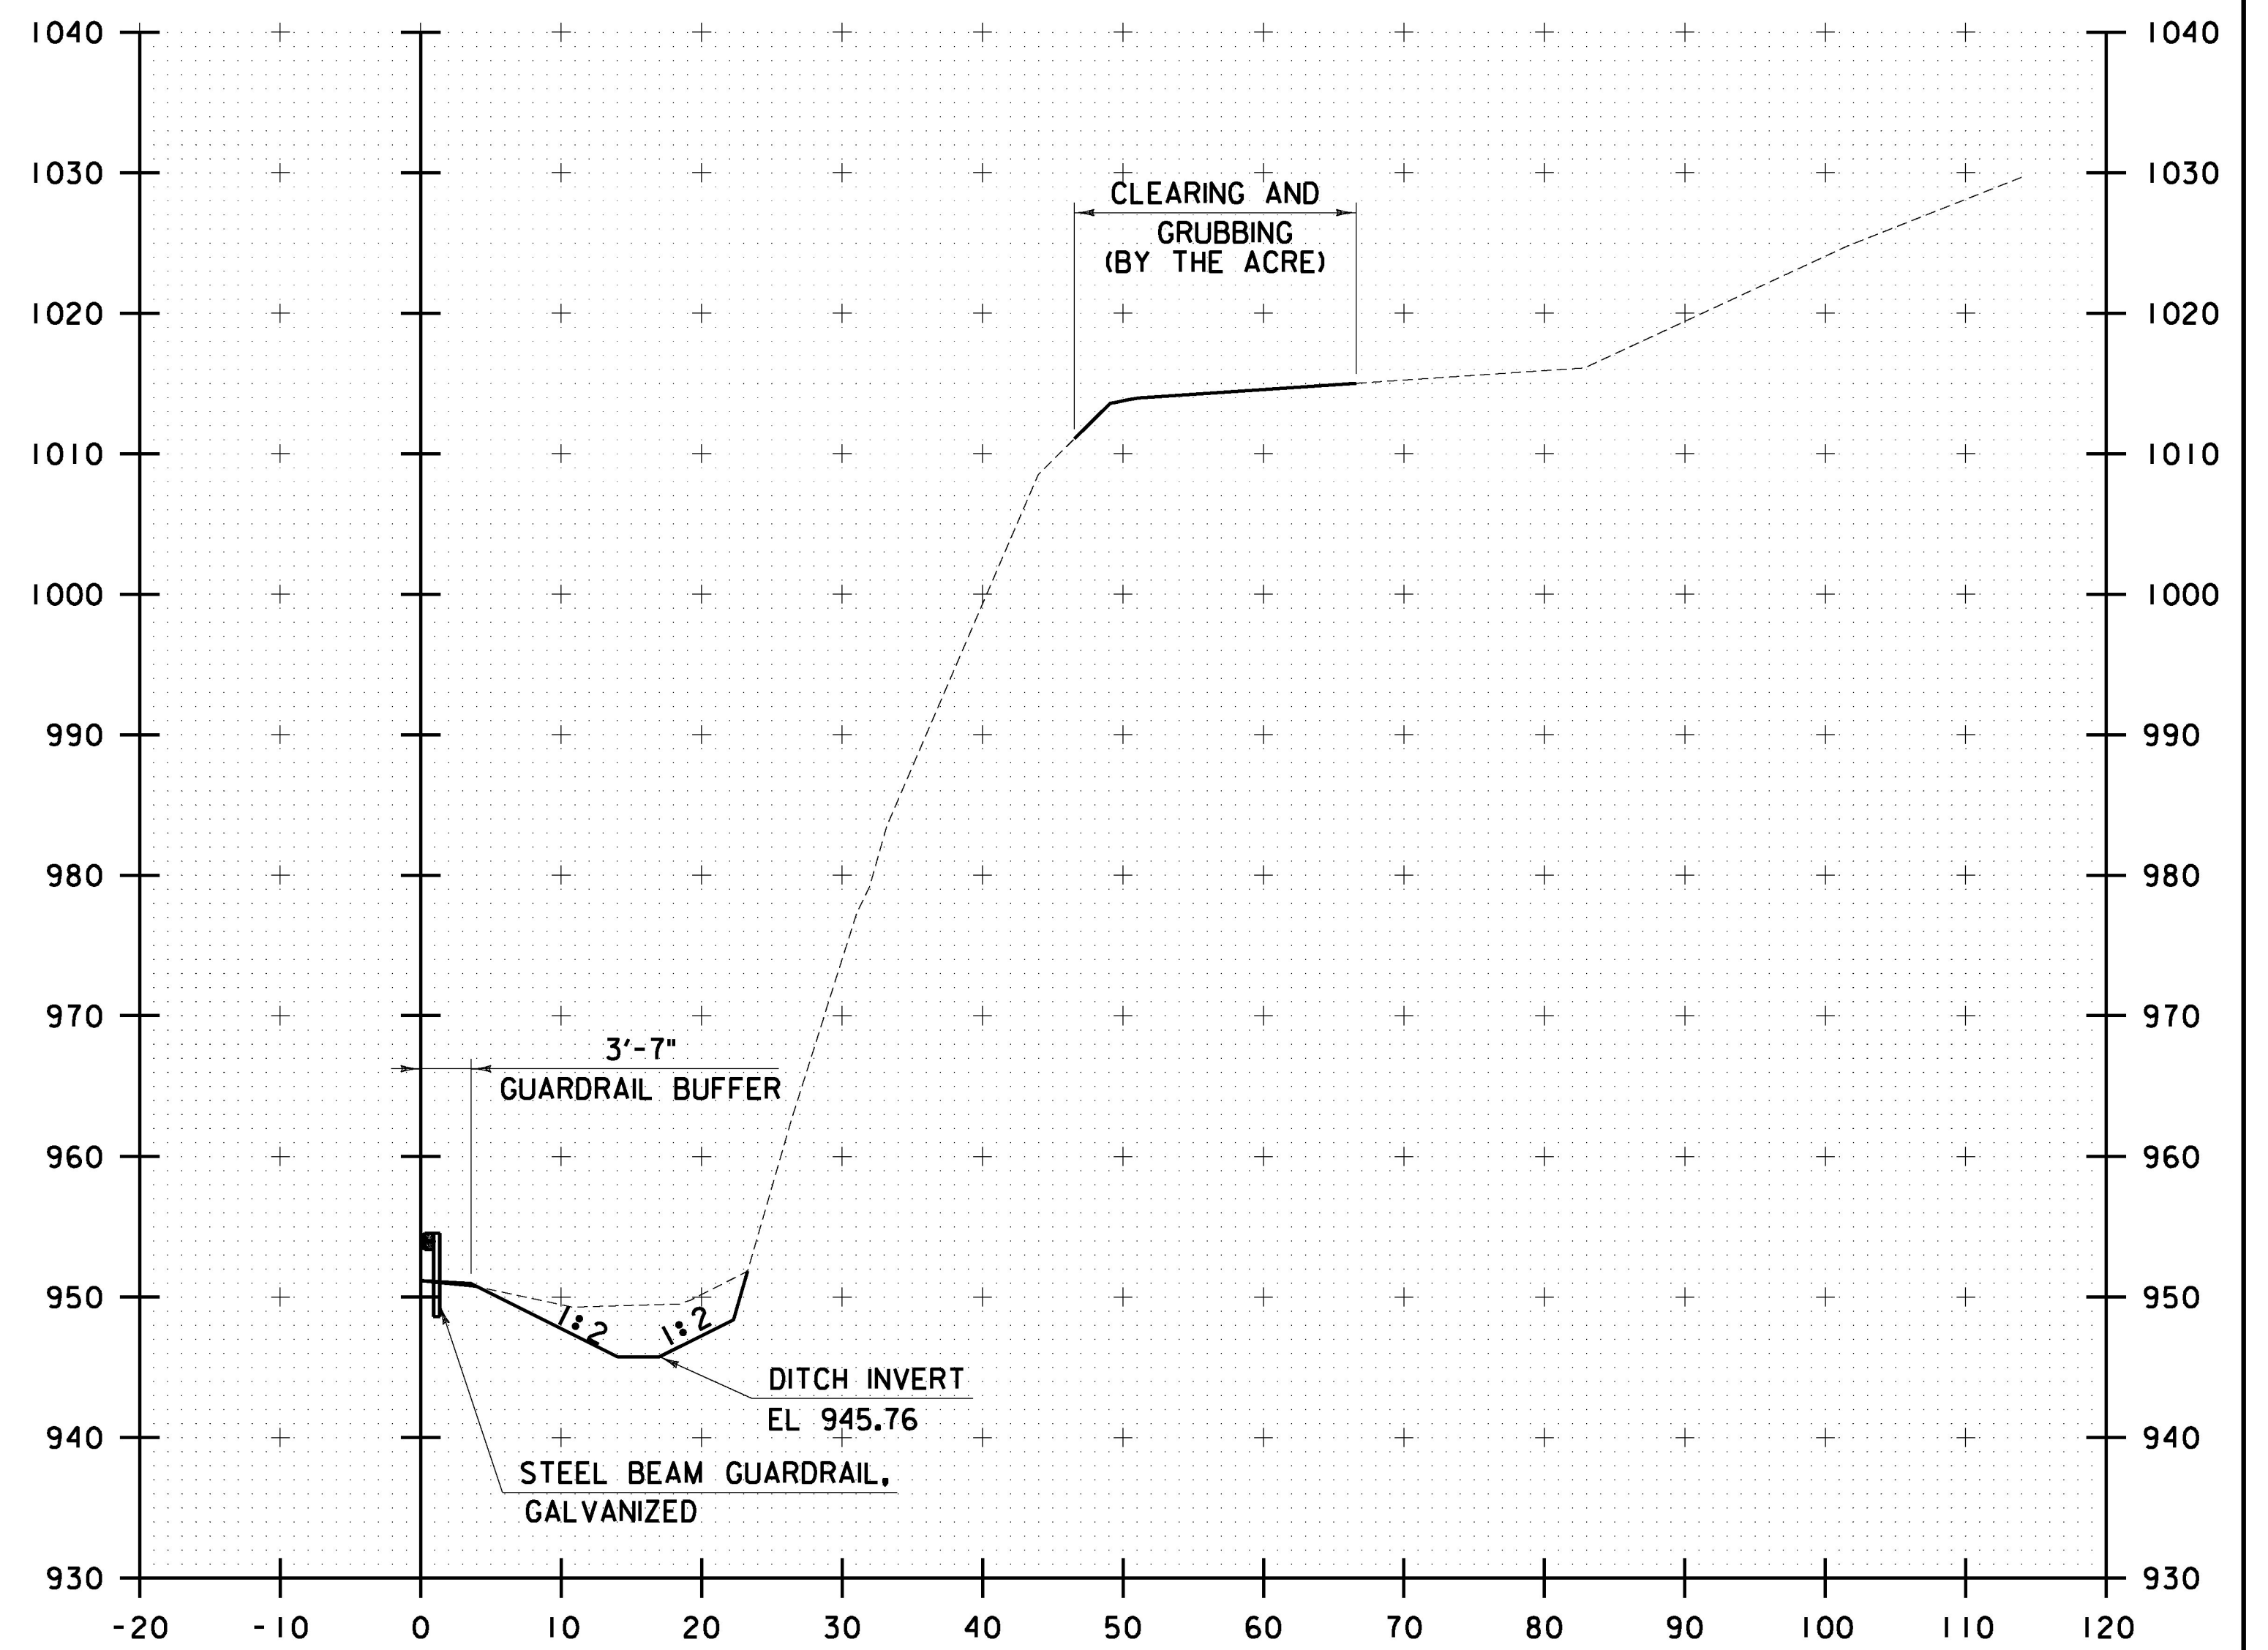

7528+00

STA. 7527+50 TO STA. 7528+00

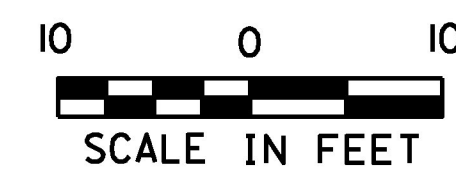

PROJECT NAME: LYNDON	PLOT DATE: 12/13/2016
PROJECT NUMBER: IM 091-3(51)	DRAWN BY: J. HEALD
FILE NAME: z13a370xsc.dgn	DESIGNED BY: J. OLSEN
CROSS SECTIONS SHEET 3	CHECKED BY: J. SHIELDS
	SHEET 26 OF 35