


7530+50

7531+00

STA. 7530+50 TO STA. 7531+11

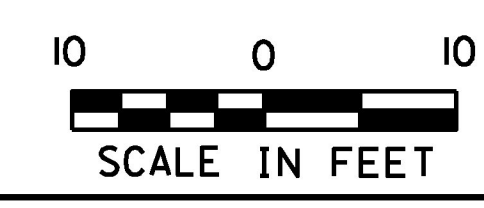

PROJECT NAME: LYNDON	
PROJECT NUMBER: IM 091-3(51)	
FILE NAME: z13a370xsc.dgn	PLOT DATE: 12/13/2016
PROJECT LEADER: D. GOZALKOWSKI	DRAWN BY: J. HEALD
DESIGNED BY: J. OLSEN	CHECKED BY: J. SHIELDS
CROSS SECTIONS SHEET 6	SHEET 29 OF 35

FILE NAME = W:\P\cs\_jessica\ANY\KA\29752\CADD\1\STN13a370\CrossSections\Highway\z13a370xsc.dgn  
 DATE/TIME = 12/13/2016  
 USER = 5323