



FILE NAME = W:\P\cs\jessica\ANY\KA\29752\CADD\1\STN\13a\370\Consult\taanta\Highway\213a\370\ksc.dgn  
 DATE/TIME = 12/13/2016  
 USER = 5323

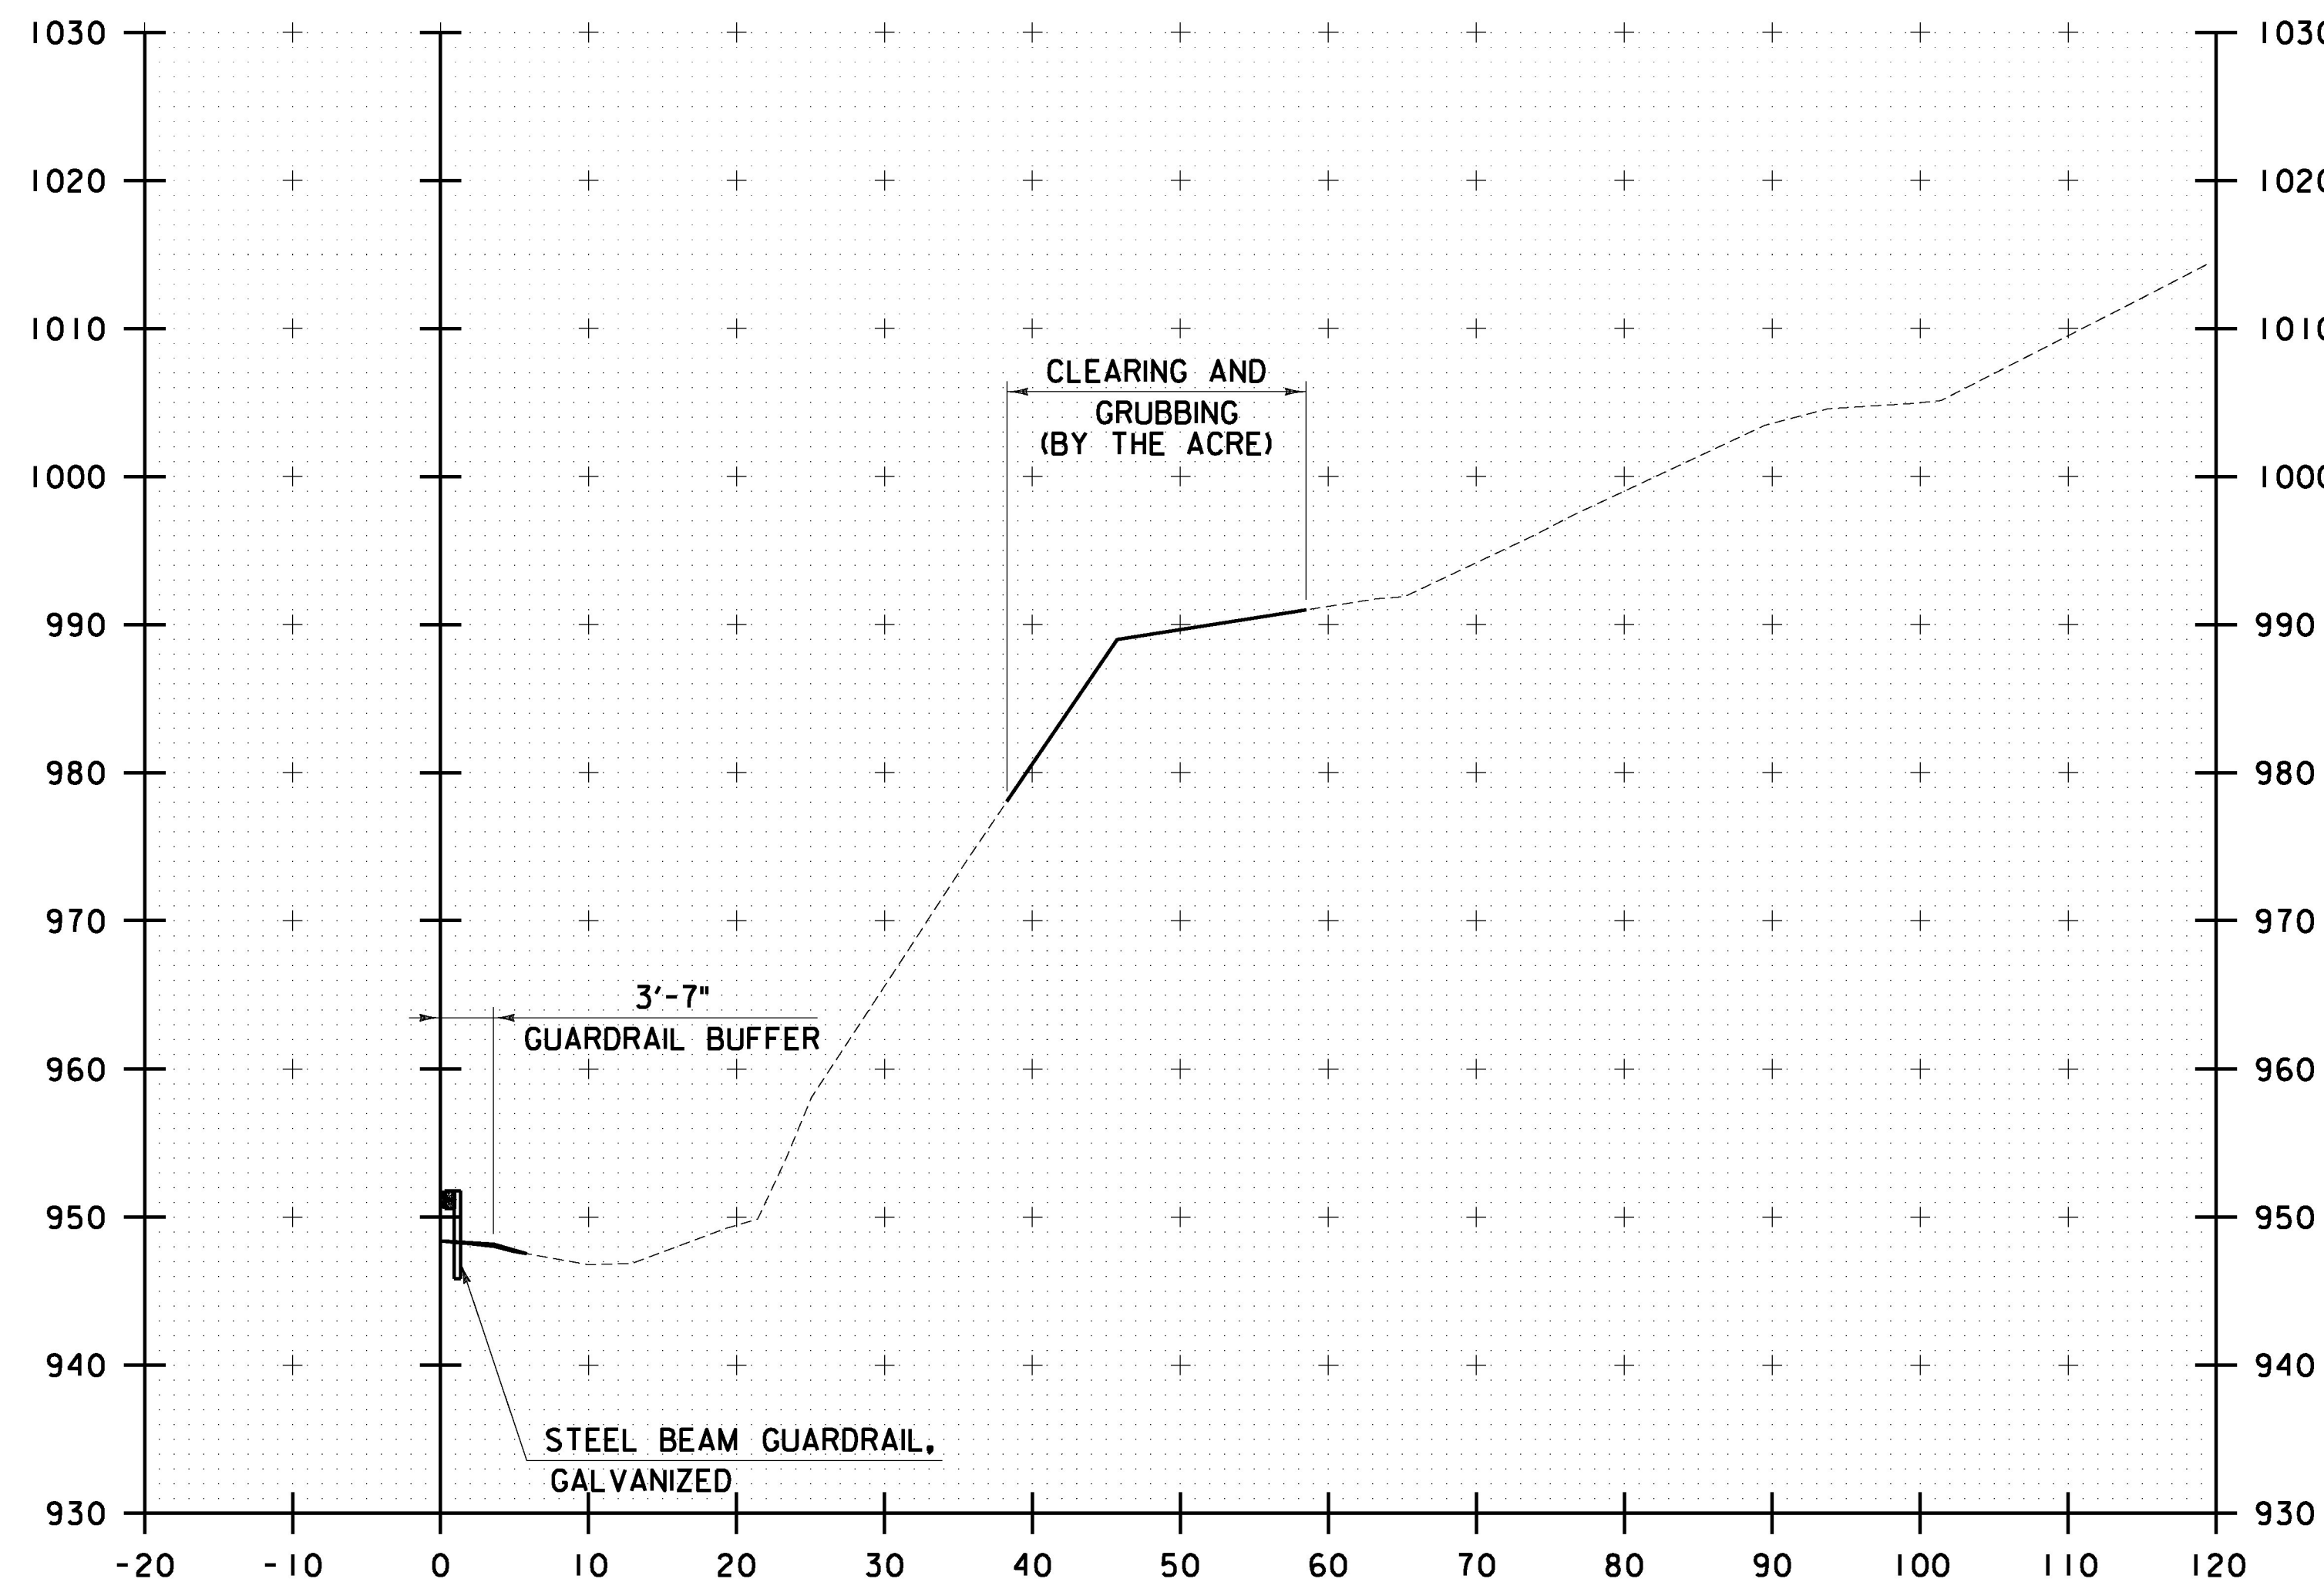


7531+50

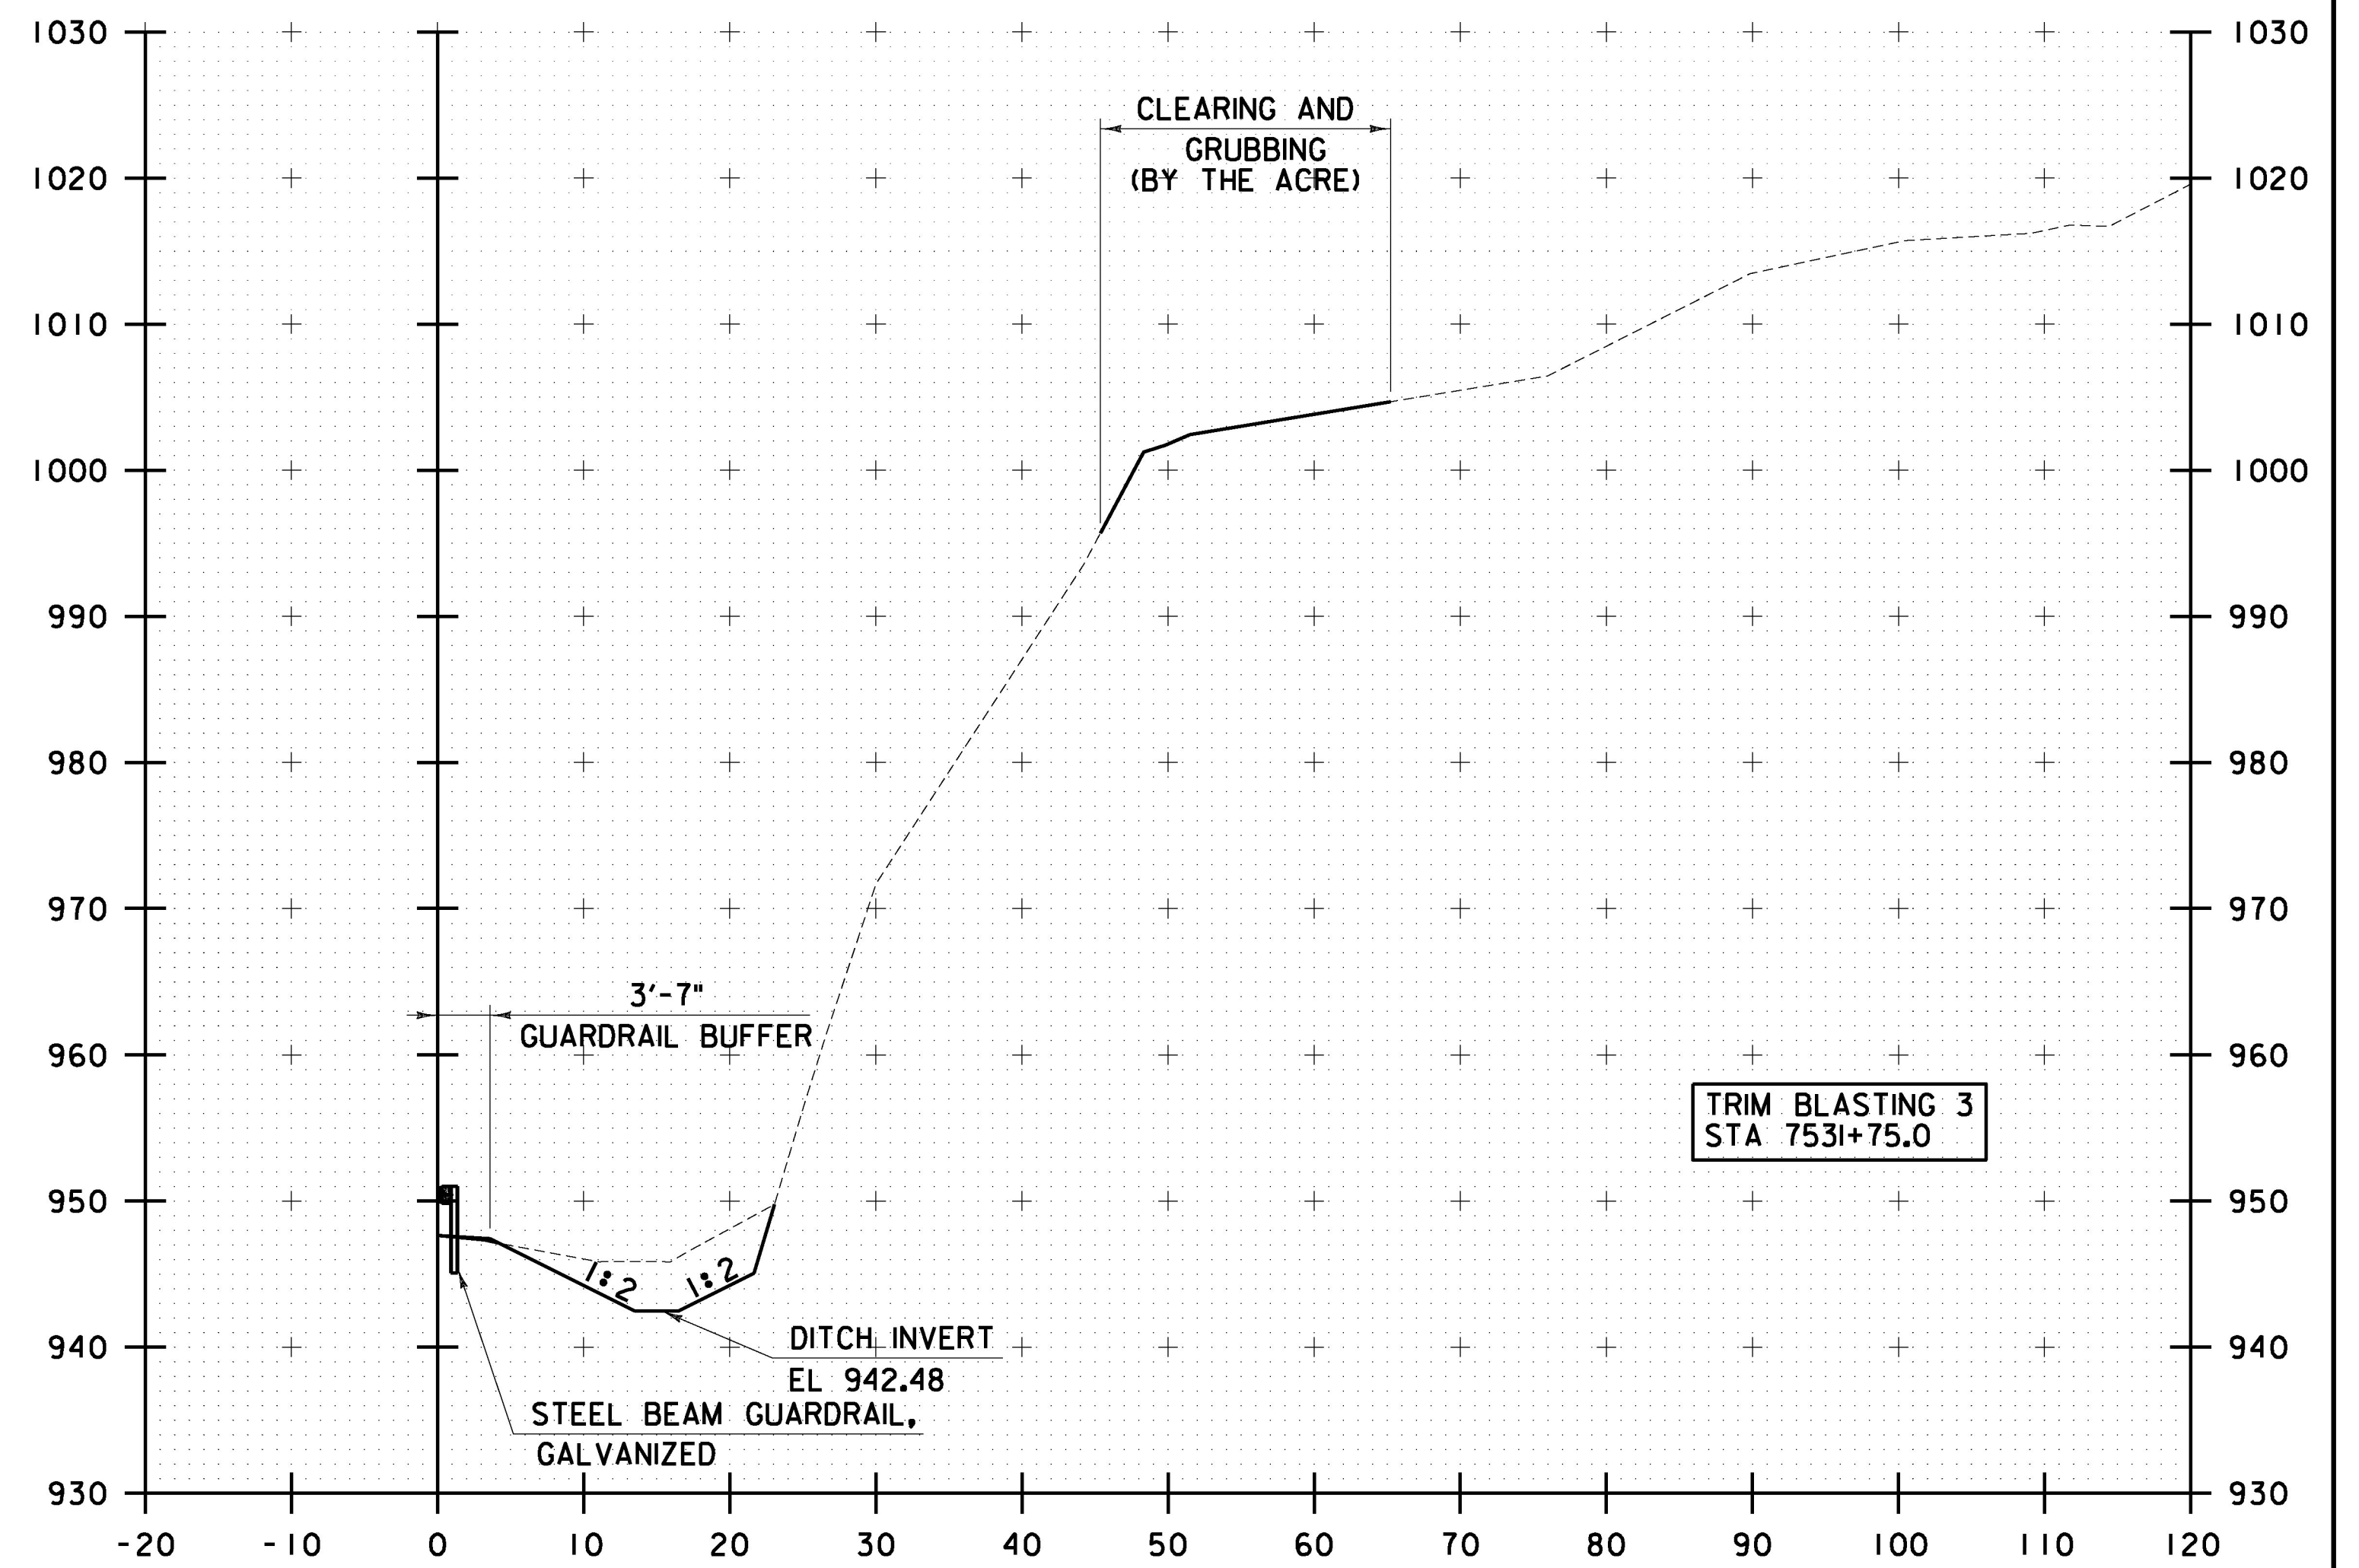

7532+00

STA. 7531+50 TO STA. 7532+00

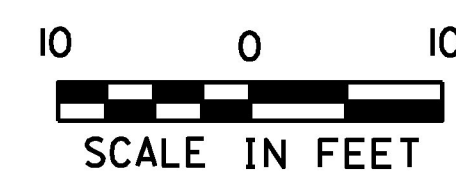

PROJECT NAME: LYNDON	
PROJECT NUMBER: IM 091-3(51)	
FILE NAME: z13a370xsc.dgn	PLOT DATE: 12/13/2016
PROJECT LEADER: D. GOZALKOWSKI	DRAWN BY: J. HEALD
DESIGNED BY: J. OLSEN	CHECKED BY: J. SHIELDS
CROSS SECTIONS SHEET 7	SHEET 30 OF 35