



FILE NAME = W:\P\cs\res\ANY\KA\29752\CADD\15\TIN13a370\Consult\taanta\Highway\213a370xsc.dgn
 DATE/TIME = 12/13/2016
 USER = 5323

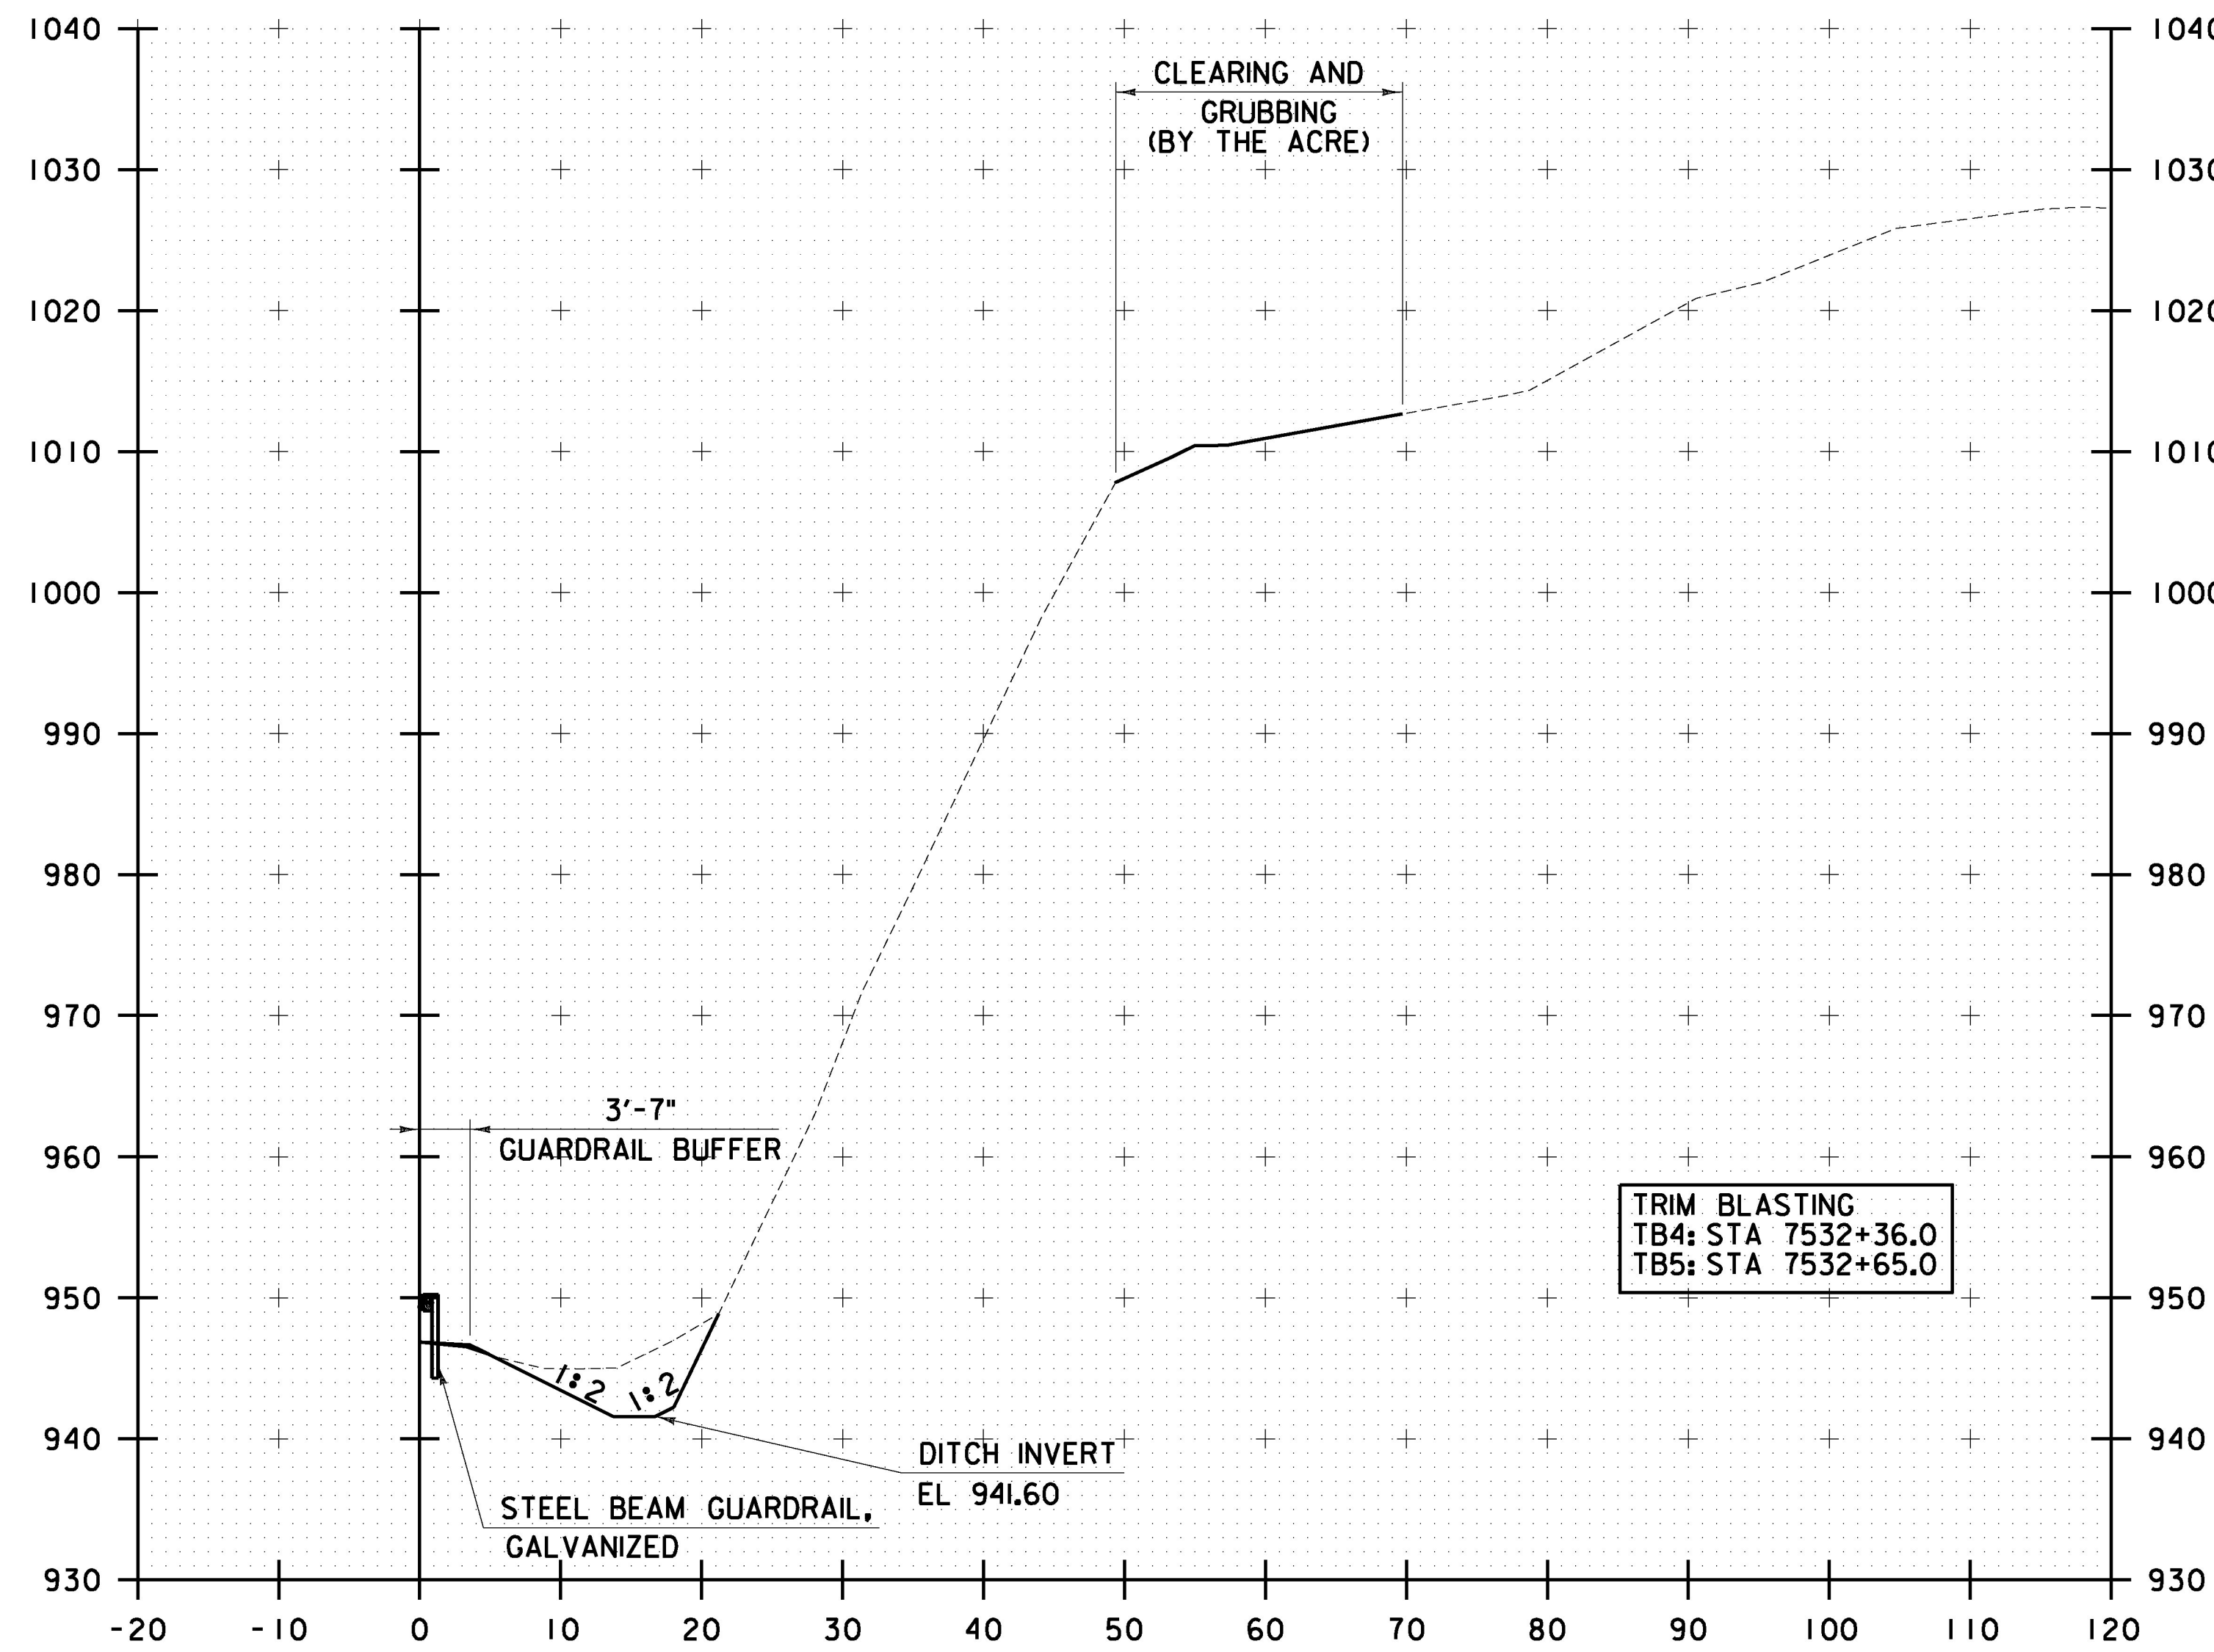


7532+50

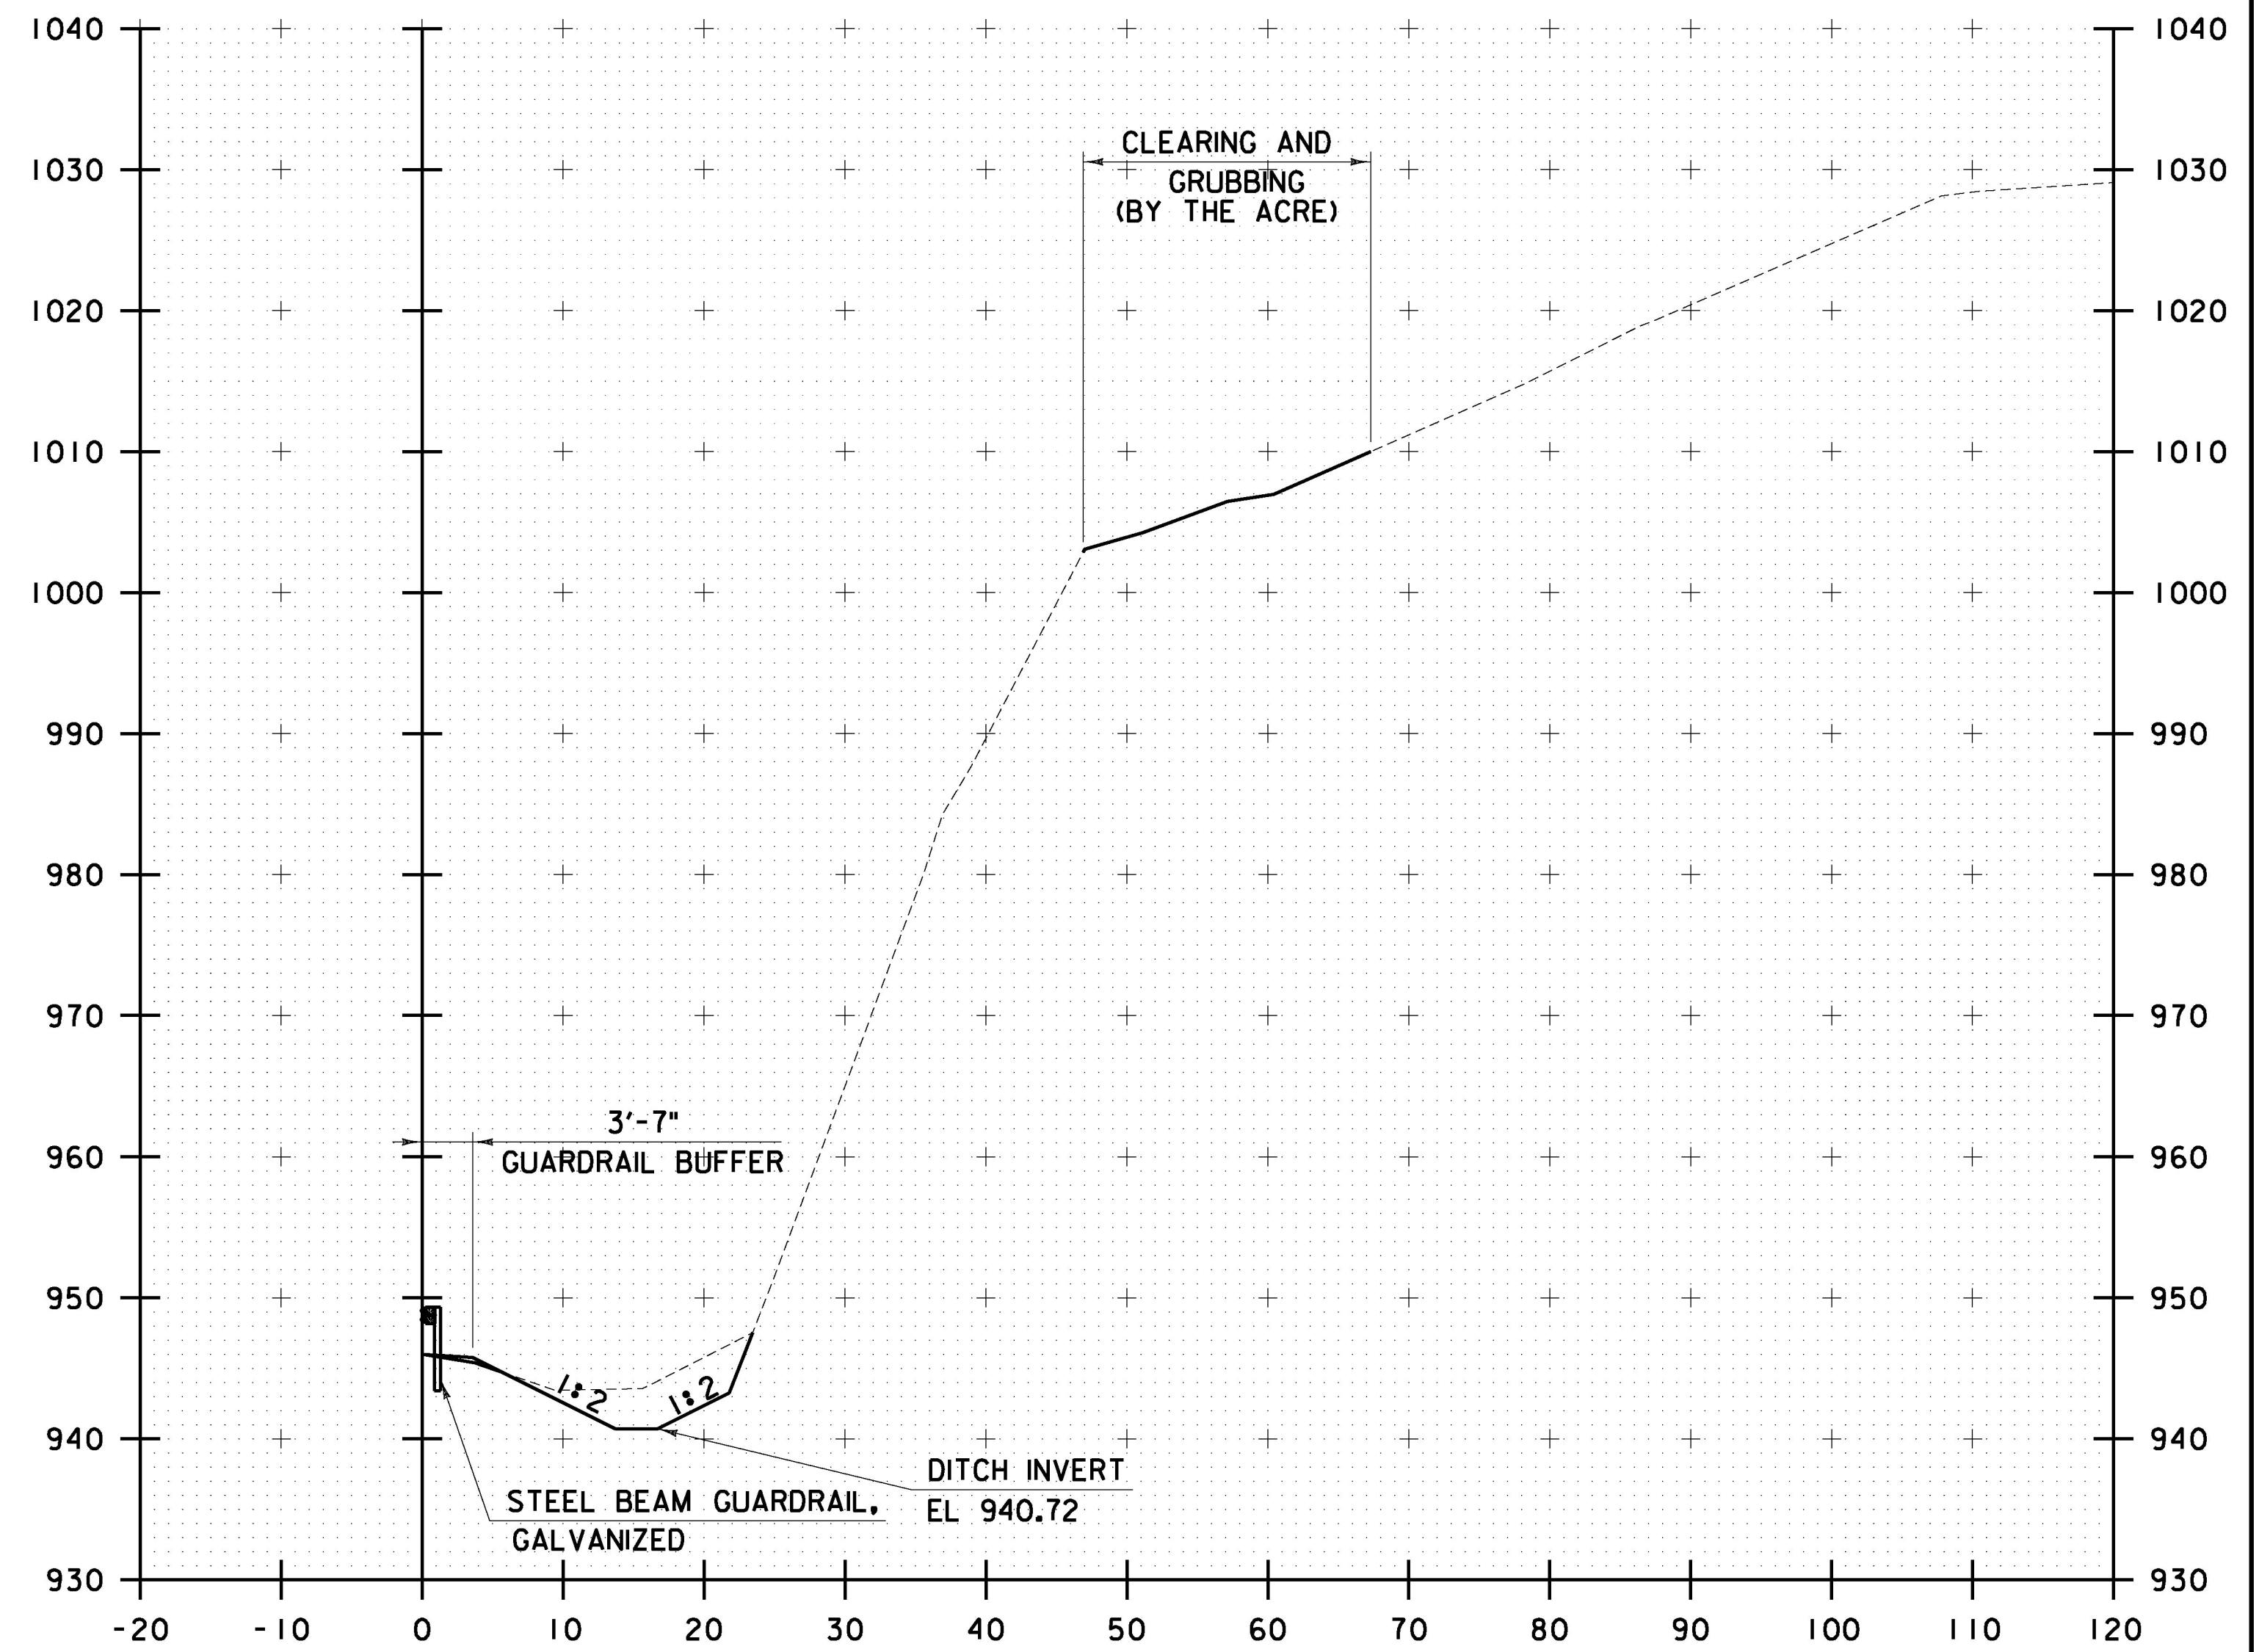

7533+00

STA. 7532+50 TO STA. 7533+00

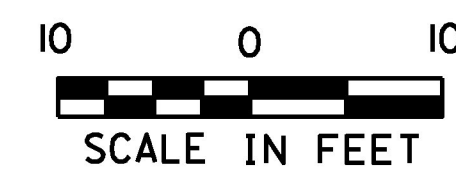

PROJECT NAME: LYNDON	
PROJECT NUMBER: IM 091-3(51)	
FILE NAME: z13a370xsc.dgn	PLOT DATE: 12/13/2016
PROJECT LEADER: D. GOZALKOWSKI	DRAWN BY: J. HEALD
DESIGNED BY: J. OLSEN	CHECKED BY: J. SHIELDS
CROSS SECTIONS SHEET 8	SHEET 31 OF 35