



FILE NAME = W:\P\cs\res\cs\ANY\KA\29752\ADD\1\STN\13a370\Consult\taanta\Highway\213a370xsc.dgn  
 DATE/TIME = 12/13/2016  
 USER = 5323

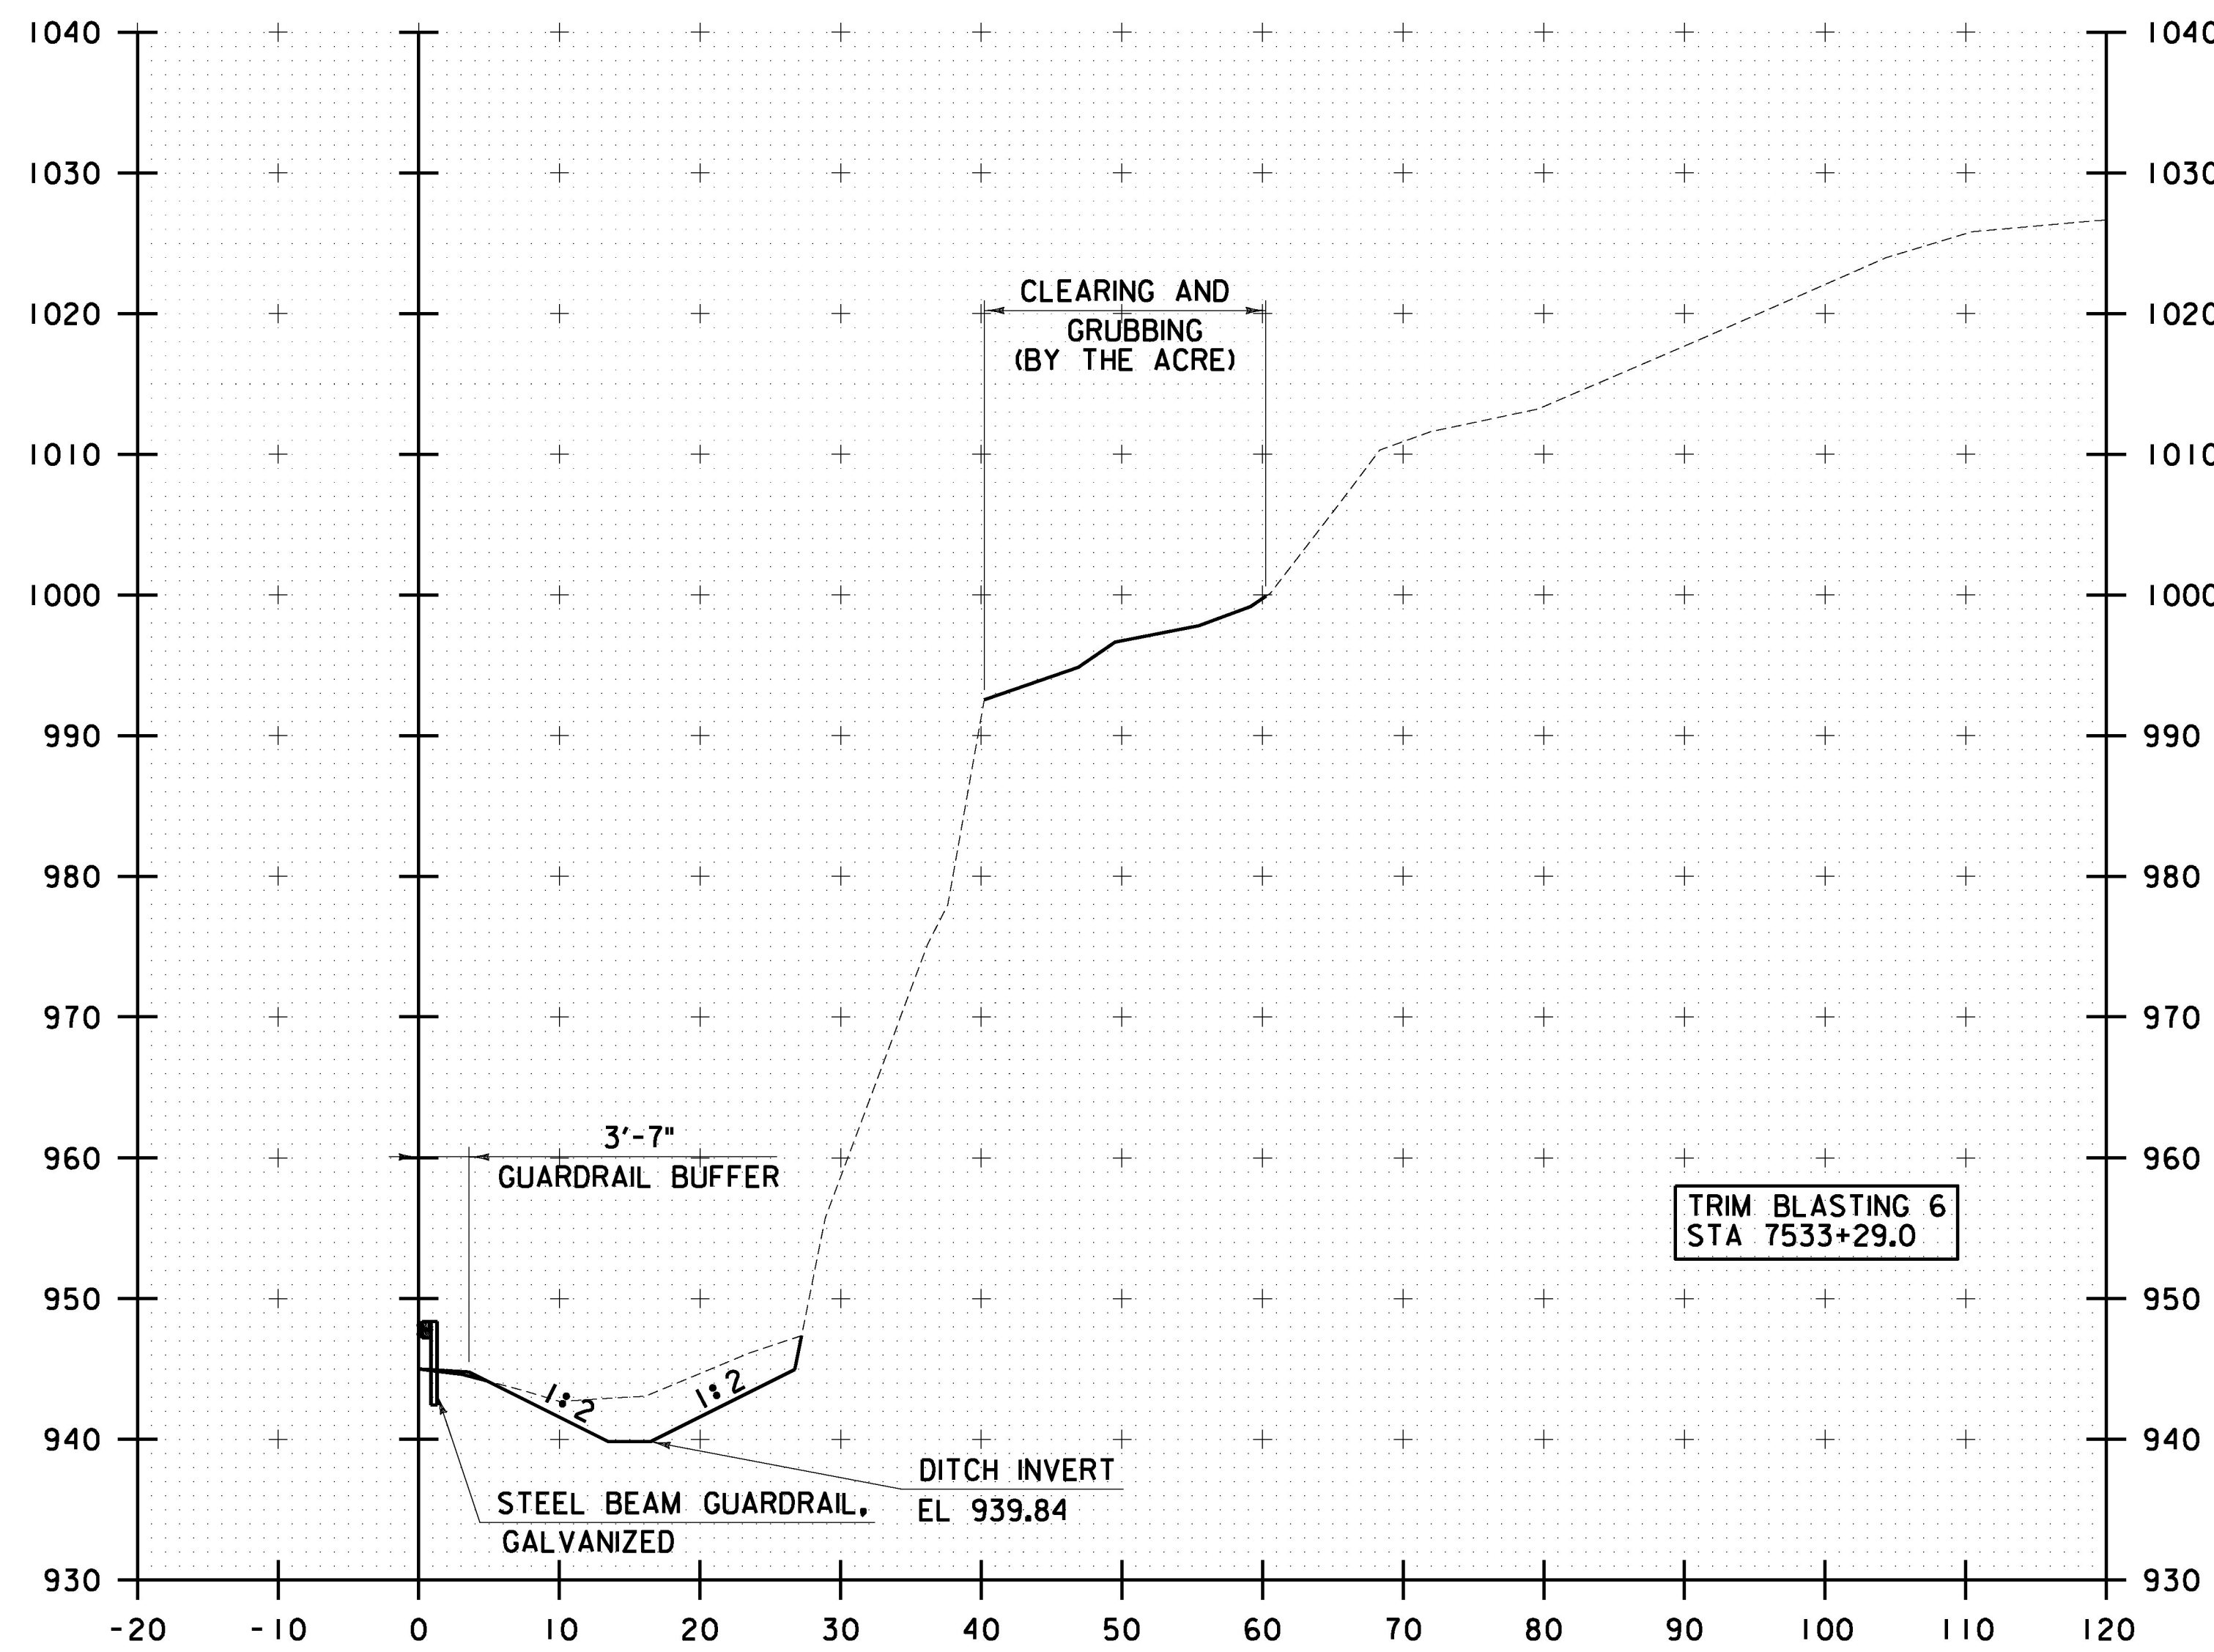


7533+50

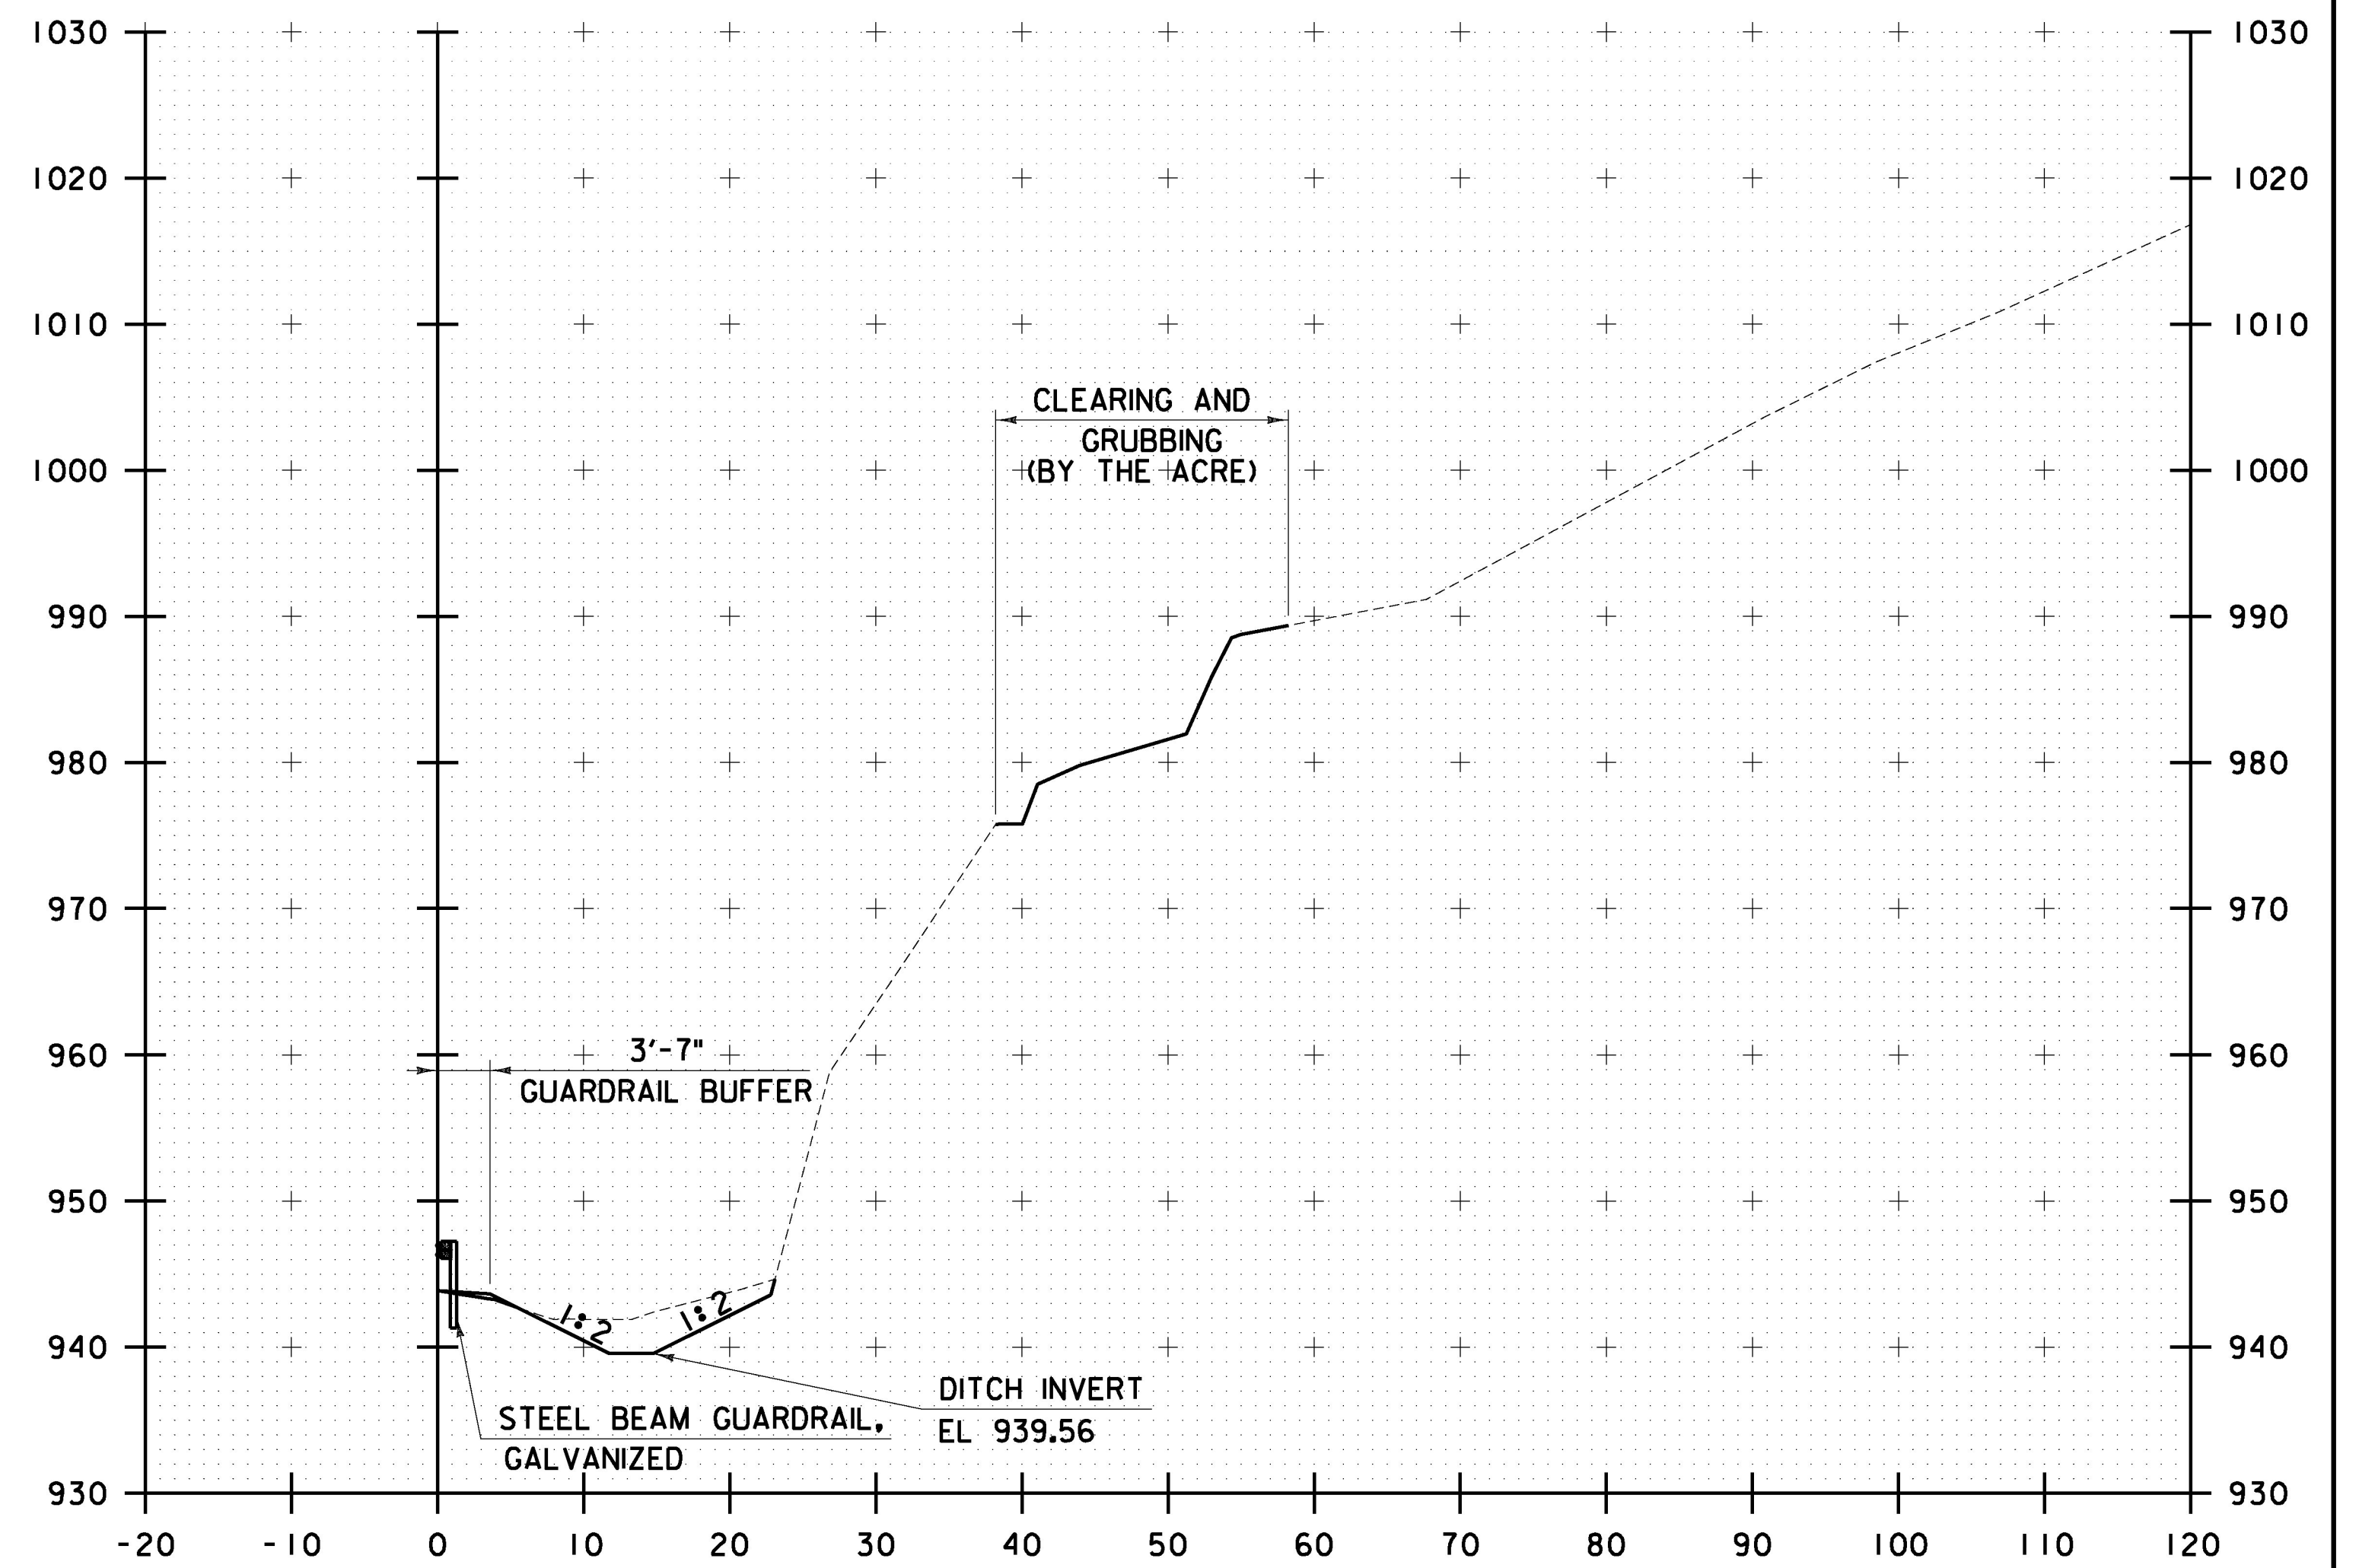

7534+00

STA. 7533+50 TO STA. 7534+00

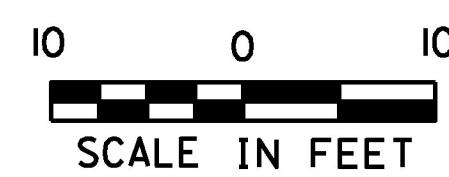

PROJECT NAME: LYNDON	
PROJECT NUMBER: IM 091-3(51)	
FILE NAME: z13a370xsc.dgn	PLOT DATE: 12/13/2016
PROJECT LEADER: D. GOZALKOWSKI	DRAWN BY: J. HEALD
DESIGNED BY: J. OLSEN	CHECKED BY: J. SHIELDS
CROSS SECTIONS SHEET 9	SHEET 32 OF 35