



FILE NAME = W:\P\cs\jessica\ANY\KA\29752\CADD\15\TNT\15a\378\Consult\taanta\Highway\213a\378\ksc.dgn  
 DATE/TIME = 12/13/2016  
 USER = 5323

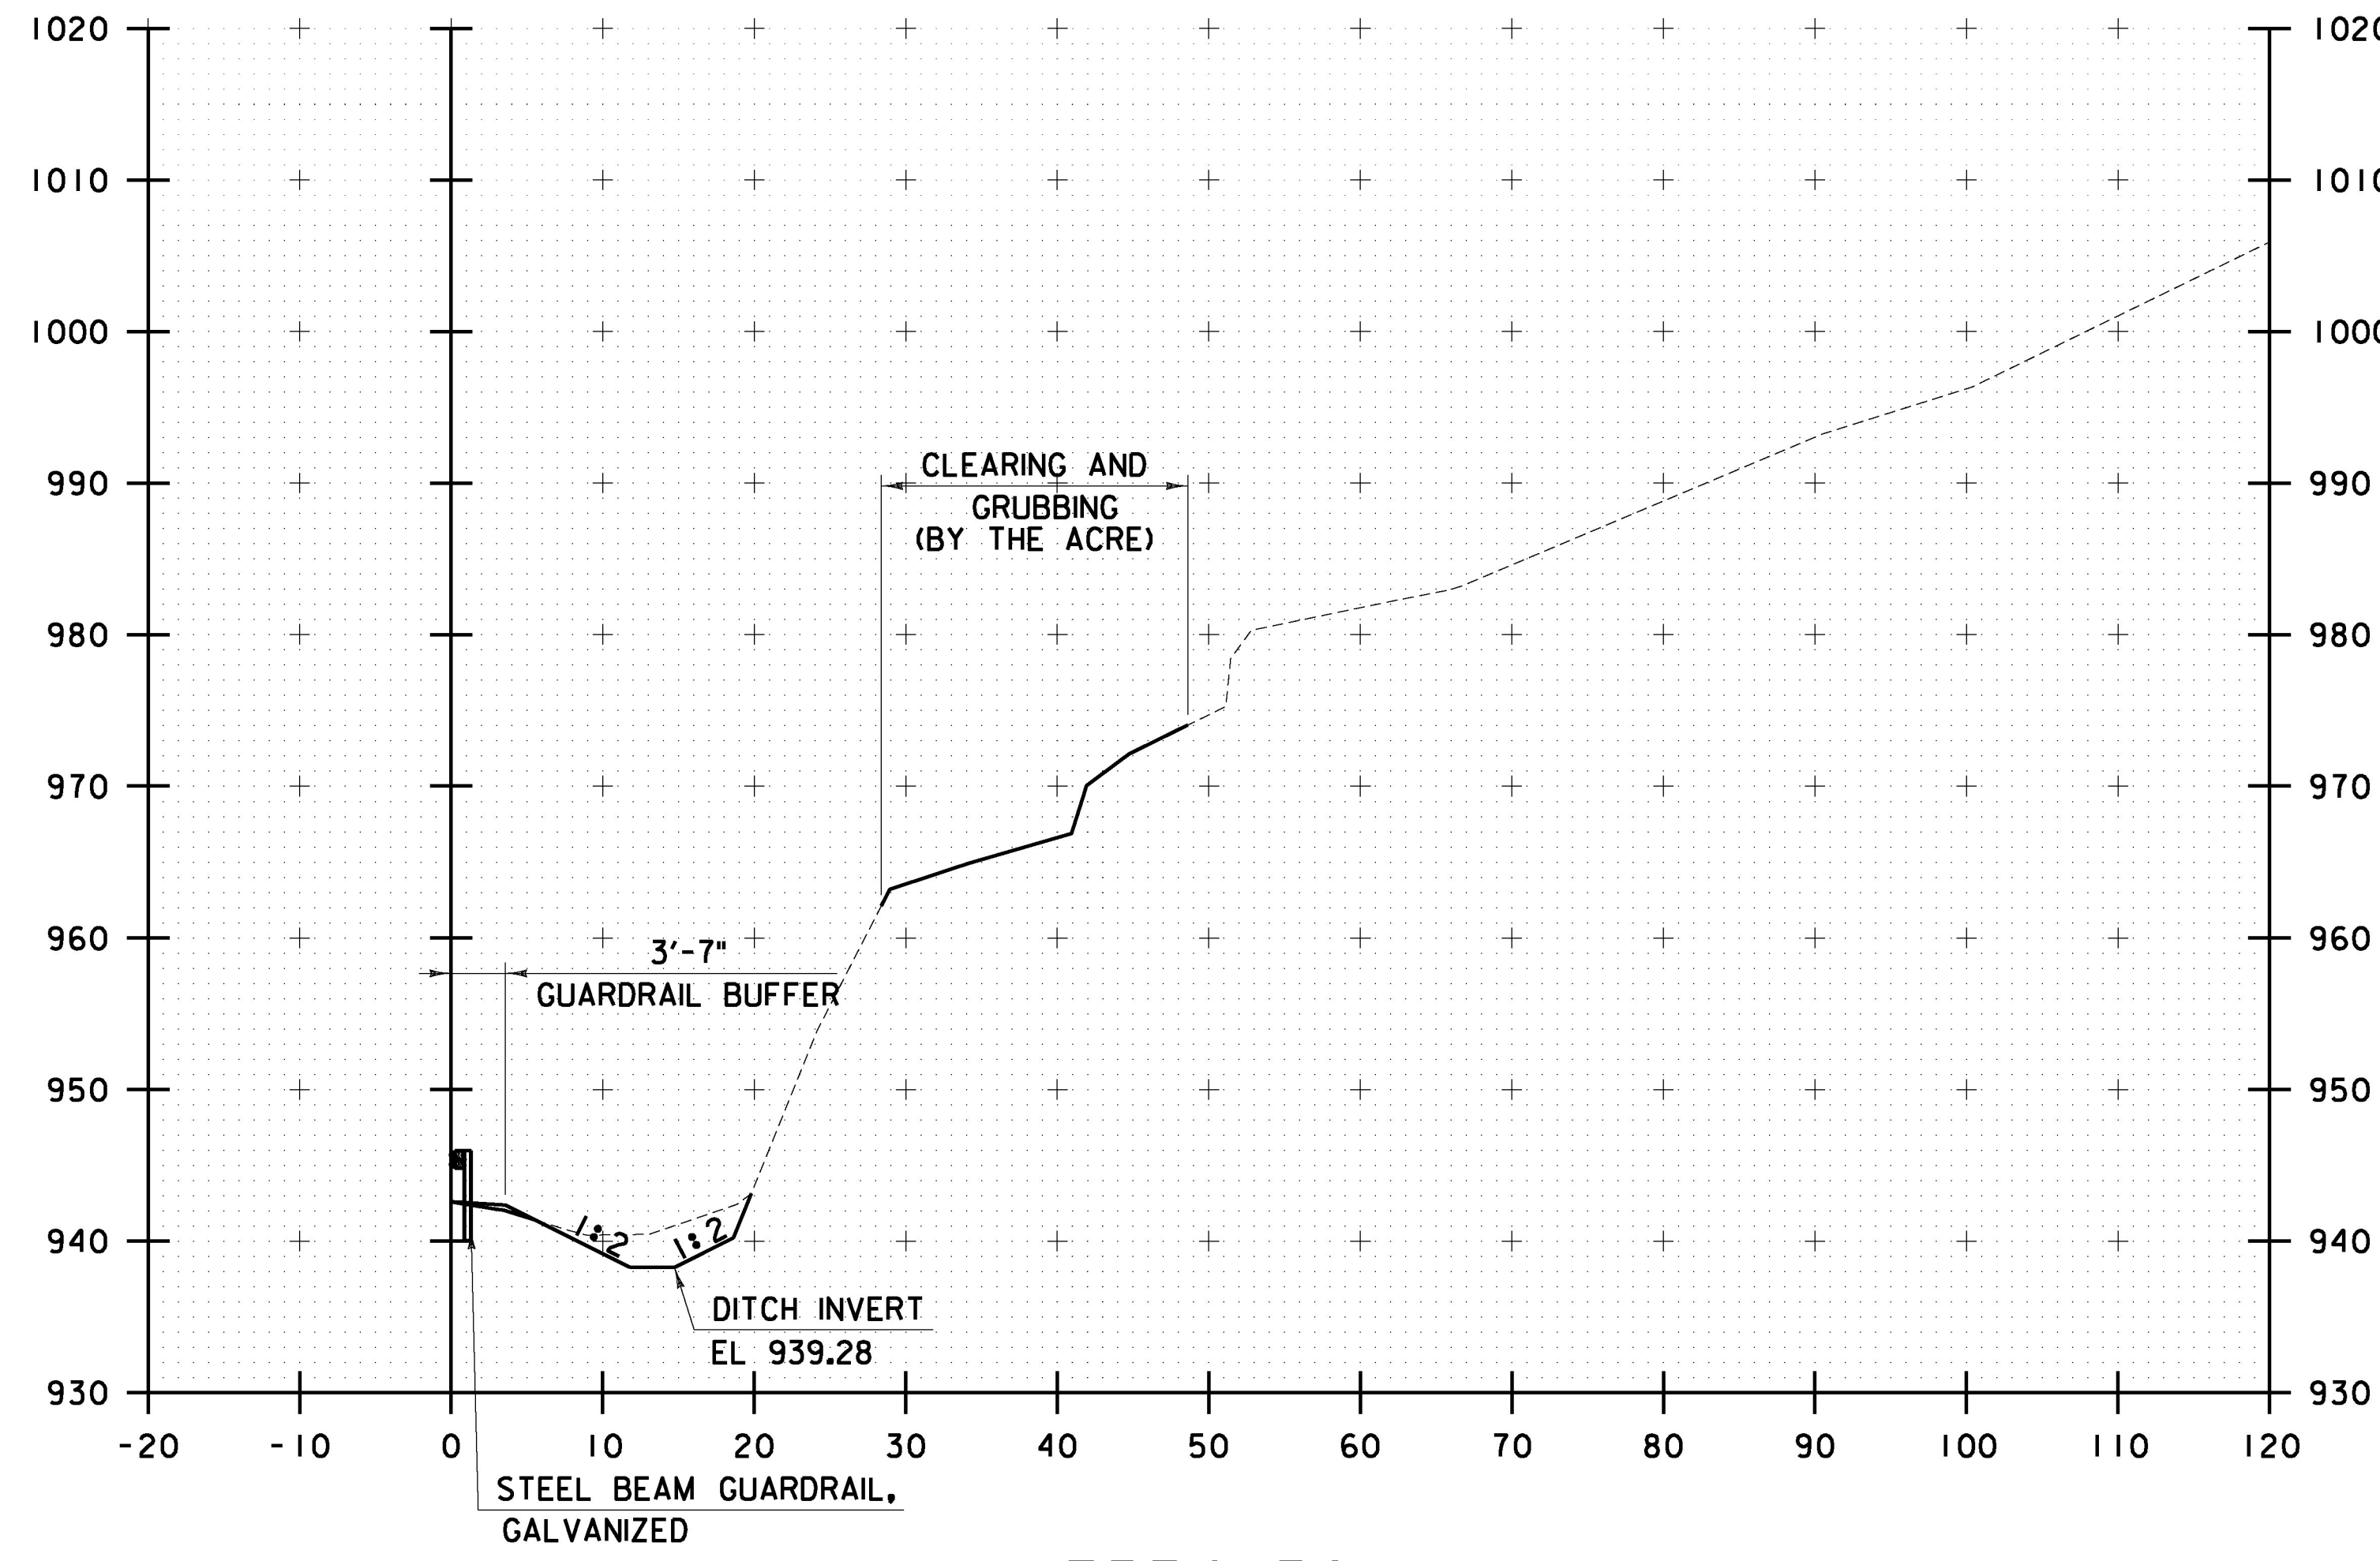


7534+50

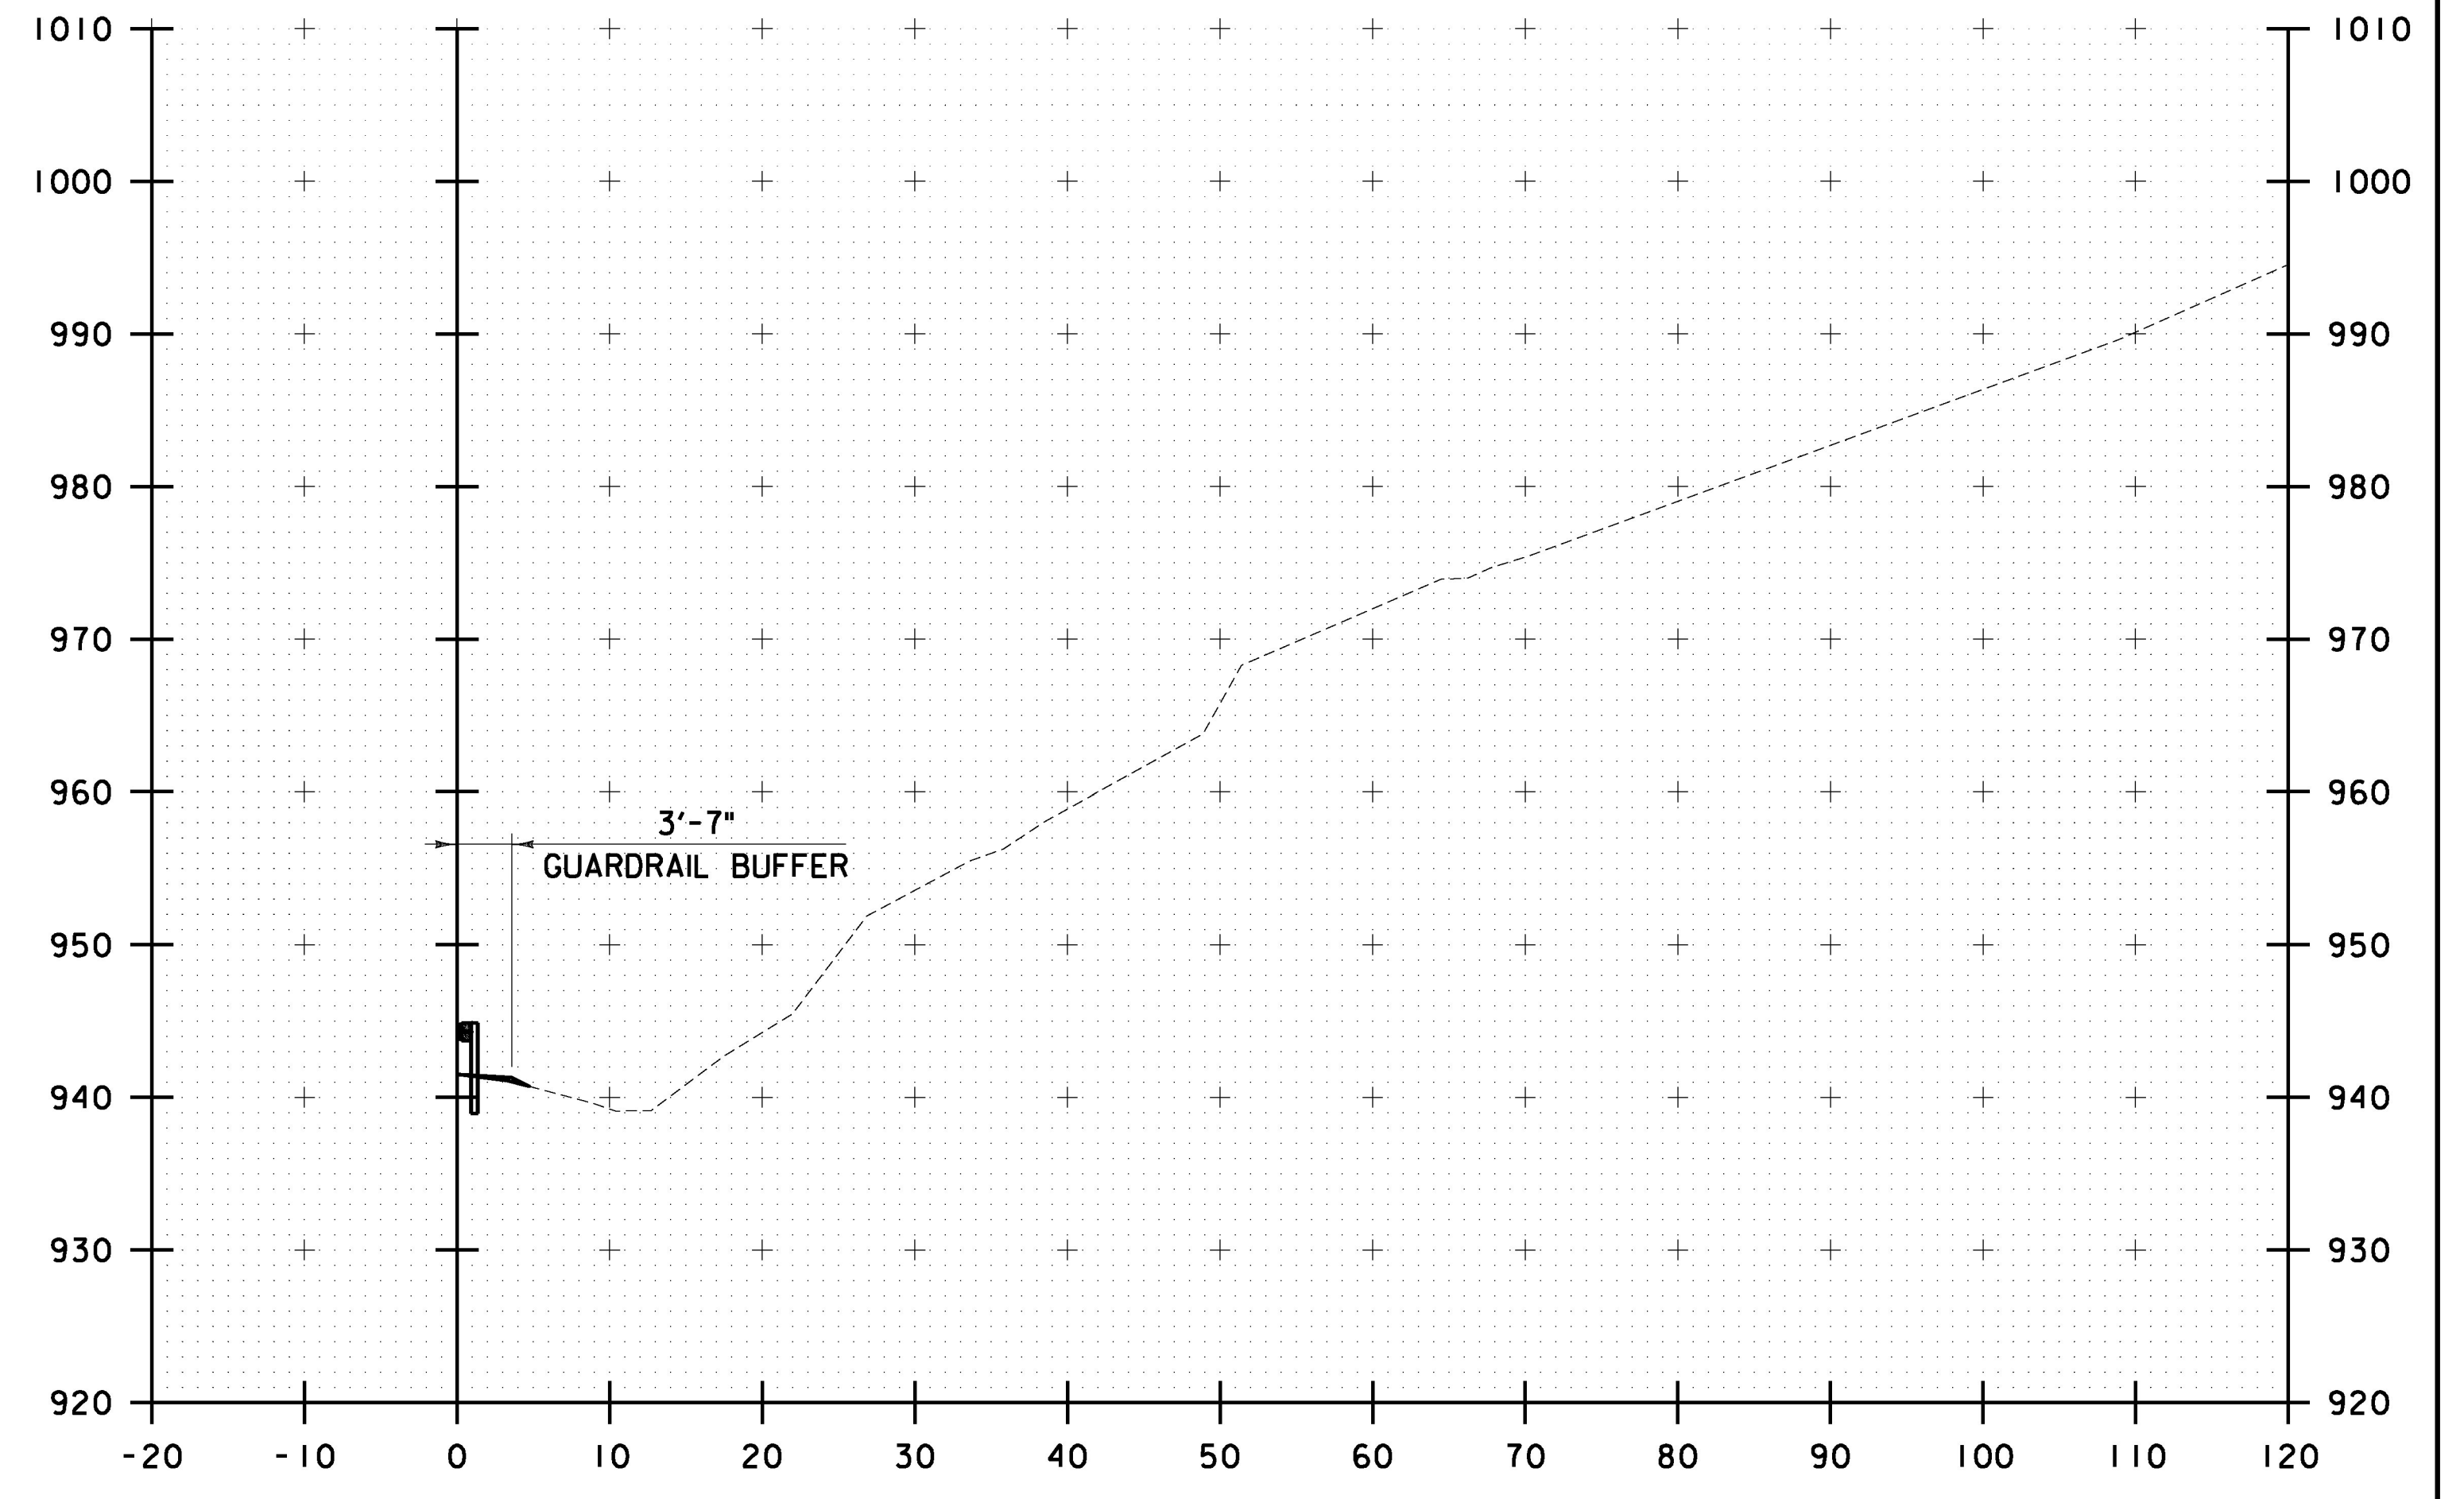

7534+92.50  
 END PROJECT

STA. 7534+50 TO STA. 7534+92.50

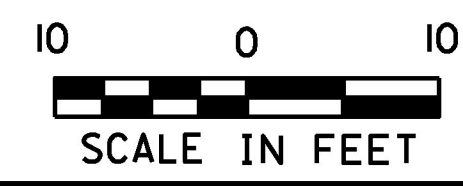

PROJECT NAME: LYNDON	
PROJECT NUMBER: IM 091-3(51)	
FILE NAME: z13a370xsc.dgn	PLOT DATE: 12/13/2016
PROJECT LEADER: D. GOZALKOWSKI	DRAWN BY: J. HEALD
DESIGNED BY: J. OLSEN	CHECKED BY: J. SHIELDS
CROSS SECTIONS SHEET 10	SHEET 33 OF 35