


TYPICAL SECTION - ALTERNATE A
VT RTE 62
BERLIN MM 1.598 TO MM 2.526

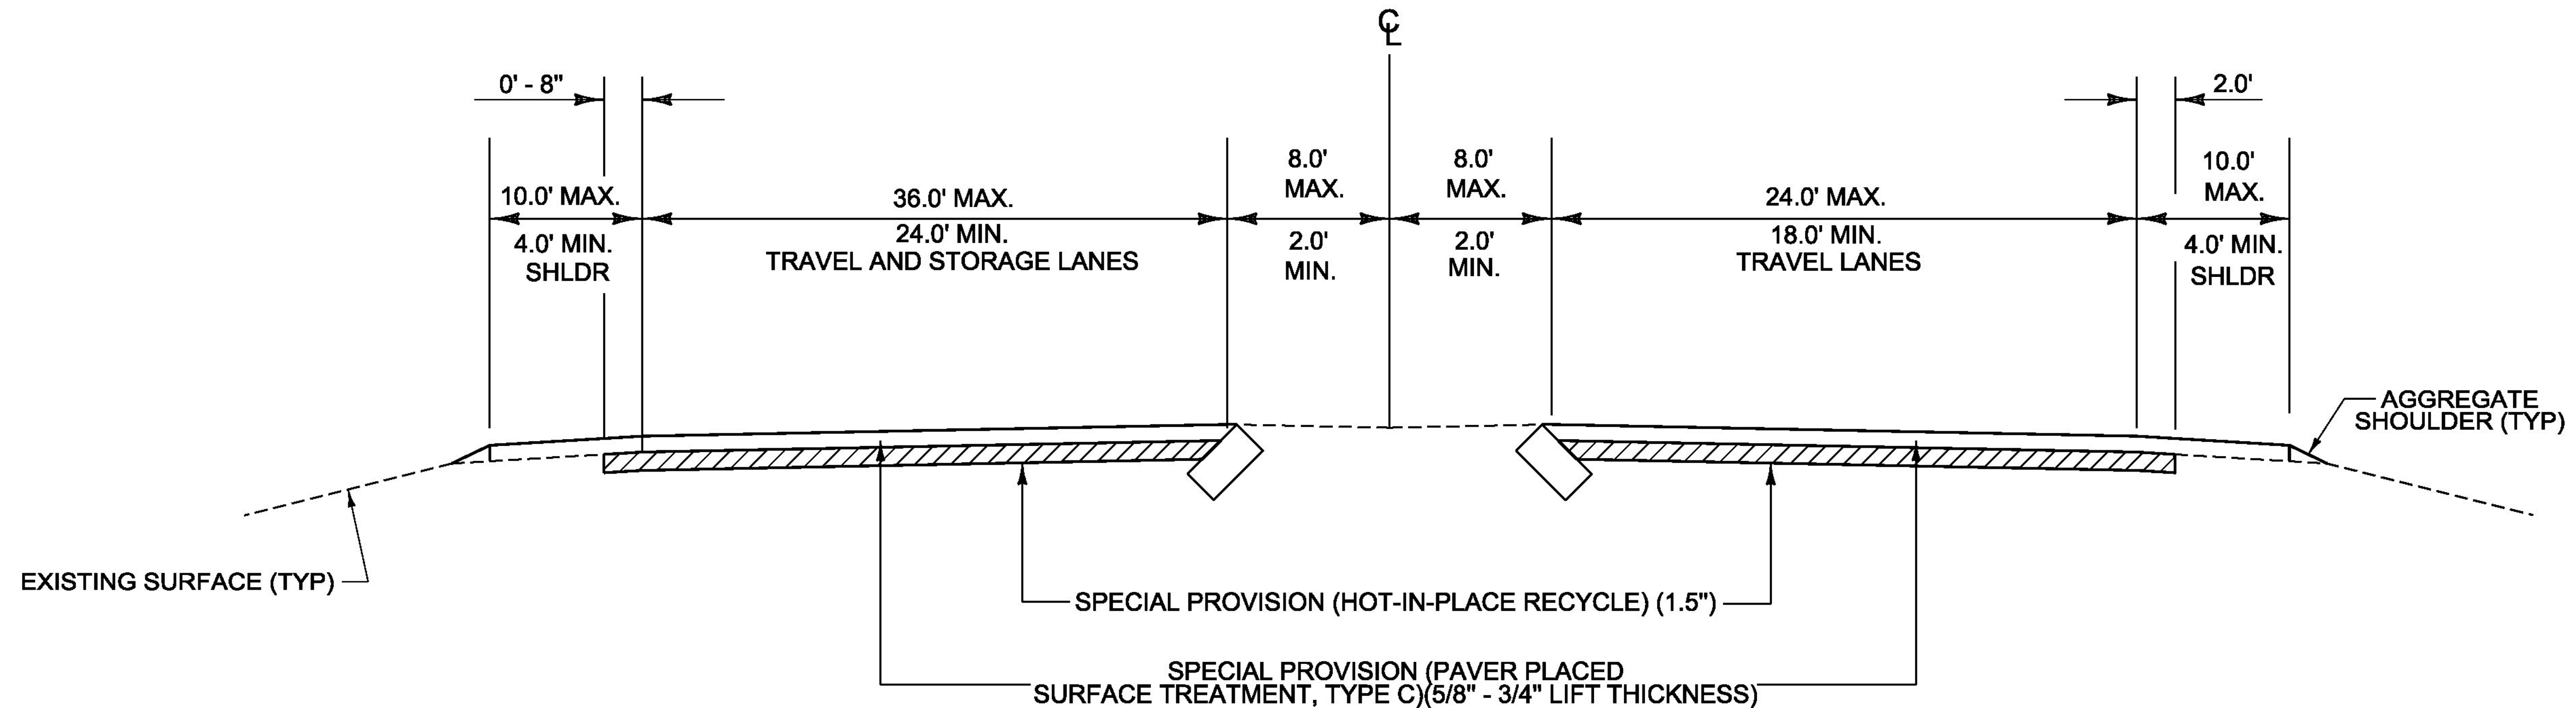

TYPICAL SECTION W/MEDIAN ISLAND - ALTERNATE A
VT RTE 62
BERLIN MM 2.526 TO MM 2.934
BARRE CITY MM 0.000 TO MM 1.189
BARRE CITY MM 1.208 TO MM 1.524

NOT TO SCALE

PROJECT NAME:	BERLIN-BARRE CITY
PROJECT NUMBER:	NH SURF(44)
FILE NAME:	I3B634/pvtmgt/pi3b634.dgn
PROJECT LEADER:	J. HARRINGTON
DESIGNED BY:	PVT. MGT.
TYPICAL SECTIONS - ALTERNATE A	
PLOT DATE:	06-JUN-2014
DRAWN BY:	PVT. MGT.
CHECKED BY:	PVT. MGT.
SHEET	8 OF 64