


DURABLE 6 INCH WHITE LINE, POLYUREA
 TEMPORARY 6 INCH WHITE LINE, PAINT
 MM 1.131 RT. - MM 1.184 RT. (SOLID)
 MM 1.208 LT. - MM 1.243 LT. (SOLID)
 MM 1.131 LT. - MM 1.184 LT. (DASHED)
 MM 1.208 LT. - MM 1.243 LT. (DASHED)
 MM 1.131 RT. - MM 1.132 RT. (DOTTED)
 MM 1.132 RT. - MM 1.184 RT. (SOLID)
 MM 1.208 LT. - MM 1.243 LT. (SOLID)
 MM 1.131 RT. - MM 1.184 RT. (DASHED)
 MM 1.208 RT. - MM 1.243 RT. (DASHED)
 MM 1.131 RT. - MM 1.192 RT. (SOLID)
 MM 1.200 RT. - MM 1.243 RT. (SOLID)

DURABLE 6 INCH YELLOW LINE, POLYUREA
 TEMPORARY 6 INCH YELLOW LINE, PAINT
 MM 1.131 LT. - MM 1.184 LT. (SOLID - AROUND MEDIAN ISLAND)
 MM 1.208 RT. - MM 1.243 RT. (SOLID - AROUND MEDIAN ISLAND)
 MM 1.196 LT (AROUND ISLAND - BERLIN STREET)
 MM 1.196 RT (AROUND ISLAND - BERLIN STREET)

DURABLE 24 INCH STOP BAR, THERMOPLASTIC OR
 DURABLE 24 INCH STOP BAR, POLYUREA (OPTION ITEM)
 TEMPORARY 24 INCH STOP BAR, PAINT
 MM 1.184 LT. - RT.
 MM 1.193 LT. (BERLIN STREET)
 MM 1.199 RT. (BERLIN STREET)
 MM 1.208 RT. - LT.

DURABLE CROSSWALK MARKING, THERMOPLASTIC OR
 DURABLE CROSSWALK MARKING, POLYUREA (OPTION ITEM)
 TEMPORARY CROSSWALK MARKING, PAINT
 MM 1.185 LT. - RT.

DURABLE LETTER OR SYMBOL, THERMOPLASTIC OR
 DURABLE LETTER OR SYMBOL, POLYUREA (OPTION ITEM)
 TEMPORARY LETTER OR SYMBOL, PAINT
 MM 1.133 RT. (ONLY)
 MM 1.136 RT. (LEFT TURN ARROW, THROUGH ARROW,
 THROUGH/RIGHT TURN ARROW)
 MM 1.155 RT. (ONLY)
 MM 1.158 RT. (LEFT TURN ARROW, THROUGH ARROW,
 THROUGH/RIGHT TURN ARROW)
 MM 1.177 RT. (ONLY)
 MM 1.180 RT. (LEFT TURN ARROW, THROUGH ARROW,
 THROUGH/RIGHT TURN ARROW)
 MM 1.211 LT. (LEFT TURN ARROW, THROUGH ARROW,
 THROUGH/RIGHT TURN ARROW)
 MM 1.214 LT. (ONLY)
 MM 1.227 LT. (LEFT TURN ARROW, THROUGH ARROW,
 THROUGH/RIGHT TURN ARROW)
 MM 1.230 LT. (ONLY)

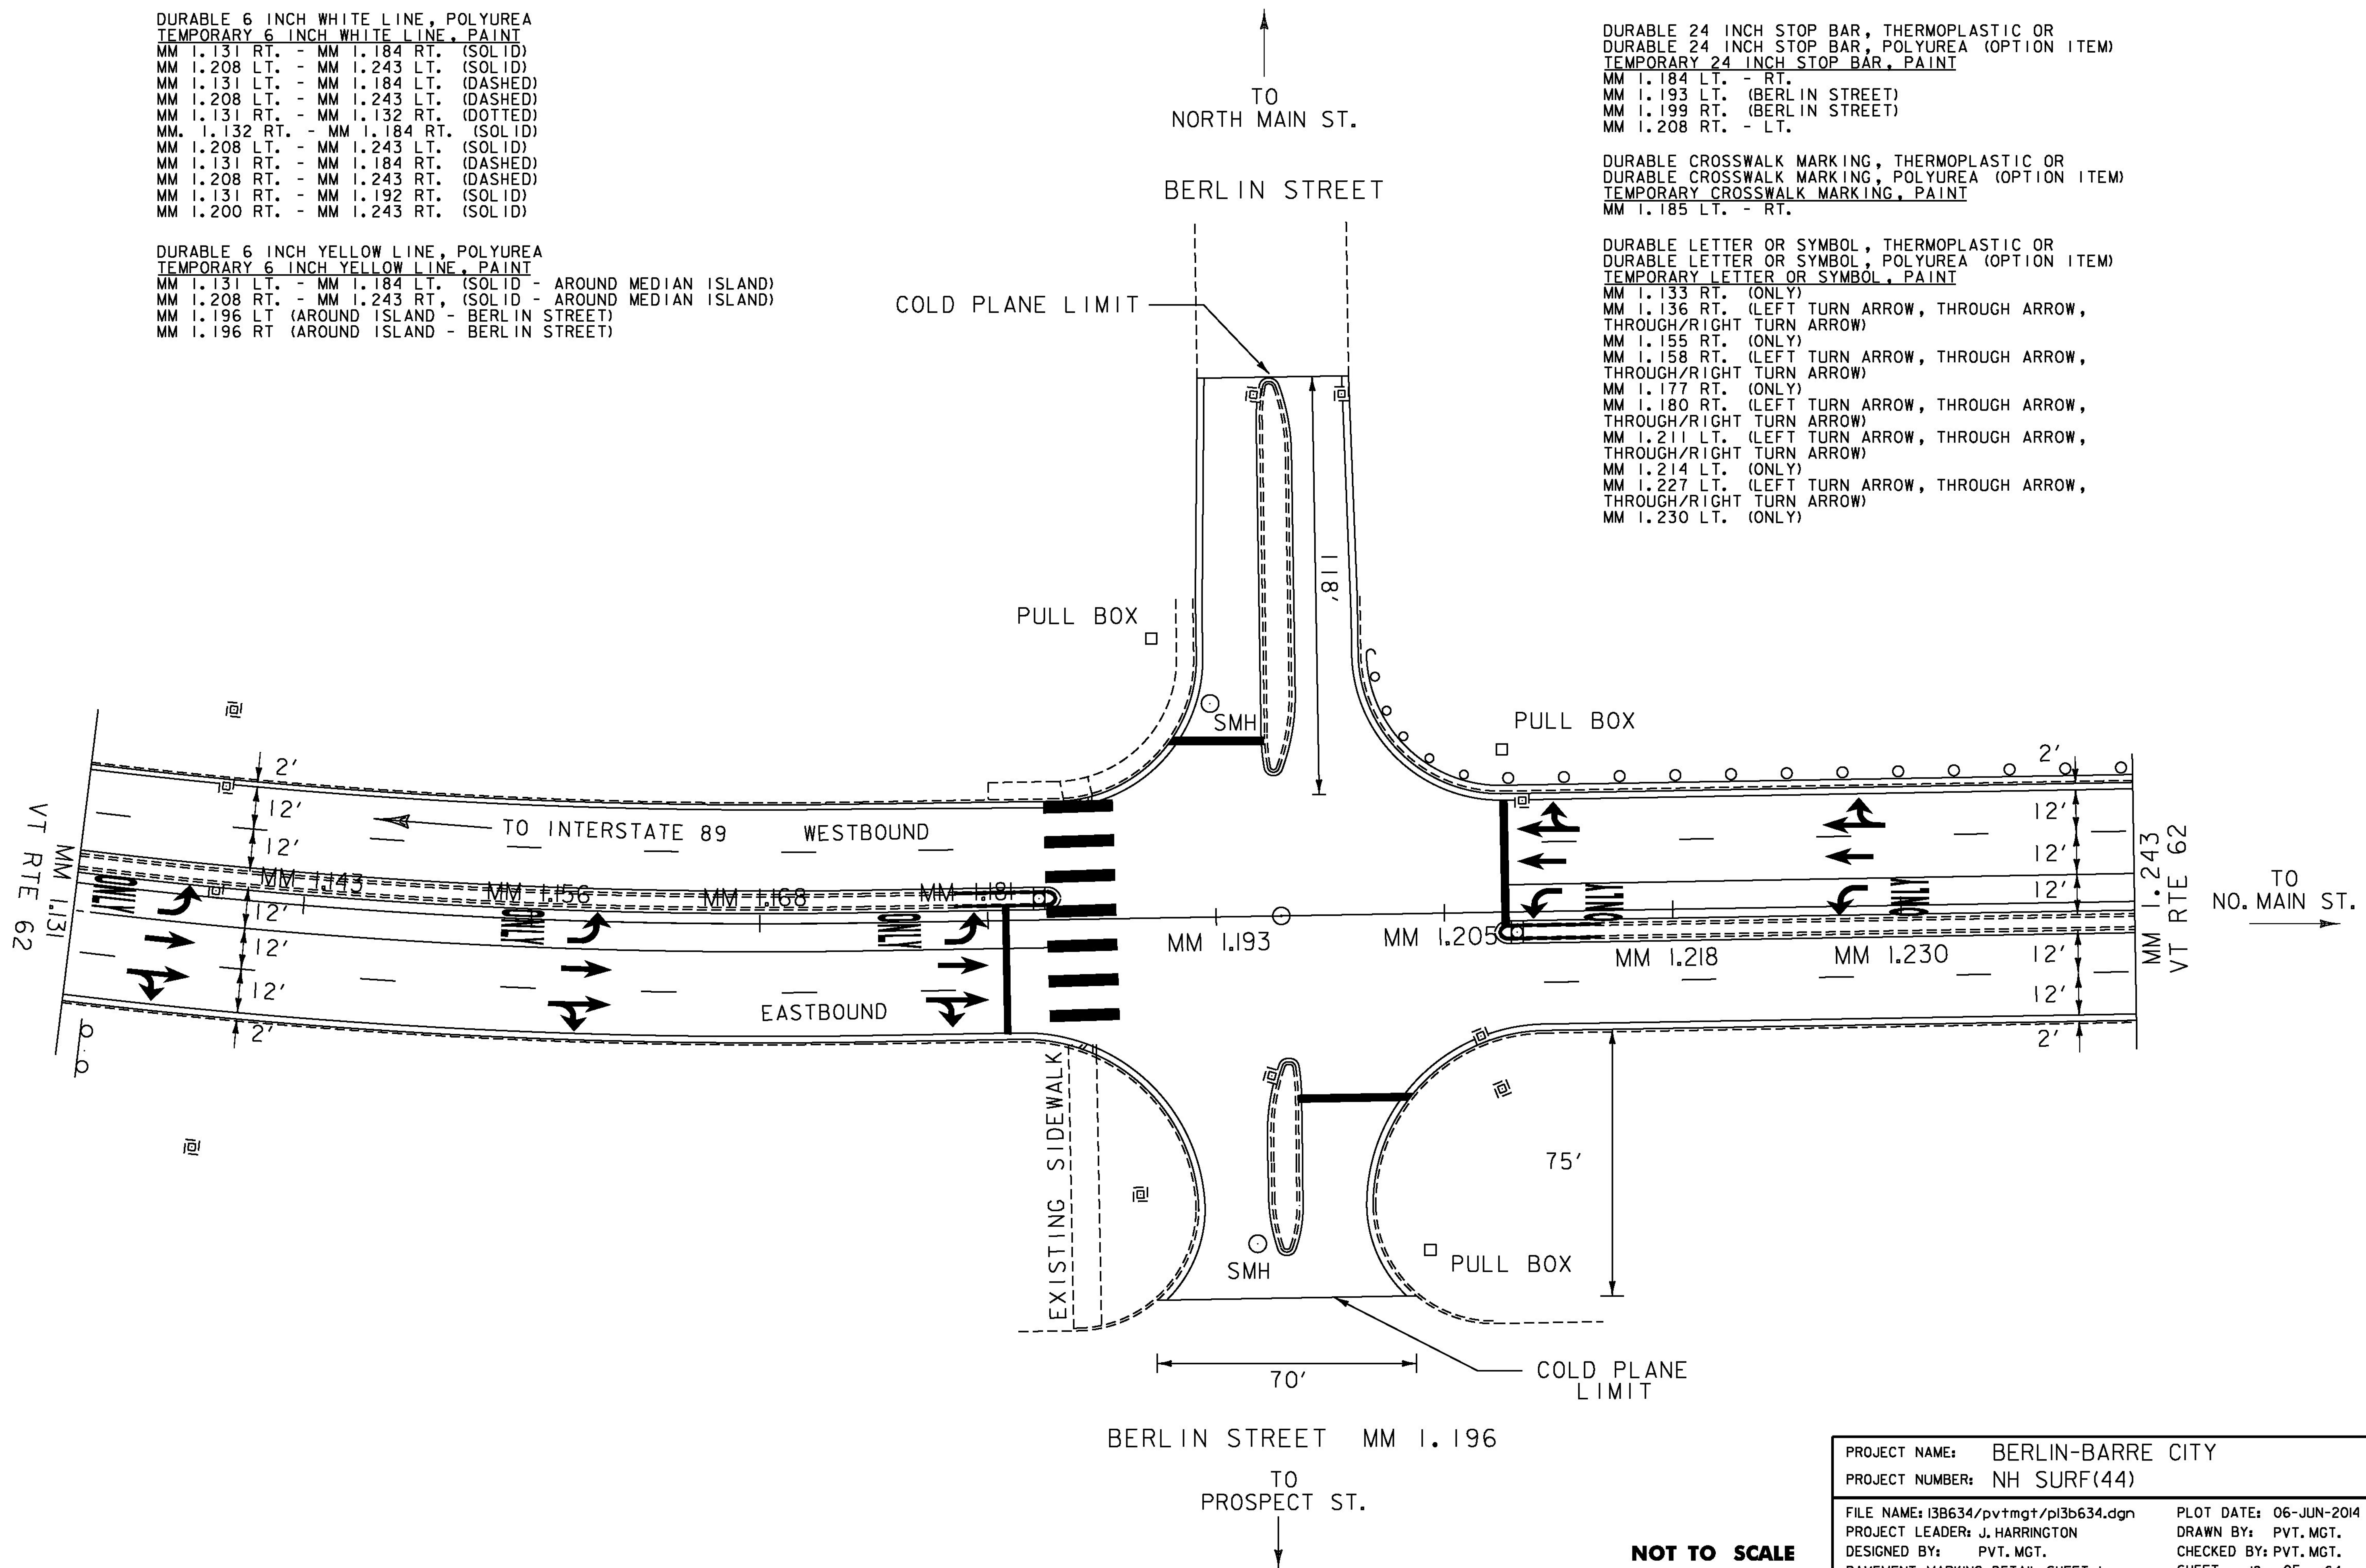

NOT TO SCALE

PROJECT NAME: BERLIN-BARRE CITY	PLOT DATE: 06-JUN-2014
PROJECT NUMBER: NH SURF(44)	DRAWN BY: PVT. MGT.
FILE NAME: I3B634/pvtmgt/pi3b634.dgn	CHECKED BY: PVT. MGT.
PROJECT LEADER: J. HARRINGTON	SHEET 18 OF 64
DESIGNED BY: PVT. MGT.	PAVEMENT MARKING DETAIL SHEET 1