


DURABLE 6 INCH WHITE LINE, POLYUREA
 TEMPORARY 6 INCH WHITE LINE, PAINT
 MM 1.466 LT. - MM 1.524 LT. (SOLID)
 MM 1.466 RT. - MM 1.524 RT. (DASHED)
 MM 1.466 LT. - MM 1.524 LT. (DASHED)
 MM 1.466 RT. - MM 1.524 RT. (SOLID)

DURABLE 6 INCH YELLOW LINE, POLYUREA
 TEMPORARY 6 INCH YELLOW LINE, PAINT
 MM 1.466 LT. - MM 1.524 LT. (SOLID)
 MM 1.466 RT. - MM 1.524 RT. (SOLID)

DURABLE RAILROAD CROSSING SYMBOL, THERMOPLASTIC OR
 DURABLE RAILROAD CROSSING SYMBOL, POLYUREA (OPTION ITEM)
 TEMPORARY RAILROAD CROSSING SYMBOL, PAINT
 MM 1.474 RT.

**END NH SURF(44)
 MM 1.524**

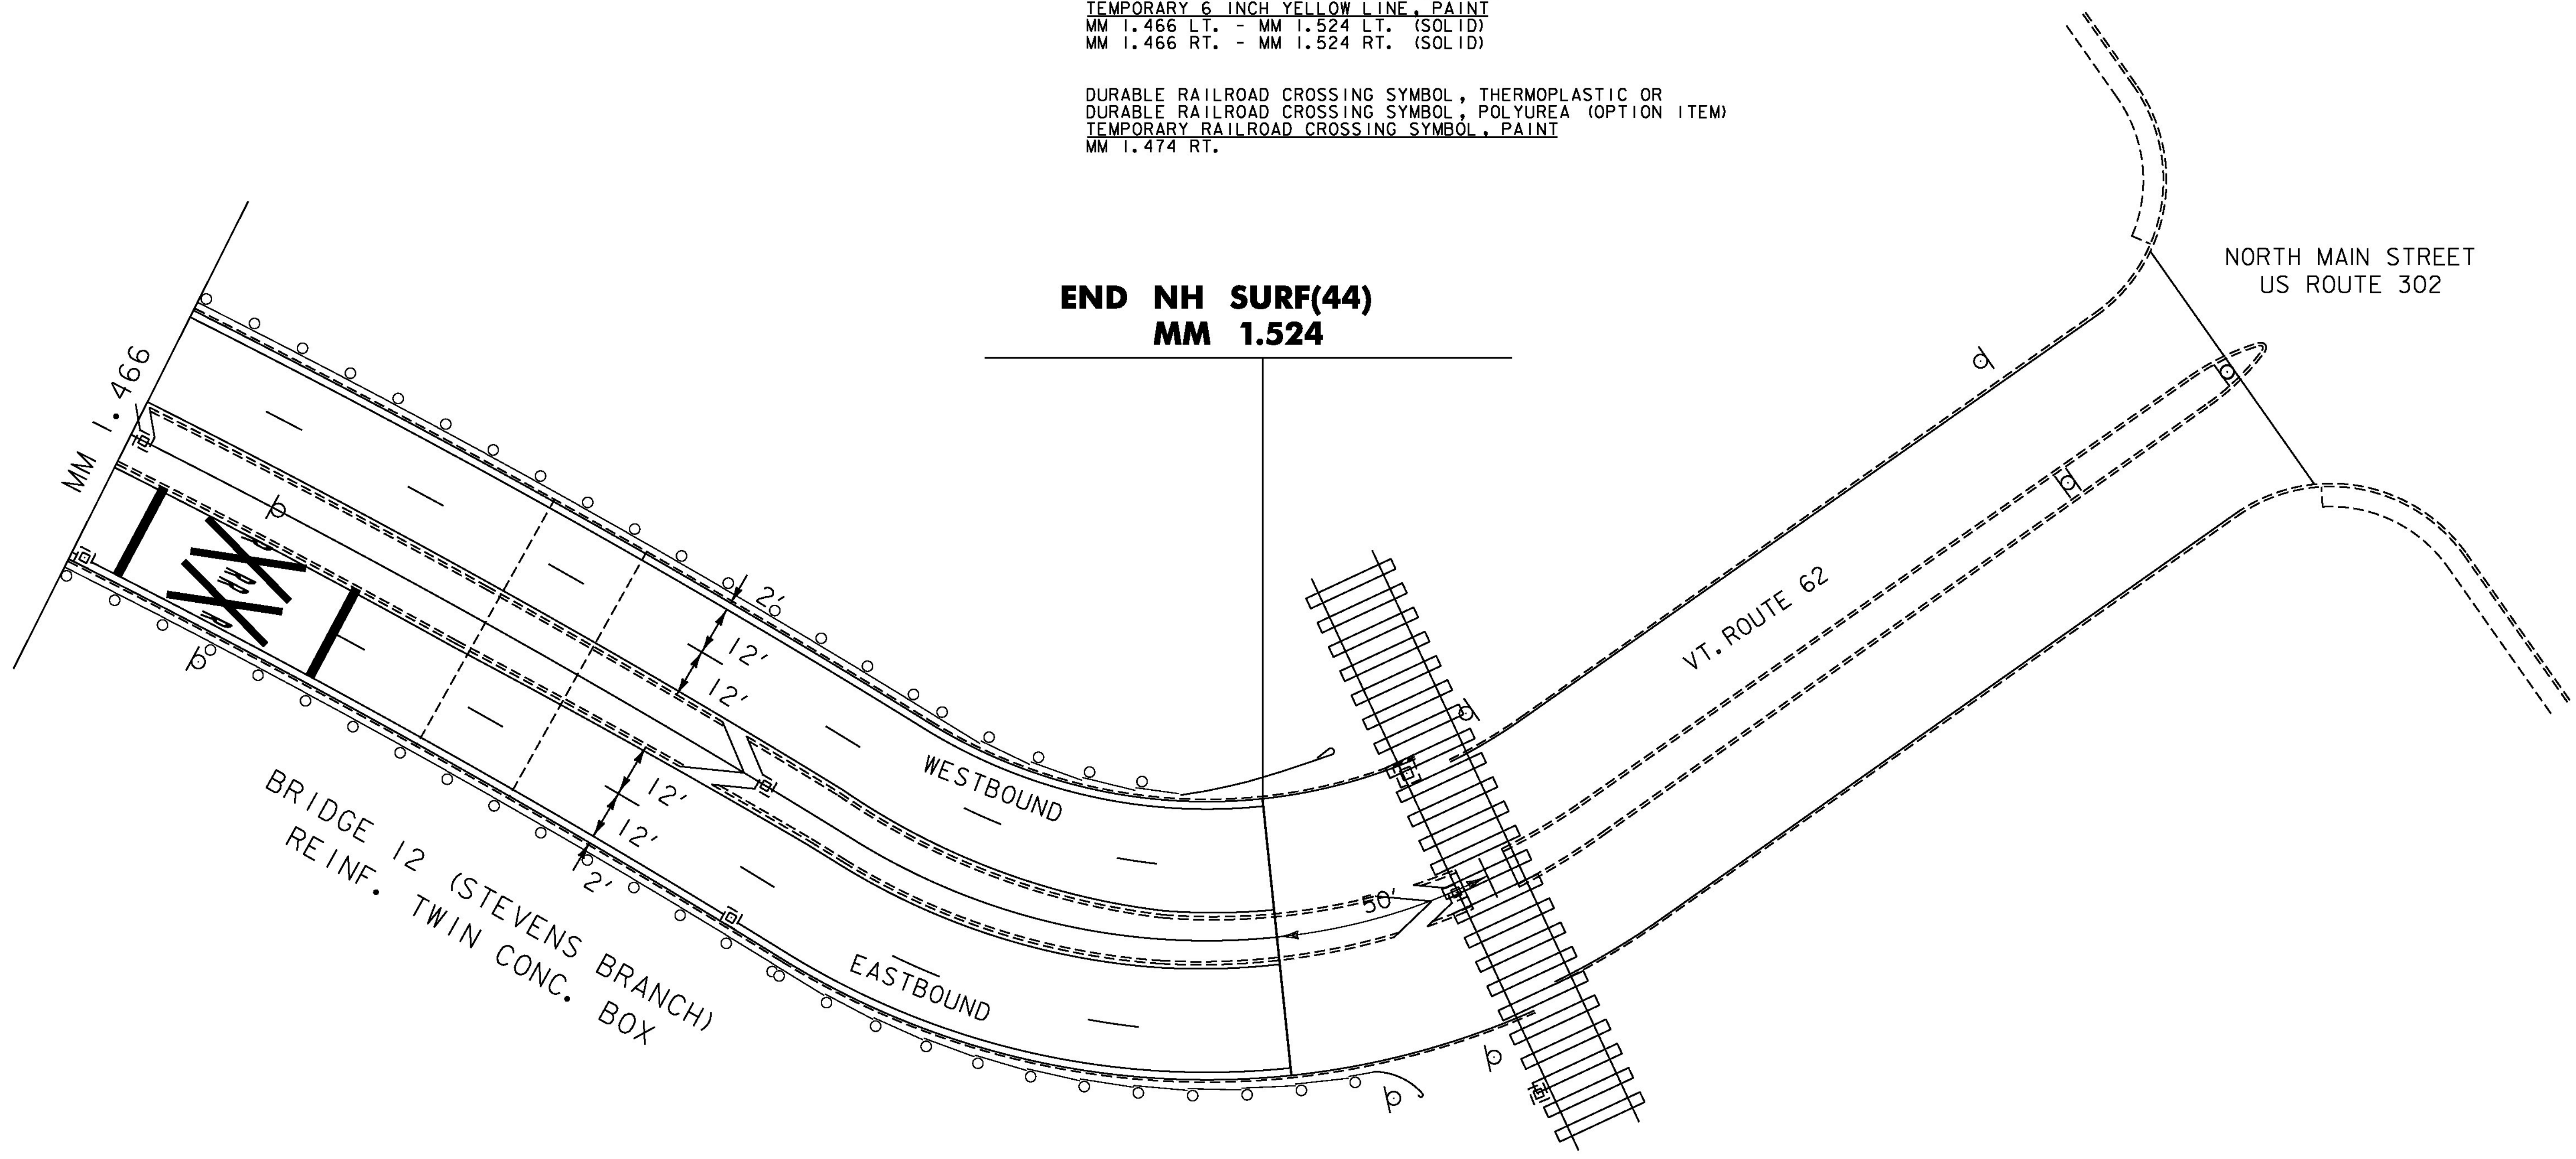

NOTE:

THE CONTRACTOR SHALL NOT PLACE OR PUT INTO OPERATION EQUIPMENT INSIDE THE RAILROAD FOUL ZONE. A TRACK SHALL BE CONSIDERED FOULED AND SUBJECT TO HAZARD WHEN ANY OBJECT OR OPERATION IS BROUGHT CLOSER THAN TWENTY-FIVE (25) FEET TO THE CENTERLINE OF TRACKS.

NOT TO SCALE

PROJECT NAME: BERLIN-BARRE CITY	PLOT DATE: 06-JUN-2014
PROJECT NUMBER: NH SURF(44)	DRAWN BY: PVT. MGT.
FILE NAME: I3B634/pvtmgt/pi3b634.dgn	CHECKED BY: PVT. MGT.
PROJECT LEADER: J. HARRINGTON	SHEET 19 OF 64
DESIGNED BY: PVT. MGT.	PAVEMENT MARKING DETAIL SHEET 2