

STATE OF VERMONT  
AGENCY OF TRANSPORTATION





PROPOSED IMPROVEMENT  
TOWNS OF HARTFORD & SHARON  
COUNTY OF WINDSOR  
INTERSTATE ROUTE 89 (NB) (PRINCIPAL ARTERIAL-NHS)

BEGINNING AT STATION 2+64 (MM 0.050) (NORTH END OF THE BRIDGE OVER THE CONNECTICUT RIVER) IN THE TOWN OF HARTFORD,  
AND EXTENDING NORTHERLY ALONG INTERSTATE 89 (IN THE NORTHBOUND LANES) FOR A DISTANCE OF 64,416.00 FEET (12.200 MILES)  
TO STATION 646+80.00 (MM 12.250) IN THE TOWN OF SHARON.

PROJECT DATA	LENGTH	
	(FEET)	(MILES)
NORTHBOUND		
STA 2+64 TO 646+80 (MM 0.050 TO MM 12.250)	64,416.00	12.200
LENGTH OF ROADWAY	64,416.00	12.200
LENGTH OF PROJECT	64,416.00	12.200

WORK TO BE PERFORMED UNDER THIS PROJECT INCLUDES SURFACE PREPARATION INVOLVING  
PATCHING, POT HOLE REPAIR, CRACK SEALING, HOT-IN-PLACE RECYCLING AND OVERLAYING WITH  
A THIN BITUMINOUS SURFACE TREATMENT, TRAFFIC MARKINGS AND OTHER HIGHWAY RELATED ITEMS.

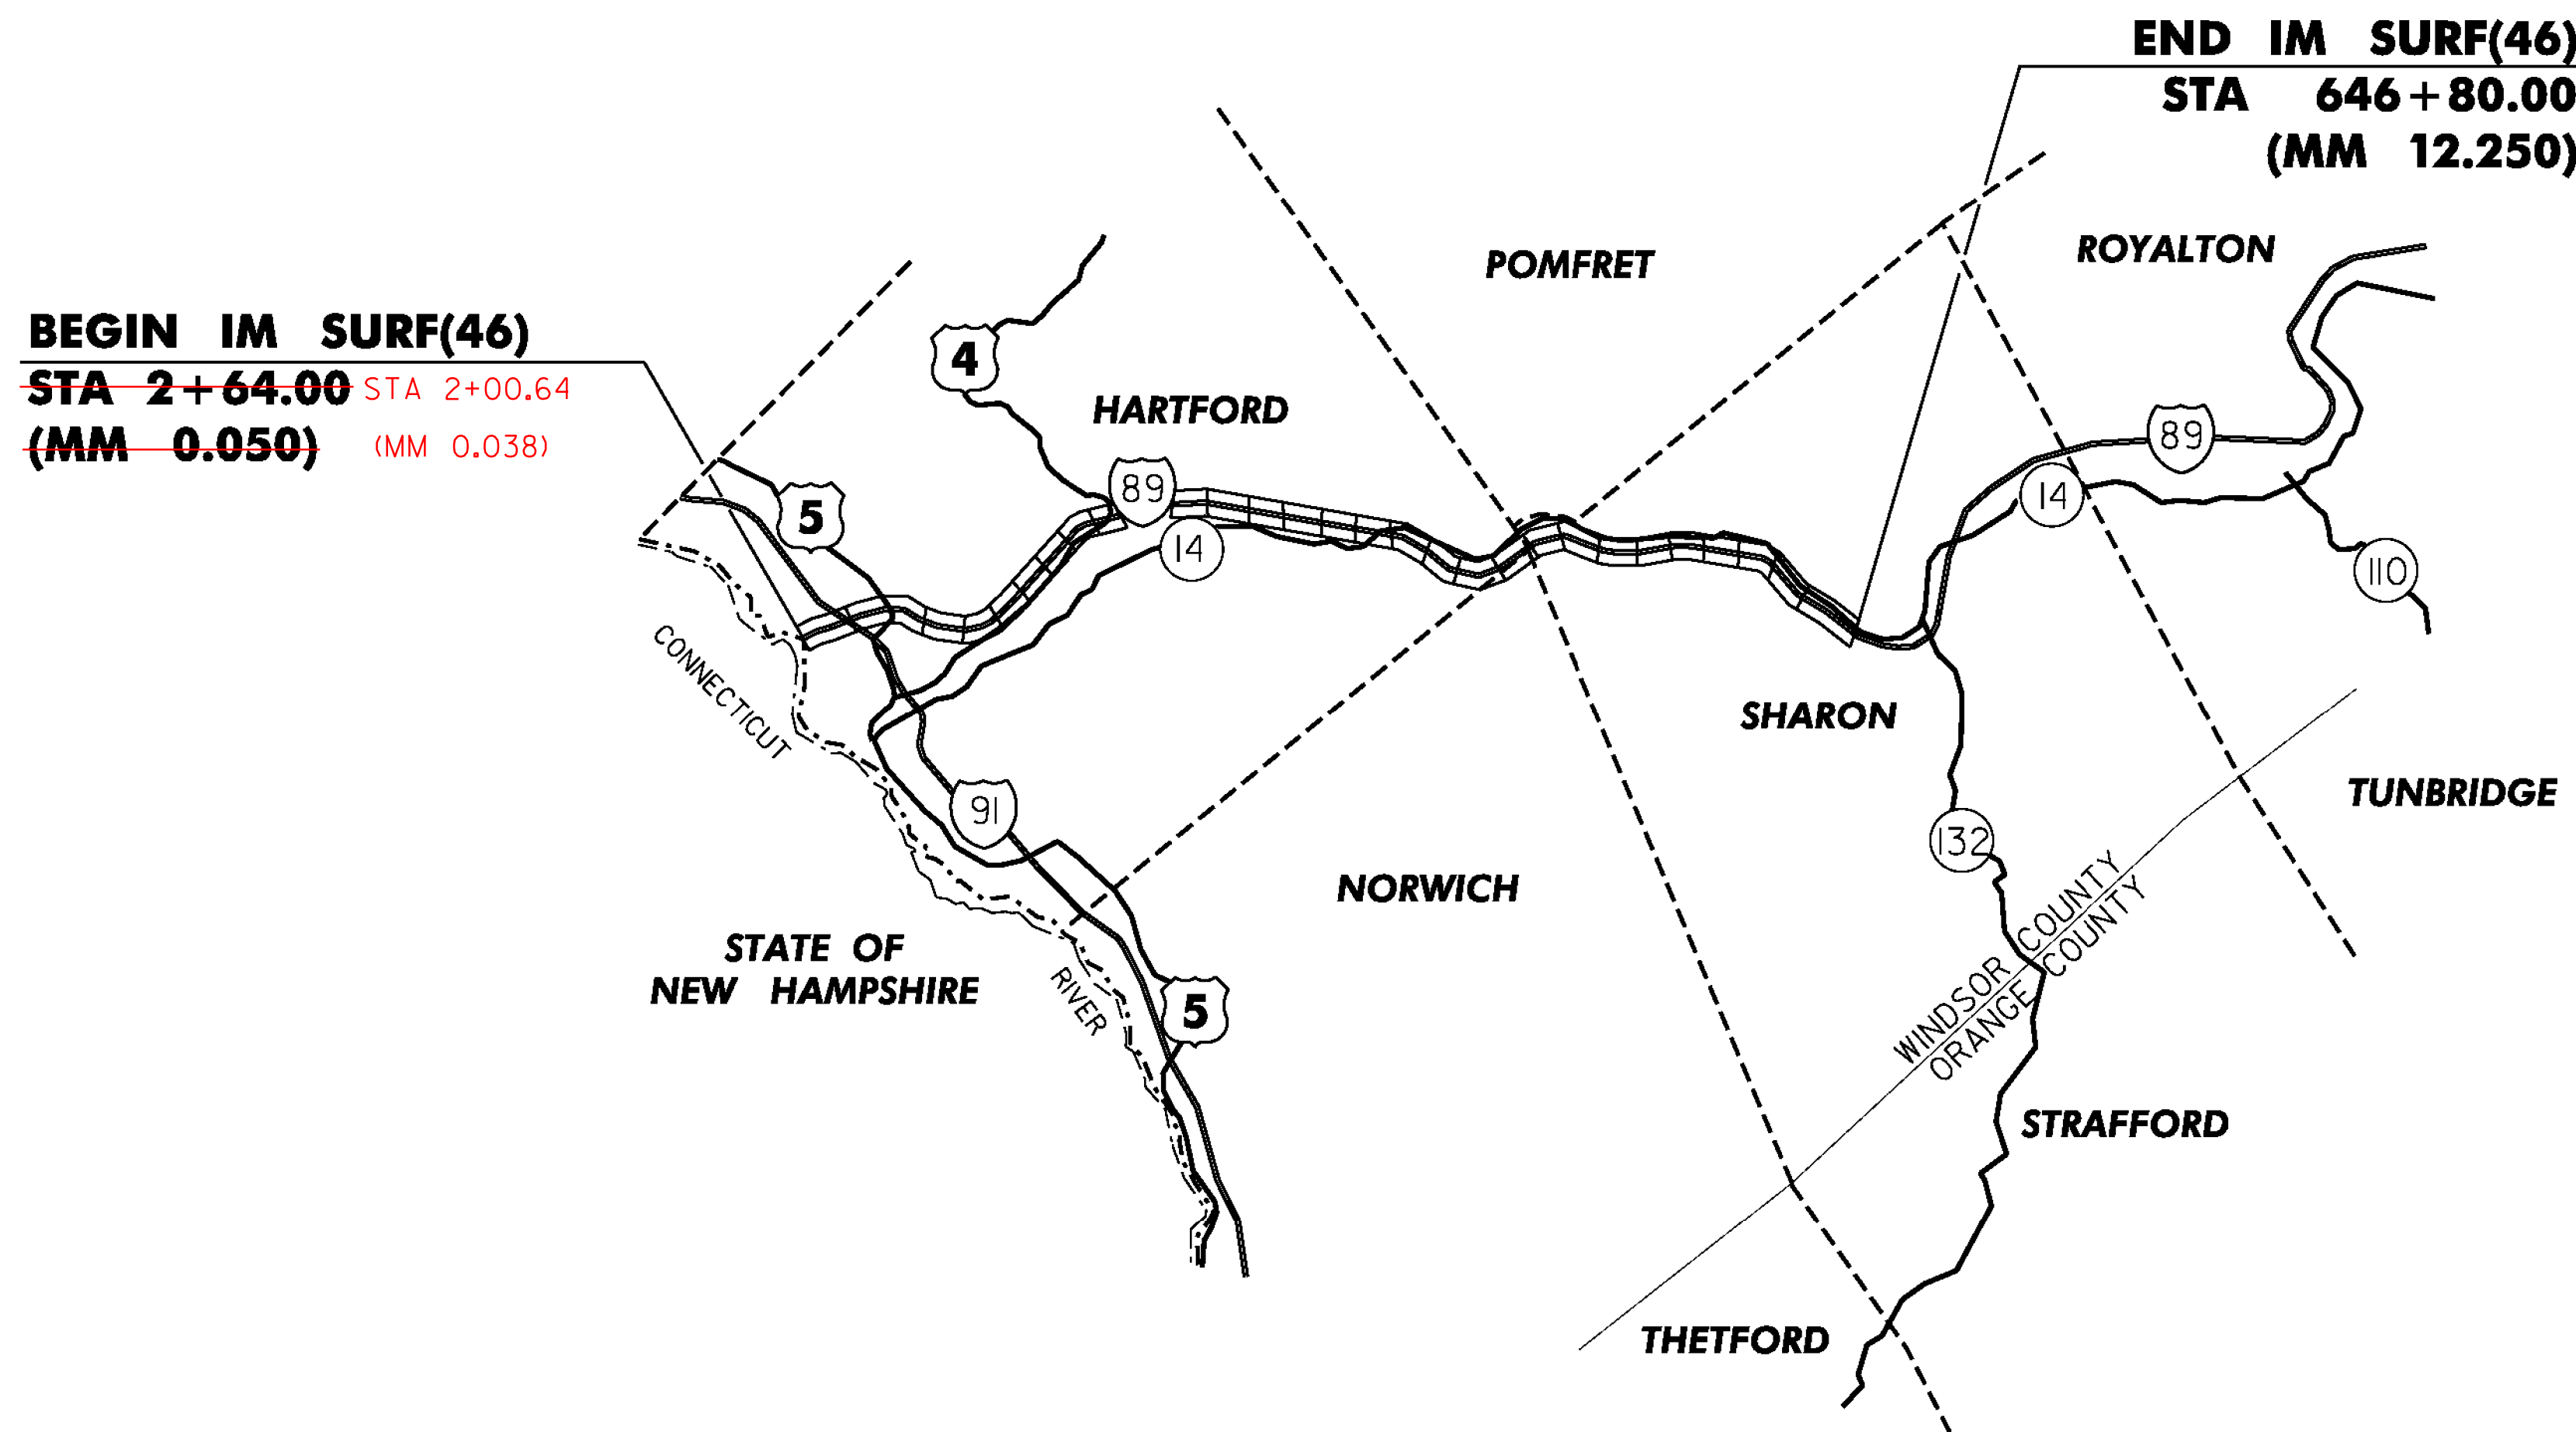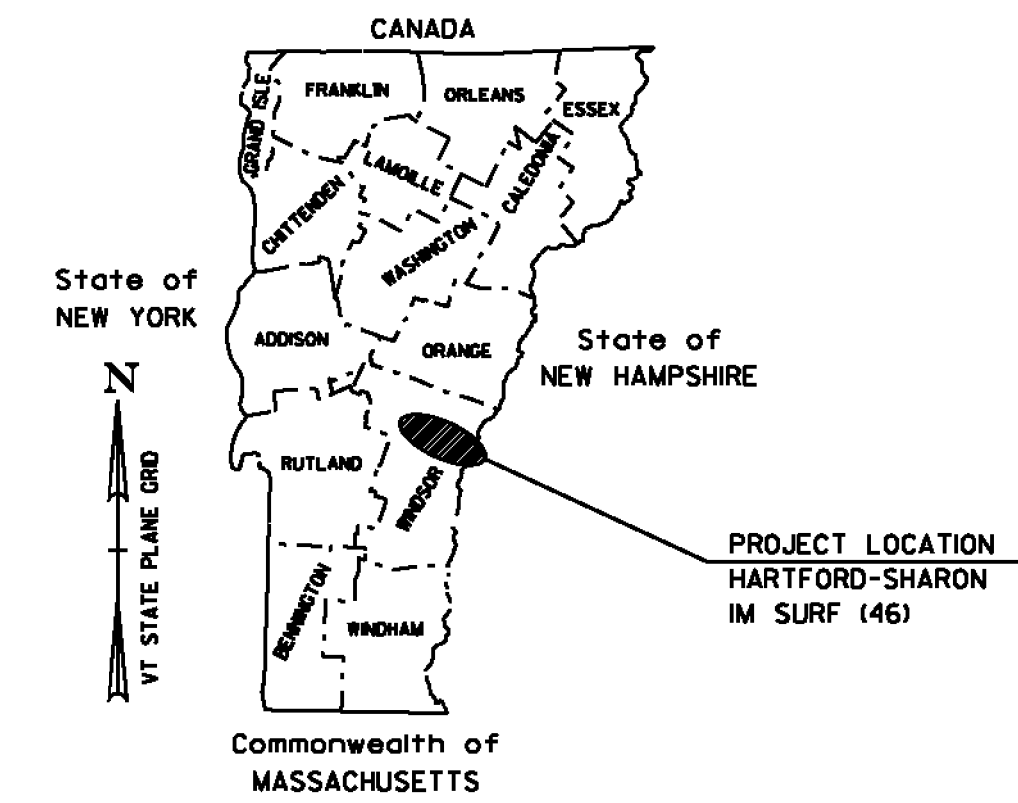


**TRAFFIC DATA**

	2014 AADT	2024 AADT	2014 DHV	2024 DHV	FLEXIBLE ESALS (2014-2024)	FLEXIBLE ESALS (2014-2034)
I-89 NB						
BEGIN PROJECT TO I-91 EXIT 10	19,700	21,200	2700	2900	2,945,000	6,419,000
I-91 EXIT 10 TO I-89 EXIT 1	11,600	11,000	1600	1600	3,539,000	8,104,000
I-89 EXIT 1 TO END OF PROJECT	8,500	9,100	1100	1200	3,860,000	8,945,000

THESE PLANS ARE SUBJECT TO SUCH ENGINEERING CHANGES AS MAY BE REQUIRED BY THE FEDERAL HIGHWAY ADMINISTRATION OR THE DIRECTOR OF PROGRAM DEVELOPMENT.  
CONSTRUCTION IS TO BE CARRIED ON IN ACCORDANCE WITH THESE PLANS AND THE STANDARD SPECIFICATIONS FOR CONSTRUCTION DATED 2011, AS APPROVED BY THE FEDERAL HIGHWAY ADMINISTRATION ON JULY 20, 2011 FOR USE ON THIS PROJECT, INCLUDING ALL SUBSEQUENT REVISIONS AND SUCH REVISED SPECIFICATIONS AND SPECIAL PROVISIONS AS ARE INCORPORATED IN THESE PLANS.

QUALITY ASSURANCE PROGRAM : LEVEL I	
SURVEYED BY :	NA
SURVEYED DATE :	NA
DATUM	
VERTICAL	NA
HORIZONTAL	NA

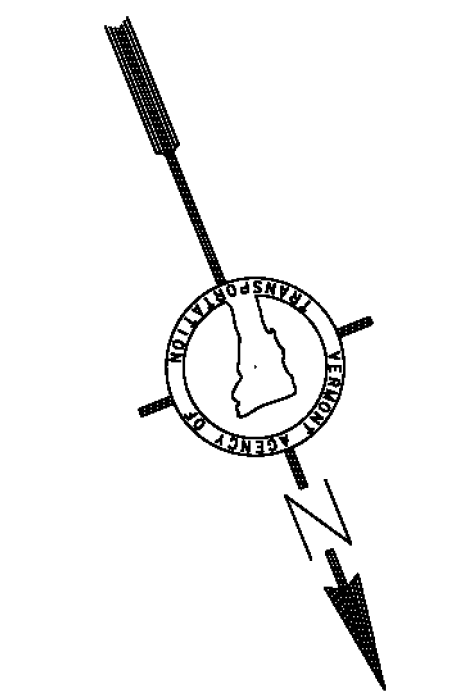

NOT TO SCALE

PROJECT MANAGER :	JONATHAN C. HARRINGTON, P. E.
PROJECT NAME :	HARTFORD-SHARON
PROJECT NUMBER :	IM SURF (46)
SHEET	40 OF 64