


**BRIDGE #6N**

MM 1.071


LENGTH OF ASPHALTIC PLUG JOINTS:

- JOINT #1 - 43'
- JOINT #2 - 43' X 2 = 86'
- JOINT #3 - 43' X 2 = 86'
- JOINT #4 - 43'
- TOTAL = 258'

**LEGEND**

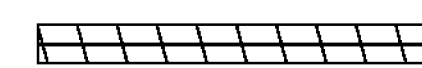

EXISTING BRIDGE JOINTS TO BE  
REPAIRED WITH ASPHALTIC PLUG JOINT

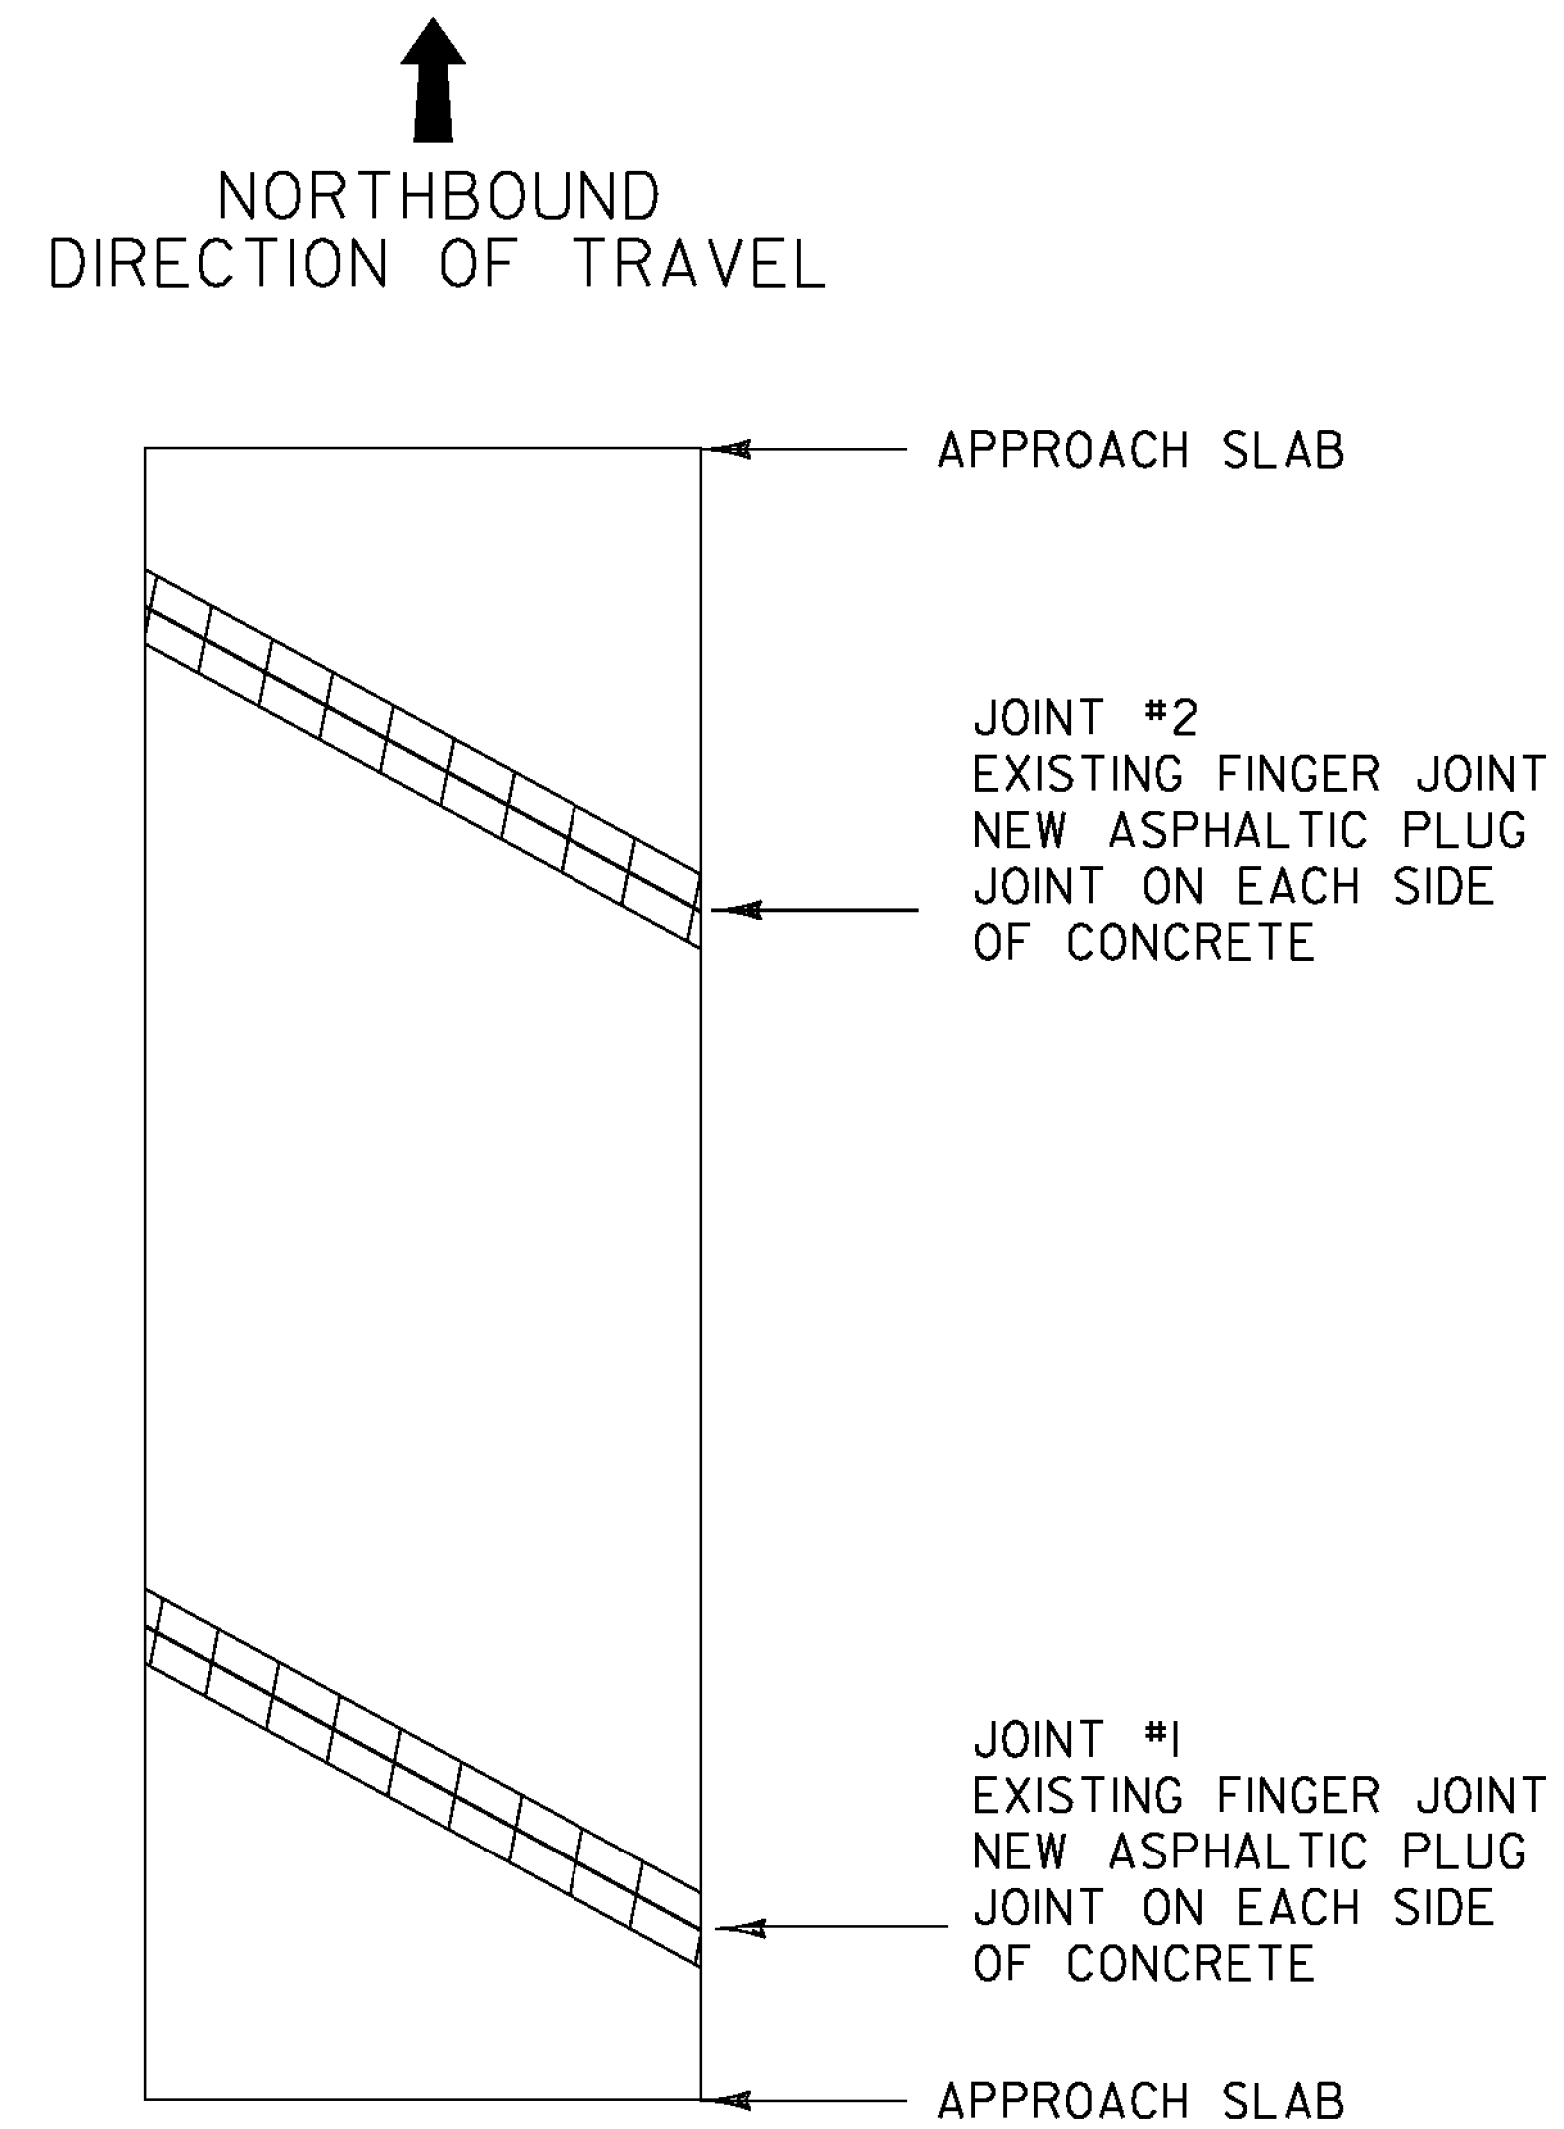

**BRIDGE #11N**

MM 6.950

LENGTH OF ASPHALTIC PLUG JOINTS:

- ~~JOINT #1 - 43' X 2 = 86'~~
- ~~JOINT #2 - 43' X 2 = 86'~~
- TOTAL = 172'
- JOINT #1 - 45.1' X 2 = 90.2'
- JOINT #2 - 45.1' X 2 = 90.2'
- TOTAL = 180.4'

**NOT TO SCALE**

PROJECT NAME: HARTFORD-SHARON	
PROJECT NUMBER: IM SURF(46)	
FILE NAME: I3a638/pvtmgt/pl3a638_wrk.dgn	PLOT DATE: 06-JUN-2014
PROJECT LEADER: J. HARRINGTON	DRAWN BY: PVT. MGT.
DESIGNED BY: PVT. MGT.	CHECKED BY: PVT. MGT.
BRIDGE DETAIL SHEET 2	SHEET 47 OF 64