


**EXPANSION JOINT - ASPHALTIC PLUG DETAIL
PLAN VIEW
(FINGER PLATE JOINT)**

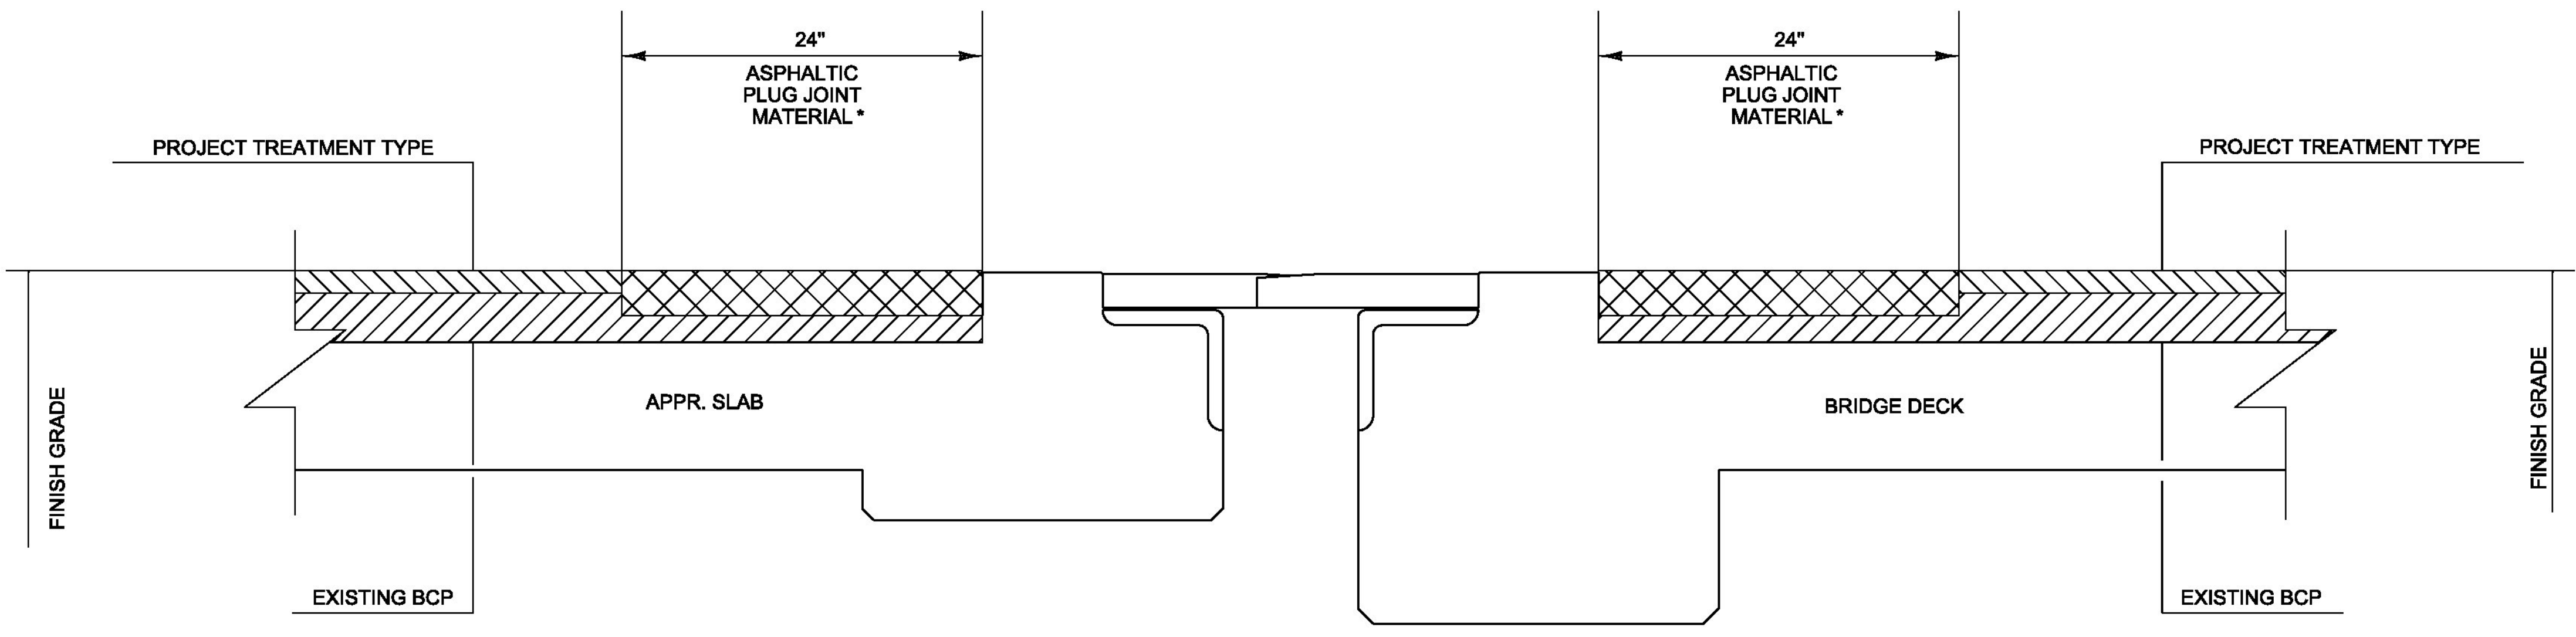

* 2" MAXIMUM DEPTH UNLESS OTHERWISE DIRECTED BY THE ENGINEER

**EXPANSION JOINT - ASPHALTIC PLUG DETAIL
CROSS SECTION VIEW
(FINGER PLATE JOINT)**

NOT TO SCALE

PROJECT NAME:	HARTFORD-SHARON
PROJECT NUMBER:	IM SURF(46)
FILE NAME:	I3a638/pvtmg+/p3a638_wrk.dgn
PROJECT LEADER:	J. HARRINGTON
DESIGNED BY:	PVT. MGT.
BRIDGE DETAIL SHEET 3	
PLOT DATE:	06-JUN-2014
DRAWN BY:	PVT. MGT.
CHECKED BY:	PVT. MGT.
SHEET 48 OF 64	