

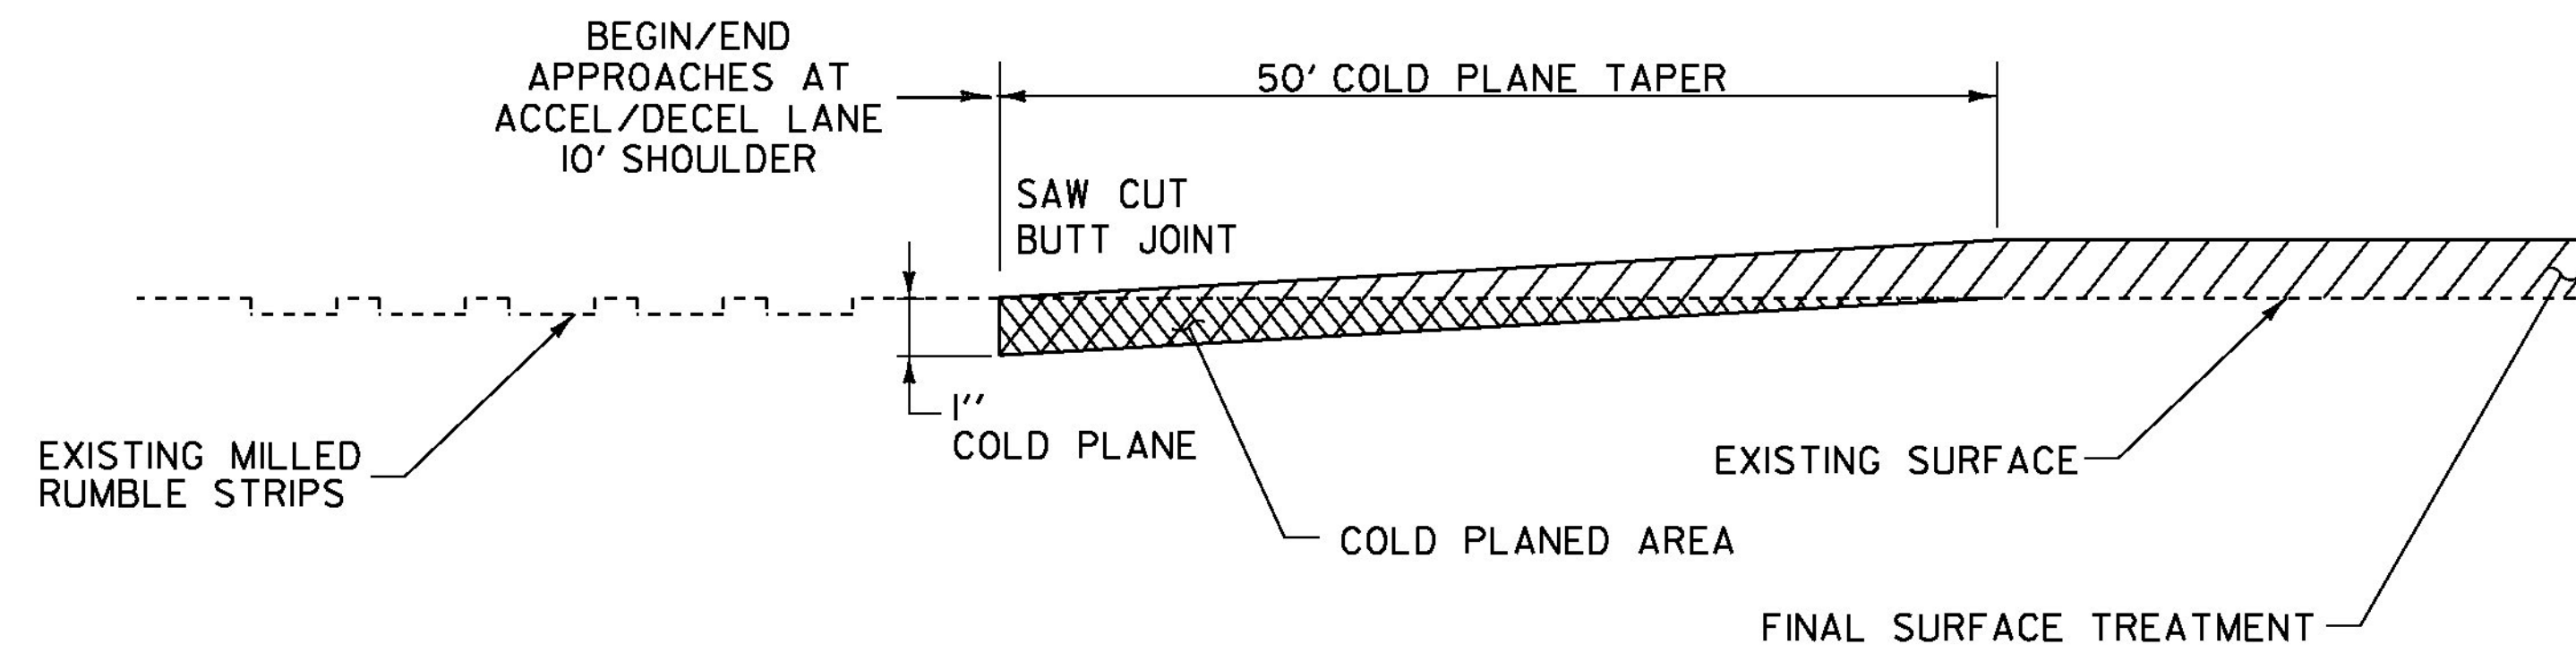
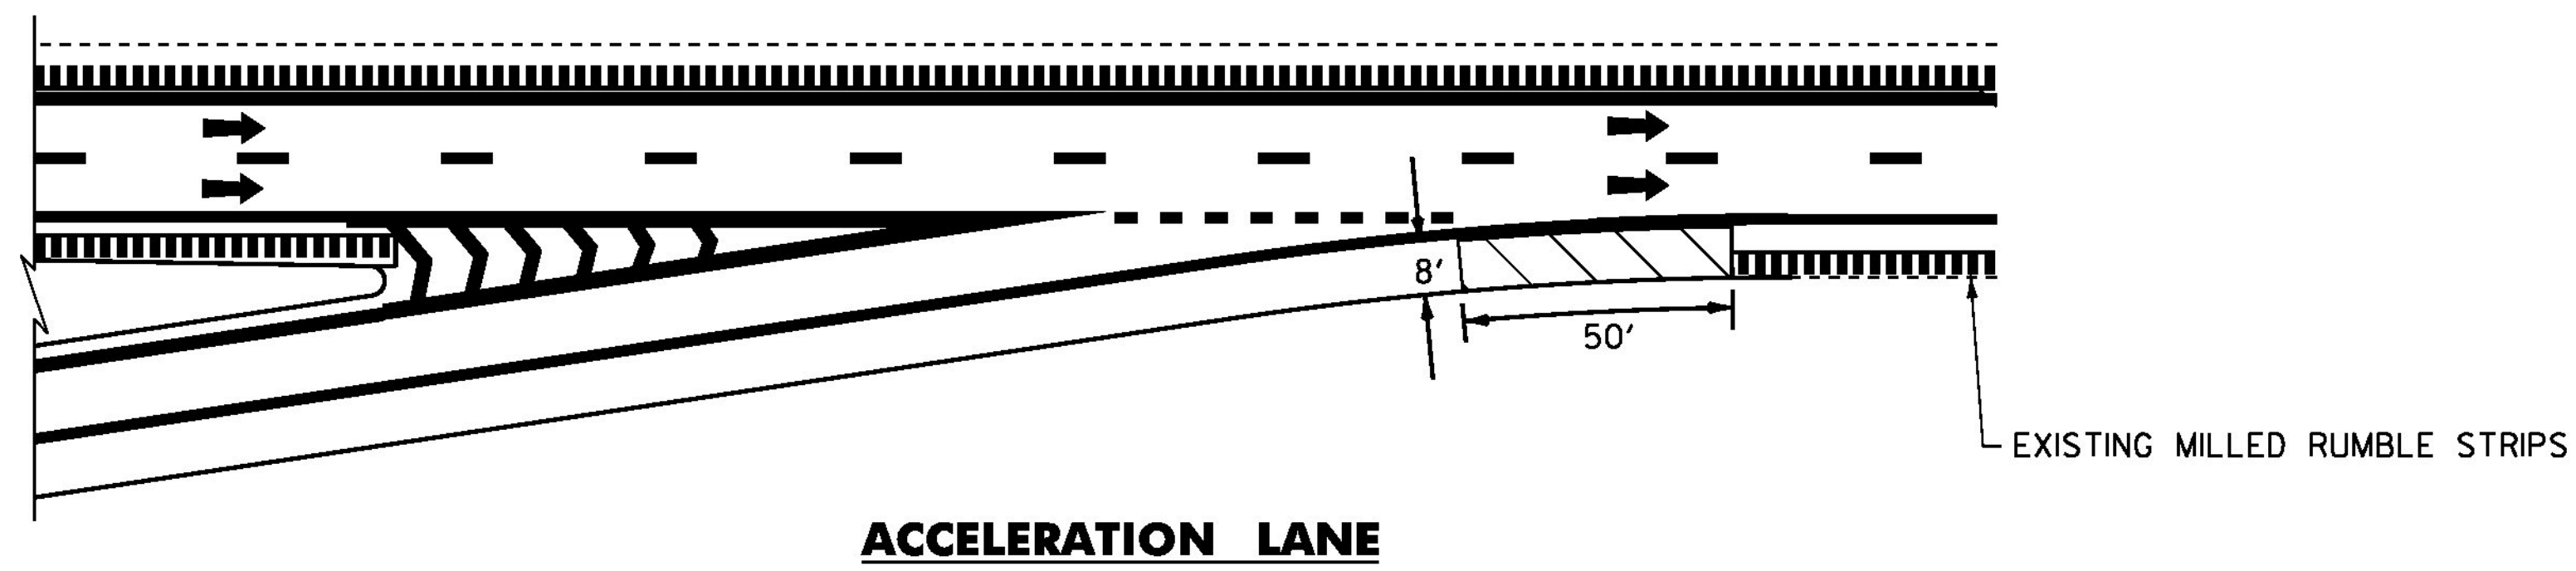


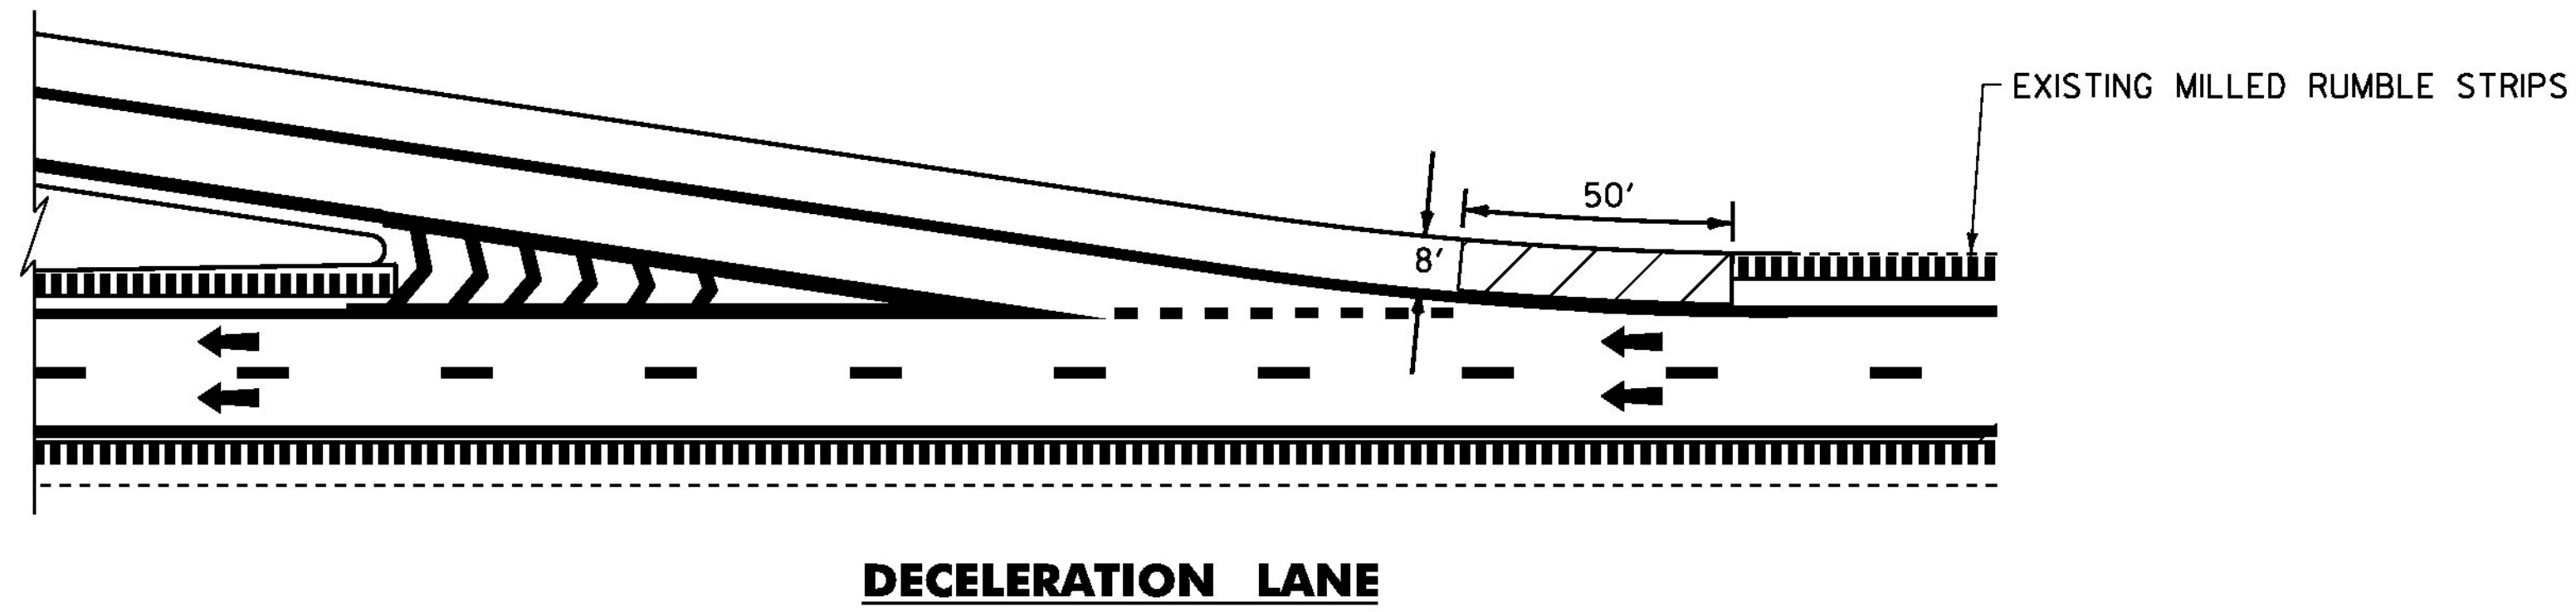

**TYPICAL INTERCHANGE CONSTRUCTION DETAILS # 2**

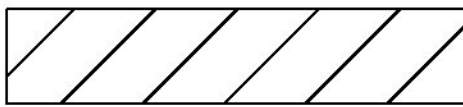

**TYPICAL APPROACH AREA DETAIL AT ACCEL/DECEL LANE 10 FT SHOULDER**

**LEGEND**

-  AREA TO BE COLD PLANED
-  DIRECTION OF TRAFFIC FLOW
-  EXISTING MILLED RUMBLE STRIPS

**NOT TO SCALE**

PROJECT NAME:	HARTFORD-SHARON
PROJECT NUMBER:	IM SURF(46)
FILE NAME:	I3a638/pvtmgt/p3a638_wrk.dgn
PROJECT LEADER:	J. HARRINGTON
DESIGNED BY:	PVT. MGT.
INTERCHANGE DETAIL SHEET 2	
DRAWN BY:	PVT. MGT.
CHECKED BY:	PVT. MGT.
SHEET	51 OF 64