

DURABLE 6 INCH WHITE LINE, POLYUREA  
 TEMPORARY 6 INCH WHITE LINE, PAINT  
 STA 2+64 TO 316+80.00 C.L. (DASHED)  
 STA 2+64 TO 316+80.00 RT (SOLID)


DURABLE 6 INCH YELLOW LINE, POLYUREA  
 TEMPORARY 6 INCH YELLOW LINE, PAINT  
 STA 2+64 TO 316+80.00 LT (SOLID)

**INTERSTATE ROUTE 89**

~~STA 2+64~~ STA 2+00.64  
 (MM 0.050) (MM 0.038)  
**BEGIN PROJECT**  
**IM SURF(46)**

BRIDGE #6N  
 STA 56+54.88  
 (MM 1.071)  
 REFER TO BRIDGE DETAIL SHEETS  
 FOR COLD PLANING, PAVING  
 AND EXPANSION JOINTS

STA 316+80.00  
 (MM 6.000)

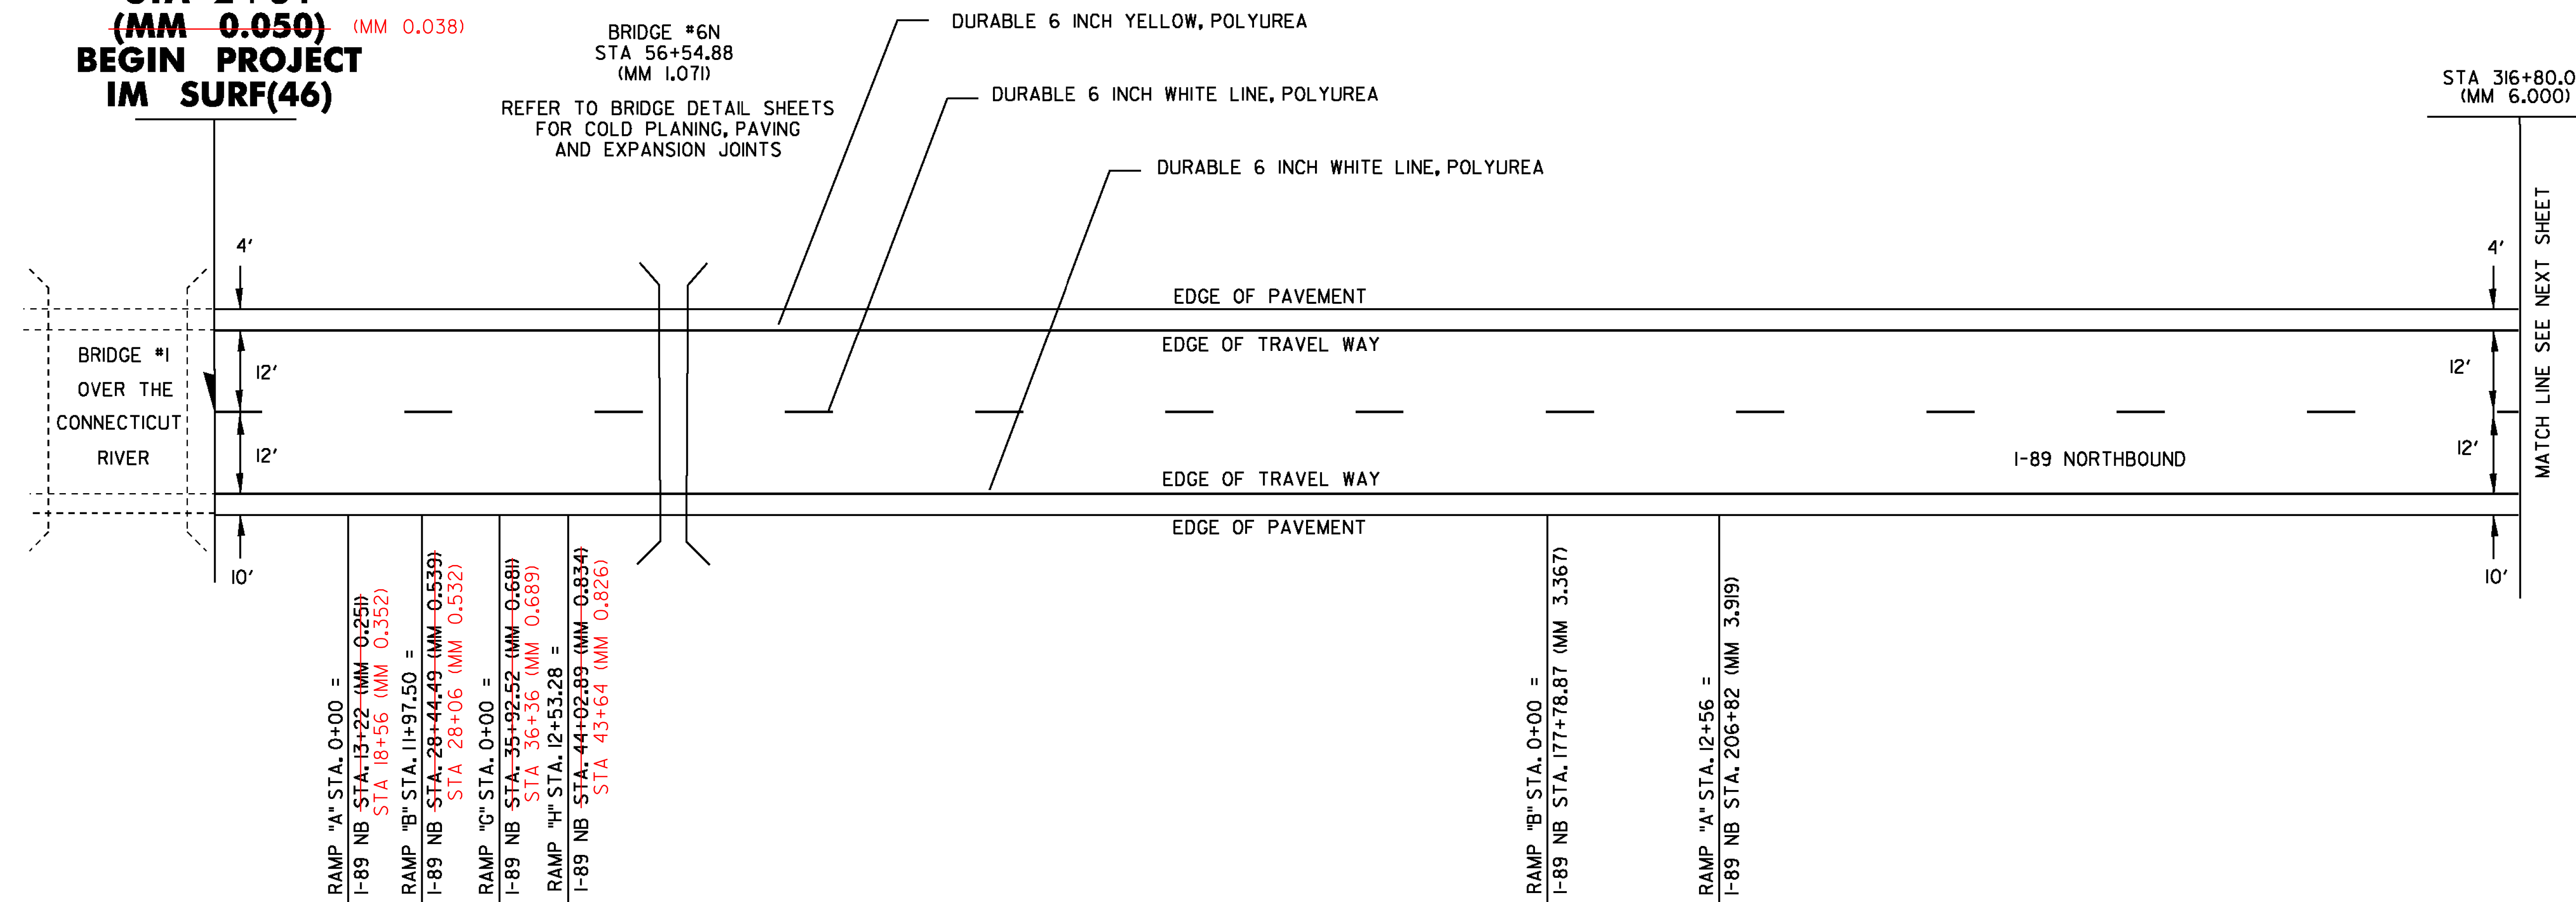

RAMP "A" STA. 0+00 =  
 I-89 NB STA. 13+22 (MM 0.251)  
 STA 18+56 (MM 0.552)  
 RAMP "B" STA. 11+97.50 =  
 I-89 NB STA. 28+44.49 (MM 0.539)  
 STA 28+06 (MM 0.532)  
 RAMP "C" STA. 0+00 =  
 I-89 NB STA. 35+92.52 (MM 0.681)  
 STA 36+36 (MM 0.689)  
 RAMP "H" STA. 12+53.28 =  
 I-89 NB STA. 44+02.89 (MM 0.834)  
 STA 43+64 (MM 0.826)

REFER TO WHITE RIVER JCT. INTERCHANGE  
 PAVEMENT MARKING DETAILS

RAMP "B" STA. 0+00 =  
 I-89 NB STA. 177+78.87 (MM 3.367)  
 RAMP "A" STA. 12+56 =  
 I-89 NB STA. 206+82 (MM 3.919)

REFER TO QUECHEE INTERCHANGE  
 PAVEMENT MARKING DETAIL

**NOT TO SCALE**

PROJECT NAME:	HARTFORD-SHARON
PROJECT NUMBER:	IM SURF(46)
FILE NAME:	I3a638/pvtmgt/pl3a638_wrk.dgn
PROJECT LEADER:	J. HARRINGTON
DESIGNED BY:	PVT. MGT.
PAVEMENT MARKING DETAIL SHEET I	
PLOT DATE:	06-JUN-2014
DRAWN BY:	PVT. MGT.
CHECKED BY:	PVT. MGT.
SHEET	52 OF 64