


DURABLE 6 INCH WHITE LINE, POLYUREA
 TEMPORARY 6 INCH WHITE LINE, PAINT
 WHITE RIVER JCT, INTERCHANGE
 RAMP H
 NORTHBOUND ON RAMP STA. 0+00 TO 12+53 RT (SOLID)
 NORTHBOUND ON RAMP STA. 12+53 TO 14+57 RT (DASHED)

DURABLE 6 INCH YELLOW LINE, POLYUREA
 TEMPORARY 6 INCH YELLOW LINE, PAINT
 WHITE RIVER JCT, INTERCHANGE
 RAMP H
 NORTHBOUND ON RAMP STA. 0+00 TO 11+02 LT (SOLID)

DURABLE 12 INCH WHITE LINE, POLYUREA
 TEMPORARY 12 INCH WHITE LINE, PAINT
 WHITE RIVER JCT, INTERCHANGE
 RAMP H
 NORTHBOUND ON RAMP STA. 11+02 TO 12+53 LT (GORE AREA)
 NORTHBOUND ON RAMP STA. 0+00 LT (GORE AREA W/DIAG. AT I-91 SB)

RAMP H OMITTED FROM PROJECT
 ONLY PAVED FROM STA 43+64 INTO MERGE LANE

**WHITE RIVER JCT. INTERCHANGE
 I-89 - RAMP H
 SOUTHBOUND ON RAMP**

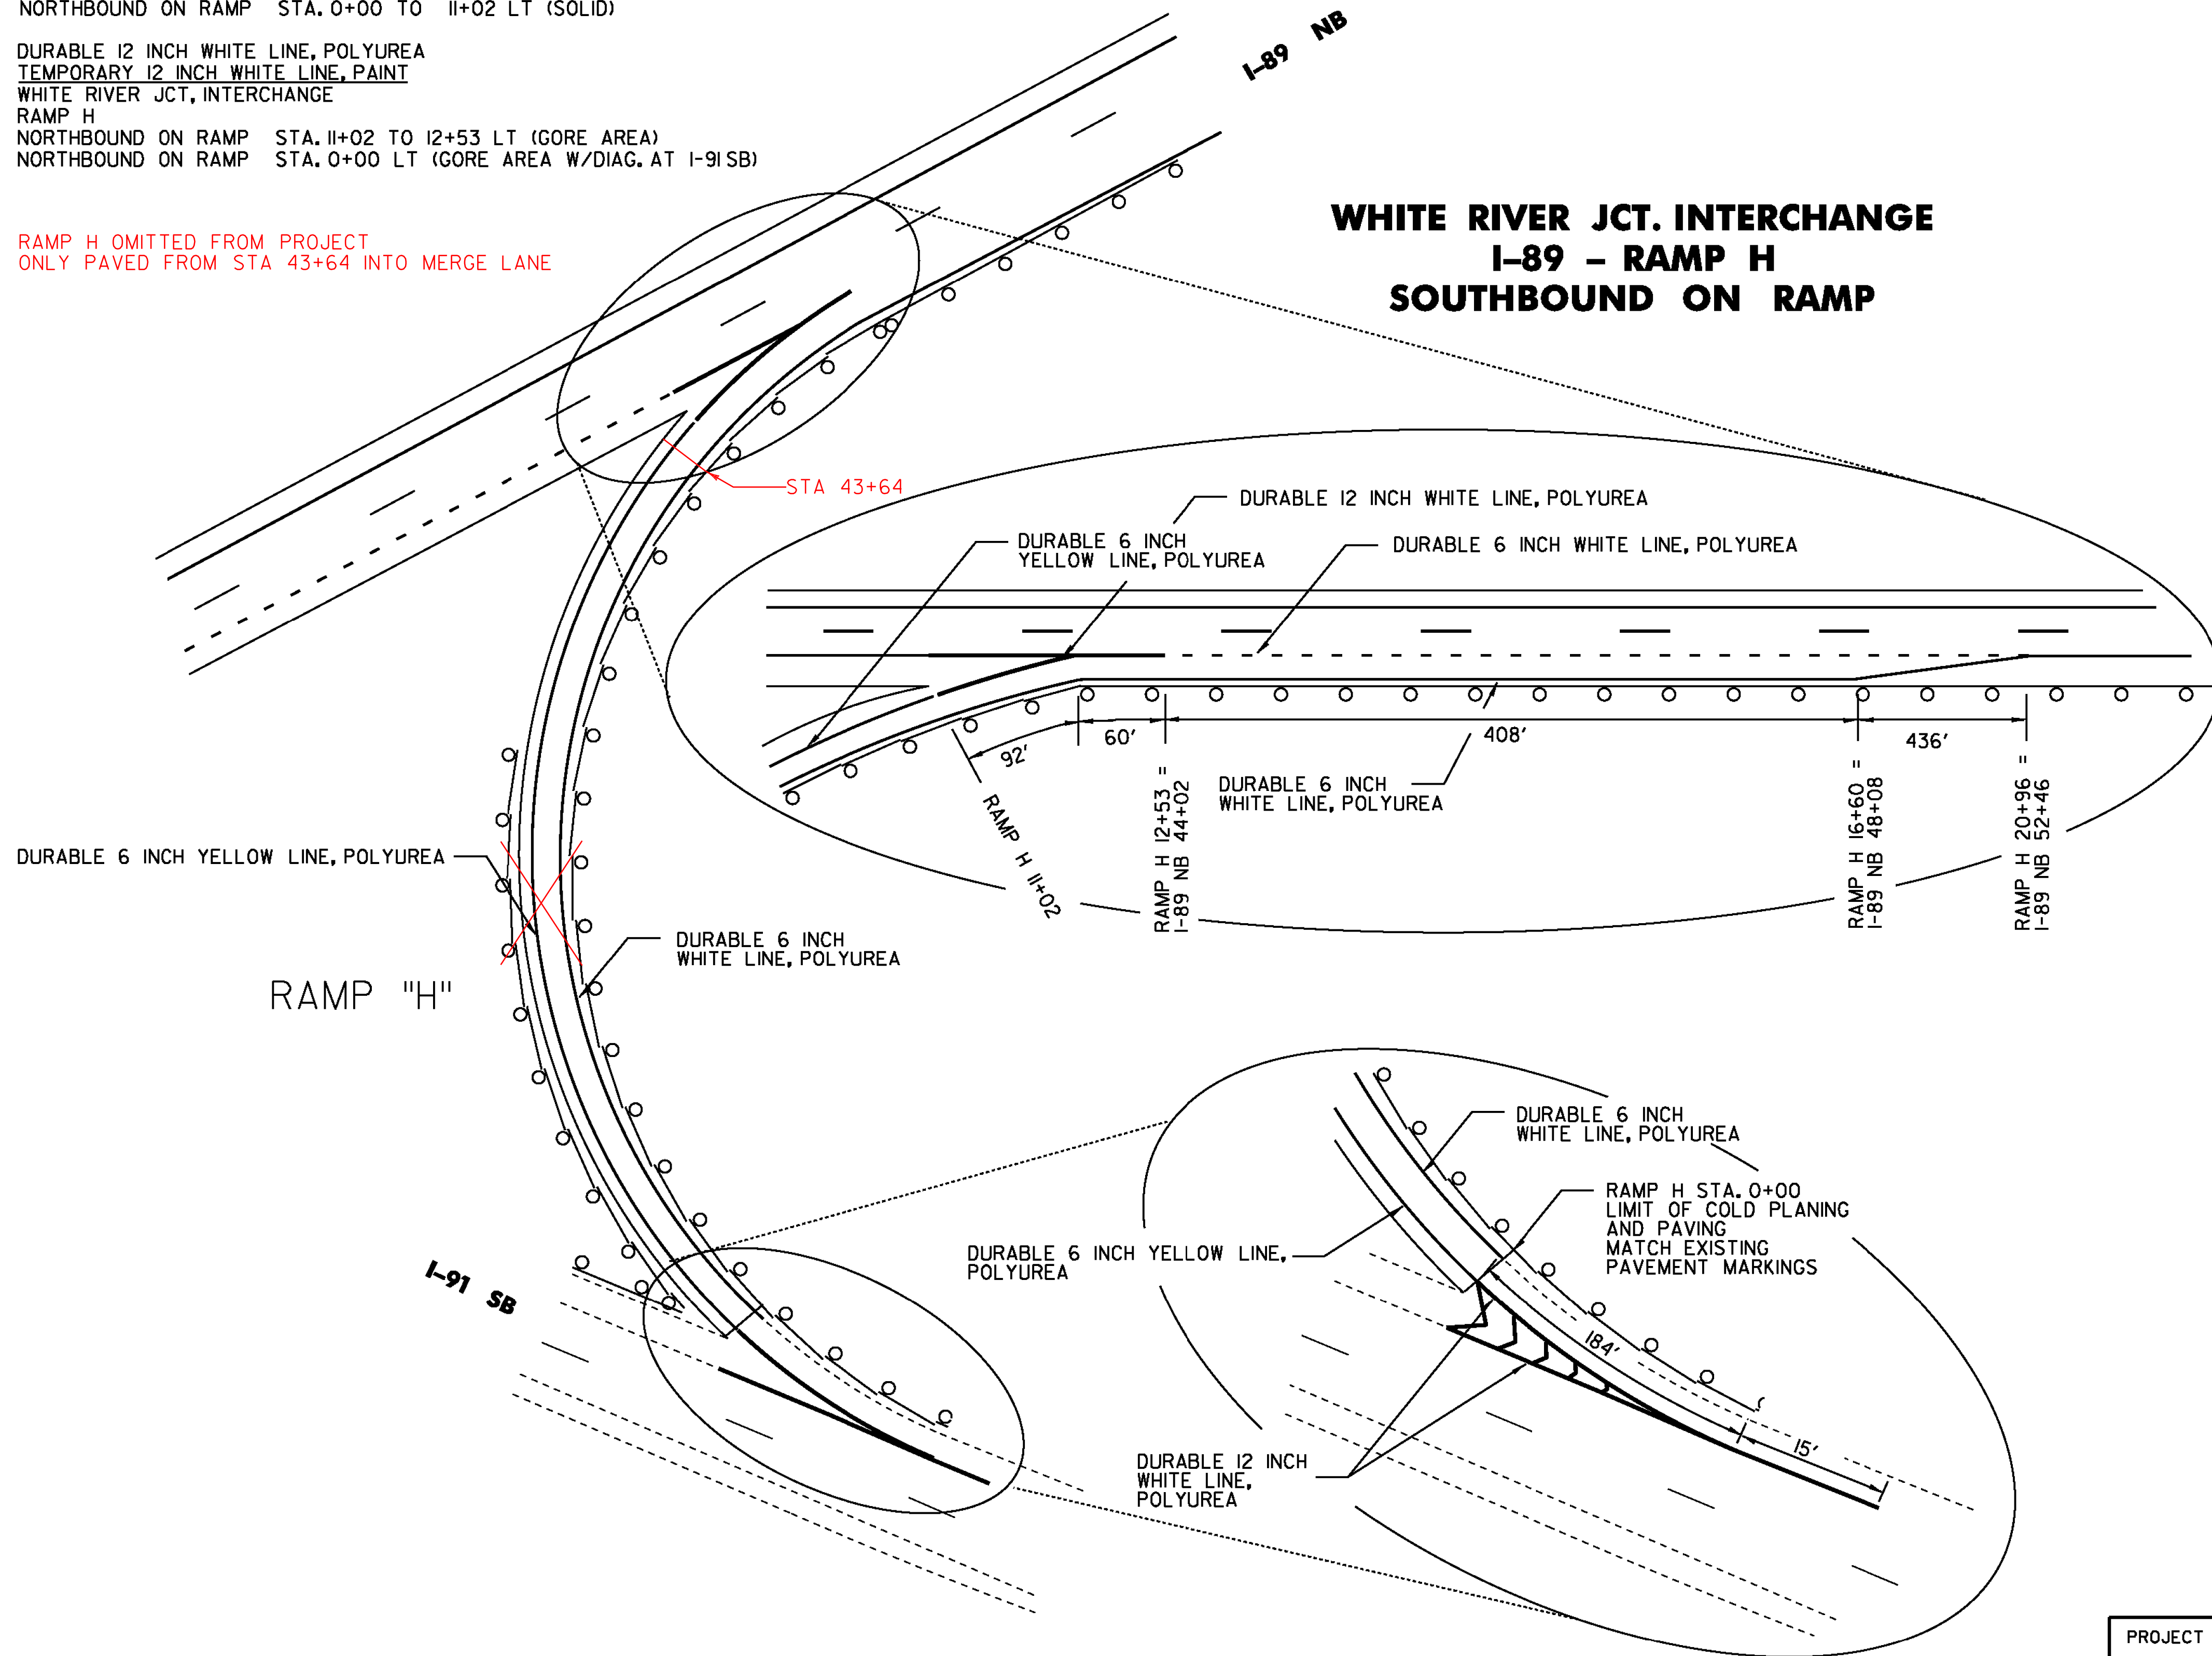

NOT TO SCALE

PROJECT NAME:	HARTFORD-SHARON
PROJECT NUMBER:	IM SURF(46)
FILE NAME:	I3a638/pvtmgt/pl3a638_wrk.dgn
PROJECT LEADER:	J. HARRINGTON
DESIGNED BY:	PVT. MGT.
PAVEMENT MARKING DETAIL SHEET 5	
PLOT DATE:	06-JUN-2014
DRAWN BY:	PVT. MGT.
CHECKED BY:	PVT. MGT.
SHEET	56 OF 64