


**ROADWAY PROJECT TYPICAL SECTION - ALTERNATE A**  
**I-93 NORTHBOUND WATERFORD M.M. 0.038 - WATERFORD M.M. 11.128**  
**I-93 SOUTHBOUND WATERFORD M.M. 0.051 - WATERFORD M.M. 11.184**

NOT TO SCALE

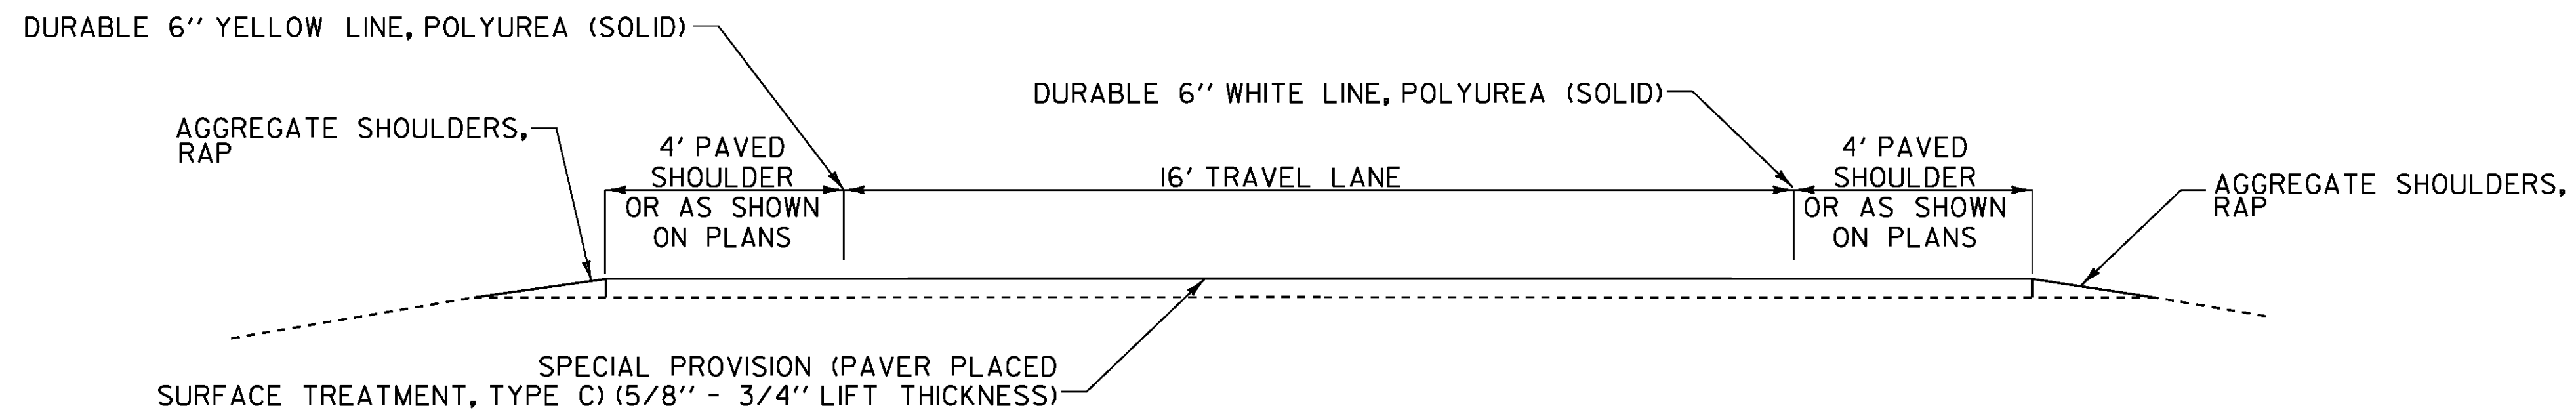

**TYPICAL RAMP SECTION**  
**ALTERNATE A**  
 NOT TO SCALE

<b>TYPICAL SECTION - ALTERNATE A</b>	PROJECT NAME: WATERFORD	
	PROJECT NUMBER: IM SURF(47)	
	FILE NAME: I4aI22\pl4aI22.dgn	PLOT DATE: 10-DEC-2014
	PROJECT LEADER: M. FOWLER	DRAWN BY: K. LOCKE
	DESIGNED BY: K. LOCKE	CHECKED BY: M. FOWLER
	IPARM FILE NAME: pl4aI22_03.1	SHEET 3 OF 22