


STATE OF VERMONT AGENCY OF TRANSPORTATION

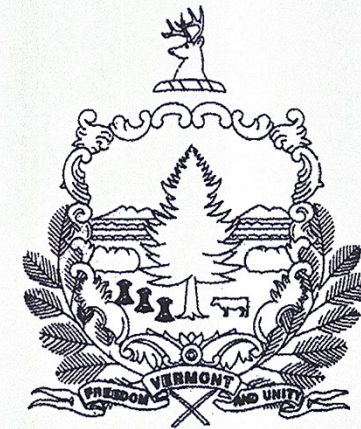

PROPOSED IMPROVEMENT TOWNS OF NORWICH, THETFORD & FAIRLEE COUNTIES OF WINDSOR & ORANGE INTERSTATE ROUTE 91 (NHS)

IM SURF(48) NORTHBOUND:
BEGINNING IN THE TOWN OF NORWICH AT MILE MARKER 74.810 AND EXTENDING NORTHERLY ALONG INTERSTATE ROUTE 91
(NORTHBOUND BARREL) FOR A DISTANCE OF 93,403.20 FT (17.690 MILES) TO MILE MARKER 92.500 IN THE TOWN OF FAIRLEE.

NB LENGTH OF ROADWAY = 93,403.20 FT = (17.690 MILES)
NB LENGTH OF PROJECT = 93,403.20 FT = (17.690 MILES)


WORK TO BE PERFORMED UNDER THIS PROJECT INCLUDES SURFACE PREPARATION INVOLVING PATCHING, POT HOLE REPAIR, CRACK SEALING AND OVERLAYING
WITH A THIN BITUMINOUS CONCRETE WEARING SURFACE ON THE EXISTING INTERSTATE TYPICAL, PAVEMENT MARKINGS, AND OTHER RELATED HIGHWAY ITEMS.

INDEX OF SHEETS


- 1 TITLE SHEET
- 2 CONVENTIONAL SYMBOLOLOGY - LEGEND
- 3 TYPICAL SECTION - ALTERNATE A
- 4 TYPICAL SECTION - ALTERNATE B
- 5 PROJECT NOTES AND DETAILS
- 6-9 BRIDGE DETAIL SHEETS
- 10-11 TYPICAL INTERCHANGE CONSTRUCTION DETAILS
- 12-13 QUANTITY SHEETS
- 14-18 PAVEMENT MARKING DETAIL SHEETS
- 19 CONSTRUCTION APPROACH SIGNING
- 20 CONSTRUCTION APPROACH SIGNING NOTES
- 21 ROUGHNESS DATA INFORMATION SHEET
- 22 RUTTING DATA INFORMATION SHEET
- STRUCTURES DETAIL SD-516.10

VAOT STANDARDS

E-191	02/01/99
E-192	10/12/00
E-193	08/18/95
T-1	08/06/12
T-10	08/06/12
T-11	08/06/12
T-12	08/06/12
T-13	08/06/12
T-16	08/06/12
T-17	08/06/12
T-22	08/06/12
T-23	08/06/12
T-24	08/06/12
T-28	08/06/12
T-29	08/06/12
T-30	08/06/12
T-31	08/06/12
T-33	08/06/12
T-36	08/06/12

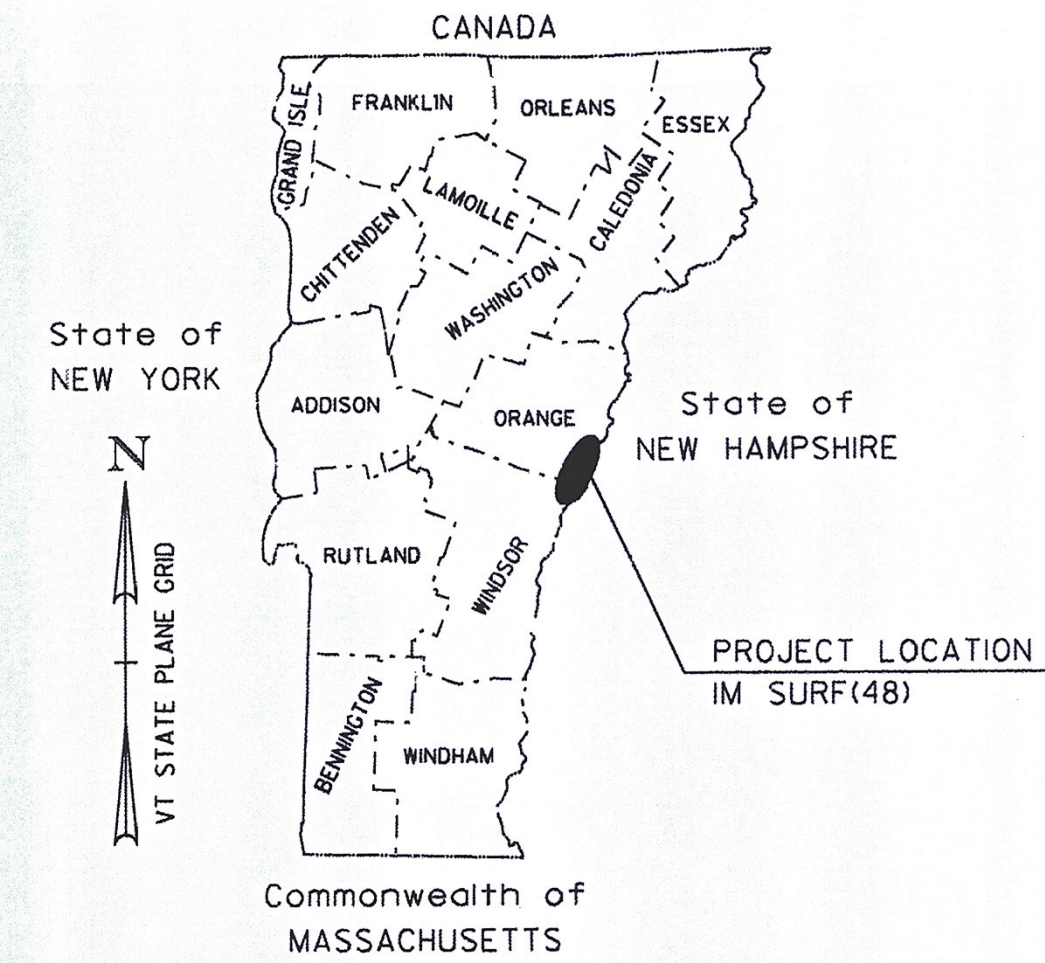

RECORD PLANS	
CONTRACTOR:	GORMAN GROUP, LLC - ALBANY, NY
RESIDENT ENGINEER:	SANDY SCHMITT
CONSTRUCTION BEGAN:	APRIL 22, 2015
CONSTRUCTION COMPLETE:	JULY 20, 2015
RECORD PLANS BY:	SANDY SCHMITT & C. PIERCE
I HEREBY CERTIFY THAT ALL THE CONSTRUCTION REQUIRED BY THIS SET OF DRAWINGS HAS BEEN ACCOMPLISHED AS INDICATED HEREIN.	
BY:	<i>Sandy Schmitt</i> RESIDENT ENGINEER
DATE:	03-16-16
NOTE: Any further information concerning final quantities, amounts or other details relative to this project may be found at Central Files in the electronic archives.	

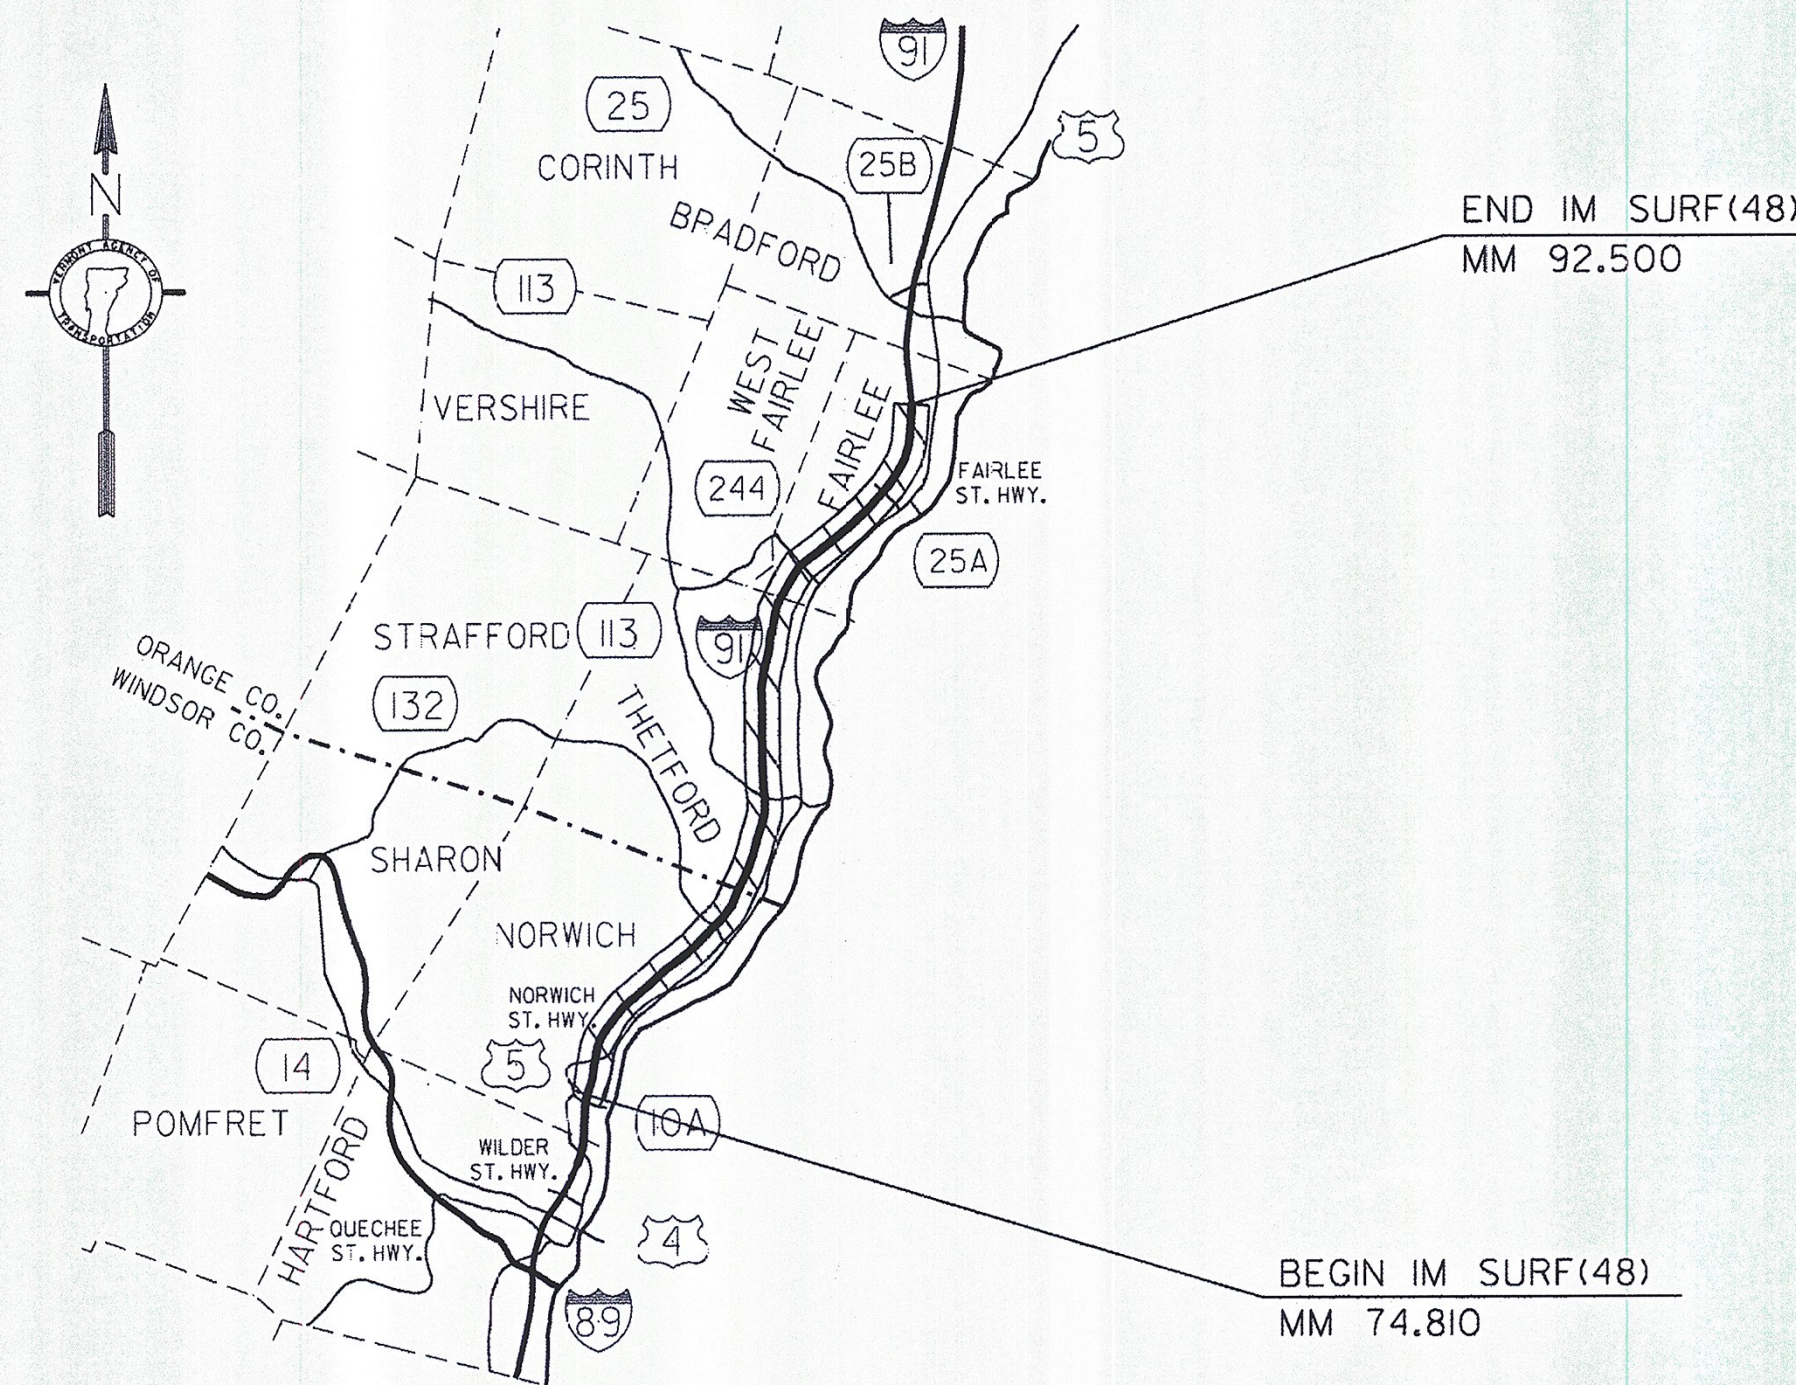

I-91 NORTHBOUND	TRAFFIC DATA					
	2015 AADT	2025 AADT	2015 DHV	2025 DHV	FLEXIBLE ESALS (2015-2025)	FLEXIBLE ESALS (2015-2035)
BEGIN PROJECT TO EXIT 14	5900	6300	920	980	1,716,000	3,870,000
EXIT 14 TO EXIT 15	5300	5700	820	880	1,682,000	3,962,000
EXIT 15 TO END OF PROJECT	3900	4100	600	630	1,700,000	3,937,000

CONSTRUCTION IS TO BE CARRIED ON IN ACCORDANCE WITH THESE PLANS AND THE STANDARD SPECIFICATIONS FOR CONSTRUCTION DATED 2011, AS APPROVED BY THE FEDERAL HIGHWAY ADMINISTRATION ON JULY 20, 2011 FOR USE ON THIS PROJECT, INCLUDING ALL SUBSEQUENT REVISIONS AND SUCH REVISED SPECIFICATIONS AND SPECIAL PROVISIONS AS ARE INCORPORATED IN THESE PLANS.

QUALITY ASSURANCE PROGRAM : LEVEL I
SURVEYED BY : N/A
SURVEYED DATE : N/A
DATUM
VERTICAL: N/A
HORIZONTAL: N/A

DIRECTOR OF PROJECT DELIVERY	
APPROVED: <i>J.C.H.</i>	DATE: 12/15/2014
PROJECT MANAGER : JONATHAN C. HARRINGTON, P. E.	
PROJECT NAME :	NORWICH - FAIRLEE
PROJECT NUMBER :	IM SURF (48)
SHEET 1	OF 22 SHEETS

NOT TO SCALE