


ROADWAY TYPICAL NORMAL SECTION

ALTERNATE B

I-91 NORTHBOUND NORWICH MM 74.810 - FAIRLEE MM 92.500

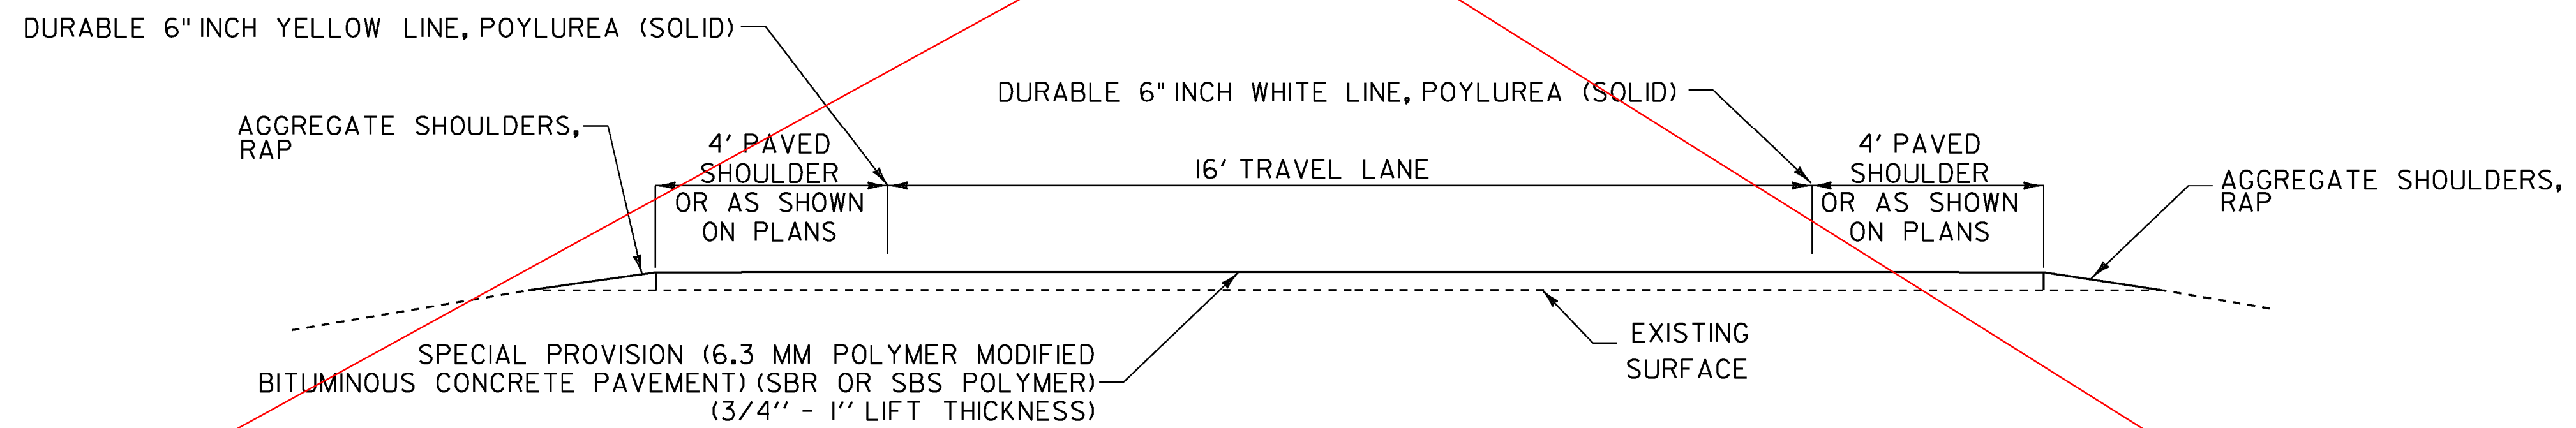

ROADWAY TYPICAL RAMP SECTION

ALTERNATE B

ALTERNATE A USED

NOTE:

1. PRIOR TO THE PLACEMENT OF THE 6.3 MM POLYMER MODIFIED BITUMINOUS CONCRETE PAVEMENT, EMULSIFIED ASPHALT SHALL BE APPLIED TO ALL EXISTING PAVEMENT SURFACES AND ON ALL COLD PLANED SURFACES AT A RATE OF 0.080 GAL/SY (+/- 0.01 GAL/SY) OR AS DIRECTED BY THE ENGINEER. EMULSIFIED ASPHALT SHALL BE RS-IH OR CRS-IH PER THE MANUFACTURER'S RECOMMENDATION AND PAID UNDER ITEM 900.683 SPECIAL PROVISION (EMULSIFIED ASPHALT) (RS-IH OR CRS-IH).

NOT TO SCALE

PROJECT NAME: NORWICH - FAIRLEE
PROJECT NUMBER: IM SURF(48)

FILE NAME: I4a144 Norwich-Fairlee.dgn PLOT DATE: 19-DEC-2014
PROJECT LEADER: J. HARRINGTON DRAWN BY: N. PAPPAS
DESIGNED BY: N. PAPPAS CHECKED BY: J. HARRINGTON
TYPICAL SECTION - ALTERNATE B SHEET 4 OF 22