


↑
NORTHBOUND
DIRECTION OF TRAVEL

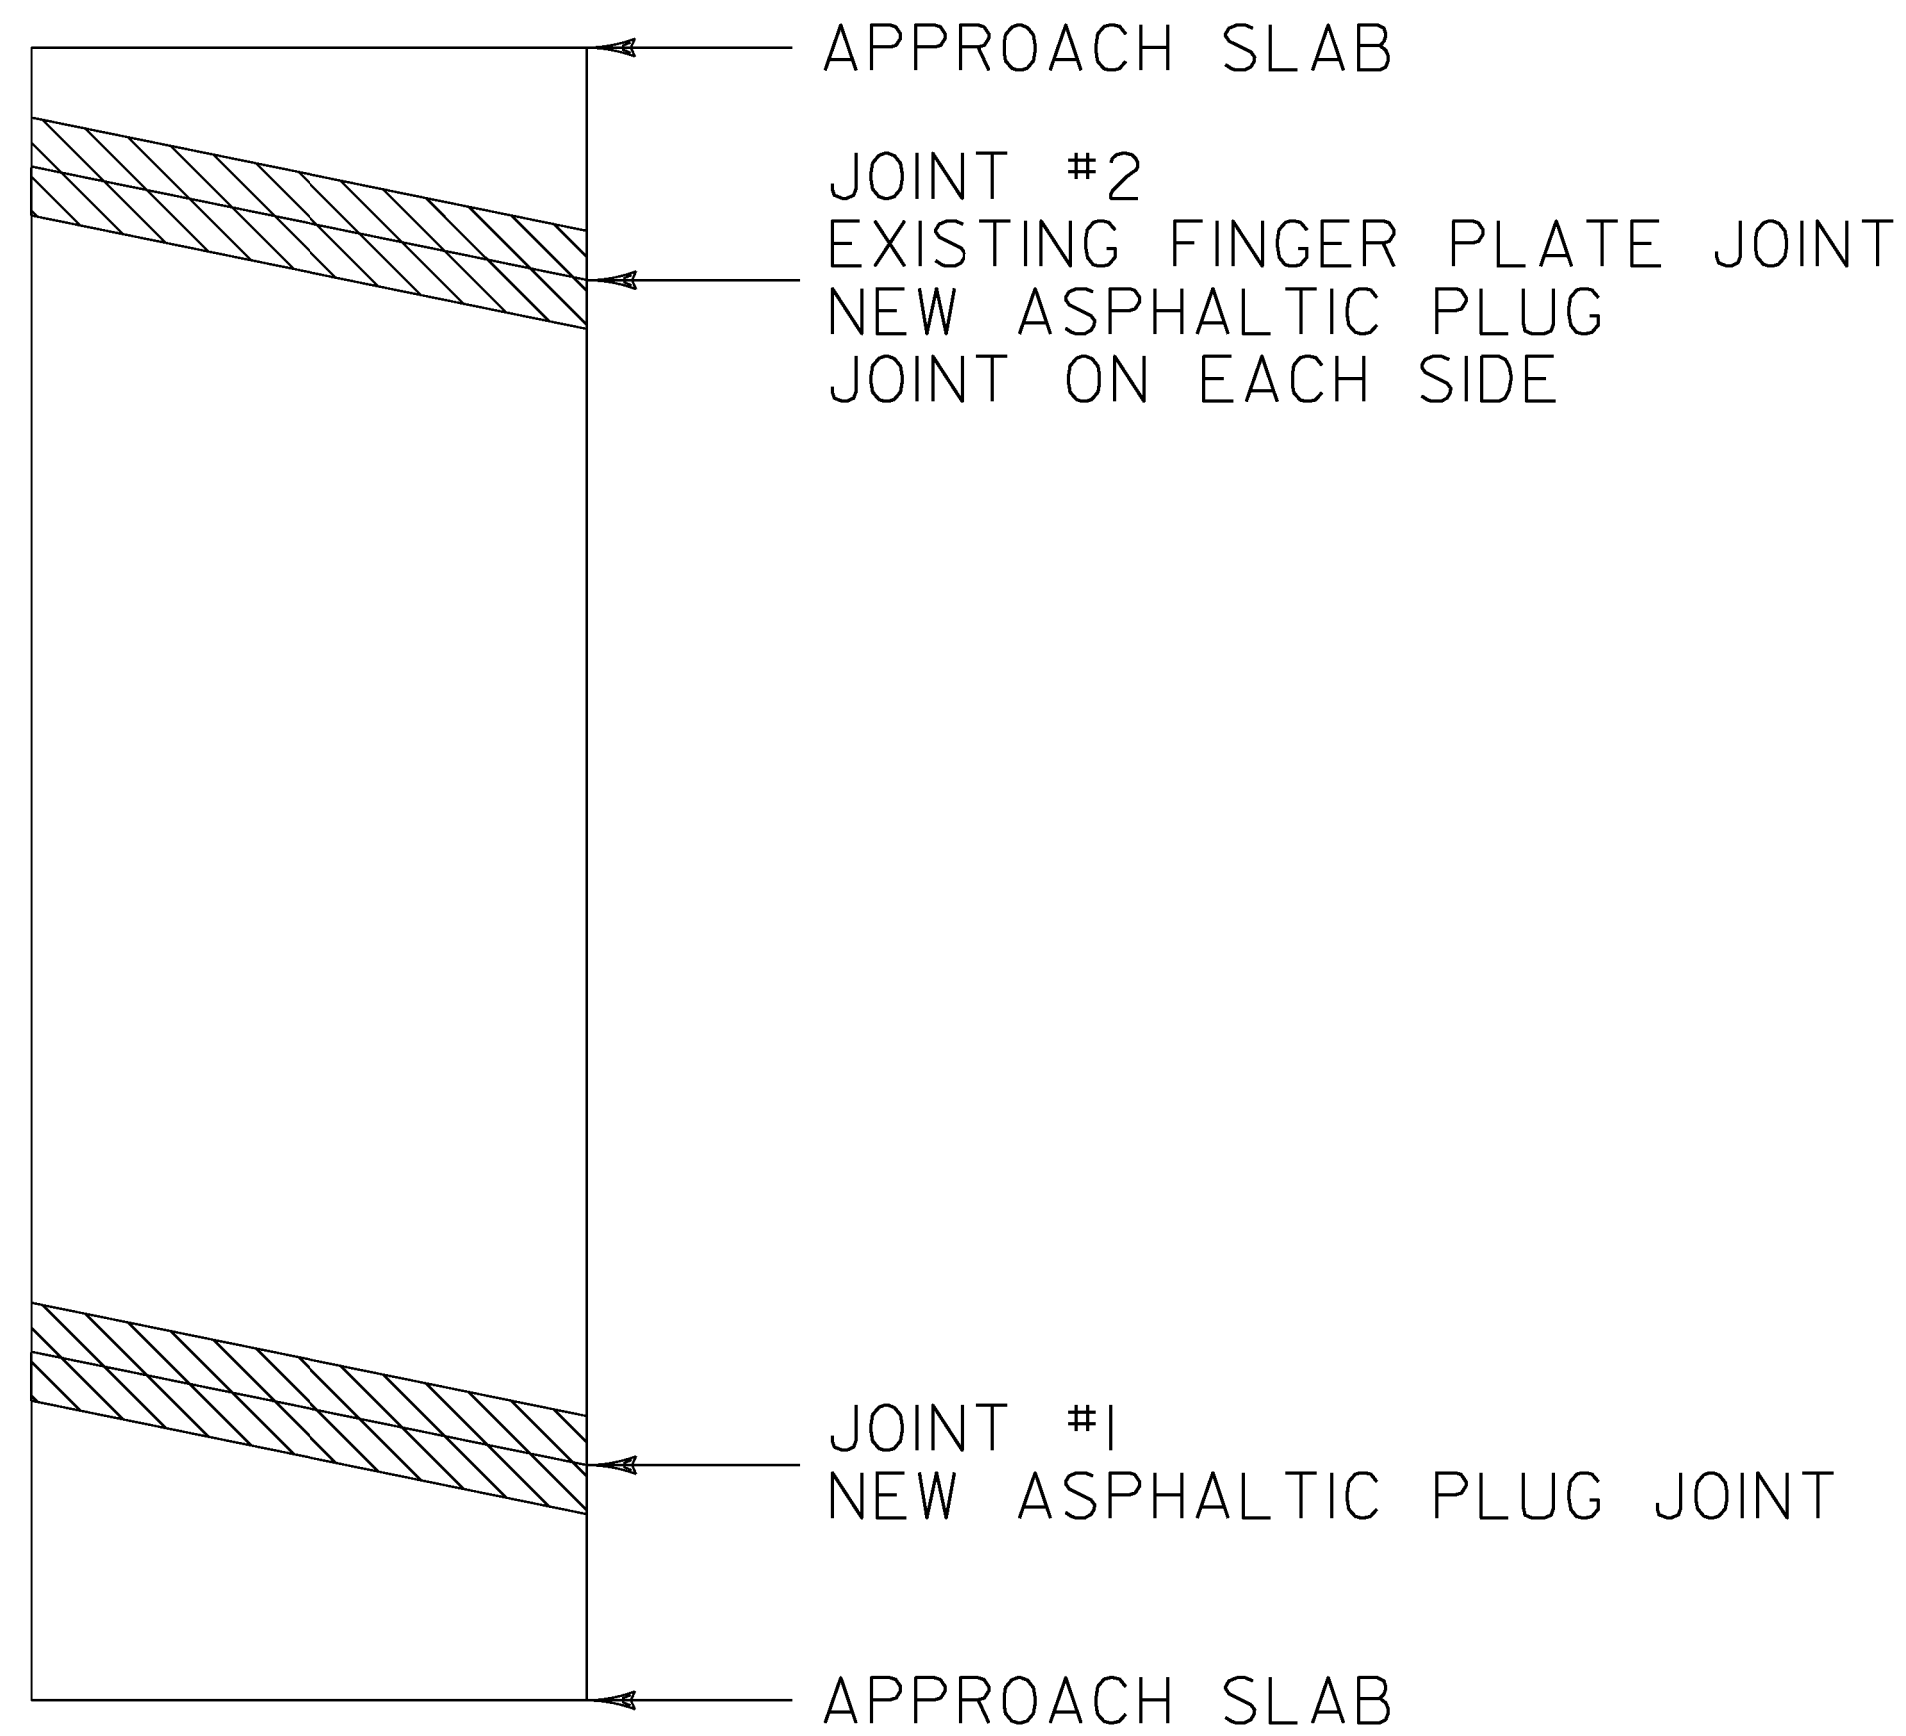


BRIDGE 55N

MM 89.266

LENGTH OF ASPHALTIC PLUG JOINTS:

JOINT #1 - ~~50'~~ 49.5'
JOINT #2 - ~~50'~~ X 2 = ~~100'~~ 98'
TOTAL = ~~150'~~ 147.5'

↑
NORTHBOUND
DIRECTION OF TRAVEL

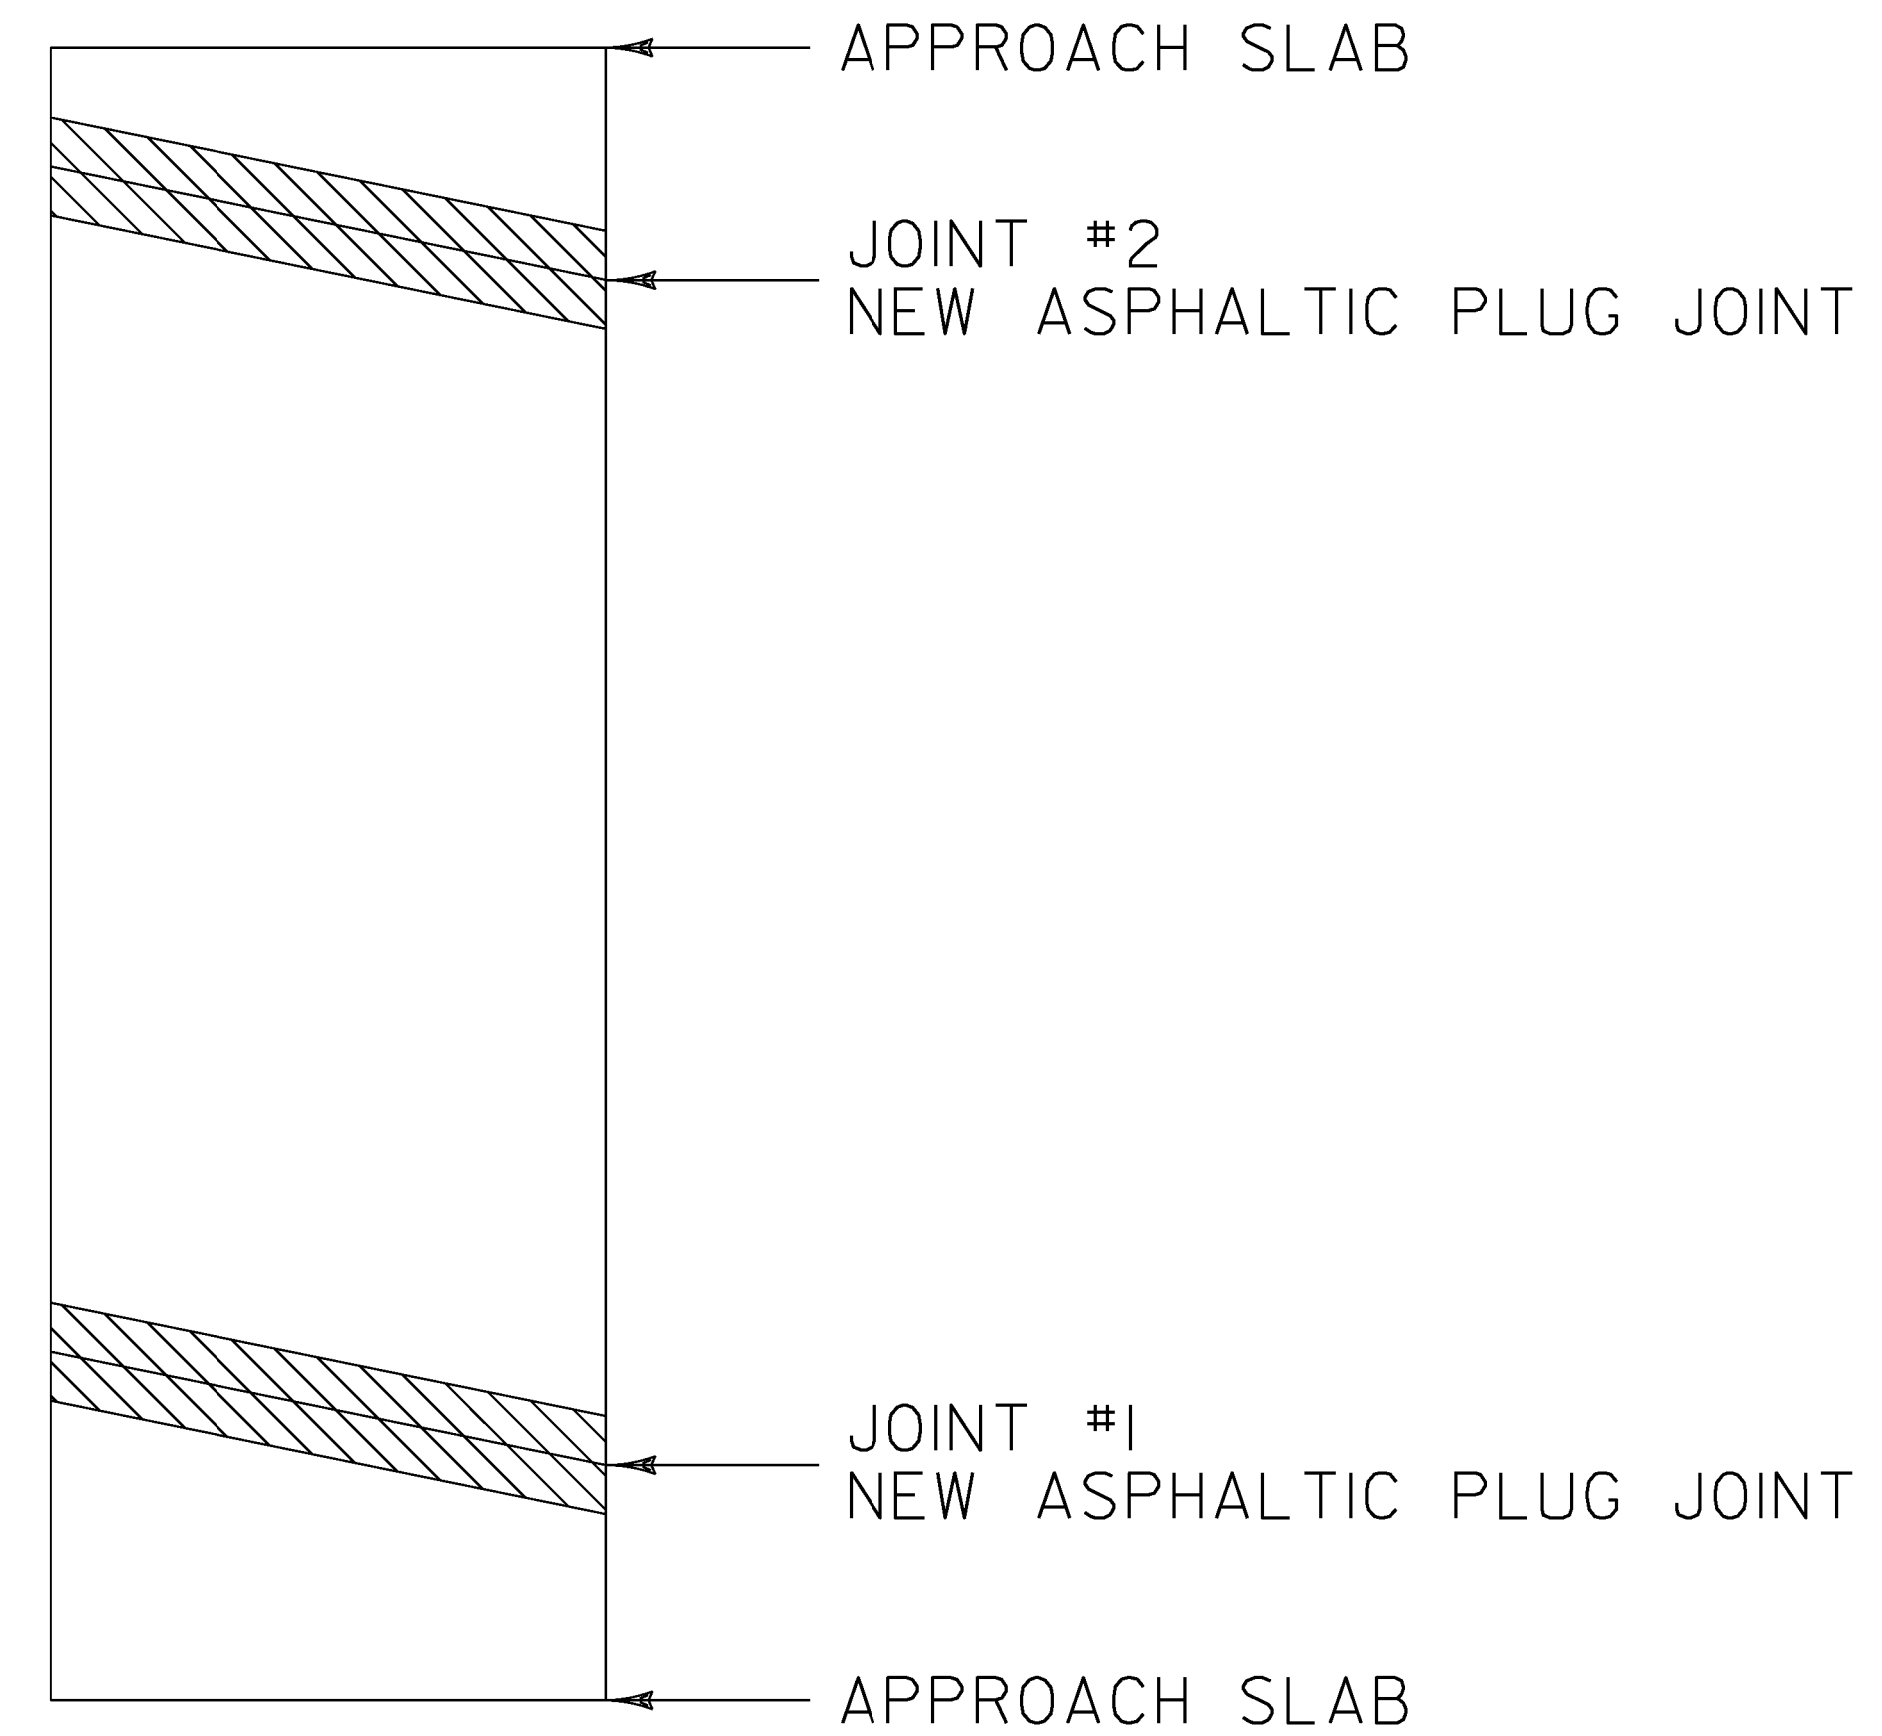


BRIDGE 56N

MM 91.539

LENGTH OF ASPHALTIC PLUG JOINTS:

JOINT #1 - ~~40'~~ 40.5'
JOINT #2 - ~~40'~~ 40.5'
TOTAL = ~~80'~~ 81'

LEGEND

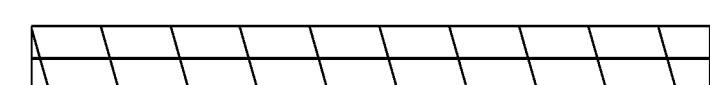

EXISTING BRIDGE JOINTS TO BE REPAIRED
WITH ASPHALTIC PLUG JOINT.

NOT TO SCALE

PROJECT NAME: NORWICH - FAIRLEE	PLOT DATE: 15-DEC-2014
PROJECT NUMBER: IM SURF(48)	DRAWN BY: N. PAPPAS
FILE NAME: I4a144 Norwich-Fairlee.dgn	CHECKED BY: J. HARRINGTON
PROJECT LEADER: J. HARRINGTON	SHEET 8 OF 22
DESIGNED BY: N. PAPPAS	BRIDGE DETAIL SHEET 3