


**EXPANSION JOINT - ASPHALTIC PLUG DETAIL  
PLAN VIEW  
(FINGER PLATE JOINT)**

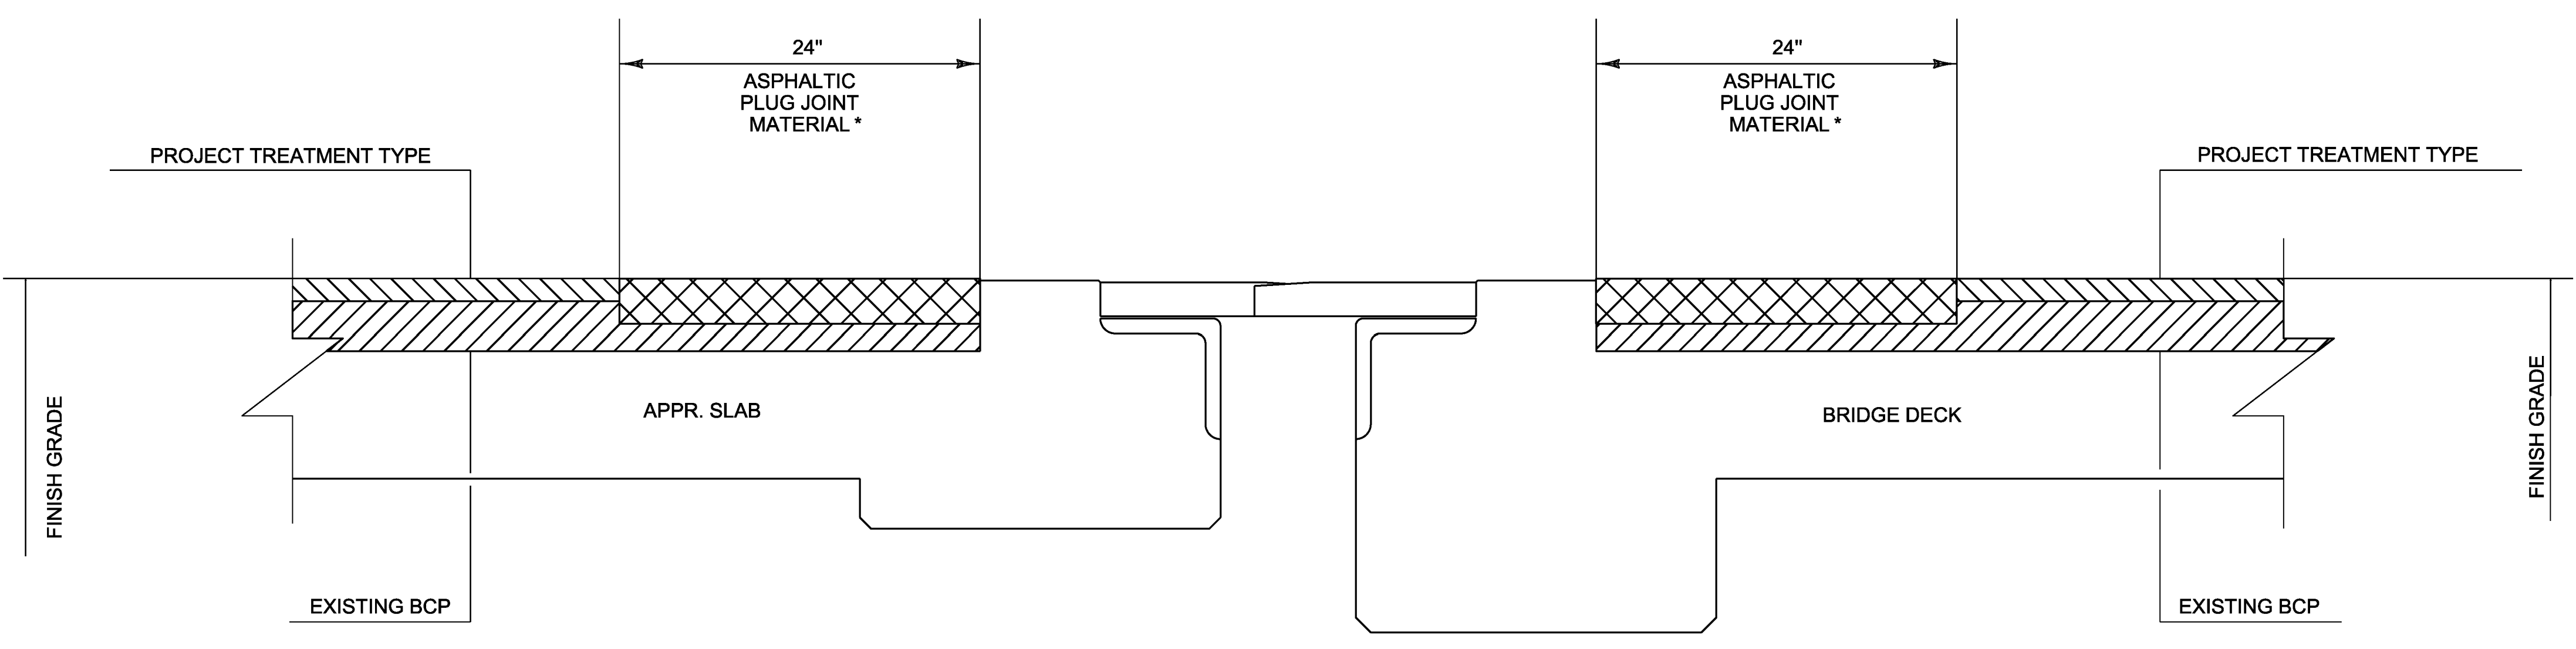

\* 2" MINIMUM DEPTH UNLESS OTHERWISE DIRECTED BY THE ENGINEER

**EXPANSION JOINT - ASPHALTIC PLUG DETAIL  
CROSS SECTION VIEW  
(FINGER PLATE JOINT)**

**NOT TO SCALE**

PROJECT NAME: NORWICH - FAIRLEE	PLOT DATE: 15-DEC-2014
PROJECT NUMBER: IM SURF(48)	DRAWN BY: N. PAPPAS
FILE NAME: I4a144 Norwich-Fairlee.dgn	CHECKED BY: J. HARRINGTON
PROJECT LEADER: J. HARRINGTON	BRIDGE DETAIL SHEET 4
DESIGNED BY: N. PAPPAS	SHEET 9 OF 22