


TEMPORARY 6 INCH WHITE LINE, PAINT
 MM 74.810 - MM 92.500 (SOLID RT)
 MM 74.810 - MM 92.500 (DASHED)


DURABLE 6 INCH WHITE LINE, POLYUREA
 MM 74.810 - MM 92.500 (SOLID RT)
 MM 74.810 - MM 92.500 (DASHED)

TEMPORARY 6 INCH YELLOW LINE, PAINT
 MM 74.810 - MM 92.500 (SOLID LT)

DURABLE 6 INCH YELLOW LINE, POLYUREA
 MM 74.810 - MM 92.500 (SOLID LT)

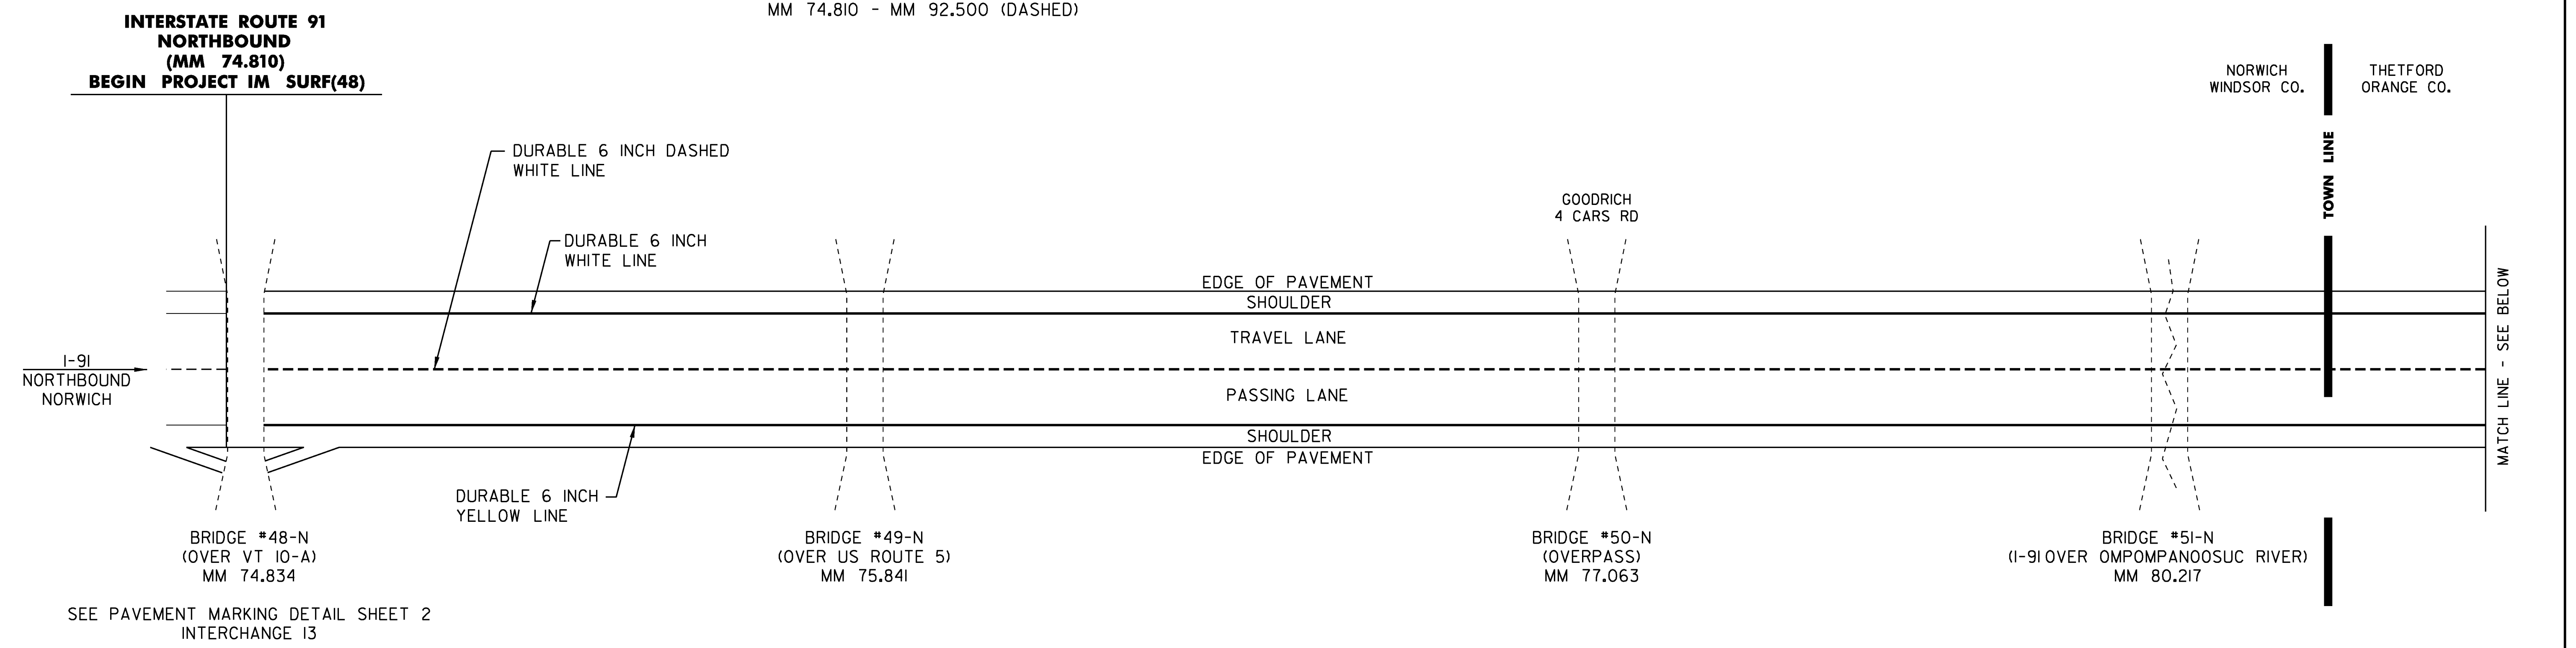

SEE PAVEMENT MARKING DETAIL SHEET 2 INTERCHANGE 13

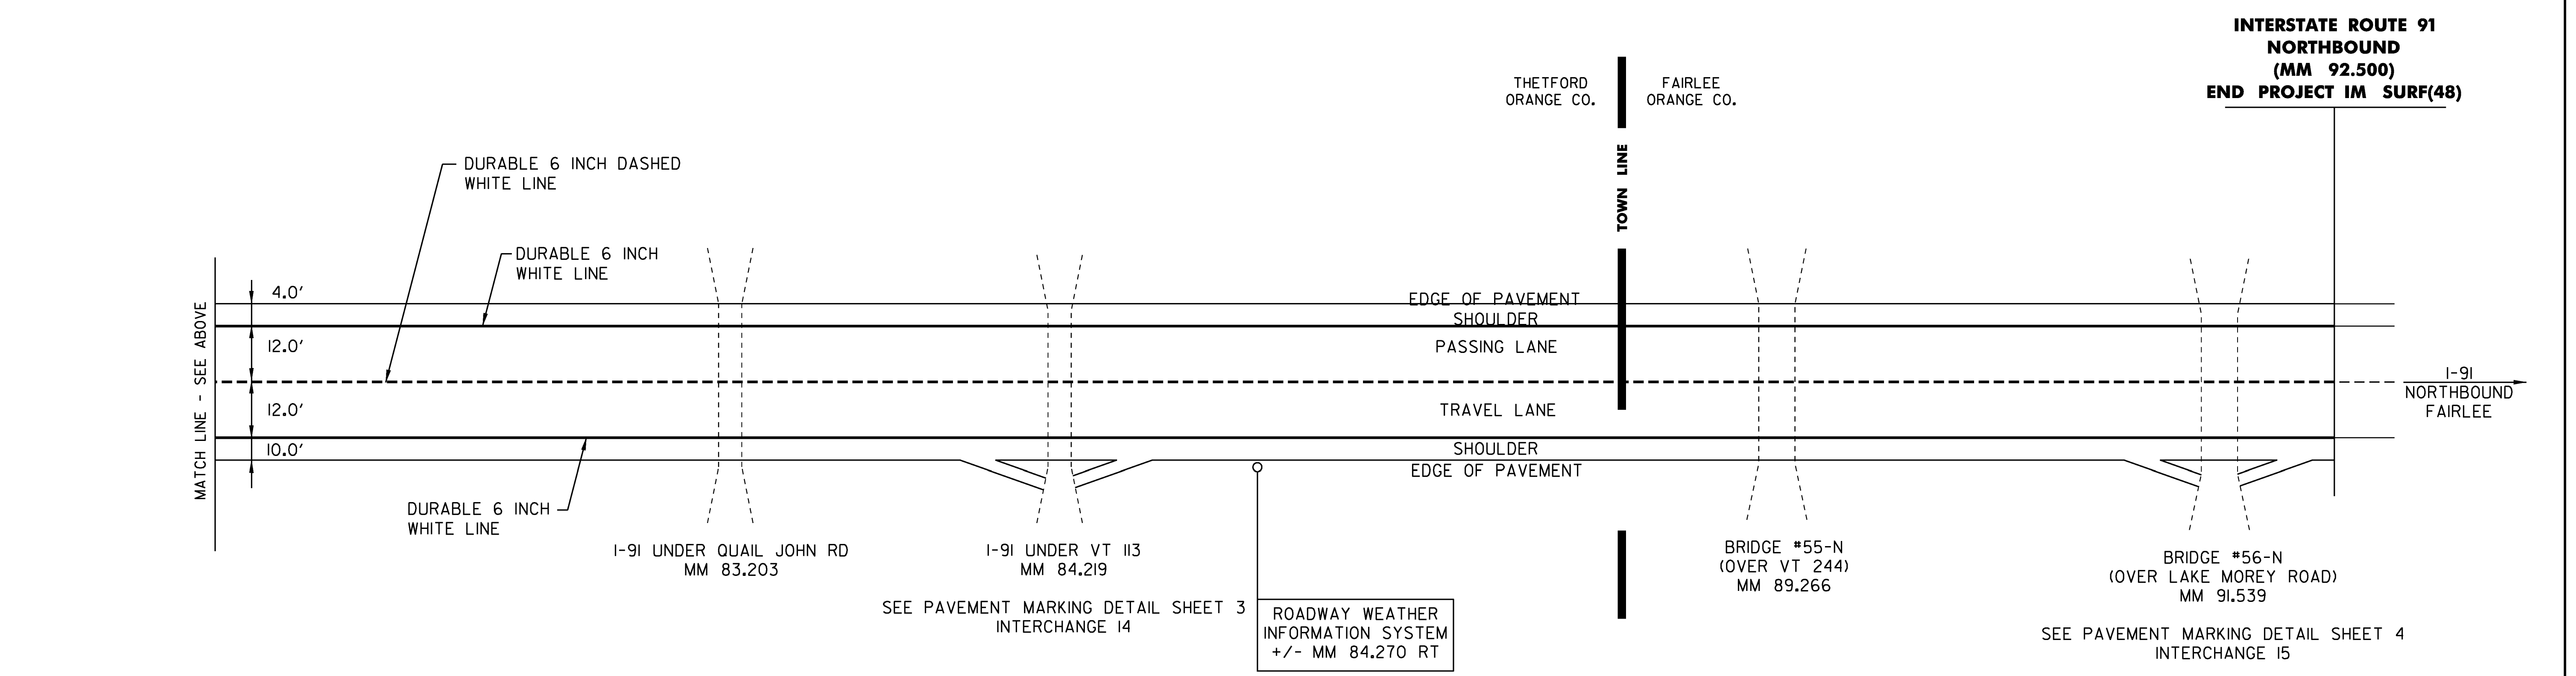

SEE PAVEMENT MARKING DETAIL SHEET 3 INTERCHANGE 14

SEE PAVEMENT MARKING DETAIL SHEET 4 INTERCHANGE 15

NOT TO SCALE

PROJECT NAME: NORWICH - FAIRLEE	
PROJECT NUMBER: IM SURF(48)	
FILE NAME: I4a144 Norwich-Fairlee.dgn	PLOT DATE: 15-DEC-2014
PROJECT LEADER: J. HARRINGTON	DRAWN BY: N. PAPPAS
DESIGNED BY: N. PAPPAS	CHECKED BY: J. HARRINGTON
PAVEMENT MARKING DETAIL SHEET 1	SHEET 14 OF 22