


# STATE OF VERMONT AGENCY OF TRANSPORTATION

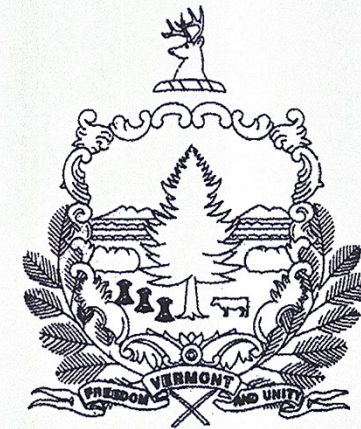

## PROPOSED IMPROVEMENT TOWNS OF NORWICH, THETFORD & FAIRLEE COUNTIES OF WINDSOR & ORANGE INTERSTATE ROUTE 91 (NHS)

IM SURF(48) NORTHBOUND:  
BEGINNING IN THE TOWN OF NORWICH AT MILE MARKER 74.810 AND EXTENDING NORTHERLY ALONG INTERSTATE ROUTE 91  
(NORTHBOUND BARREL) FOR A DISTANCE OF 93,403.20 FT (17.690 MILES) TO MILE MARKER 92.500 IN THE TOWN OF FAIRLEE.

NB LENGTH OF ROADWAY = 93,403.20 FT = (17.690 MILES)  
NB LENGTH OF PROJECT = 93,403.20 FT = (17.690 MILES)


WORK TO BE PERFORMED UNDER THIS PROJECT INCLUDES SURFACE PREPARATION INVOLVING PATCHING, POT HOLE REPAIR, CRACK SEALING AND OVERLAYING  
WITH A THIN BITUMINOUS CONCRETE WEARING SURFACE ON THE EXISTING INTERSTATE TYPICAL, PAVEMENT MARKINGS, AND OTHER RELATED HIGHWAY ITEMS.

### INDEX OF SHEETS


- 1 TITLE SHEET
- 2 CONVENTIONAL SYMBOLOLOGY - LEGEND
- 3 TYPICAL SECTION - ALTERNATE A
- 4 TYPICAL SECTION - ALTERNATE B
- 5 PROJECT NOTES AND DETAILS
- 6-9 BRIDGE DETAIL SHEETS
- 10-11 TYPICAL INTERCHANGE CONSTRUCTION DETAILS
- 12-13 QUANTITY SHEETS
- 14-18 PAVEMENT MARKING DETAIL SHEETS
- 19 CONSTRUCTION APPROACH SIGNING
- 20 CONSTRUCTION APPROACH SIGNING NOTES
- 21 ROUGHNESS DATA INFORMATION SHEET
- 22 RUTTING DATA INFORMATION SHEET
- STRUCTURES DETAIL SD-516.10

### VAOT STANDARDS

E-191	02/01/99
E-192	10/12/00
E-193	08/18/95
T-1	08/06/12
T-10	08/06/12
T-11	08/06/12
T-12	08/06/12
T-13	08/06/12
T-16	08/06/12
T-17	08/06/12
T-22	08/06/12
T-23	08/06/12
T-24	08/06/12
T-28	08/06/12
T-29	08/06/12
T-30	08/06/12
T-31	08/06/12
T-33	08/06/12
T-36	08/06/12

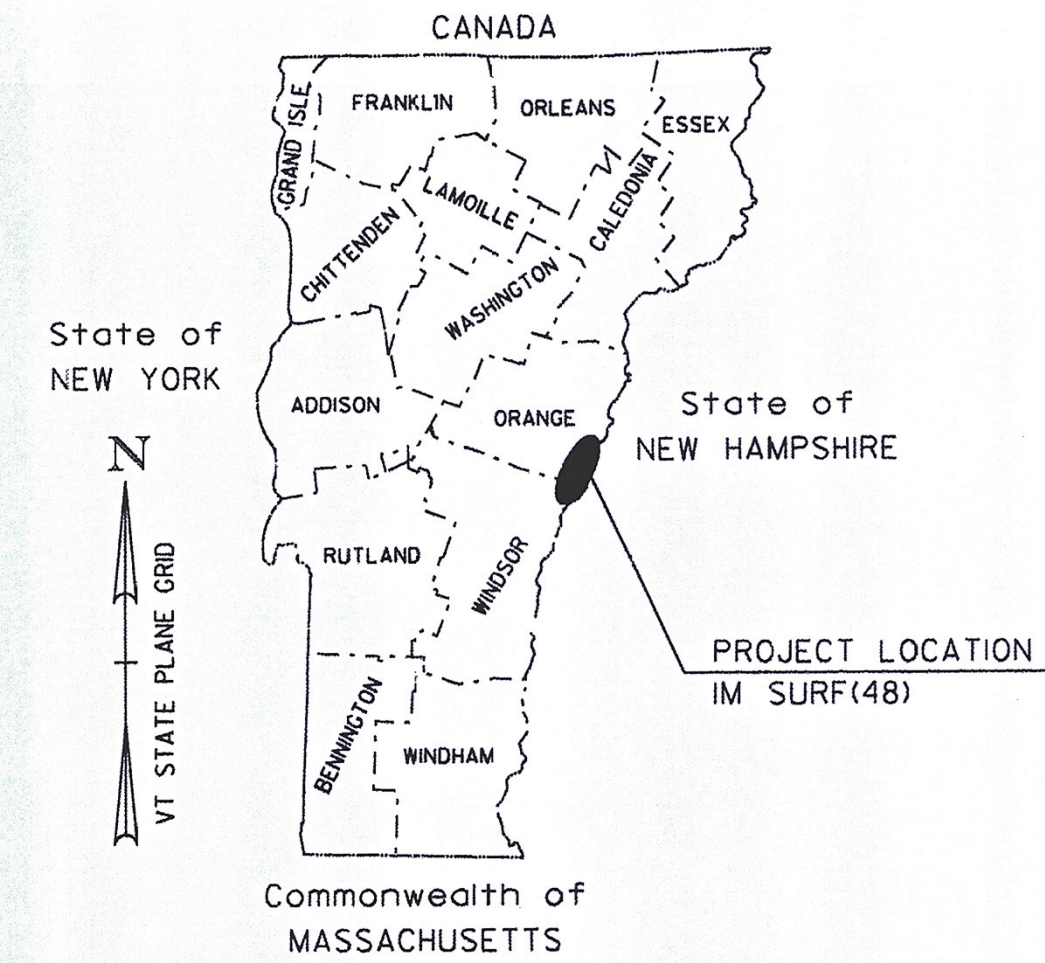

RECORD PLANS	
CONTRACTOR:	GORMAN GROUP, LLC - ALBANY, NY
RESIDENT ENGINEER:	SANDY SCHMITT
CONSTRUCTION BEGAN:	APRIL 22, 2015
CONSTRUCTION COMPLETE:	JULY 20, 2015
RECORD PLANS BY:	SANDY SCHMITT & C. PIERCE
I HEREBY CERTIFY THAT ALL THE CONSTRUCTION REQUIRED BY THIS SET OF DRAWINGS HAS BEEN ACCOMPLISHED AS INDICATED HEREIN.	
BY	<i>Sandy Schmitt</i> RESIDENT ENGINEER
DATE	03-16-16
NOTE: Any further information concerning final quantities, amounts or other details relative to this project may be found at Central Files in the electronic archives.	

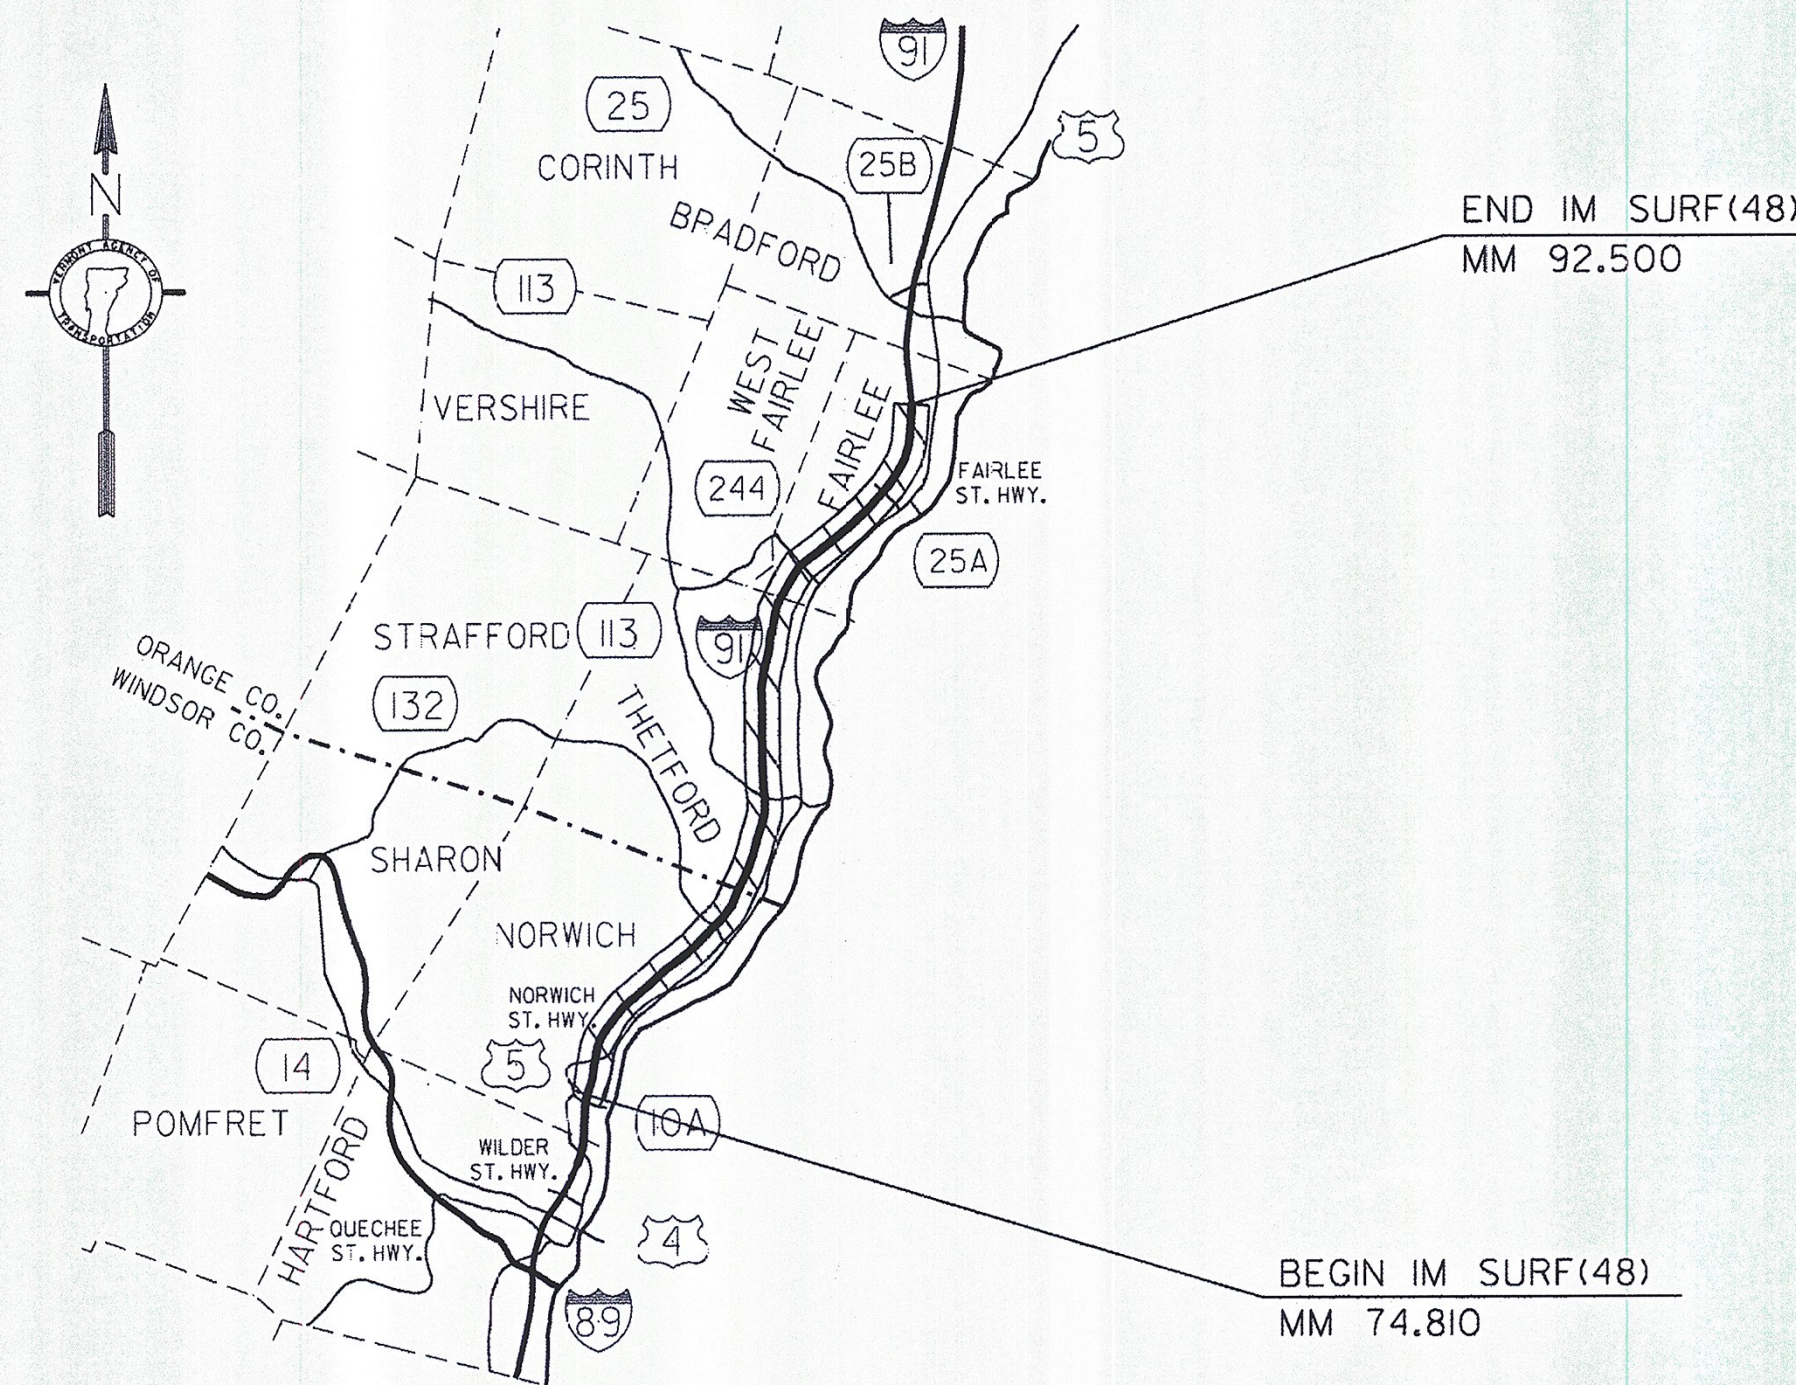

I-91 NORTHBOUND	TRAFFIC DATA				FLEXIBLE ESALS (2015-2025)	FLEXIBLE ESALS (2015-2035)
	2015 AADT	2025 AADT	2015 DHV	2025 DHV		
BEGIN PROJECT TO EXIT 14	5900	6300	920	980	1,716,000	3,870,000
EXIT 14 TO EXIT 15	5300	5700	820	880	1,682,000	3,962,000
EXIT 15 TO END OF PROJECT	3900	4100	600	630	1,700,000	3,937,000

CONSTRUCTION IS TO BE CARRIED ON IN ACCORDANCE WITH THESE PLANS AND THE STANDARD SPECIFICATIONS FOR CONSTRUCTION DATED 2011, AS APPROVED BY THE FEDERAL HIGHWAY ADMINISTRATION ON JULY 20, 2011 FOR USE ON THIS PROJECT, INCLUDING ALL SUBSEQUENT REVISIONS AND SUCH REVISED SPECIFICATIONS AND SPECIAL PROVISIONS AS ARE INCORPORATED IN THESE PLANS.

QUALITY ASSURANCE PROGRAM : LEVEL I
SURVEYED BY : N/A
SURVEYED DATE : N/A
DATUM
VERTICAL: N/A
HORIZONTAL: N/A

DIRECTOR OF PROJECT DELIVERY	
APPROVED <i>J.C.H.</i>	DATE 12/15/2014
PROJECT MANAGER : JONATHAN C. HARRINGTON, P. E.	
PROJECT NAME :	NORWICH - FAIRLEE
PROJECT NUMBER :	IM SURF (48)
SHEET 1	OF 22 SHEETS

**NOT TO SCALE**

**GENERAL INFORMATION**

**SYMBOLY LEGEND NOTE**

THE SYMBOLY ON THIS SHEET IS INTENDED TO COVER STANDARD CONVENTIONAL SYMBOLY. THE SYMBOLY IS USED FOR EXISTING & PROPOSED FEATURES WITH HEAVIER LINEWEIGHT, IN COMBINATION WITH PROJECT ANNOTATION, AS NOTED ON PROJECT PLAN SHEETS. THIS LEGEND SHEET COVERS THE BASICS. SYMBOLY ON PLANS MAY VARY, PLAN ANNOTATIONS AND NOTES SHOULD BE USED TO CLARIFY AS NEEDED.

**R.O.W. ABBREVIATIONS (CODES) & SYMBOLS**

POINT CODE	DESCRIPTION
CH	CHANNEL EASEMENT
CONST	CONSTRUCTION EASEMENT
CUL	CULVERT EASEMENT
D&C	DISCONNECT & CONNECT
DIT	DITCH EASEMENT
DR	DRAINAGE EASEMENT
DRIVE	DRIVEWAY EASEMENT
EC	EROSION CONTROL
HWY	HIGHWAY EASEMENT
I&M	INSTALL & MAINTAIN EASEMENT
LAND	LANDSCAPE EASEMENT
R&RES	REMOVE & RESET
R&REP	REMOVE & REPLACE
SR	SLOPE RIGHT
UE	UTILITY EASEMENT
(P)	PERMANENT EASEMENT
(T)	TEMPORARY EASEMENT
■	BNDNS BOUND SET
▣	BNDNS BOUND TO BE SET
●	IPNS IRON PIN SET
⊙	IPNS IRON PIN TO BE SET
⊠	CALC EXISTING ROW POINT
○	PROW PROPOSED ROW POINT
[LENGTH]	LENGTH CARRIED ON NEXT SHEET

**COMMON TOPOGRAPHIC POINT SYMBOLS**

POINT CODE	DESCRIPTION
##	APL BOUND APPARENT LOCATION
□	BM BENCH MARK
▣	BND BOUND
▣	CB CATCH BASIN
⊕	COMB COMBINATION POLE
▣	DITHR DROP INLET THROATED DNC
⊕	EL ELECTRIC POWER POLE
○	FPOLE FLAGPOLE
○	GASFIL GAS FILLER
○	GP GUIDE POST
×	GSO GAS SHUT OFF
○	GUY GUY POLE
○	GUYW GUY WIRE
×	GV GATE VALVE
⊗	H TREE HARDWOOD
△	HCTRL CONTROL HORIZONTAL
▲	HVCTRL CONTROL HORIZ. & VERTICAL
◇	HYD HYDRANT
●	IP IRON PIN
●	IPIPE IRON PIPE
⊕	LI LIGHT - STREET OR YARD
⊕	MB MAILBOX
○	MH MANHOLE (MH)
▣	MM MILE MARKER
●	PM PARKING METER
▣	PMK PROJECT MARKER
○	POST POST STONE/WOOD
⊕	RRSIG RAILROAD SIGNAL
⊕	RRSL RAILROAD SWITCH LEVER
⊕	S TREE SOFTWOOD
⊕	SAT SATELLITE DISH
⊕	SHRUB SHRUB
⊕	SIGN SIGN
⊕	STUMP STUMP
⊕	TEL TELEPHONE POLE
○	TIE TIE
⊕	TSIGN SIGN W/DOUBLE POST
⊕	VCTRL CONTROL VERTICAL
○	WELL WELL
×	WSO WATER SHUT OFF

THESE ARE COMMON VAOT SURVEY POINT SYMBOLS FOR EXISTING FEATURES, ALSO USED FOR PROPOSED FEATURES WITH HEAVIER LINEWEIGHT, IN COMBINATION WITH PROPOSED ANNOTATION.

**PROPOSED GEOMETRY CODES**

CODE	DESCRIPTION
PC	POINT OF CURVATURE
PI	POINT OF INTERSECTION
CC	CENTER OF CURVE
PT	POINT OF TANGENCY
PCC	POINT OF COMPOUND CURVE
PRC	POINT OF REVERSE CURVE
POB	POINT OF BEGINNING
POE	POINT OF ENDING
STA	STATION PREFIX
AH	AHEAD STATION SUFFIX
BK	BACK STATION SUFFIX
D	CURVE DEGREE OF (100FT)
R	CURVE RADIUS OF
T	CURVE TANGENT LENGTH
L	CURVE LENGTH OF
E	CURVE EXTERNAL DISTANCE

**UTILITY SYMBOLY**

**UNDERGROUND UTILITIES**

— UT —	TELEPHONE
— UE —	ELECTRIC
— UC —	CABLE (TV)
— UEC —	ELECTRIC+CABLE
— UET —	ELECTRIC+TELEPHONE
— UCT —	CABLE+TELEPHONE
— UECT —	ELECTRIC+CABLE+TELEP.
— G —	GAS LINE
— W —	WATER LINE
— S —	SANITARY SEWER (SEPTIC)

**ABOVE GROUND UTILITIES (AERIAL)**

— T —	TELEPHONE
— E —	ELECTRIC
— C —	CABLE (TV)
— EC —	ELECTRIC+CABLE
— ET —	ELECTRIC+TELEPHONE
— AER E&T —	ELECTRIC+TELEPHONE
— CT —	CABLE+TELEPHONE
— ECT —	ELECTRIC+CABLE+TELEP.
—	UTILITY POLE GUY WIRE

**PROJECT CONSTRUCTION SYMBOLY**

—	CLEAR ZONE
—	PLAN LAYOUT MATCHLINE

**PROJECT CONSTRUCTION FEATURES**

▲	TOP OF CUT SLOPE
○	TOE OF FILL SLOPE
⊗	STONE FILL
---	BOTTOM OF DITCH 'L
---	CULVERT PROPOSED
---	STRUCTURE SUBSURFACE
PDF	PROJECT DEMARCATION FENCE
BF	BARRIER FENCE
XXXXXX	TREE PROTECTION ZONE (TPZ)
////	STRIPING LINE REMOVAL
~~~~	SHEET PILES

**CONVENTIONAL BOUNDARY SYMBOLY**

**BOUNDARY LINES**

—	TOWN BOUNDARY LINE
—	COUNTY BOUNDARY LINE
—	STATE BOUNDARY LINE
---	PROPOSED STATE R.O.W. (LIMITED ACCESS)
---	PROPOSED STATE R.O.W.
---	STATE ROW (LIMITED ACCESS)
---	STATE ROW
---	TOWN ROW
---	PERMANENT EASEMENT LINE (P)
---	TEMPORARY EASEMENT LINE (T)
---	SURVEY LINE
---	PROPERTY LINE (P/L)
SR	SLOPE RIGHTS
6f	6F PROPERTY BOUNDARY
4f	4F PROPERTY BOUNDARY
HAZ	HAZARDOUS WASTE

**EPSC LAYOUT PLAN SYMBOLY**

**EPSC MEASURES**

ONNOONNOONNO	FILTER CURTAIN
—	SILT FENCE
—	SILT FENCE WOVEN WIRE
—	CHECK DAM
▣	DISTURBED AREAS REQUIRING RE-VEGETATION
⊗	EROSION MATTING

**ENVIRONMENTAL RESOURCES**

—	WETLAND BOUNDARY
---	RIPARIAN BUFFER ZONE
---	WETLAND BUFFER ZONE
---	SOIL TYPE BOUNDARY
---	THREATENED & ENDANGERED SPECIES
HAZ	HAZARDOUS WASTE AREA
---	AGRICULTURAL LAND
---	FISH & WILDLIFE HABITAT
---	FLOOD PLAIN
---	ORDINARY HIGH WATER (OHW)
---	STORM WATER
---	USDA FOREST SERVICE LANDS
---	WILDLIFE HABITAT SUIT/CONN

**ARCHEOLOGICAL & HISTORIC**

---	ARCHEOLOGICAL BOUNDARY
---	HISTORIC DISTRICT BOUNDARY
---	HISTORIC AREA
Ⓜ	HISTORIC STRUCTURE

**CONVENTIONAL TOPOGRAPHIC SYMBOLY**


**EXISTING FEATURES**

---	ROAD EDGE PAVEMENT
---	ROAD EDGE GRAVEL
---	DRIVEWAY EDGE
---	DITCH
---	FOUNDATION
---	FENCE (EXISTING)
---	FENCE WOOD POST
---	FENCE STEEL POST
---	GARDEN
---	ROAD GUARDRAIL
---	RAILROAD TRACKS
---	CULVERT (EXISTING)
---	STONE WALL
---	WALL
---	WOOD LINE
---	BRUSH LINE
---	HEDGE
---	BODY OF WATER EDGE
---	LEDGE EXPOSED

PROJECT NAME: NORWICH - FAIRLEE

PROJECT NUMBER: IM SURF (48)


FILE NAME: I4al44 Norwich-Fairlee.dgn PLOT DATE: 15-DEC-2014  
 PROJECT LEADER: J. HARRINGTON DRAWN BY: N. PAPPAS  
 DESIGNED BY: N. PAPPAS CHECKED BY: J. HARRINGTON  
 CONVENTIONAL SYMBOLY - LEGEND SHEET 2 OF 22

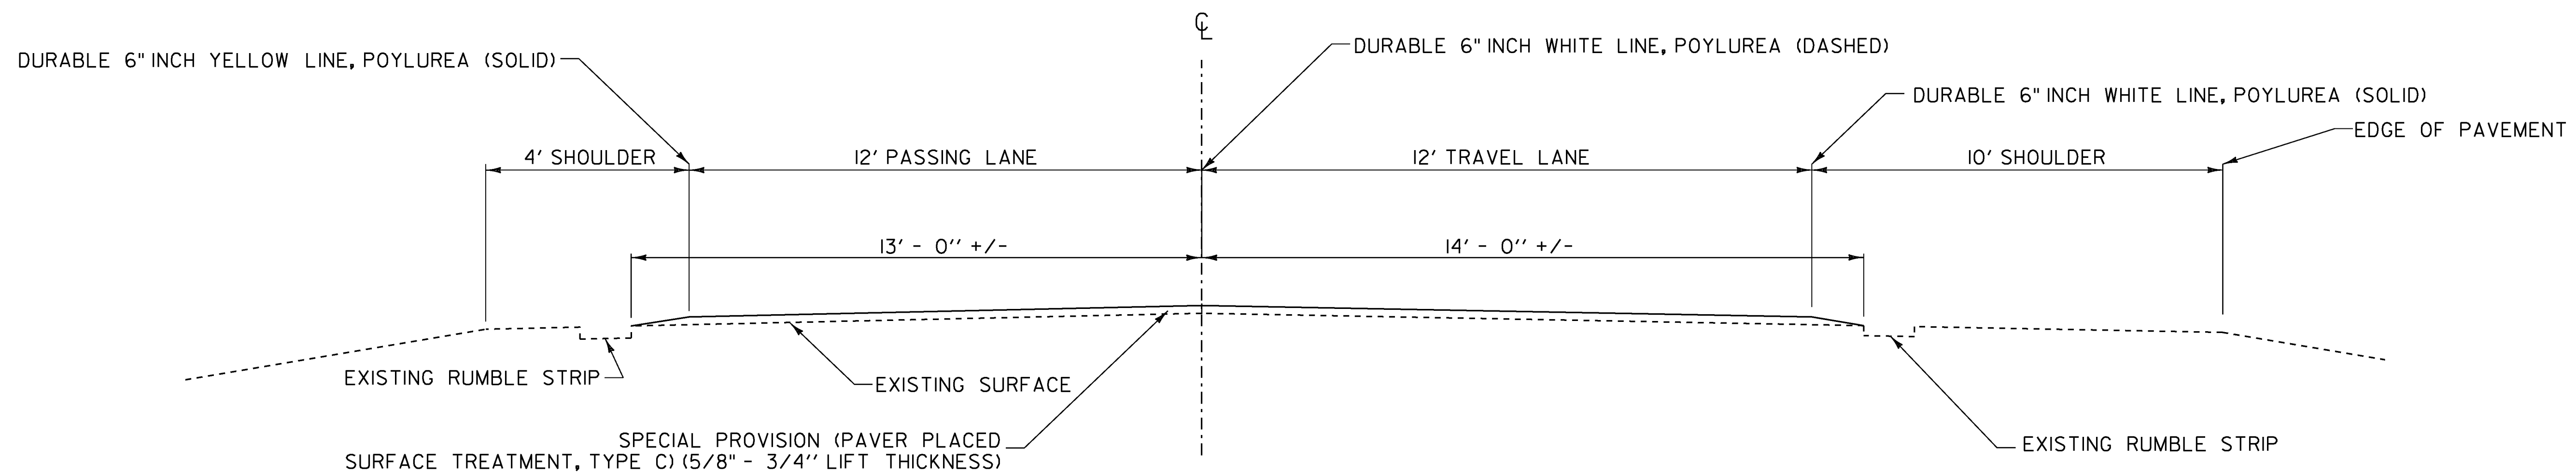

**ROADWAY TYPICAL NORMAL SECTION**

**ALTERNATE A**

**I-91 NORTHBOUND NORWICH MM 74.810 - FAIRLEE MM 92.500**

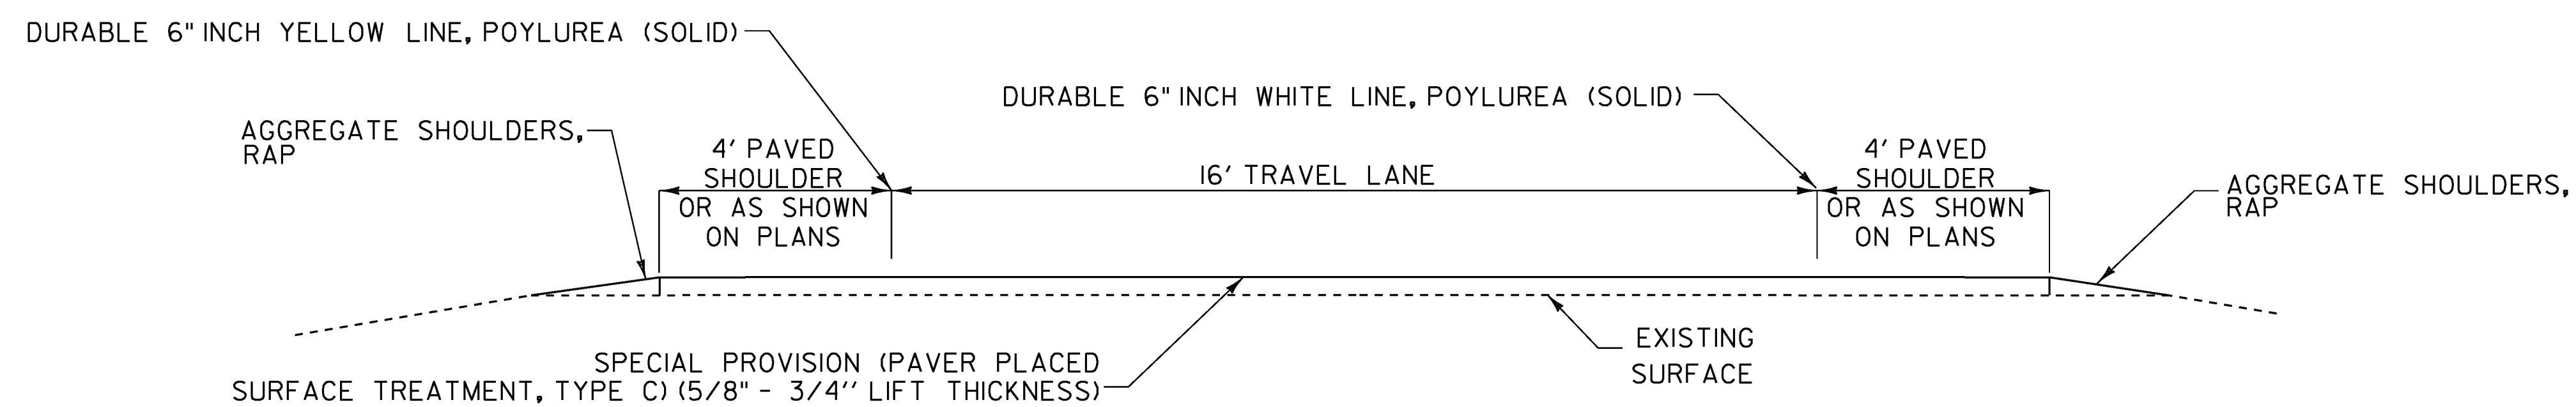


**ROADWAY TYPICAL RAMP SECTION**

**ALTERNATE A**

**NOT TO SCALE**


PROJECT NAME: NORWICH - FAIRLEE	PLOT DATE: 15-DEC-2014
PROJECT NUMBER: IM SURF(48)	DRAWN BY: N. PAPPAS
FILE NAME: I4a144 Norwich-Fairlee.dgn	CHECKED BY: J. HARRINGTON
PROJECT LEADER: J. HARRINGTON	SHEET 3 OF 22
DESIGNED BY: N. PAPPAS	TYPICAL SECTION - ALTERNATE A

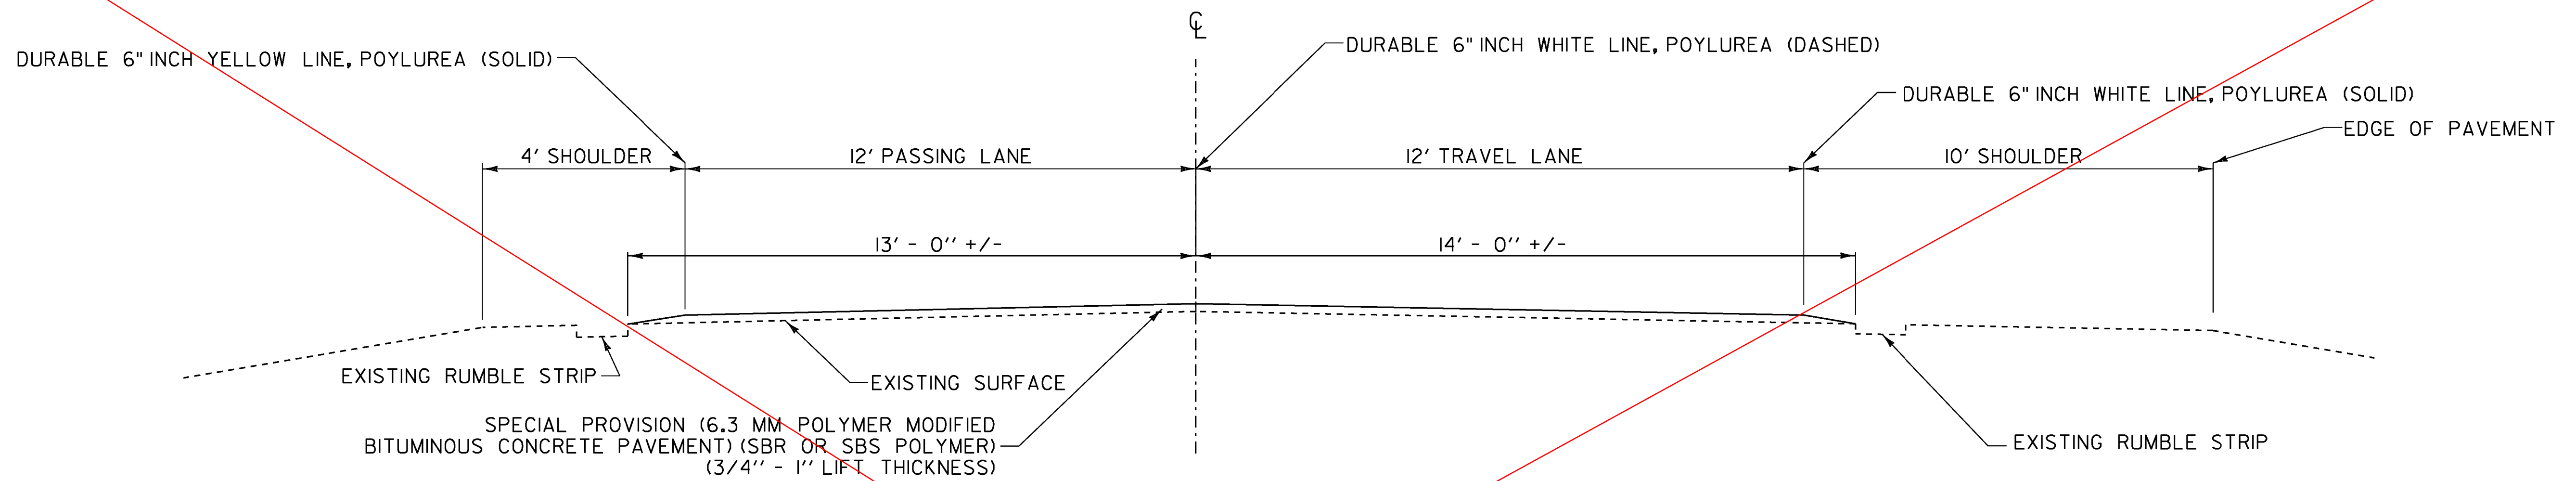

**ROADWAY TYPICAL NORMAL SECTION**

**ALTERNATE B**

**I-91 NORTHBOUND NORWICH MM 74.810 - FAIRLEE MM 92.500**

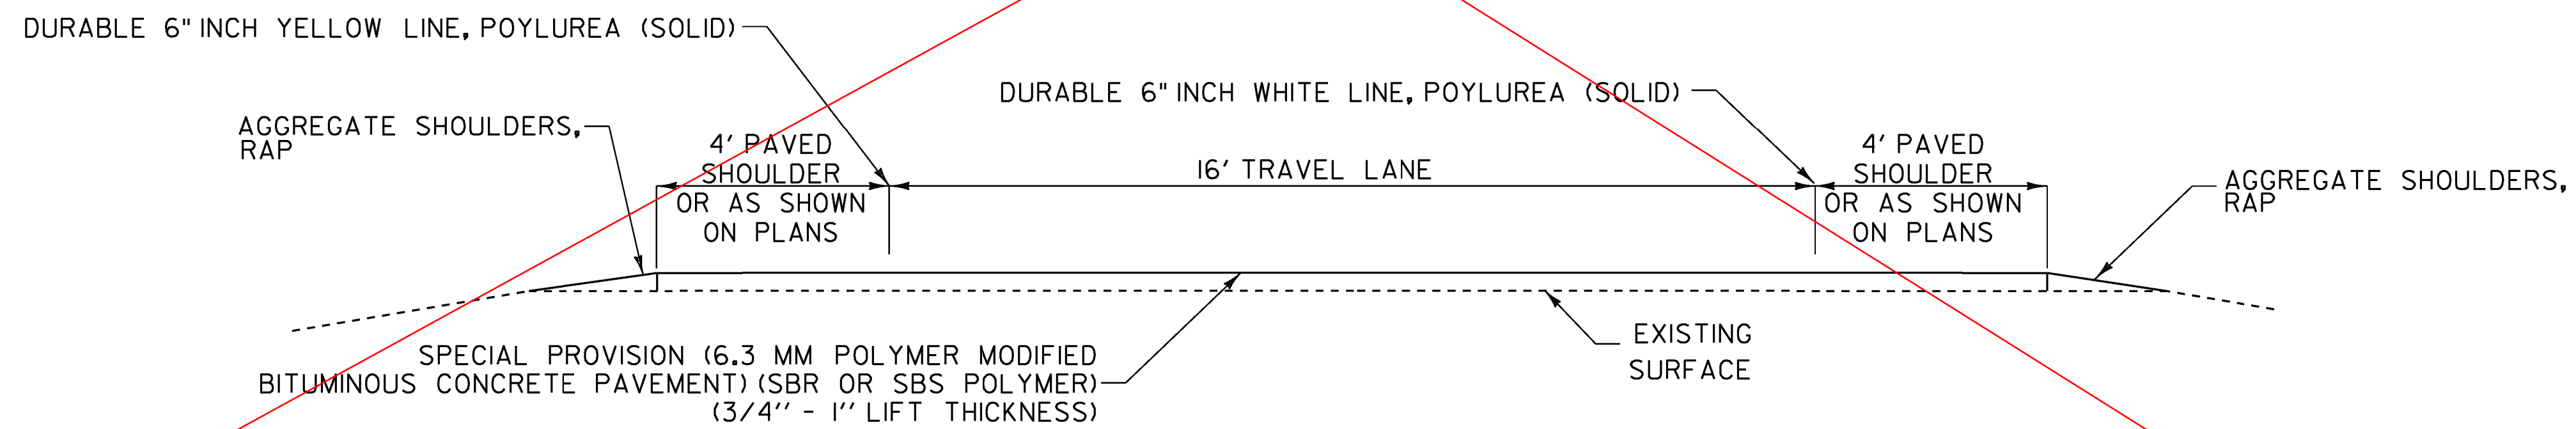

**ROADWAY TYPICAL RAMP SECTION**

**ALTERNATE B**

ALTERNATE A USED


**NOTE:**

1. PRIOR TO THE PLACEMENT OF THE 6.3 MM POLYMER MODIFIED BITUMINOUS CONCRETE PAVEMENT, EMULSIFIED ASPHALT SHALL BE APPLIED TO ALL EXISTING PAVEMENT SURFACES AND ON ALL COLD PLANED SURFACES AT A RATE OF 0.080 GAL/SY (+/- 0.01 GAL/SY) OR AS DIRECTED BY THE ENGINEER. EMULSIFIED ASPHALT SHALL BE RS-IH OR CRS-IH PER THE MANUFACTURER'S RECOMMENDATION AND PAID UNDER ITEM 900.683 SPECIAL PROVISION (EMULSIFIED ASPHALT) (RS-IH OR CRS-IH).


**NOT TO SCALE**

PROJECT NAME: NORWICH - FAIRLEE  
PROJECT NUMBER: IM SURF(48)

FILE NAME: I4a144 Norwich-Fairlee.dgn PLOT DATE: 19-DEC-2014  
PROJECT LEADER: J. HARRINGTON DRAWN BY: N. PAPPAS  
DESIGNED BY: N. PAPPAS CHECKED BY: J. HARRINGTON  
TYPICAL SECTION - ALTERNATE B SHEET 4 OF 22


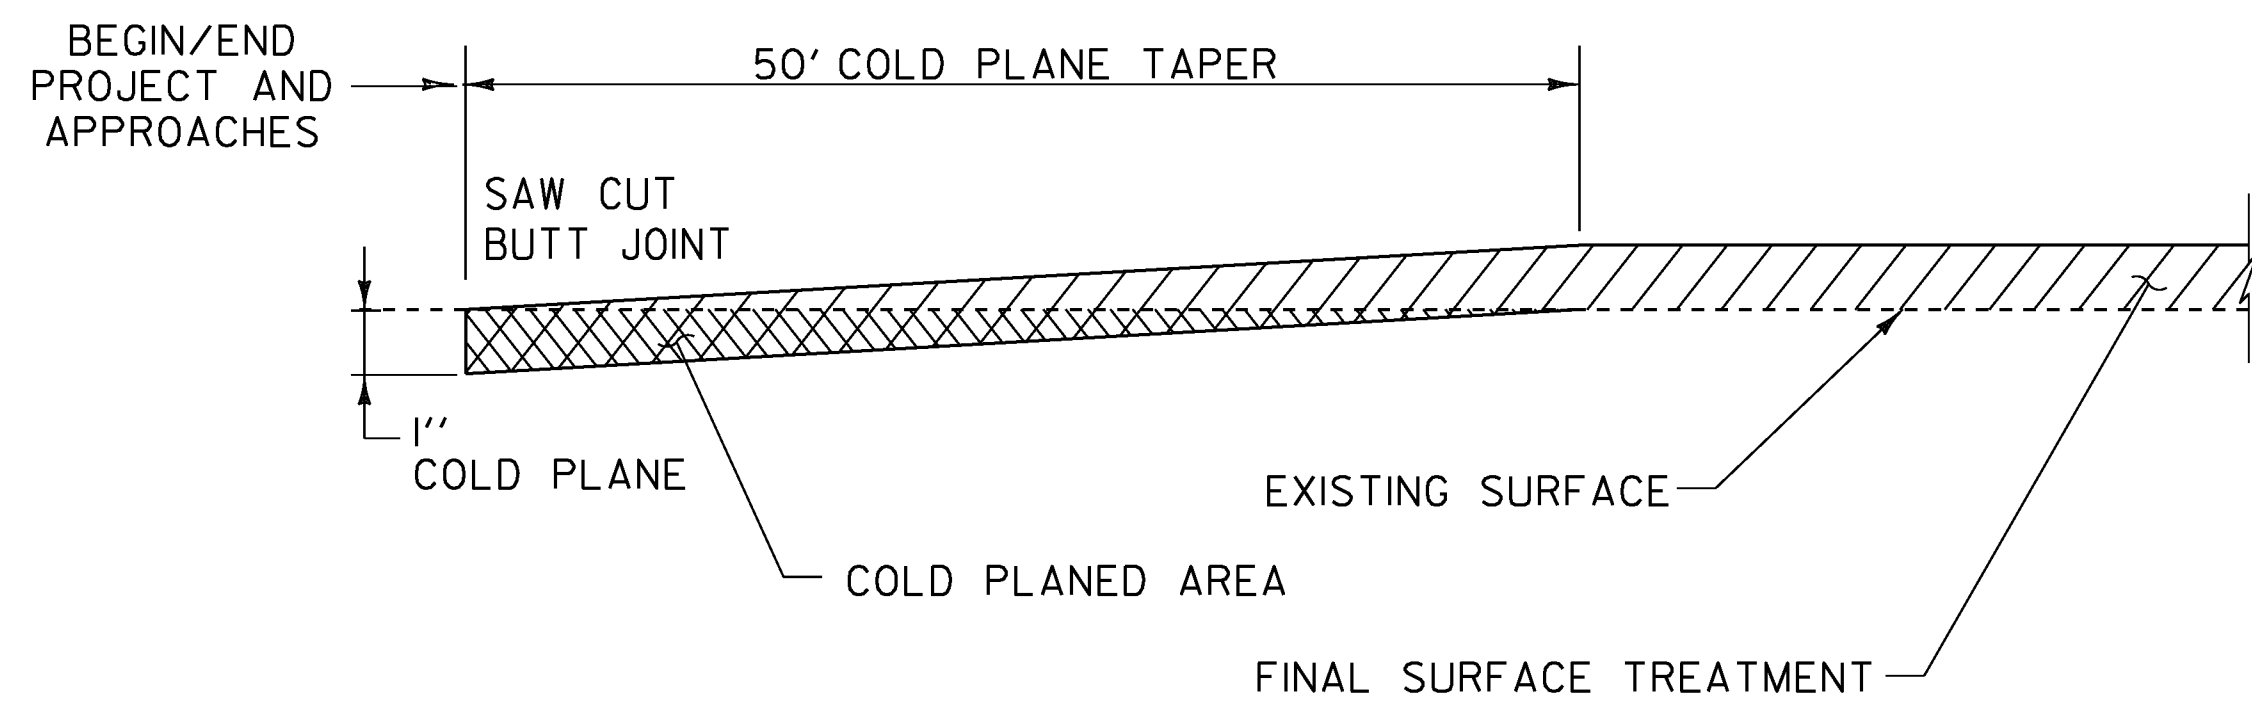


**TYPICAL APPROACH AREA DETAIL MAINLINE & RAMPS**

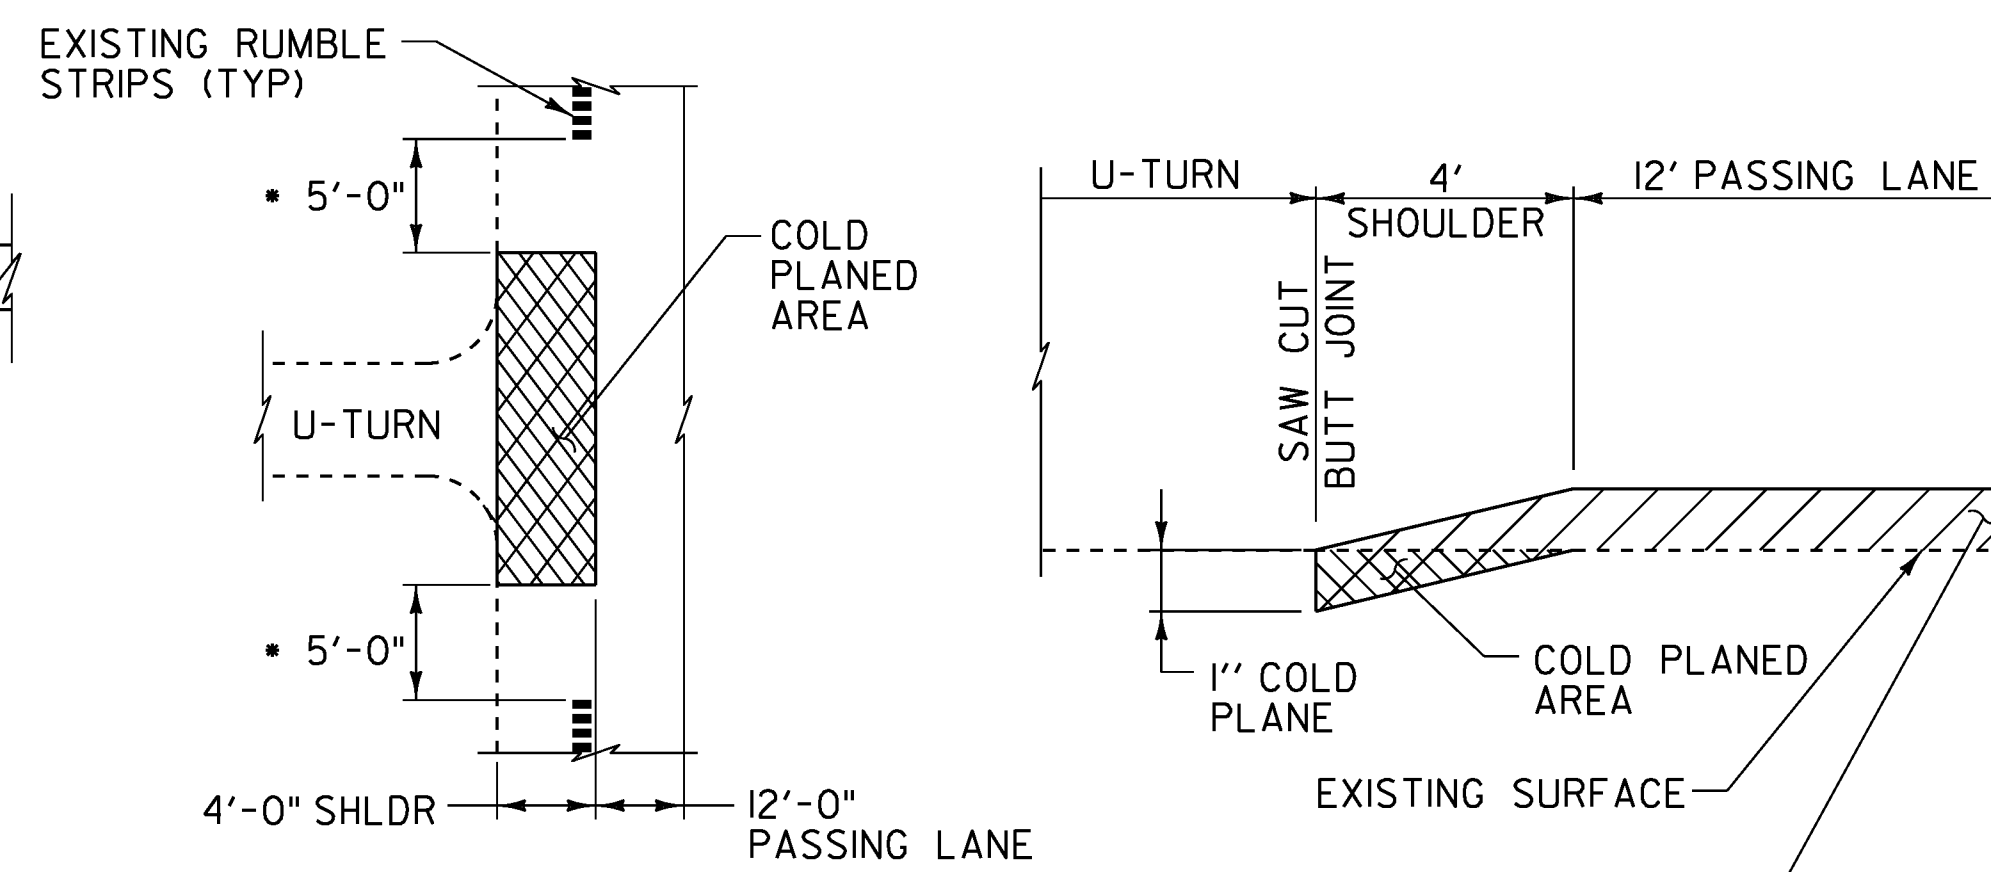


- BEGIN COLD PLANING 5'-0" AFTER RUMBLE STRIPS END, AND END COLD PLANING 5'-0" BEFORE RUMBLE STRIPS BEGIN


**COLD PLANE DETAIL AT U-TURNS**

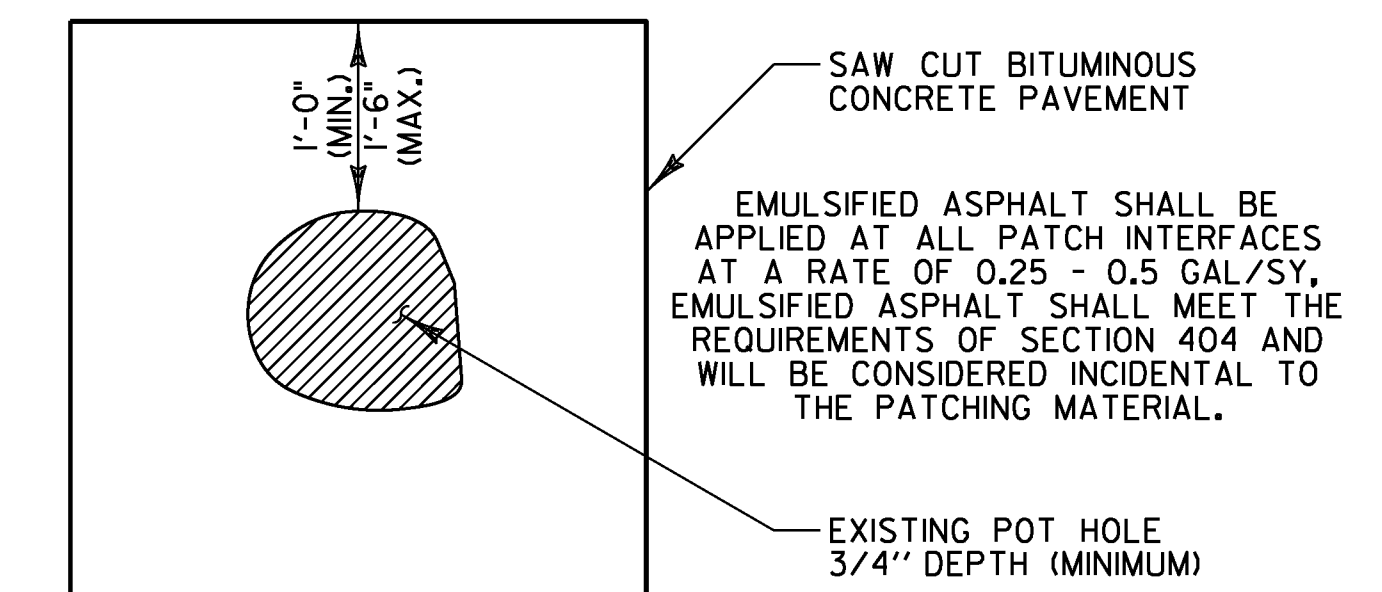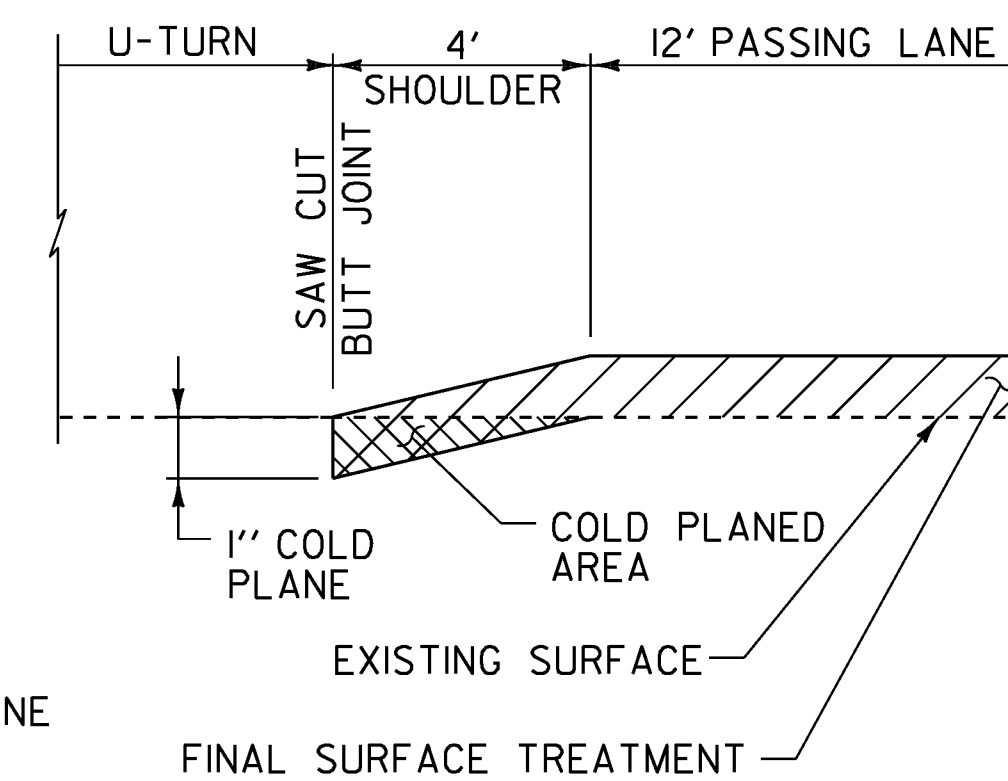

**TYPICAL POT HOLE REPAIR**

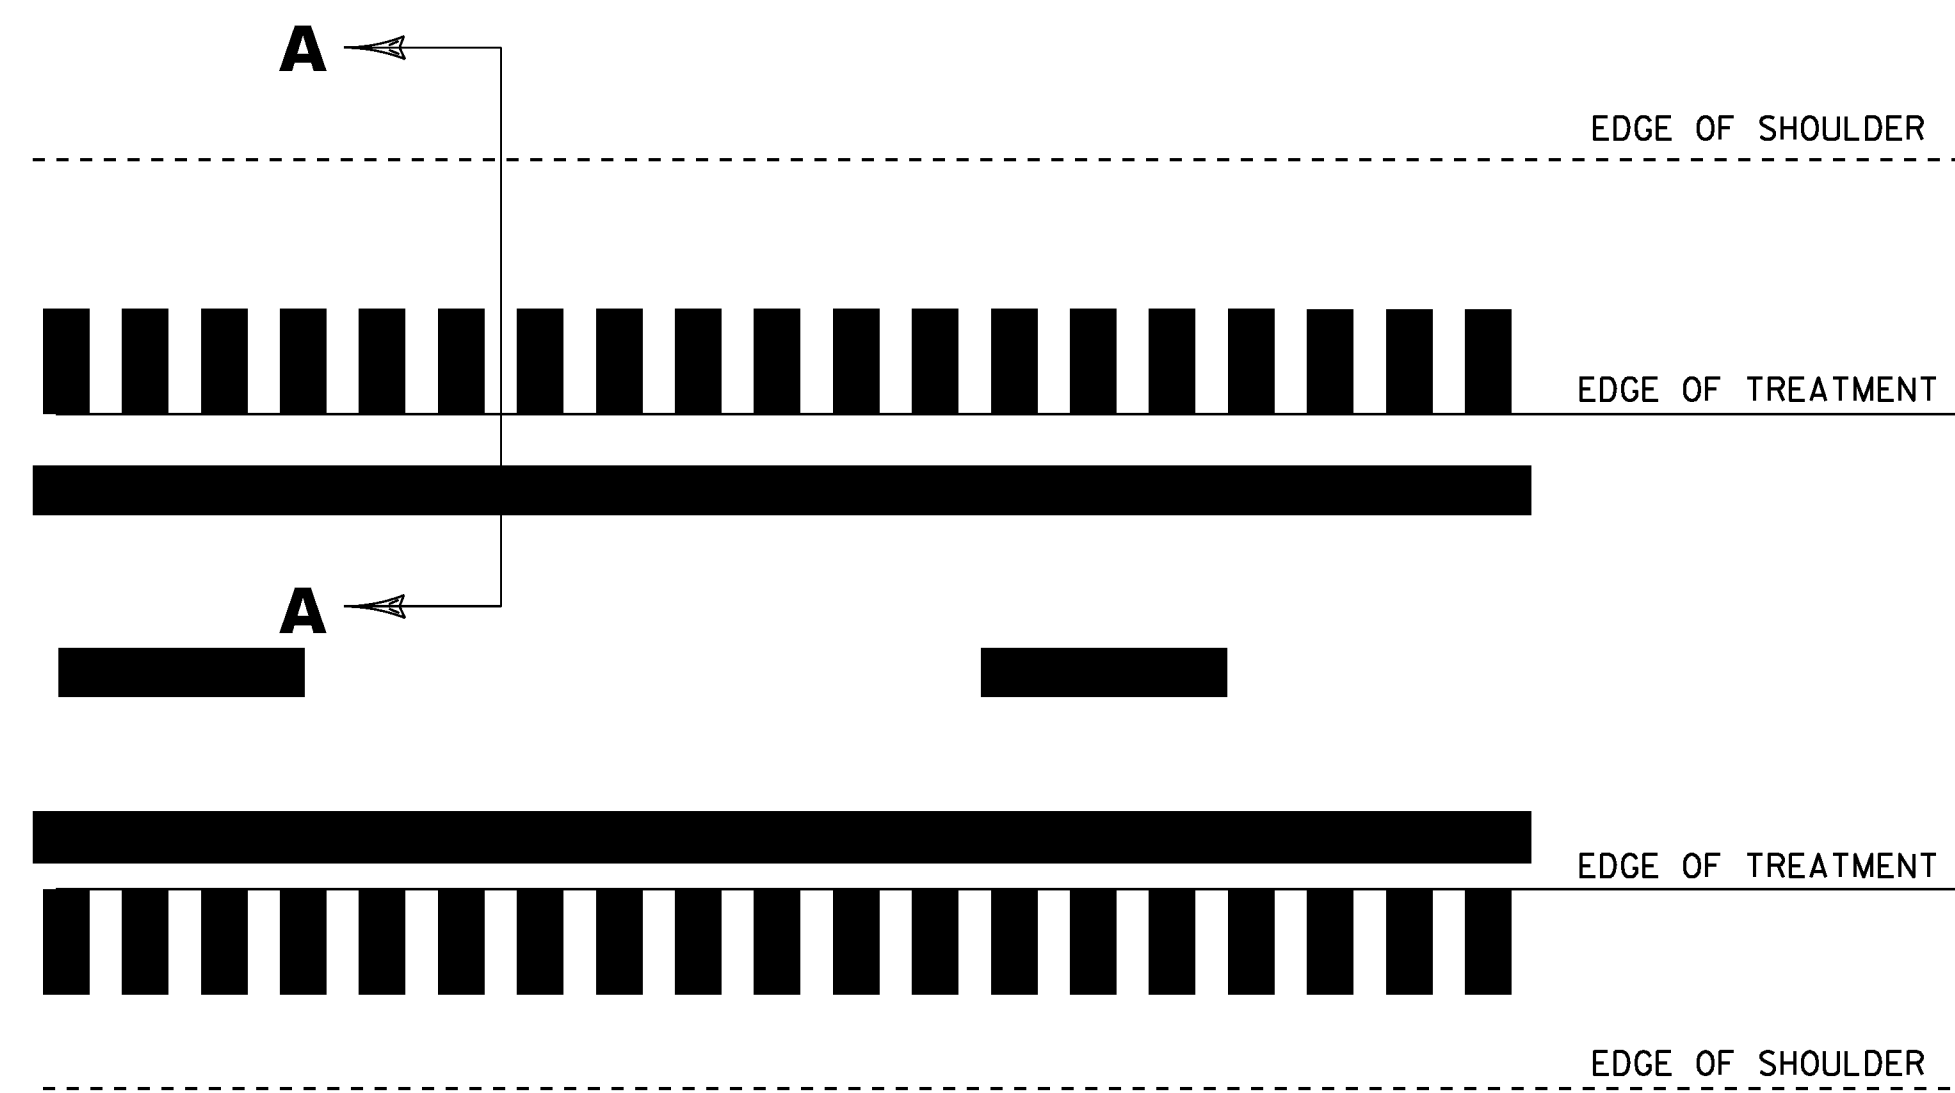

**EDGE OF TREATMENT TYPICAL PLAN**

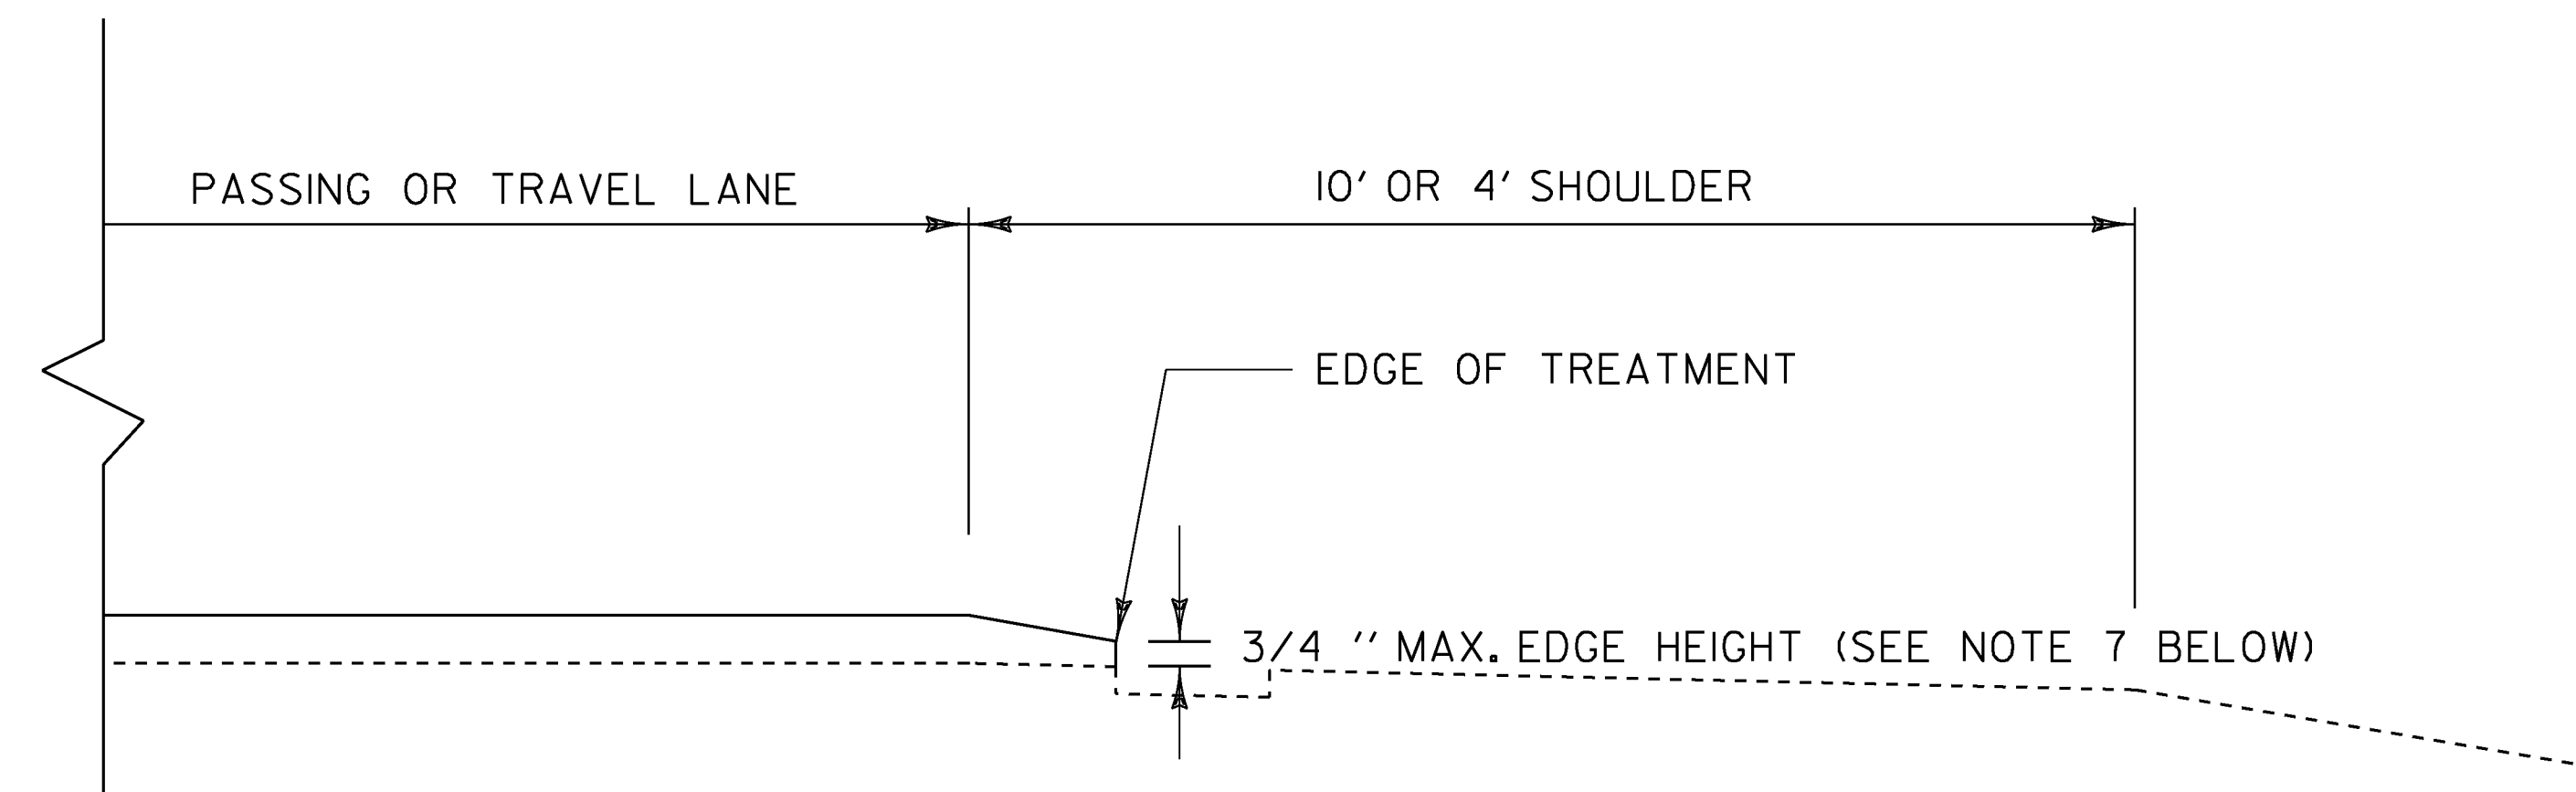


**EDGE OF TREATMENT TYPICAL SECTION A-A**

**NOTES:**

1. ALL NECESSARY SURFACE PREPARATION INVOLVING PATCHING, POTHOLE REPAIR, AND CRACK-SEALING SHALL BE PERFORMED PRIOR TO APPLICATION OF THE FINAL SURFACE TREATMENT. ALL CRACKS GREATER THAN 0.10" AND UP TO 1.0" IN WIDTH SHALL BE SEALED USING THE "BLOW AND GO" FILL METHOD. ALL COSTS ASSOCIATED WITH THIS WORK SHALL BE PAID FOR UNDER ITEM 417.20, BITUMINOUS CRACK SEALING, "BLOW AND GO" METHOD. THE PATCHING OF ALL CRACKS GREATER THAN 1.0" AND ALL OTHER PATCHING AND POTHOLE REPAIR SHALL BE COMPLETED USING BITUMINOUS CONCRETE PAVEMENT IN ACCORDANCE WITH ITEM 900.680 SPECIAL PROVISION (BITUMINOUS CONCRETE PAVEMENT SURFACE PREPARATION, TYPE I). AN ESTIMATED QUANTITY FOR THIS ITEM HAS BEEN INCLUDED TO COVER ALL COSTS ASSOCIATED WITH THIS WORK.
2. EXISTING SHOULDER PAVEMENT SURFACES BEYOND THE LIMITS OF THE FINAL SURFACE TREATMENT SHALL ALSO RECEIVE CRACK-SEALING AND RELATED PATCHING AND POTHOLE REPAIR TREATMENTS.
3. FOLLOWING COMPLETION OF COLD PLANING, THE MILLED SURFACE FOR ALL BRIDGES TO BE COLD PLANED SHALL ALSO RECEIVE CRACK-SEALING AND RELATED PATCHING AND POTHOLE REPAIR TREATMENTS, AS DIRECTED BY THE ENGINEER.
4. ALL EXISTING PAVEMENT MARKINGS SHALL BE REMOVED PRIOR TO ANY CRACK SEALING BEING PERFORMED AND PRIOR TO APPLYING THE FINAL SURFACE TREATMENT. ALL LANE DELINEATION IS TO BE MAINTAINED DURING CONSTRUCTION BY THE USE OF LINE STRIPING TARGETS OR TEMPORARY PAINT.
5. A 50' COLD PLANED WEDGE SHALL BE CONSTRUCTED AT THE PROJECT BEGIN, PROJECT END, RAMPS, AND AT ALL BRIDGE APPROACHES OR AS DIRECTED BY THE ENGINEER. THE LONGITUDINAL EDGES OF THE SURFACE TREATMENT SHALL BE FEATHERED AS SHOWN ON THE TYPICAL SECTION, OR AS DIRECTED BY THE ENGINEER. ANY SAWCUTTING AT BUTT JOINTS SHALL BE PAID INCIDENTAL TO ITEM 900.675 SPECIAL PROVISION, MICRO-MILLING BITUMINOUS CONCRETE PAVEMENT.
6. THERE ARE R.W.I.S. SENSORS IN THE PAVEMENT AT APPROXIMATE MM 84.270 NORTHBOUND THAT MAY BE IMPACTED BY CONSTRUCTION ACTIVITIES. THE CONTRACTOR SHALL CONTACT MARK GERRISH, FIBER OPTIC PROJECT MANAGER, VTRANS OPERATIONS AND MAINTENANCE BUREAU AT 802-461-5570 48 HOURS PRIOR TO BEGINNING ANY WORK IN THIS AREA SO THAT MARK OR HIS REPRESENTATIVE CAN REMOVE THESE SENSORS. INSTALLATION OF NEW SENSORS WILL BE PERFORMED BY OTHERS FOLLOWING COMPLETION OF THE PROJECT. THERE IS A WEIGH IN MOTION SENSOR IN THE PAVEMENT AT APPROXIMATE MM 91.05 NORTHBOUND THAT MAY BE IMPACTED BY CONSTRUCTION ACTIVITIES. INSTALLATION OF NEW SENSORS WILL BE PERFORMED BY OTHERS FOLLOWING COMPLETION OF THE PROJECT.
7. THE SCREED OF THE PAVER SHALL BREAK AT THE BREAK POINT OF THE SHOULDER SUCH THAT THE DESIGNED NOMINAL THICKNESS IS CARRIED ONTO THE SHOULDER AND BROKEN OR PINCHED BY ROLLING. EDGE HEIGHT SHALL BE MEASURED AT A MINIMUM OF FIVE RANDOMLY SPACED POINTS PER TENTH OF A MILE. IF IT IS FOUND THAT THE AVERAGE EDGE HEIGHT IS GREATER THAN 3/4" OVER THE TENTH OF A MILE, WORK SHALL BE PERFORMED SUCH THAT THE 3/4" AVERAGE HEIGHT IS ACHIEVED. THIS APPLIES TO BOTH THE 10' AND 4' SHOULDER SIDES OF THE HIGHWAY.

**NOT TO SCALE**

PROJECT NAME: NORWICH - FAIRLEE	PLOT DATE: 19-DEC-2014
PROJECT NUMBER: IM SURF(48)	DRAWN BY: N. PAPPAS
FILE NAME: I4a144 Norwich-Fairlee.dgn	CHECKED BY: J. HARRINGTON
PROJECT LEADER: J. HARRINGTON	SHEET 5 OF 22
DESIGNED BY: N. PAPPAS	
PROJECT NOTES AND DETAILS	

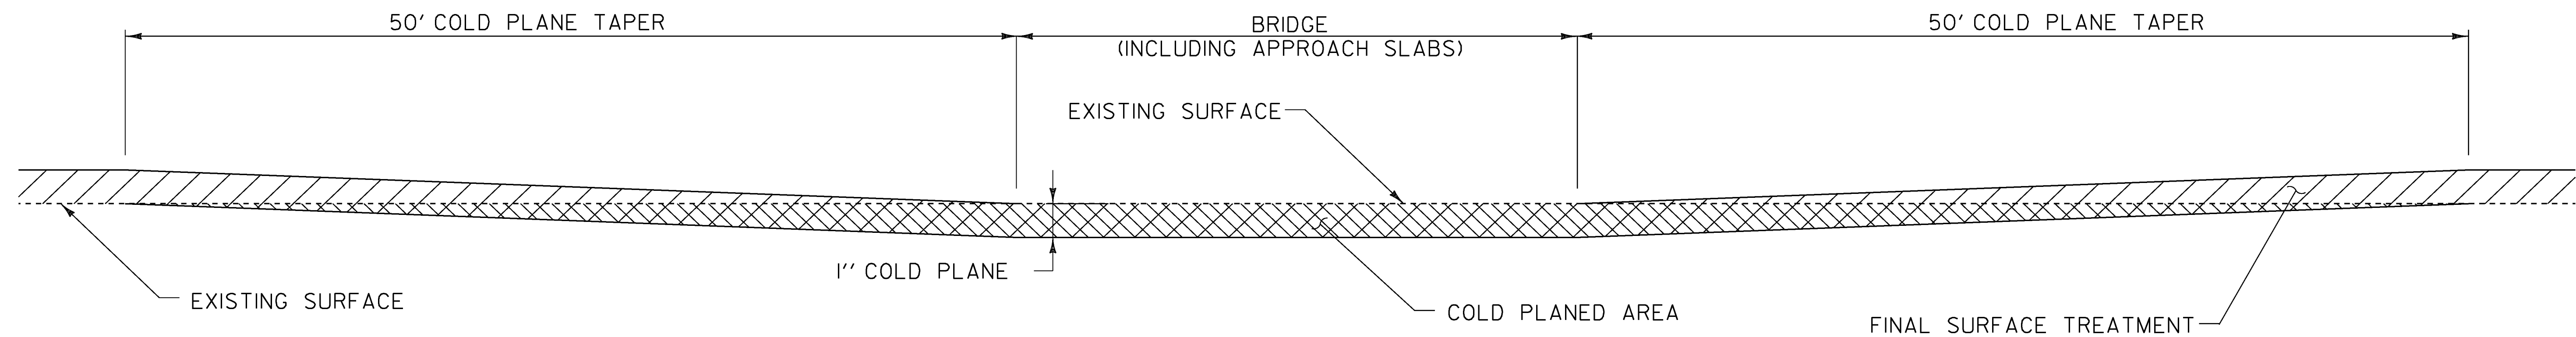


**BRIDGE COLD PLANE TYPICAL SECTION A - A**

LOCATIONS

BRIDGE 48-N	MM 74.834
BRIDGE 49-N	MM 75.841
BRIDGE 51-N	MM 80.217
BRIDGE 55-N	MM 89.266
BRIDGE 56-N	MM 91.539

**NOTES:**

1. REFER TO ASPHALTIC PLUG JOINT DETAIL SHEET, SD-516.10. ALL NEW JOINTS TO BE PAID FOR UNDER ITEM 516.10, "BRIDGE EXPANSION JOINT, ASPHALTIC PLUG."
2. THE CONTRACTOR SHALL TAKE PRECAUTIONS TO AVOID DAMAGING DRAINAGE STRUCTURES AND EXPANSION JOINTS. ANY DAMAGE CAUSED BY THE CONTRACTOR SHALL BE REPAIRED BY THE CONTRACTOR AT NO COST TO THE STATE.
3. THE CONTRACTOR SHALL TAKE PRECAUTIONS TO AVOID THE ACCUMULATION OF DEBRIS IN THE DRAINAGE STRUCTURES LOCATED AT CURB LINE AND IN THE EXPANSION JOINTS. THE CONTRACTOR SHALL EXAMINE THESE BRIDGE FEATURES ON A DAILY BASIS TO ENSURE THAT DEBRIS HAS NOT ACCUMULATED. ANY DEBRIS WHICH IS PRESENT SHALL BE REMOVED BY THE CONTRACTOR AT NO COST TO THE STATE.
4. THE CONTRACTOR SHALL USE CAUTION WHEN COLD PLANING AND PAVING OPERATIONS OCCUR ON BRIDGE DECKS. SHOULD ANY DAMAGE OCCUR TO THE DECK OR MEMBRANE AS A RESULT OF THESE OPERATIONS THE ENGINEER SHALL CONTACT THE VTRANS CONSTRUCTION STRUCTURES ENGINEER TO PROVIDE AN ASSESSMENT OF THE DAMAGE AND RECOMMEND ANY NECESSARY REPAIRS. THE CONSTRUCTION STRUCTURES ENGINEER WILL ALSO DETERMINE IF THE DAMAGE WAS AVOIDABLE. IF THE CONTRACTOR IS DETERMINED BY THE ENGINEER TO BE AT FAULT FOR THE DAMAGE, THE RECOMMENDED REPAIRS SHALL BE COMPLETED BY THE CONTRACTOR AT NO COST TO THE STATE.

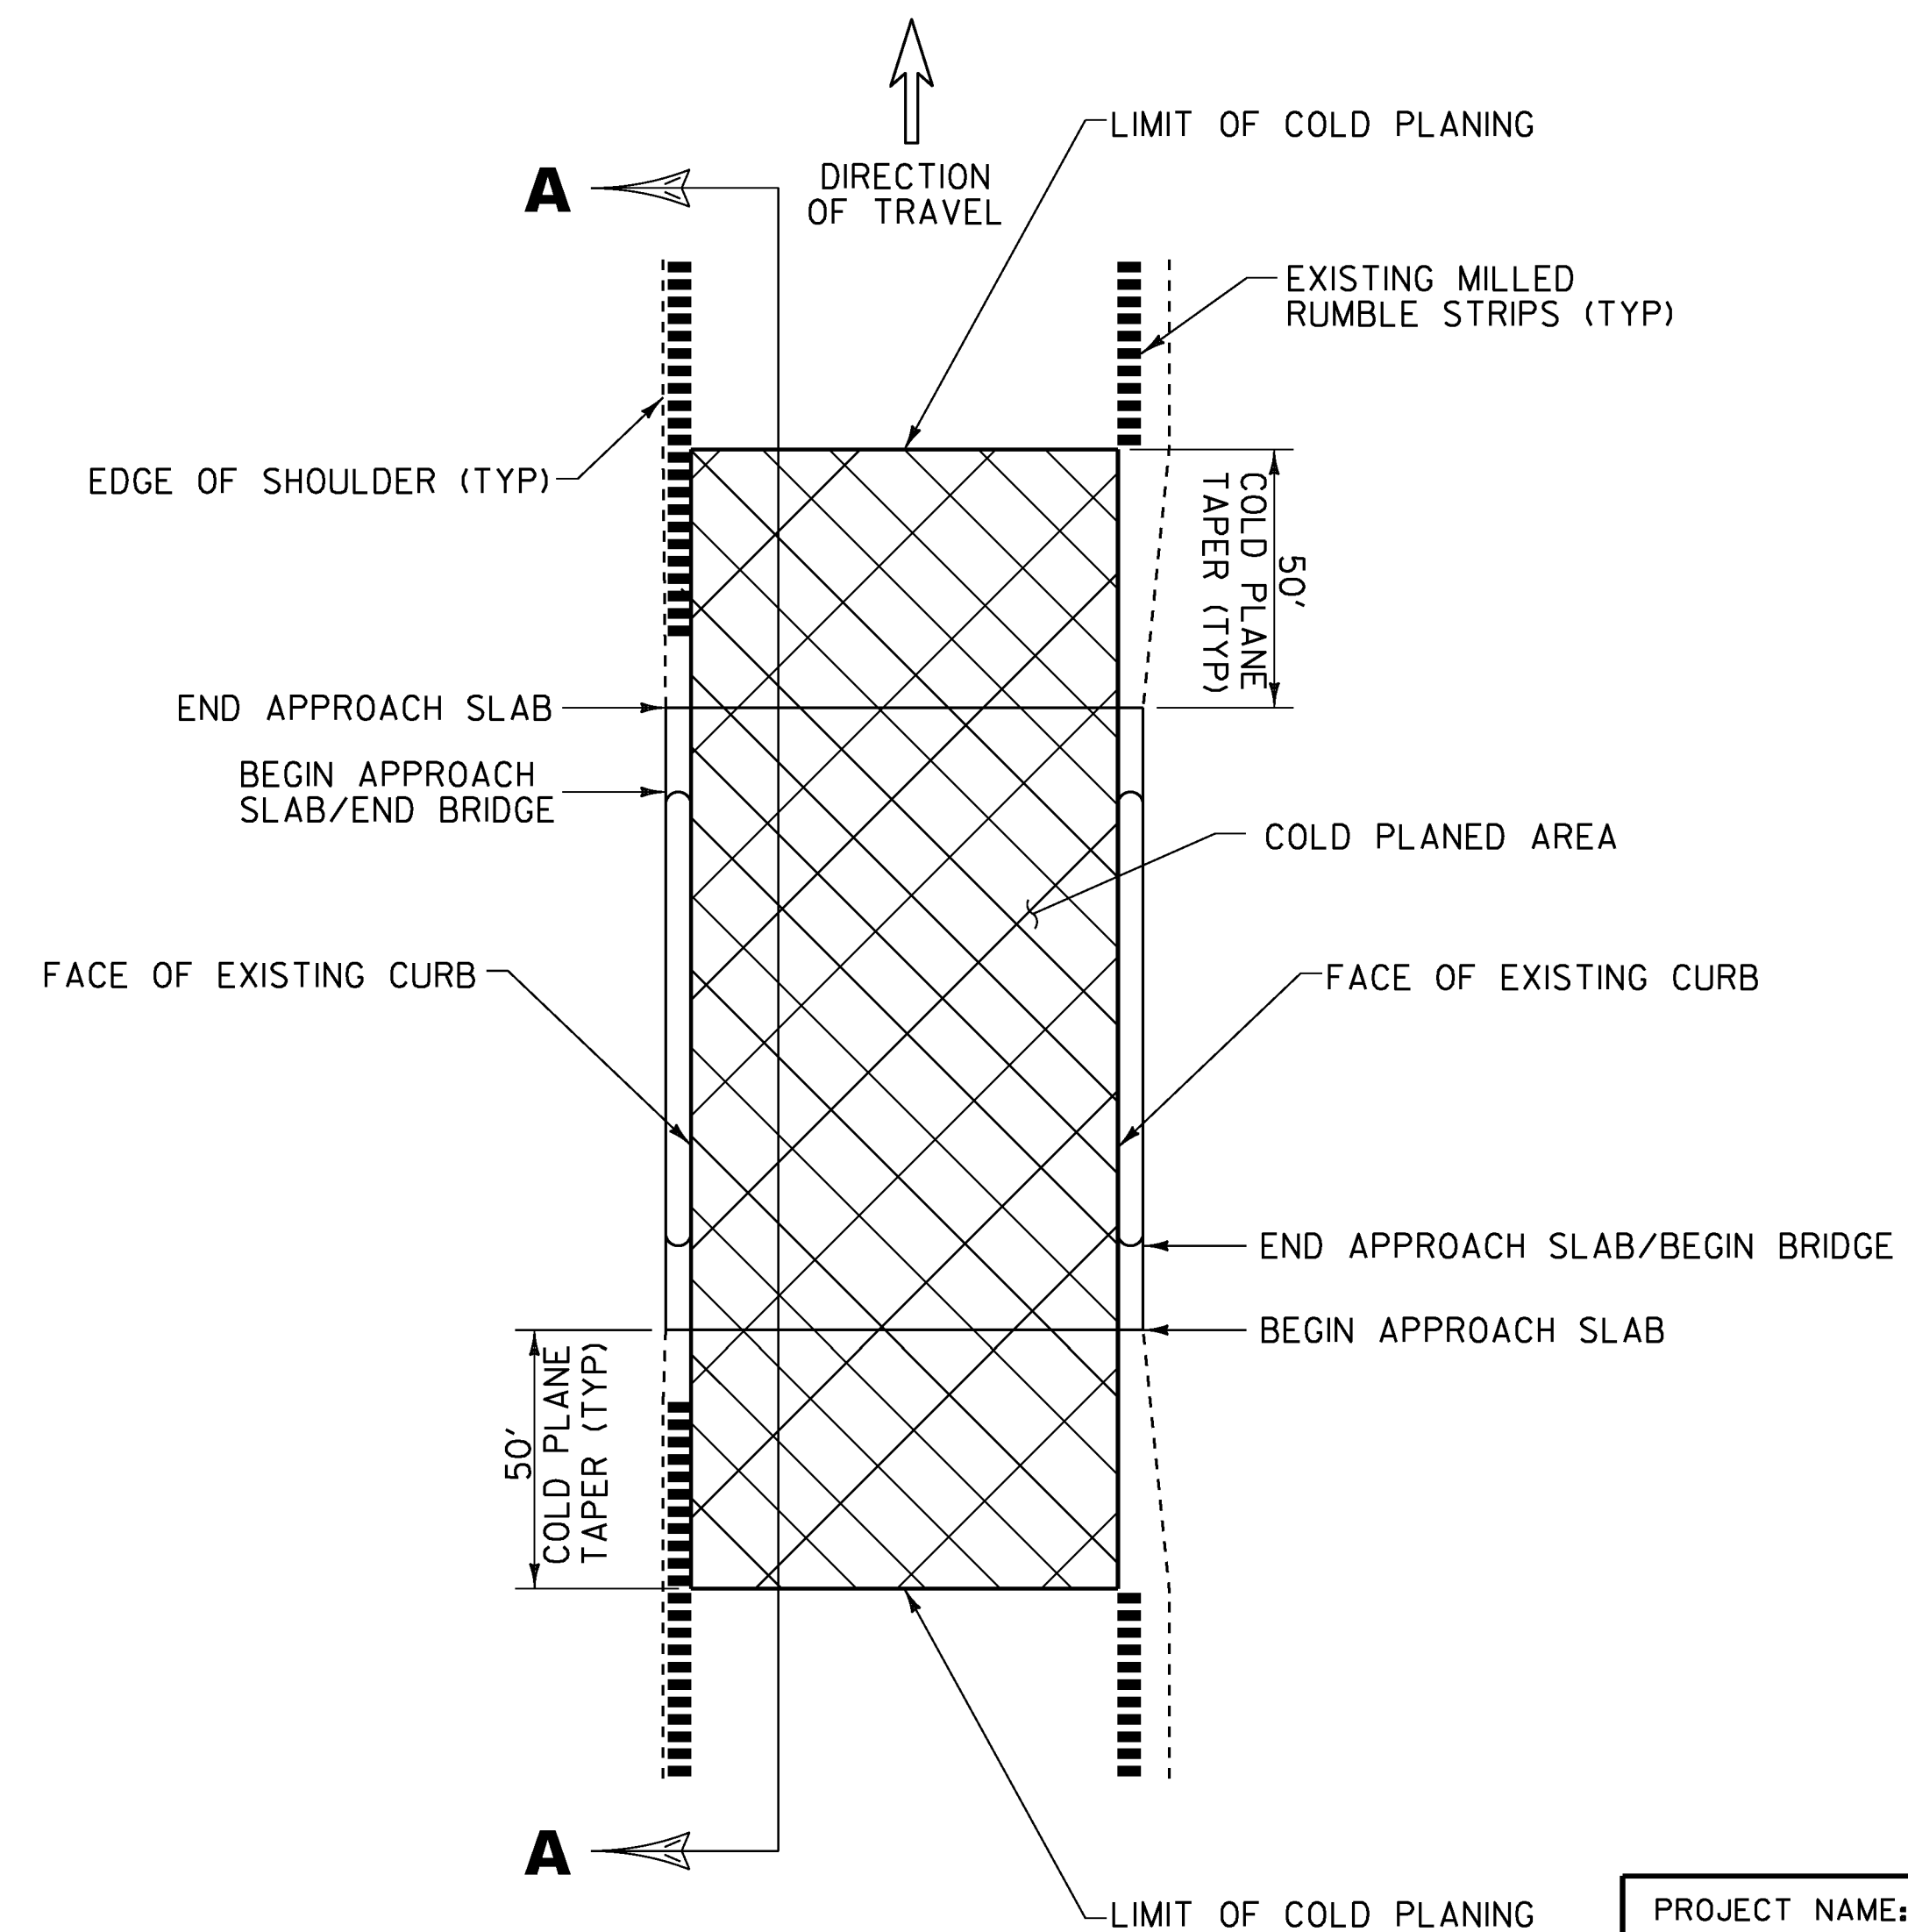


**BRIDGE COLD PLANE TYPICAL PLAN**

**NOT TO SCALE**

PROJECT NAME: NORWICH - FAIRLEE	PLOT DATE: 15-DEC-2014
PROJECT NUMBER: IM SURF(48)	DRAWN BY: N. PAPPAS
FILE NAME: I4a144 Norwich-Fairlee.dgn	CHECKED BY: J. HARRINGTON
PROJECT LEADER: J. HARRINGTON	SHEET 6 OF 22
DESIGNED BY: N. PAPPAS	BRIDGE DETAIL SHEET 1

↑  
NORTHBOUND  
DIRECTION OF TRAVEL

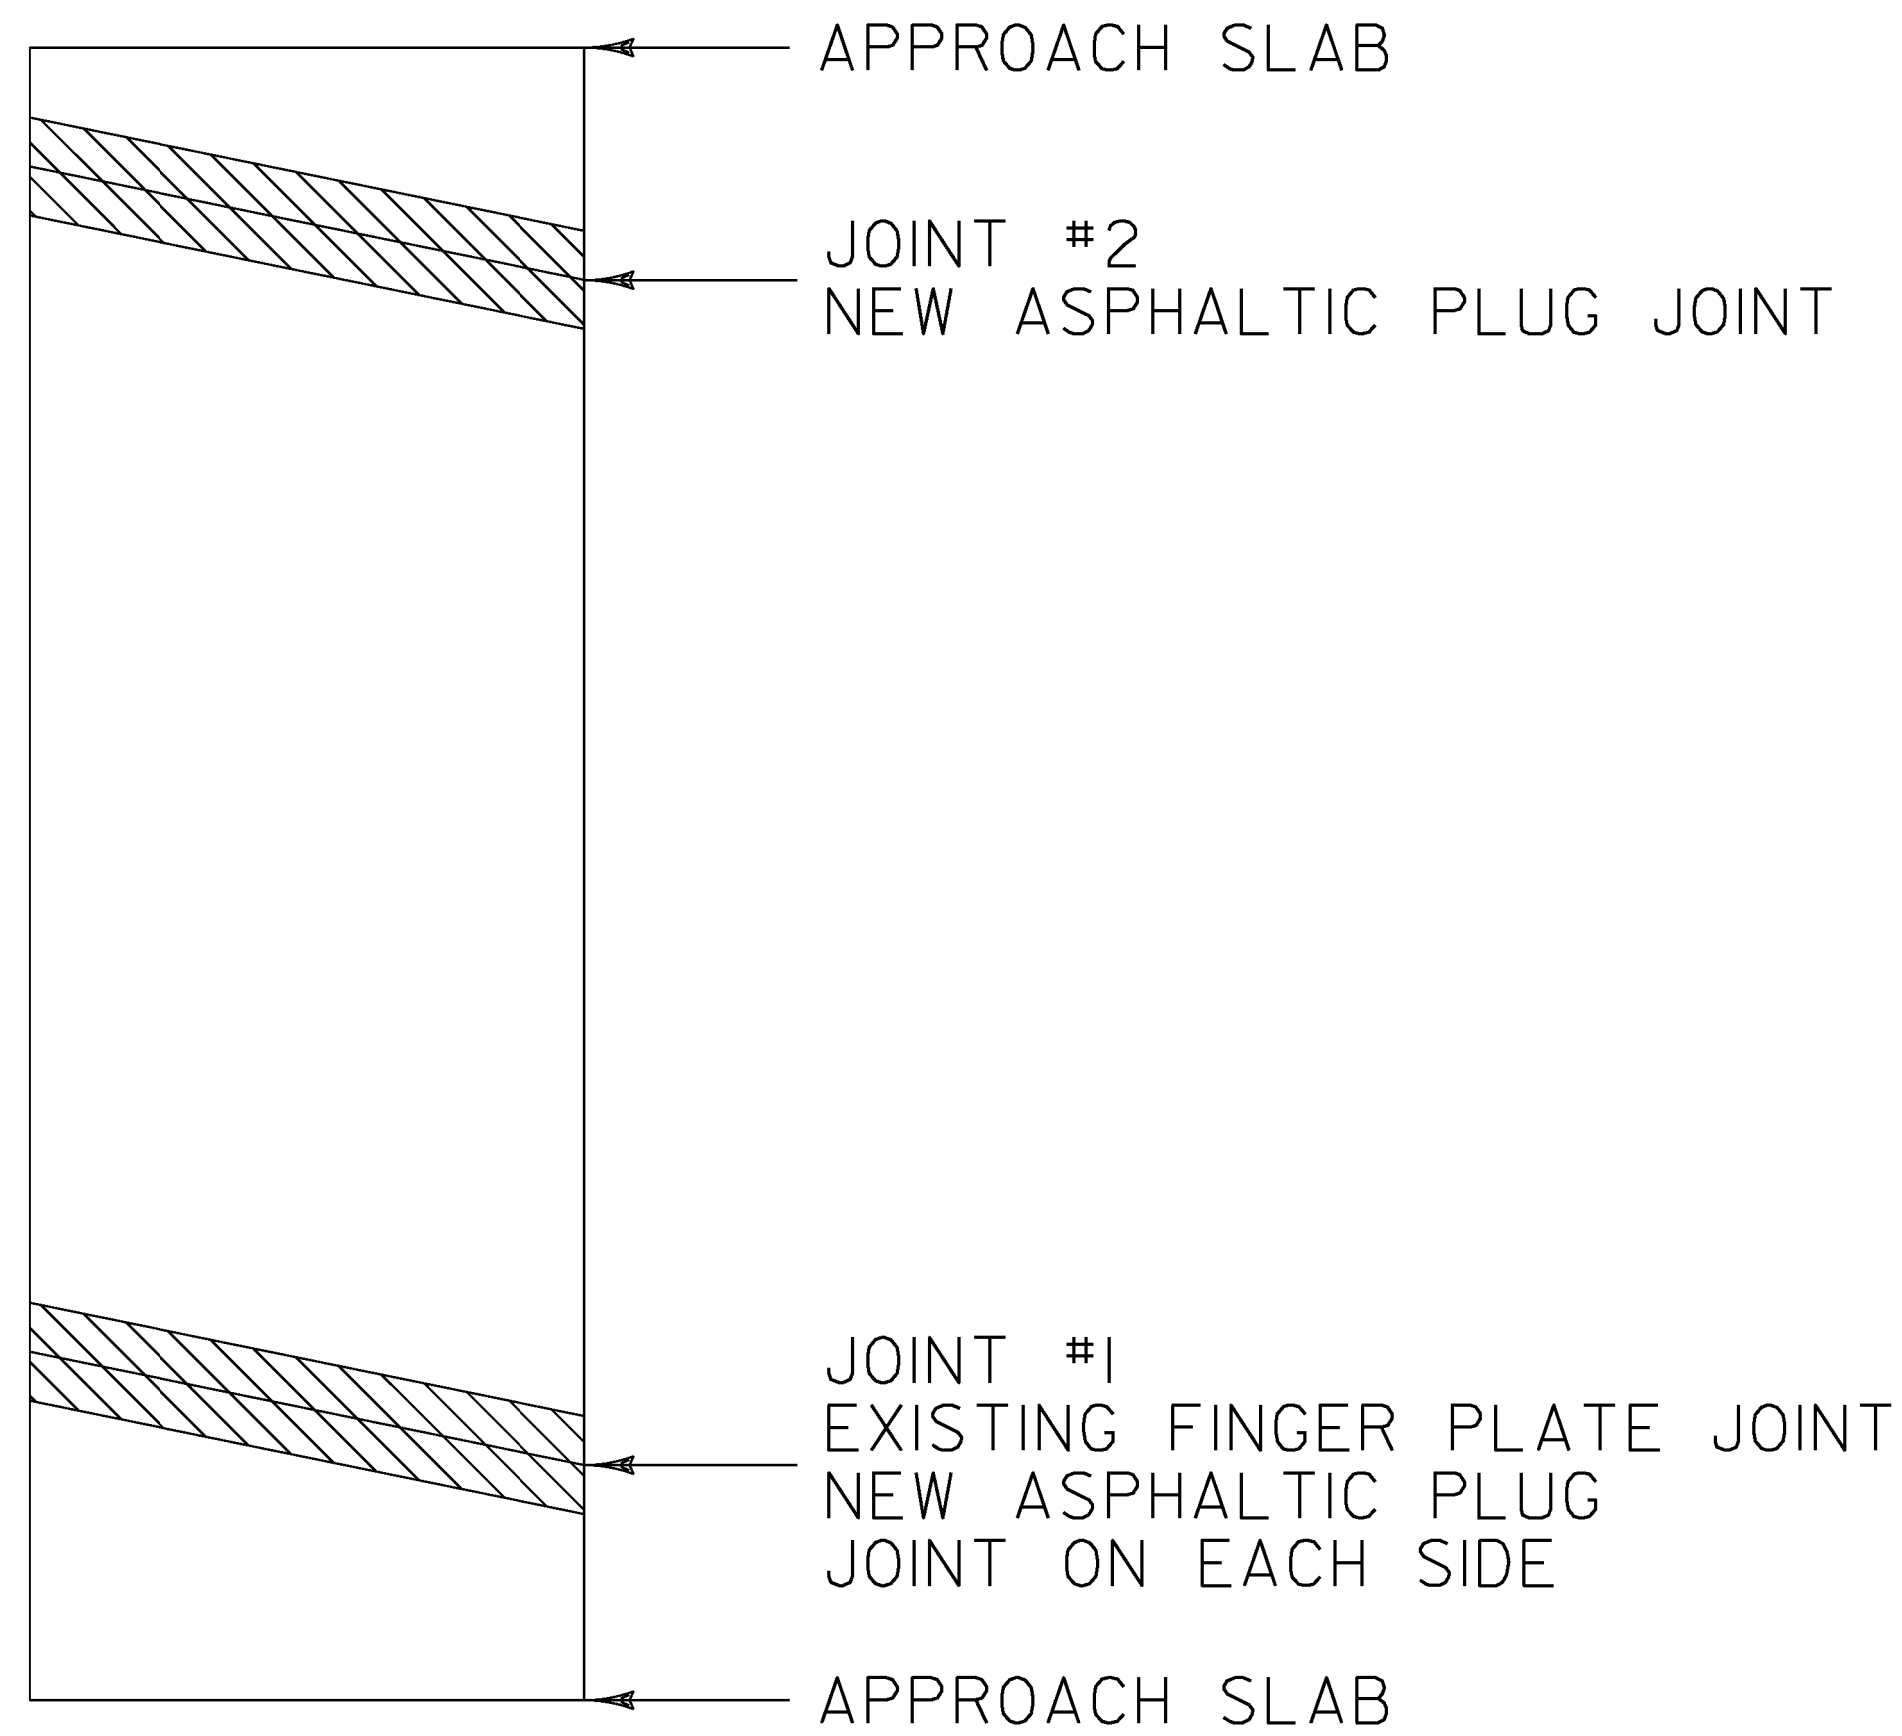

**BRIDGE 48N**

MM 74.834


LENGTH OF ASPHALTIC PLUG JOINTS:

JOINT #1 - ~~41~~40' X 2 = ~~80~~82'

JOINT #2 - ~~40~~41'

TOTAL = ~~120~~123'

↑  
NORTHBOUND  
DIRECTION OF TRAVEL

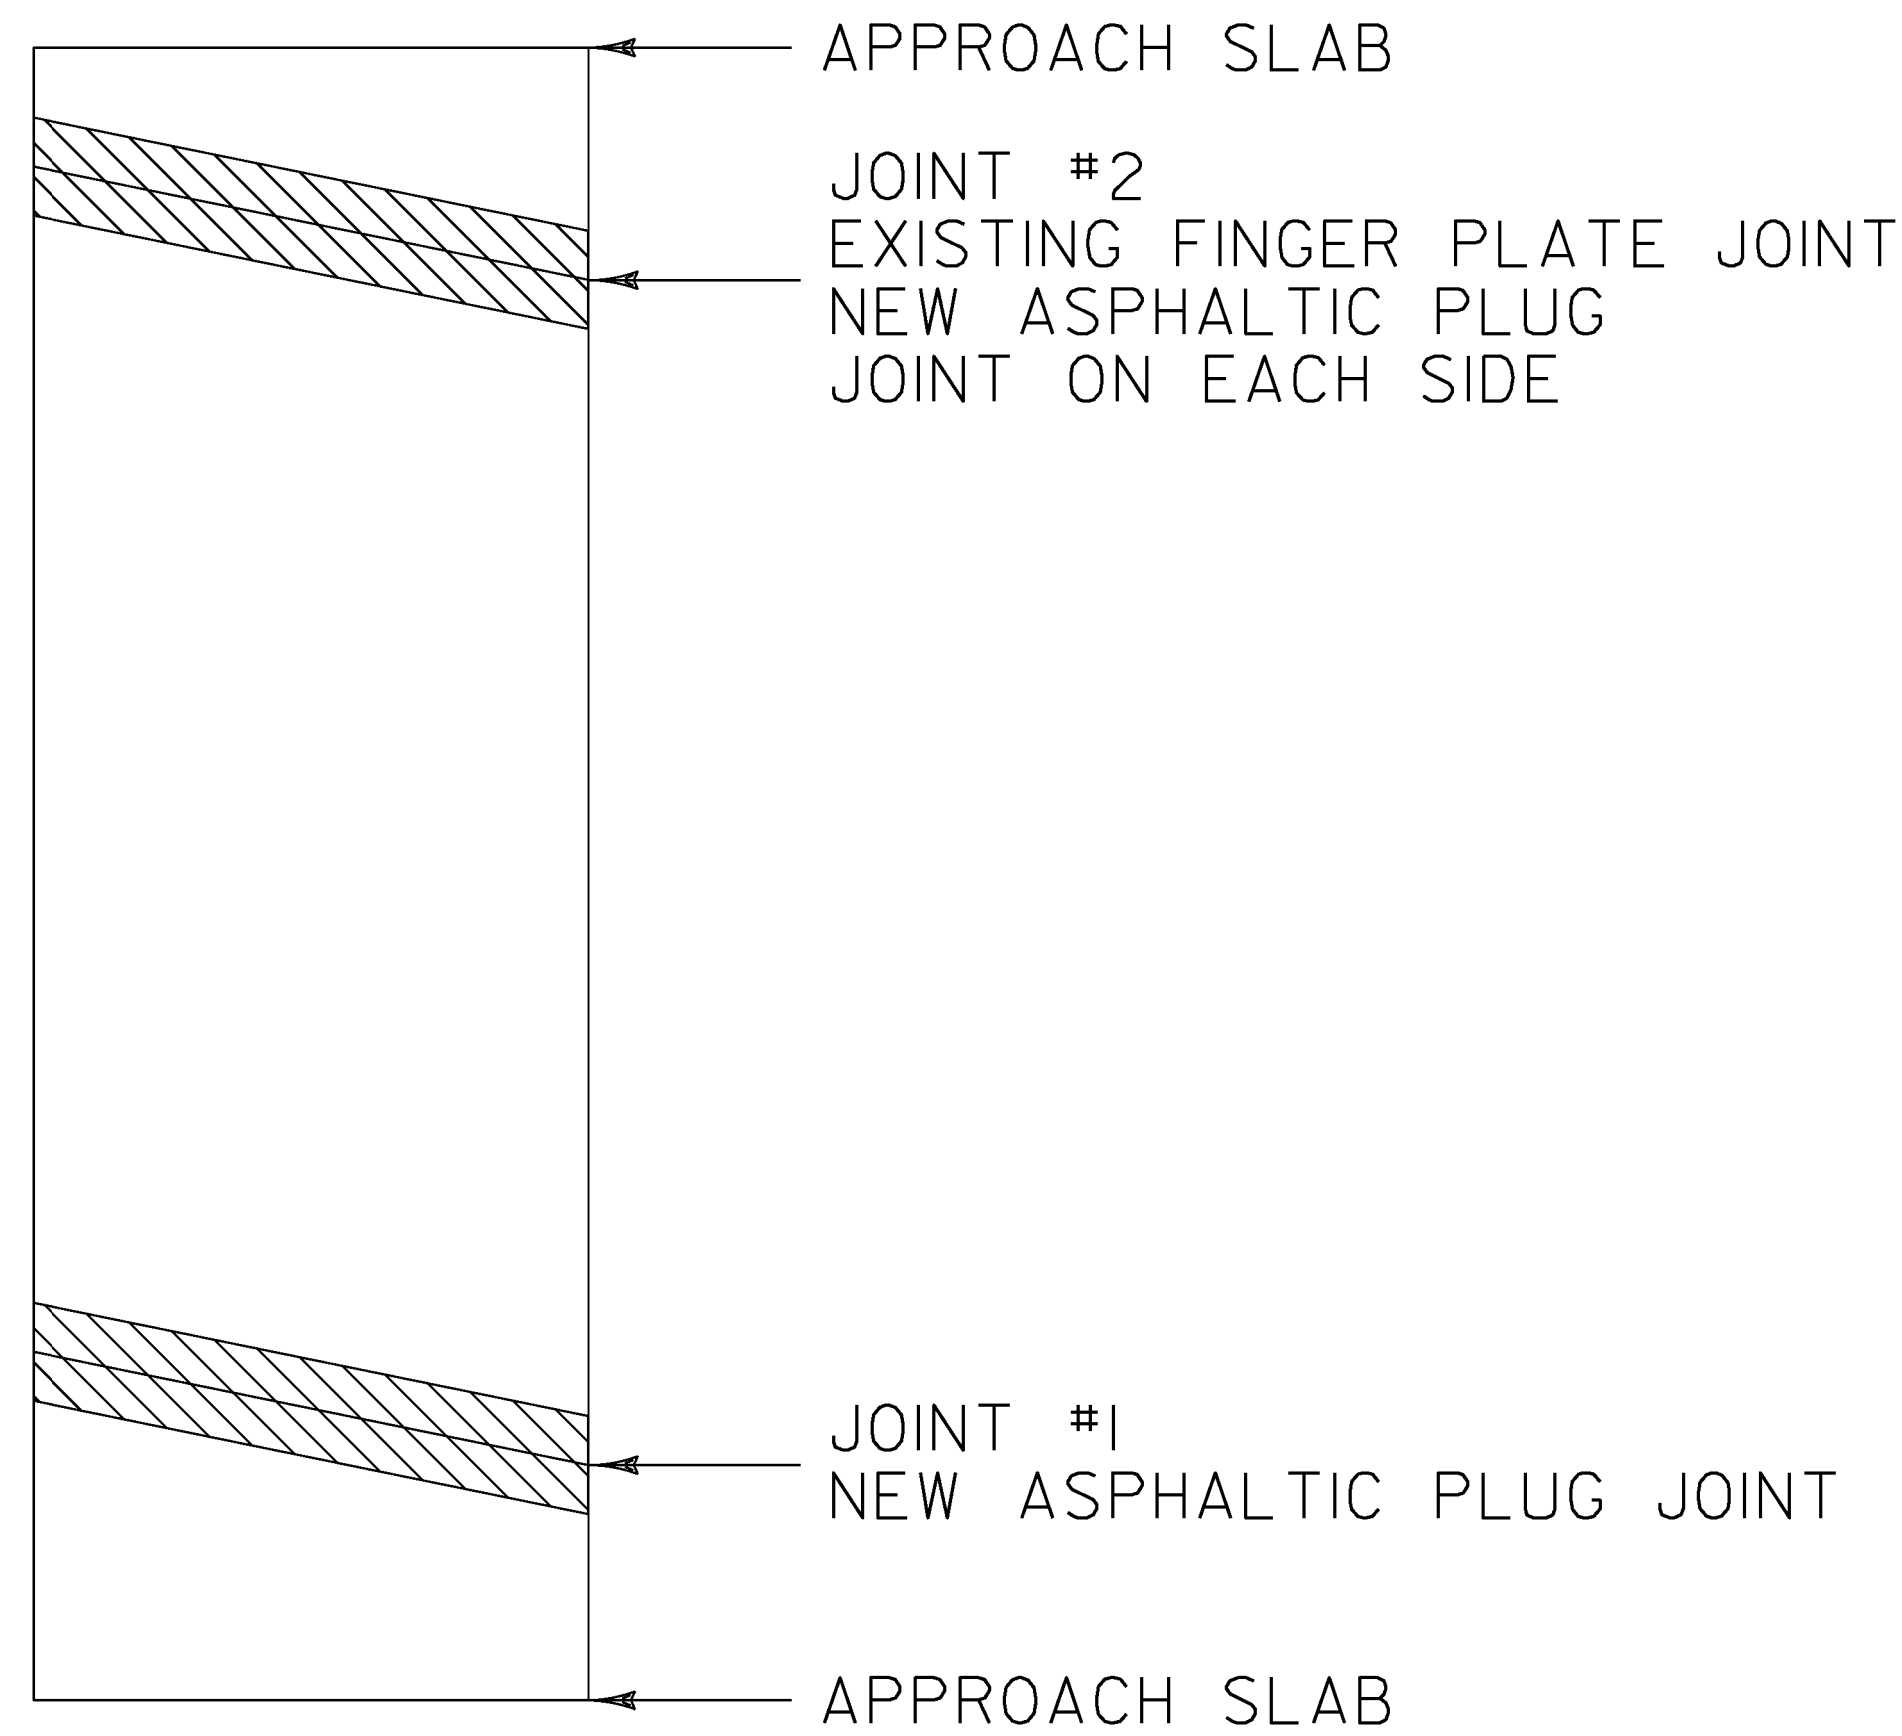

**BRIDGE 49N**

MM 75.841


LENGTH OF ASPHALTIC PLUG JOINTS:

JOINT #1 - ~~45~~46'

JOINT #2 - 45' X 2 = 90'

TOTAL = ~~135~~136'

↑  
NORTHBOUND  
DIRECTION OF TRAVEL

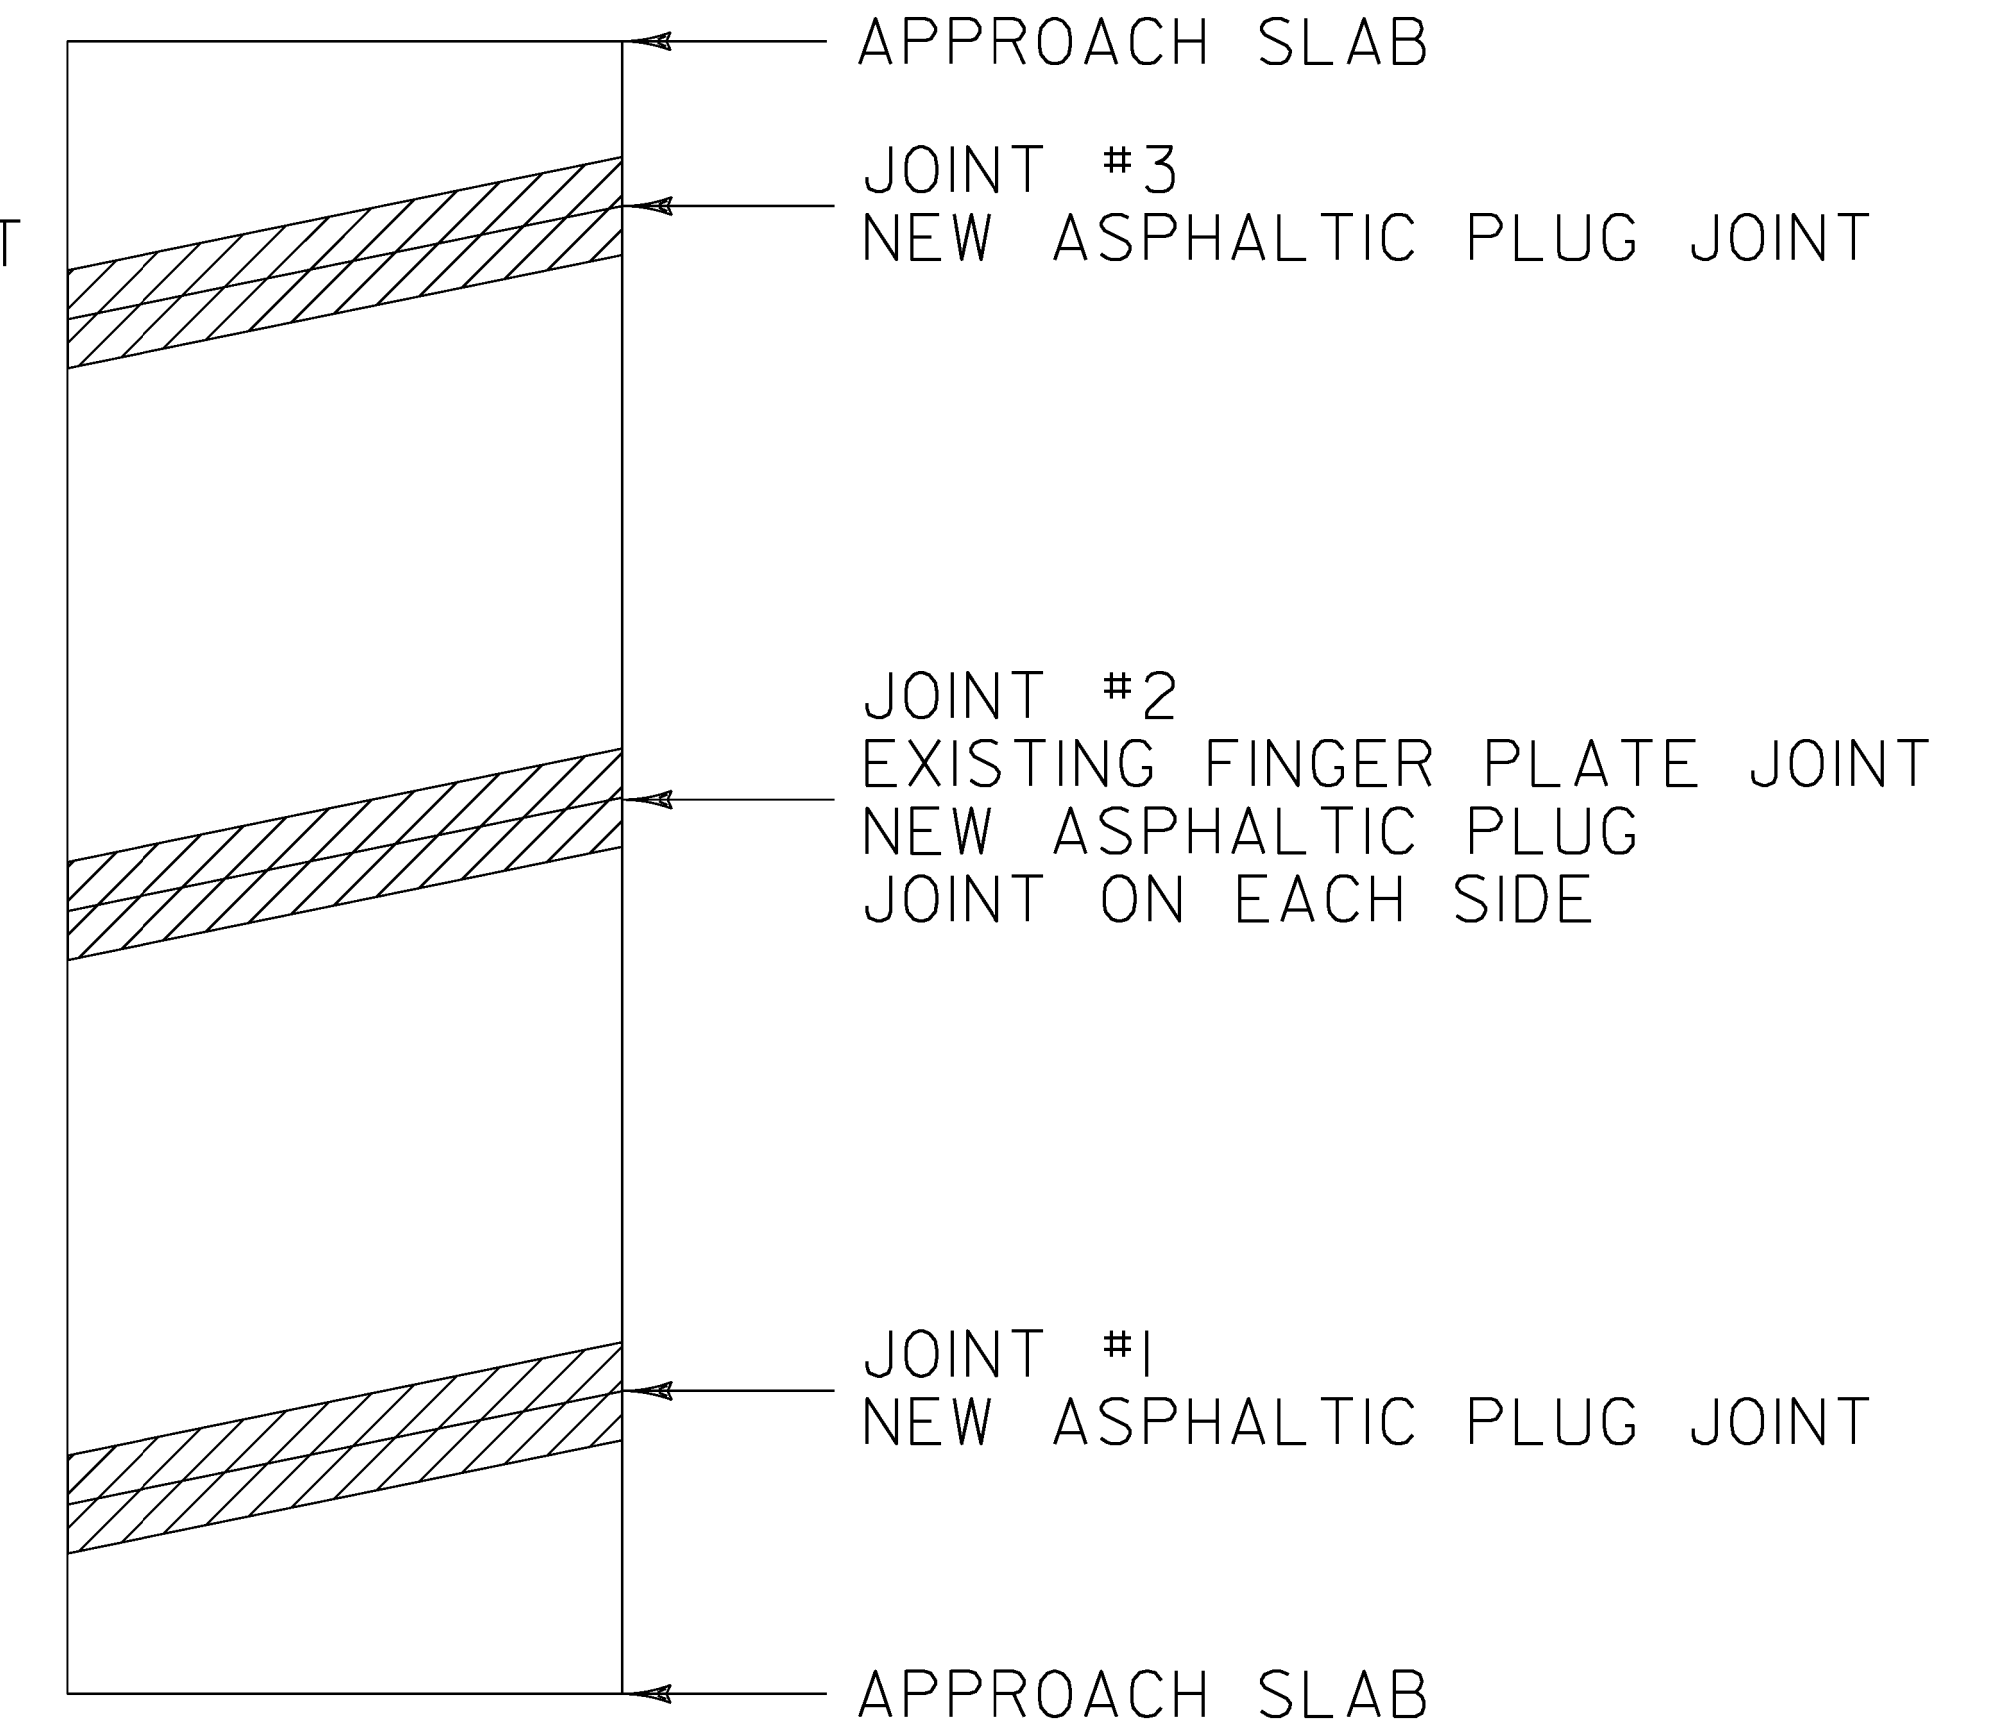

**BRIDGE 51N**

MM 80.217

LENGTH OF ASPHALTIC PLUG JOINTS:


JOINT #1 - ~~40~~41'

JOINT #2 - ~~41~~40' X 2 = ~~80~~82'

JOINT #3 - ~~40~~41'

TOTAL = ~~160~~164'

**LEGEND**

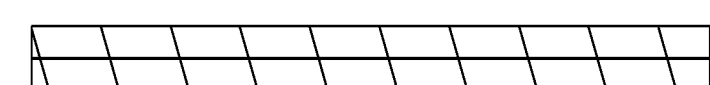


EXISTING BRIDGE JOINTS TO BE REPAIRED  
WITH ASPHALTIC PLUG JOINT.

**NOT TO SCALE**

PROJECT NAME: NORWICH - FAIRLEE  
PROJECT NUMBER: IM SURF(48)

FILE NAME: I4a144 Norwich-Fairlee.dgn PLOT DATE: 15-DEC-2014  
PROJECT LEADER: J. HARRINGTON DRAWN BY: N. PAPPAS  
DESIGNED BY: N. PAPPAS CHECKED BY: J. HARRINGTON  
BRIDGE DETAIL SHEET 2 SHEET 7 OF 22

↑  
NORTHBOUND  
DIRECTION OF TRAVEL

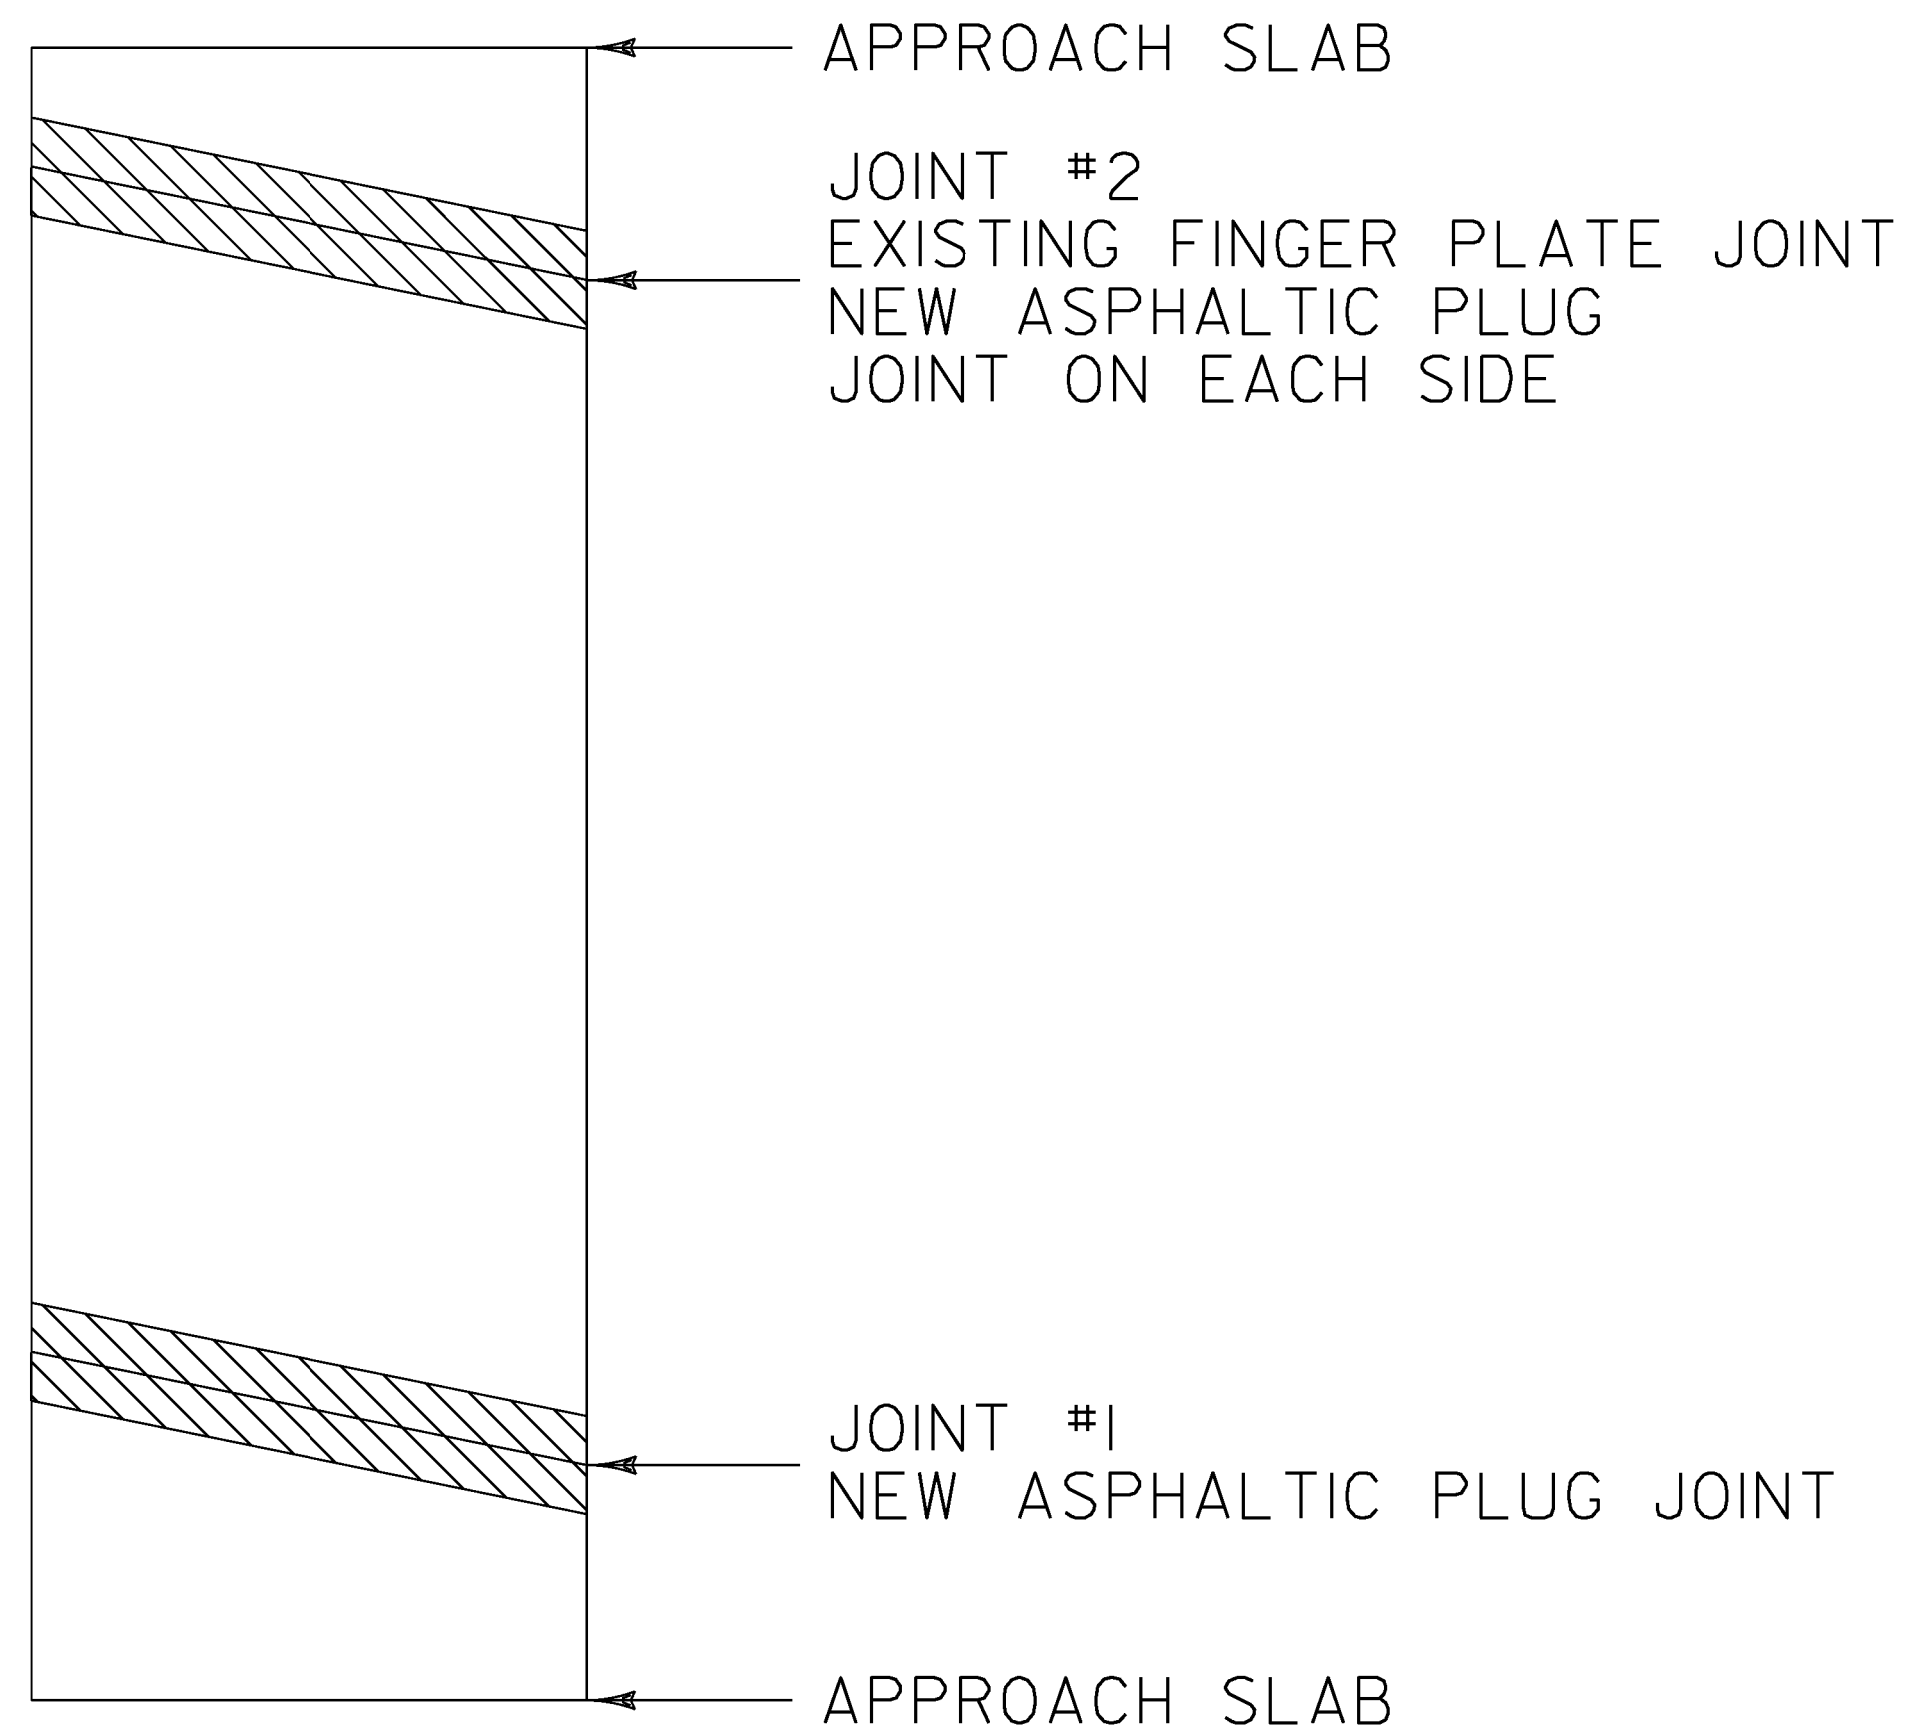


**BRIDGE 55N**

MM 89.266

LENGTH OF ASPHALTIC PLUG JOINTS:

JOINT #1 - ~~50'~~ 49.5'  
JOINT #2 - ~~50'~~ X 2 = ~~100'~~ 98'  
TOTAL = ~~150'~~ 147.5'

↑  
NORTHBOUND  
DIRECTION OF TRAVEL

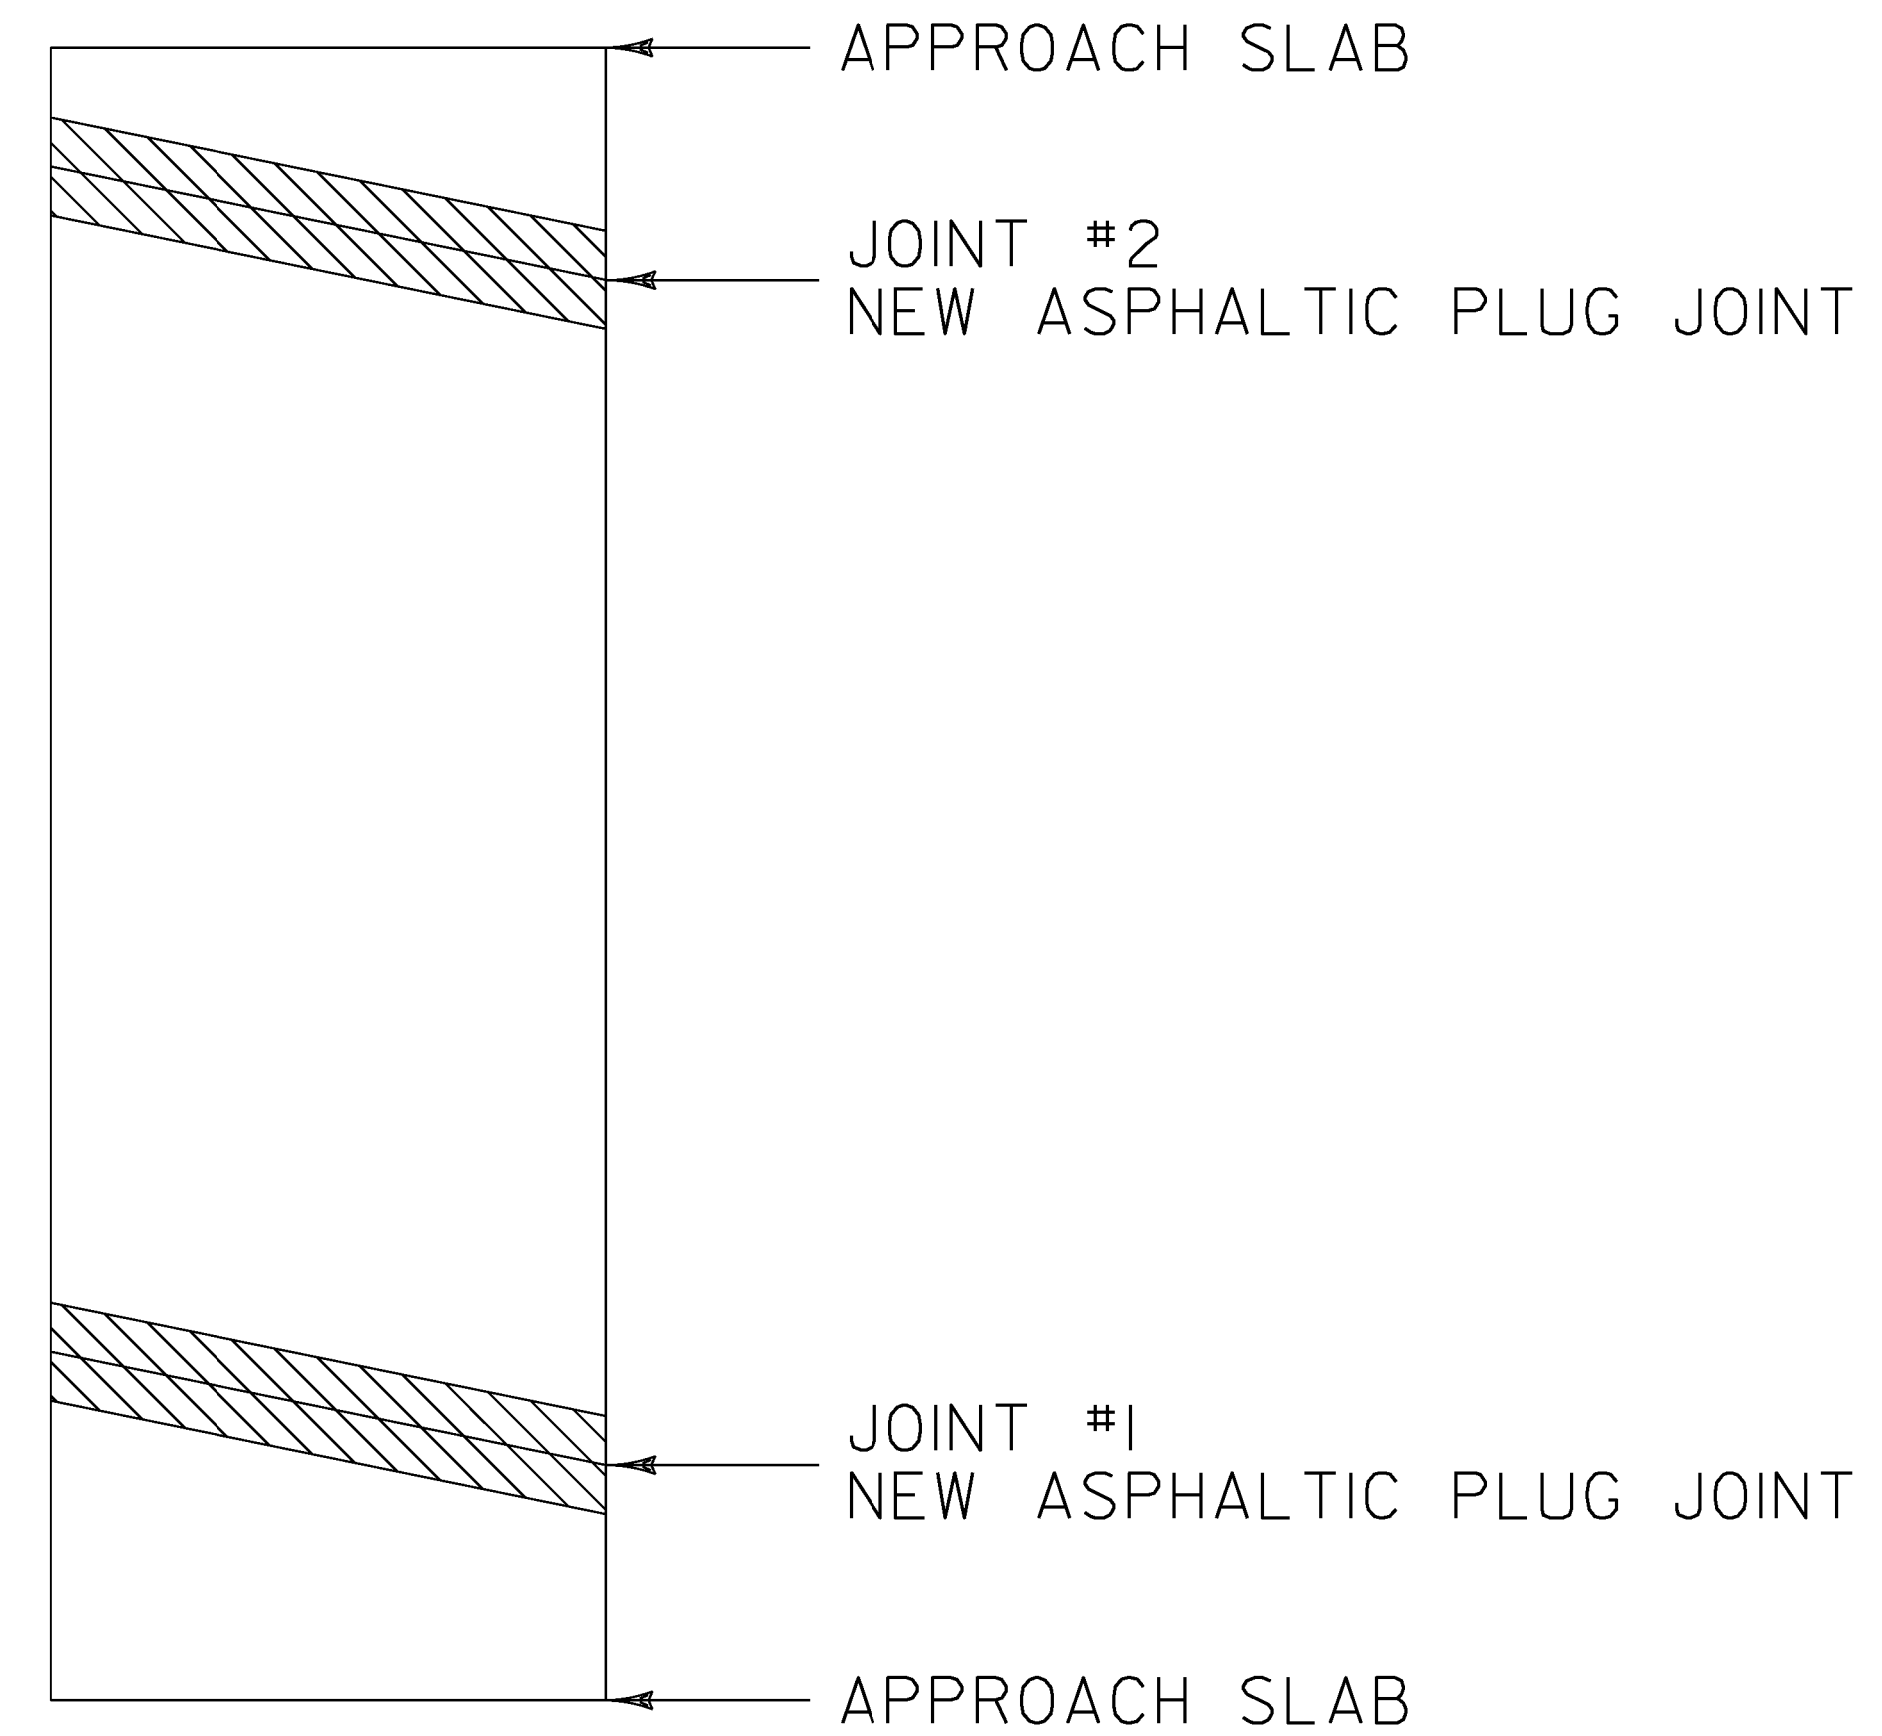


**BRIDGE 56N**

MM 91.539

LENGTH OF ASPHALTIC PLUG JOINTS:

JOINT #1 - ~~40'~~ 40.5'  
JOINT #2 - ~~40'~~ 40.5'  
TOTAL = ~~80'~~ 81'


**LEGEND**

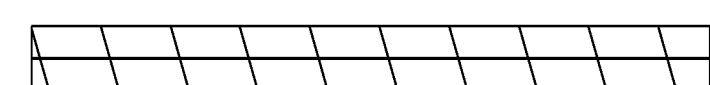


EXISTING BRIDGE JOINTS TO BE REPAIRED  
WITH ASPHALTIC PLUG JOINT.

**NOT TO SCALE**

PROJECT NAME: NORWICH - FAIRLEE	PLOT DATE: 15-DEC-2014
PROJECT NUMBER: IM SURF(48)	DRAWN BY: N. PAPPAS
FILE NAME: I4a144 Norwich-Fairlee.dgn	CHECKED BY: J. HARRINGTON
PROJECT LEADER: J. HARRINGTON	DESIGNED BY: N. PAPPAS
BRIDGE DETAIL SHEET 3	SHEET 8 OF 22

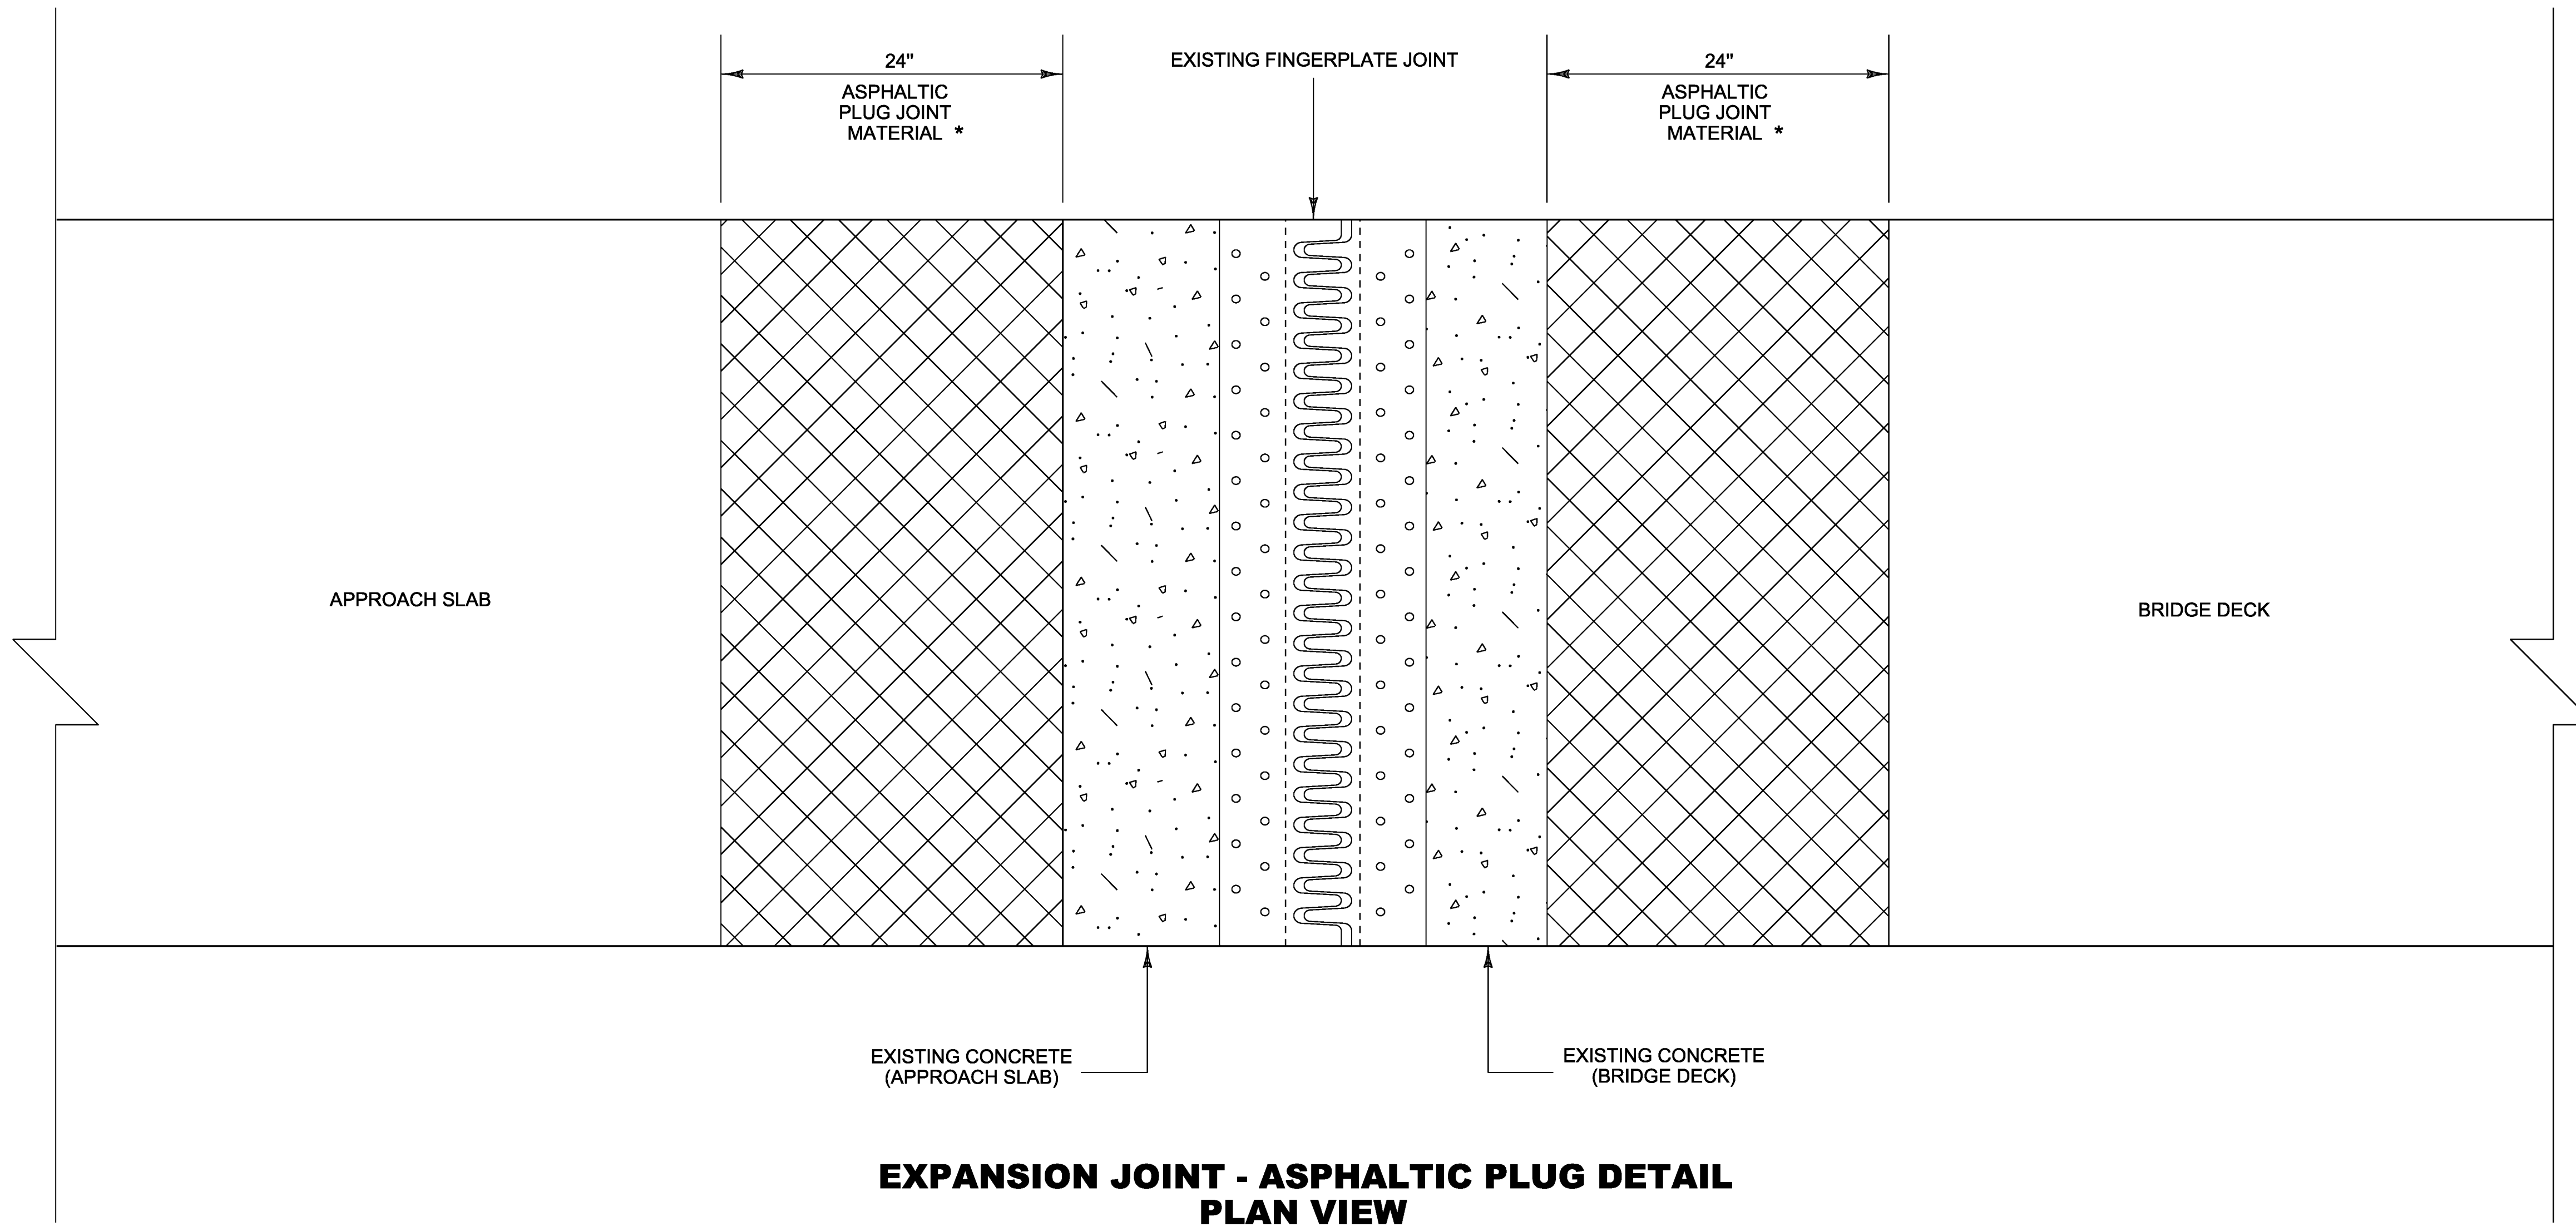

**EXPANSION JOINT - ASPHALTIC PLUG DETAIL  
PLAN VIEW  
(FINGER PLATE JOINT)**

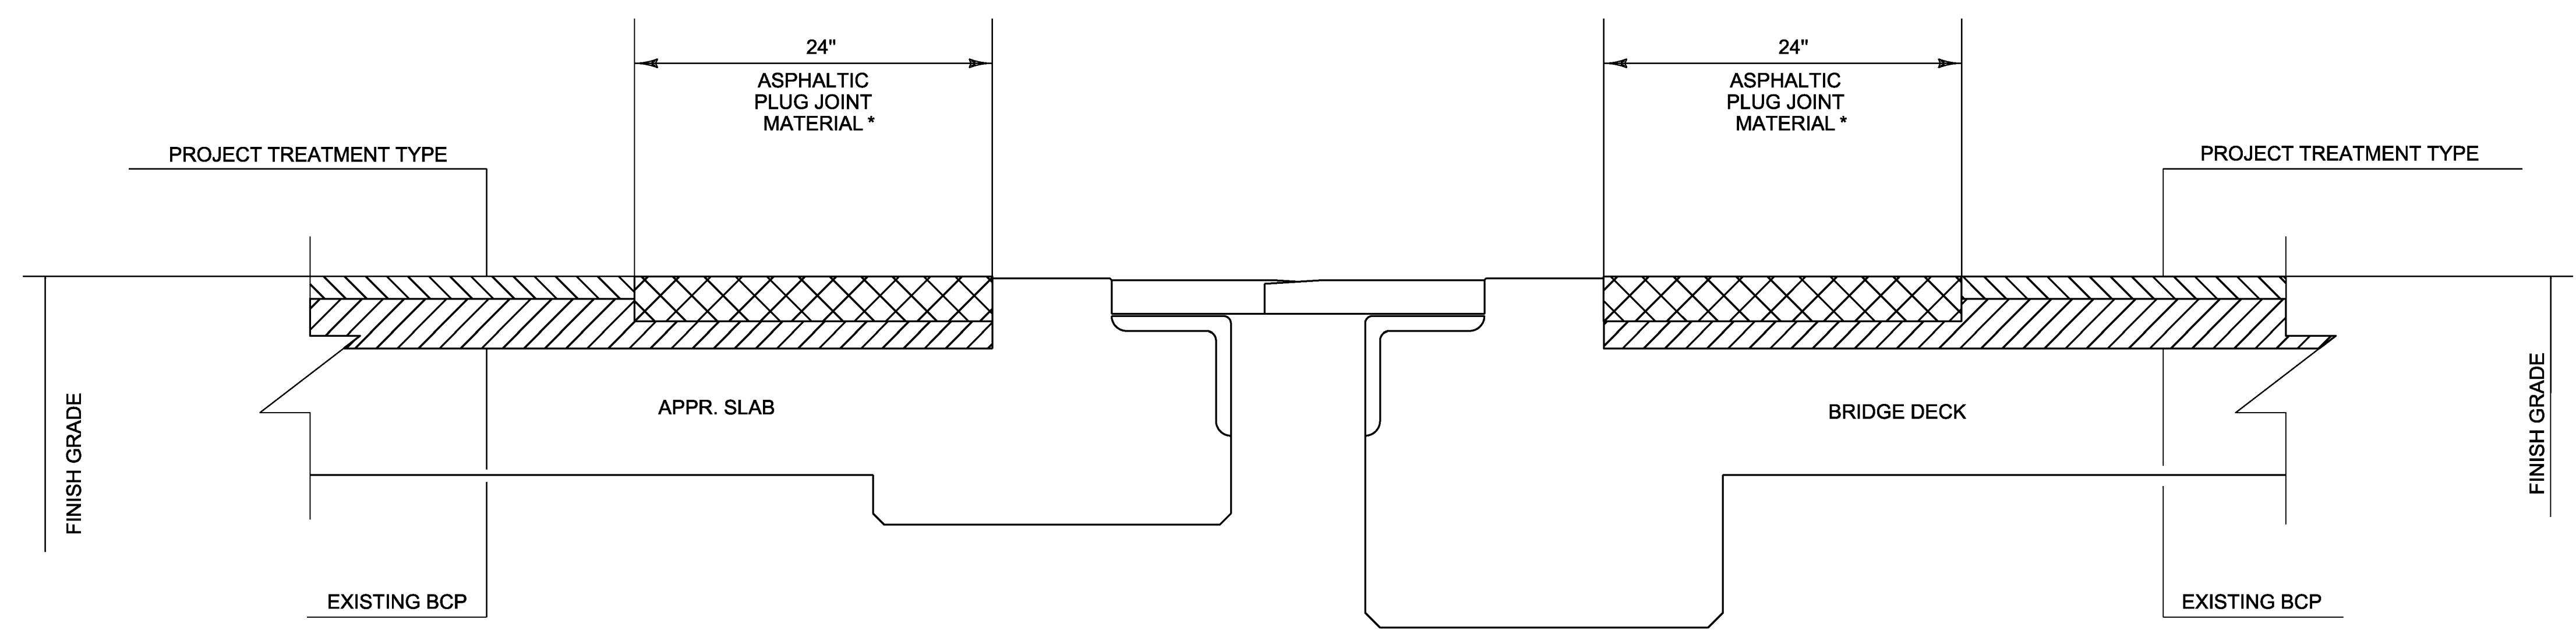



\* 2" MINIMUM DEPTH UNLESS OTHERWISE DIRECTED BY THE ENGINEER

**EXPANSION JOINT - ASPHALTIC PLUG DETAIL  
CROSS SECTION VIEW  
(FINGER PLATE JOINT)**




**NOT TO SCALE**

PROJECT NAME: NORWICH - FAIRLEE	PLOT DATE: 15-DEC-2014
PROJECT NUMBER: IM SURF(48)	DRAWN BY: N. PAPPAS
FILE NAME: I4a144 Norwich-Fairlee.dgn	CHECKED BY: J. HARRINGTON
PROJECT LEADER: J. HARRINGTON	SHEET 9 OF 22
DESIGNED BY: N. PAPPAS	
BRIDGE DETAIL SHEET 4	

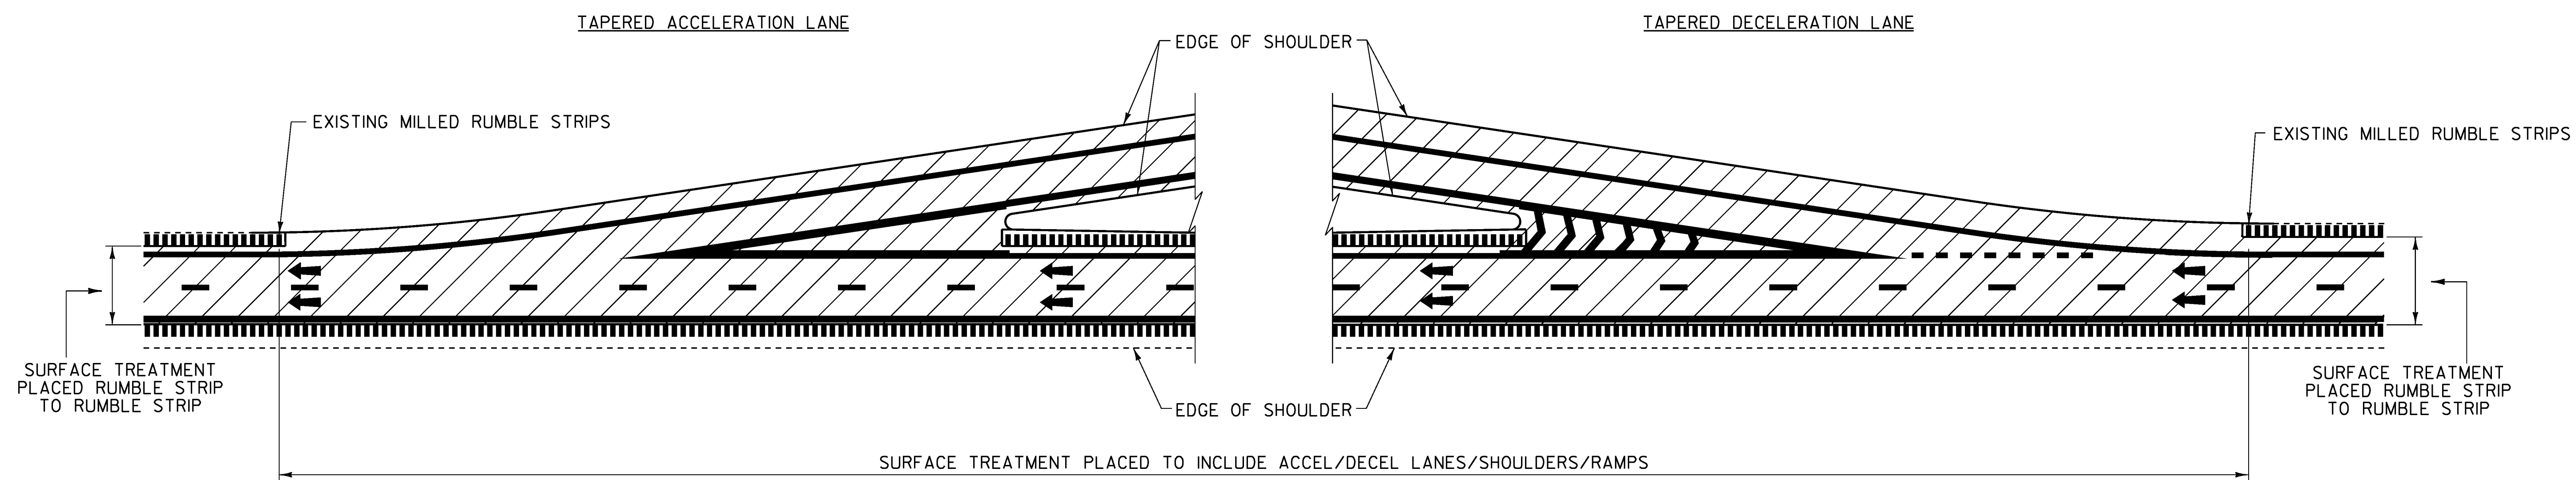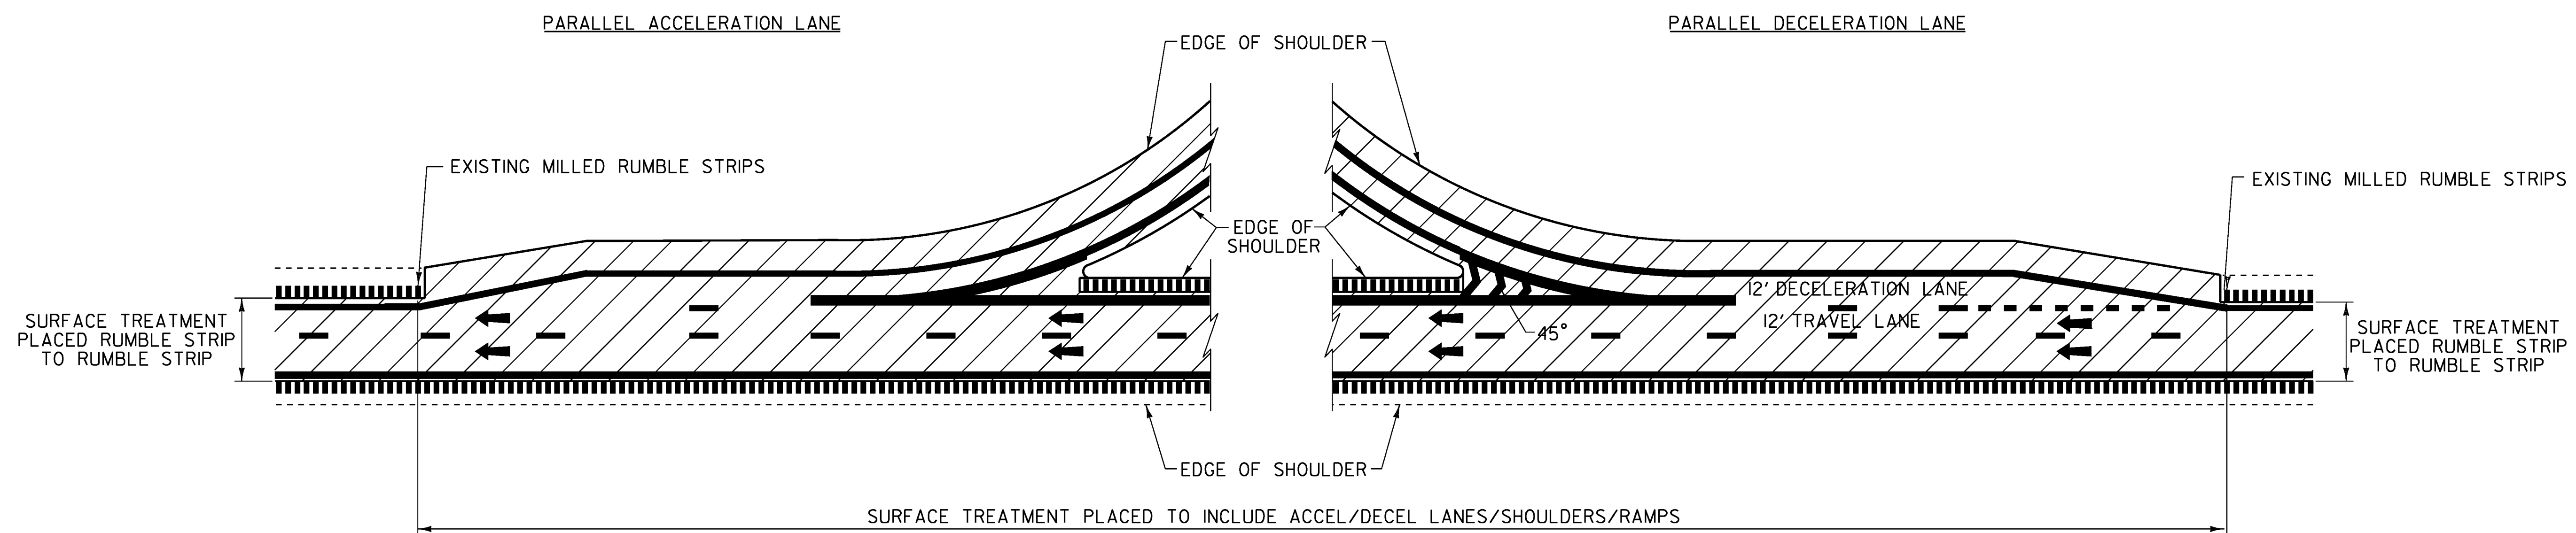**TYPICAL INTERCHANGE CONSTRUCTION DETAILS #1**

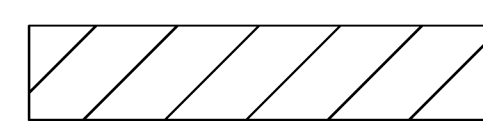

**LEGEND**

-  SURFACE TREATMENT
-  DIRECTION OF TRAFFIC FLOW
-  EXISTING MILLED RUMBLE STRIPS




NOTE: LINE STRIPING SHOWN FOR REFERENCE ONLY.

**NOT TO SCALE**


PROJECT NAME: NORWICH - FAIRLEE	
PROJECT NUMBER: IM SURF(48)	
FILE NAME: I4a144 Norwich-Fairlee.dgn	PLOT DATE: 15-DEC-2014
PROJECT LEADER: J. HARRINGTON	DRAWN BY: N. PAPPAS
DESIGNED BY: N. PAPPAS	CHECKED BY: J. HARRINGTON
TYPICAL INTERCHANGE CONSTRUCT. DETAIL 1	SHEET 10 OF 22

## TYPICAL INTERCHANGE CONSTRUCTION DETAILS # 2

NOT TO SCALE

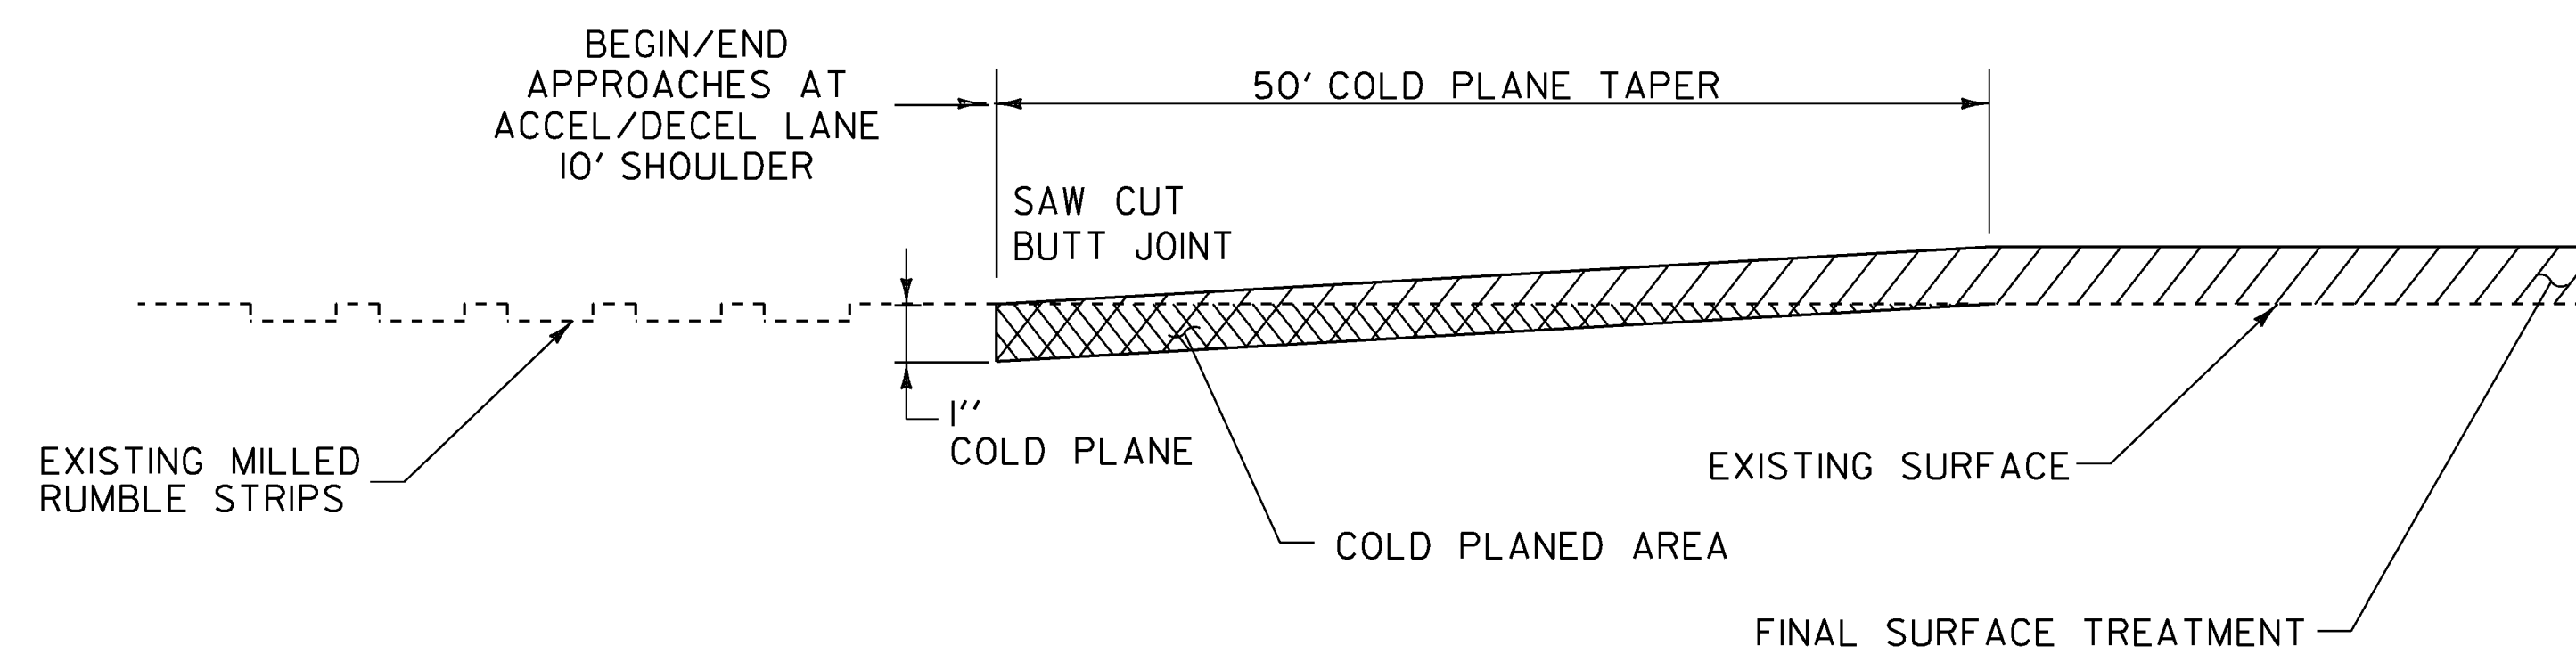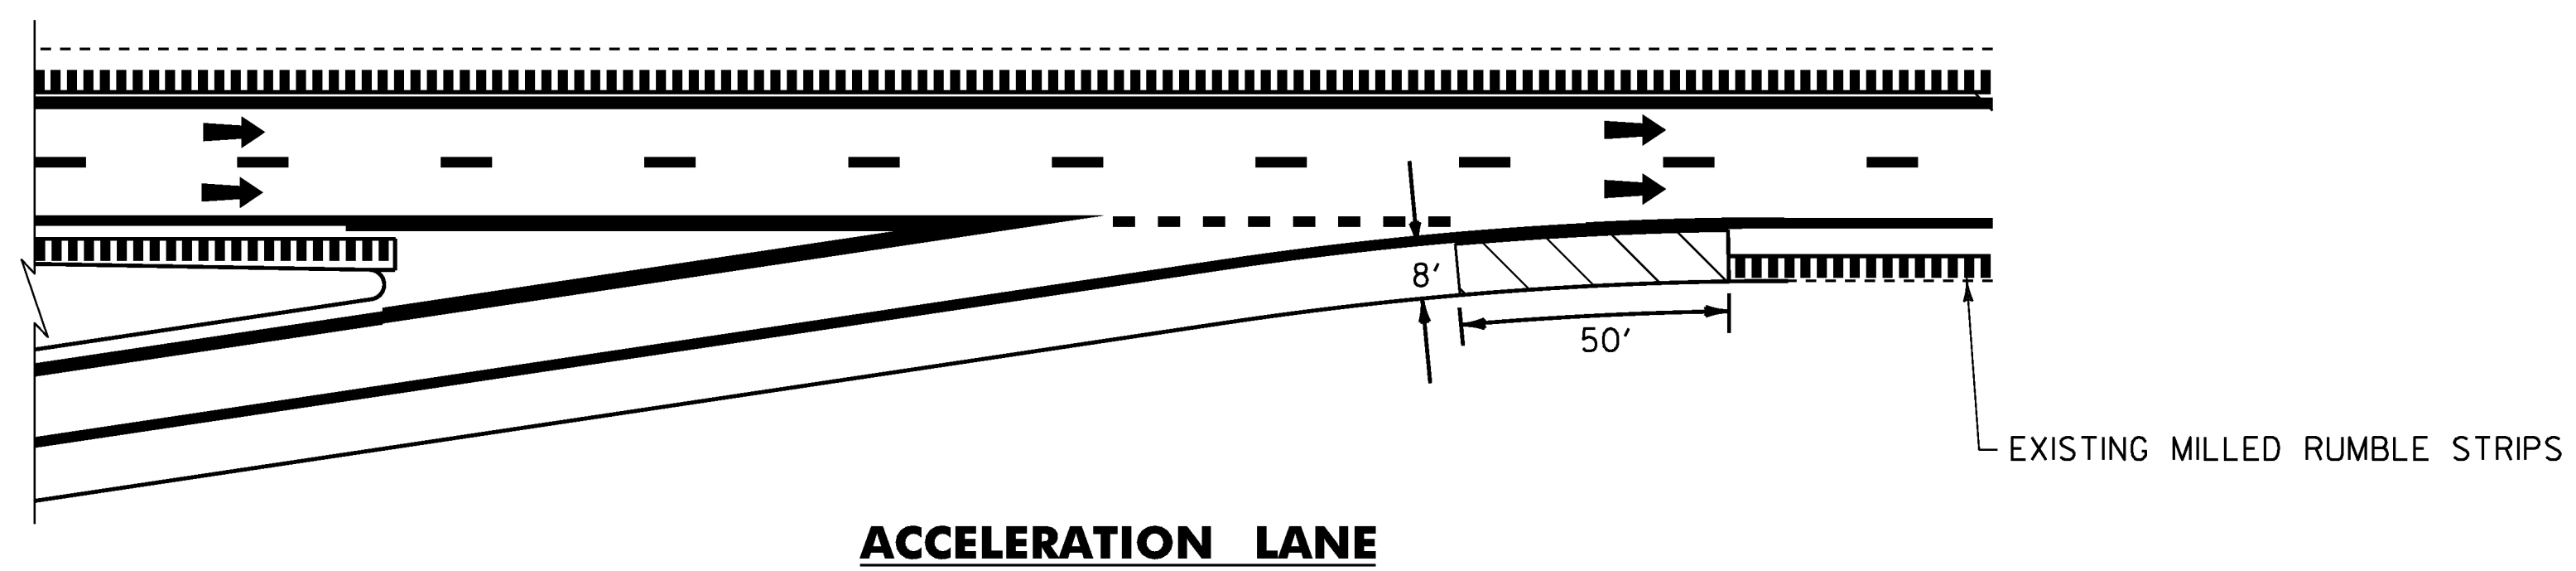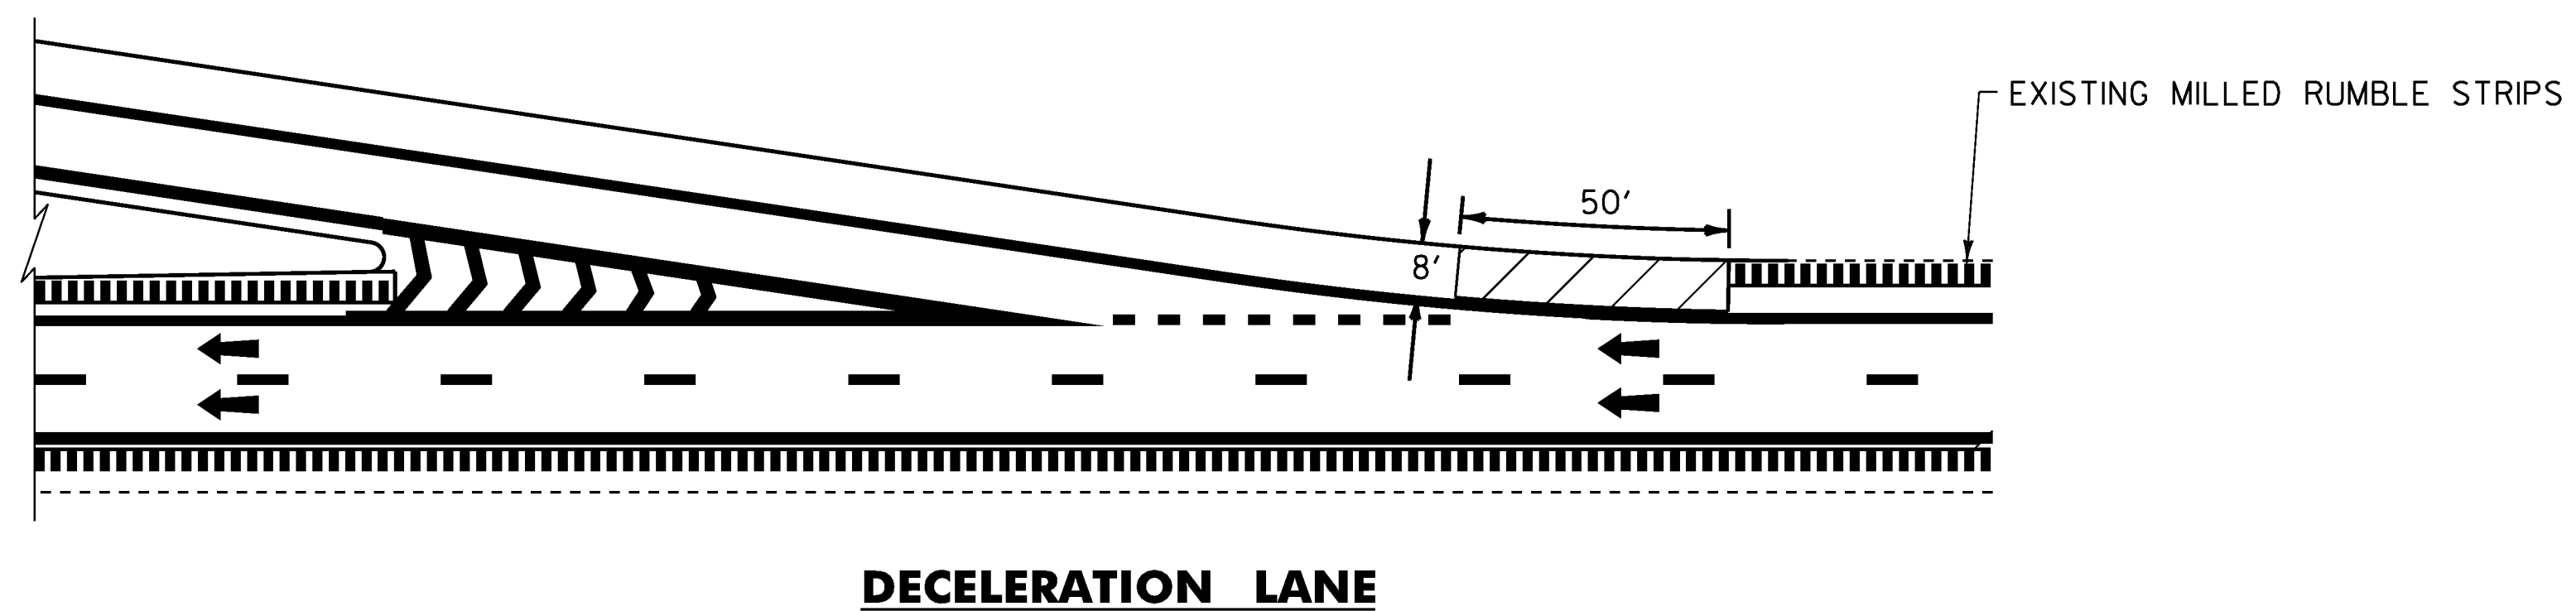

### LEGEND

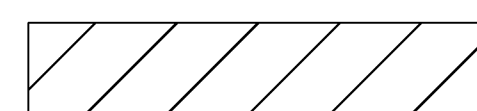

AREA TO BE COLD PLANED



DIRECTION OF TRAFFIC FLOW



EXISTING MILLED RUMBLE STRIPS

PROJECT NAME: NORWICH - FAIRLEE	
PROJECT NUMBER: IM SURF(48)	
FILE NAME: I4a144 Norwich-Fairlee.dgn	PLOT DATE: 15-DEC-2014
PROJECT LEADER: J. HARRINGTON	DRAWN BY: N. PAPPAS
DESIGNED BY: N. PAPPAS	CHECKED BY: J. HARRINGTON
TYPICAL INTERCHANGE CONSTRUCT. DETAIL 2	SHEET 11 OF 22

# QUANTITY SHEET 1

SUMMARY OF ESTIMATED QUANTITIES										TOTALS		DESCRIPTIONS				DETAILED SUMMARY OF QUANTITIES			
						ROADWAY	BRIDGE	FULL C.E. ITEMS	ROADWAY (ALTERNATE A)	ROADWAY (ALTERNATE B)	GRAND TOTAL	FINAL	UNIT	ITEMS	ITEM NUMBER	ROUND	QUANTITIES	UNIT	ITEMS
						62200					62200		LF	SHOULDER BERM REMOVAL	203.40	EST			
						1					1		CY	TRENCH EXCAVATION OF EARTH, EXPLORATORY (N.A.B.I.)	204.22	-			
						100					100		TON	AGGREGATE SHOULDERS, RAP	402.13	-			
						1					1		LU	PRICE ADJUSTMENT, ASPHALT CEMENT (N.A.B.I.)	406.50	-			
						44225					44225		LB	BITUMINOUS CRACK SEALING, "BLOW AND GO" METHOD (AASHTO M 324 (ASTM D 6690) TYPE II)	417.20	EST			
							365				365		LF	BRIDGE EXPANSION JOINT, ASPHALTIC PLUG (@ FINGER PLATE/VERMONT JOINT)	516.10	15			
							305				305		LF	BRIDGE EXPANSION JOINT, ASPHALTIC PLUG	516.10	10			
							100				100		CF	RAPID SETTING CONCRETE REPAIR MATERIAL WITH COARSE AGGREGATE	580.20	EST			
						100					100		HR	POWER BROOM RENTAL, TYPE I	608.30	EST			
						200					200		HR	POWER BROOM RENTAL, TYPE II	608.31	EST			
						200					200		HR	TRUCK RENTAL	608.37	EST			
						200					200		HR	TRUCK-MOUNTED ATTENUATOR	608.45	EST			
						100					100		HR	TRUCK-MOUNTED ATTENUATOR, AWW/PV	608.50	EST			
						600					600		HR	UNIFORMED TRAFFIC OFFICERS	630.10	EST			
						225					225		HR	FLAGGERS	630.15	EST			
								1			1		LS	FIELD OFFICE, ENGINEERS	631.10	-			
								1			1		LS	TESTING EQUIPMENT, BITUMINOUS	631.17	-			
								3000			3000		DL	FIELD OFFICE TELEPHONE (N.A.B.I.)	631.26	-			
						1					1		LS	MOBILIZATION/DEMobilIZATION	635.11	-			
						1					1		LS	TRAFFIC CONTROL	641.10	-			
						7					7		EACH	PORTABLE CHANGEABLE MESSAGE SIGN	641.15	EST			
						127000					127000		LF	DURABLE 6 INCH WHITE LINE, POLYUREA	646.424	-			
						99000					99000		LF	DURABLE 6 INCH YELLOW LINE, POLYUREA	646.434	-			
						2900					2900		LF	DURABLE 12 INCH WHITE LINE, POLYUREA	646.464	-			
														BEGIN OPTION AA					
						100					100		LF	DURABLE 24 INCH STOP BAR, THERMOPLASTIC	646.482	EST			
						100					100		LF	DURABLE 24 INCH STOP BAR, POLYUREA	646.484	EST			
														END OPTION AA					
														BEGIN OPTION BB					
						28					28		EACH	DURABLE LETTER OR SYMBOL, THERMOPLASTIC	646.492	-			
						28					28		EACH	DURABLE LETTER OR SYMBOL, POLYUREA	646.494	-			
														END OPTION BB					
						127000					127000		LF	TEMPORARY 6 INCH WHITE LINE, PAINT	646.622	-			
						99000					99000		LF	TEMPORARY 6 INCH YELLOW LINE, PAINT	646.632	-			
						2900					2900		LF	TEMPORARY 12 INCH WHITE LINE, PAINT	646.662	-			
						100					100		LF	TEMPORARY 24 INCH STOP BAR, PAINT	646.682	EST			
						28					28		EACH	TEMPORARY LETTER OR SYMBOL, PAINT	646.692	-			
						15000					15000		EACH	LINE STRIPING TARGETS	646.76	EST			
						228500					228500		SF	REMOVAL OF EXISTING PAVEMENT MARKINGS	646.85	EST			
						1					1		LU	PRICE ADJUSTMENT, FUEL (N.A.B.I.)	690.50	-			

PROJECT NAME: NORWICH - FAIRLEE  
PROJECT NUMBER: IM SURF(48)

FILE NAME: I4a144 Norwich-Fairlee.dgn PLOT DATE: 15-DEC-2014  
PROJECT LEADER: J. HARRINGTON DRAWN BY: N. PAPPAS  
DESIGNED BY: N. PAPPAS CHECKED BY: J. HARRINGTON  
QUANTITY SHEET 1 SHEET 12 OF 22

# QUANTITY SHEET 2

SUMMARY OF ESTIMATED QUANTITIES						TOTALS		DESCRIPTIONS				DETAILED SUMMARY OF QUANTITIES					
				ROADWAY	BRIDGE	FULL C.E. ITEMS	ROADWAY (ALTERNATE A)	ROADWAY (ALTERNATE B)	GRAND TOTAL	FINAL	UNIT	ITEMS	ITEM NUMBER	ROUND	QUANTITIES	UNIT	ITEMS
				10550					10550		SY	SPECIAL PROVISION (MICRO-MILLING BITUMINOUS CONCRETE PAVEMENT)	900.675	160			SPECIAL PROVISION (MICRO-MILLING BITUMINOUS CONCRETE PAVEMENT)
				150					150		TON	SPECIAL PROVISION (BITUMINOUS CONCRETE PAVEMENT SURFACE PREPARATION, TYPE I)	900.680	EST			422 SY MAINLINE BEGIN AND END PROJECT
												BEGIN ALTERNATE ZA1					662 SY U TURNS
							315500		315500		SY	SPECIAL PROVISION (PAVER PLACED SURFACE TREATMENT, TYPE C)	900.675	1512			1687 SY BRIDGE 48-N AND APPROACHES
												END ALTERNATE ZA1					2177 SY BRIDGE 49-N AND APPROACHES
												BEGIN ALTERNATE ZA2					1898 SY BRIDGE 51-N AND APPROACHES
																	1369 SY BRIDGE 55-N AND APPROACHES
																	1508 SY BRIDGE 56-N AND APPROACHES
																	133 SY EXIT 13 DECEL LANE
																	287 SY EXIT 14 DECEL/ACCEL LANES
																	287 SY EXIT 15 DECEL/ACCEL LANES
																	160 SY ROUNDING
																	10550 SY TOTAL
																	ALTERNATE (ZA1)
																	SPECIAL PROVISION (PAVER PLACED SURFACE TREATMENT, TYPE C)
																	280,210 SY MAINLINE
																	4,294 SY EXIT 13 ON RAMP
																	4,984 SY EXIT 14 OFF RAMP
																	16,164 SY EXIT 14 ON RAMP
																	4,182 SY EXIT 15 OFF RAMP
																	4,154 SY EXIT 15 ON RAMP
																	1512 SY ROUNDING
																	315,500 SY TOTAL
																	ALTERNATE (ZA2)
																	SPECIAL PROVISION (6.3MM POLYMER-MODIFIED BITUMINOUS CONCRETE PAVEMENT)(SBR OR SBS POLYMER)
																	16,339 TONS MAINLINE
																	250 TONS EXIT 13 ON RAMP
																	291 TONS EXIT 14 OFF RAMP
																	943 TONS EXIT 14 ON RAMP
																	244 TONS EXIT 15 OFF RAMP
																	242 TONS EXIT 15 ON RAMP
																	191 TONS ROUNDING
																	18,500 TONS TOTAL


PROJECT NAME: NORWICH - FAIRLEE  
 PROJECT NUMBER: IM SURF(48)  
 FILE NAME: I4a144 Norwich-Fairlee.dgn PLOT DATE: 19-DEC-2014  
 PROJECT LEADER: J. HARRINGTON DRAWN BY: N. PAPPAS  
 DESIGNED BY: N. PAPPAS CHECKED BY: J. HARRINGTON  
 QUANTITY SHEET 2 SHEET 13 OF 22

TEMPORARY 6 INCH WHITE LINE, PAINT  
 MM 74.810 - MM 92.500 (SOLID RT)  
 MM 74.810 - MM 92.500 (DASHED)


DURABLE 6 INCH WHITE LINE, POLYUREA  
 MM 74.810 - MM 92.500 (SOLID RT)  
 MM 74.810 - MM 92.500 (DASHED)

TEMPORARY 6 INCH YELLOW LINE, PAINT  
 MM 74.810 - MM 92.500 (SOLID LT)

DURABLE 6 INCH YELLOW LINE, POLYUREA  
 MM 74.810 - MM 92.500 (SOLID LT)

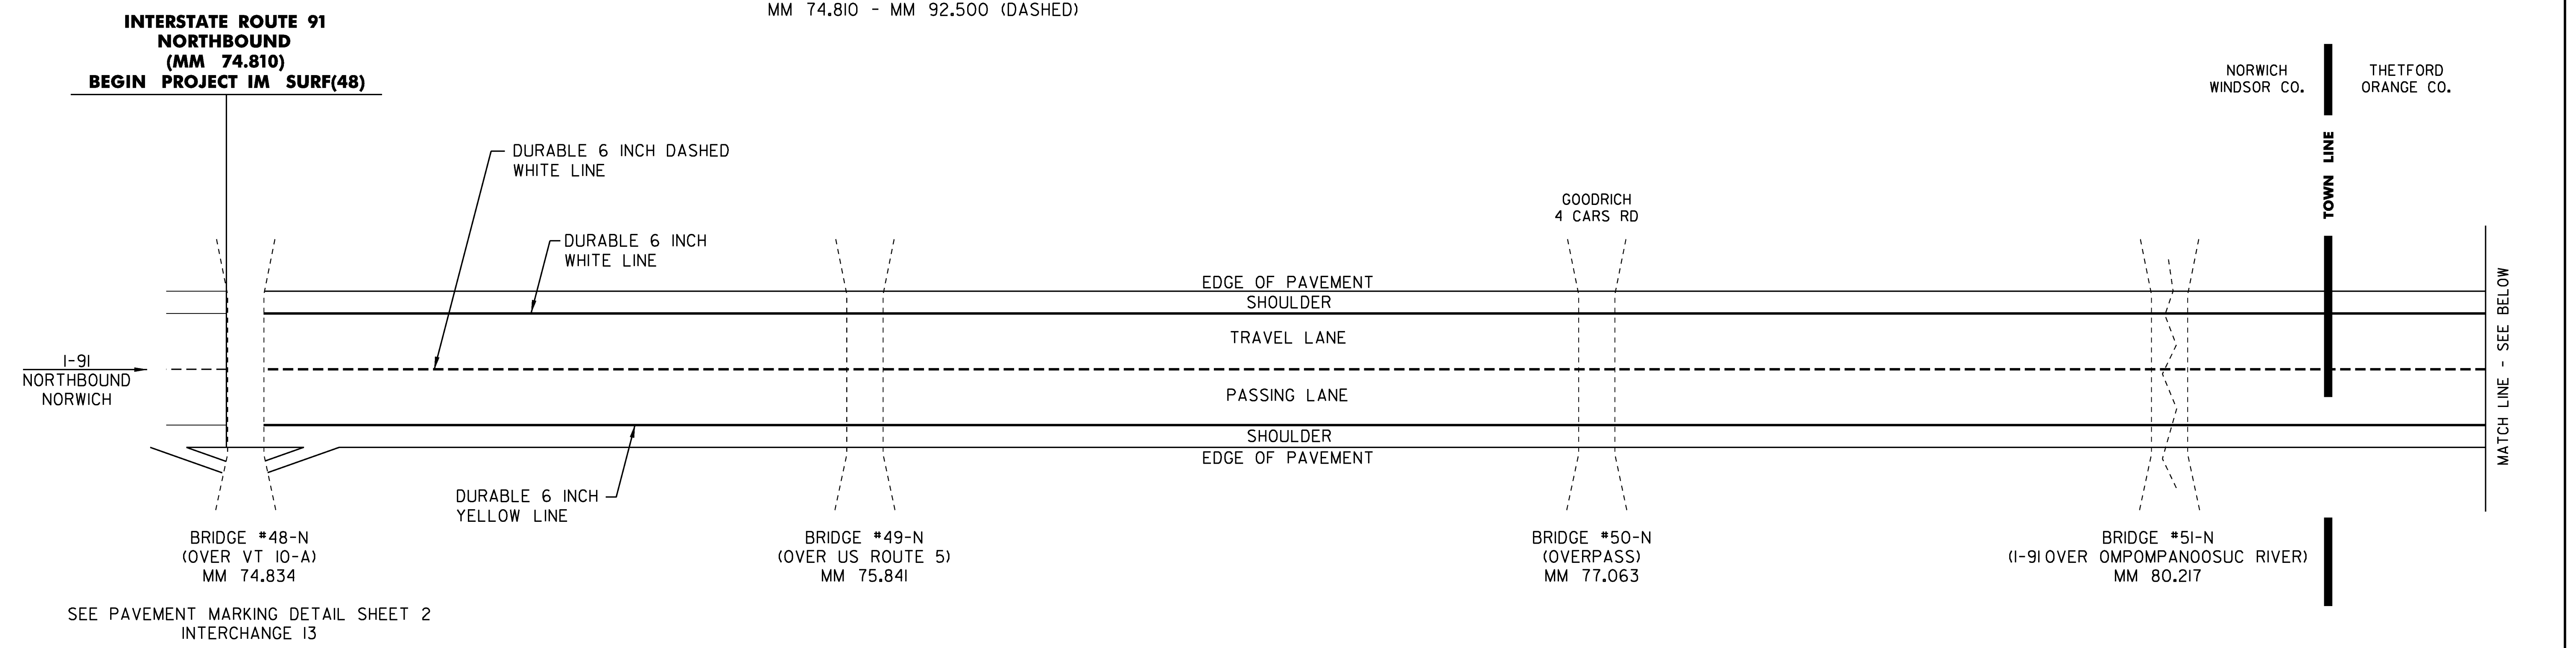

SEE PAVEMENT MARKING DETAIL SHEET 2  
 INTERCHANGE 13

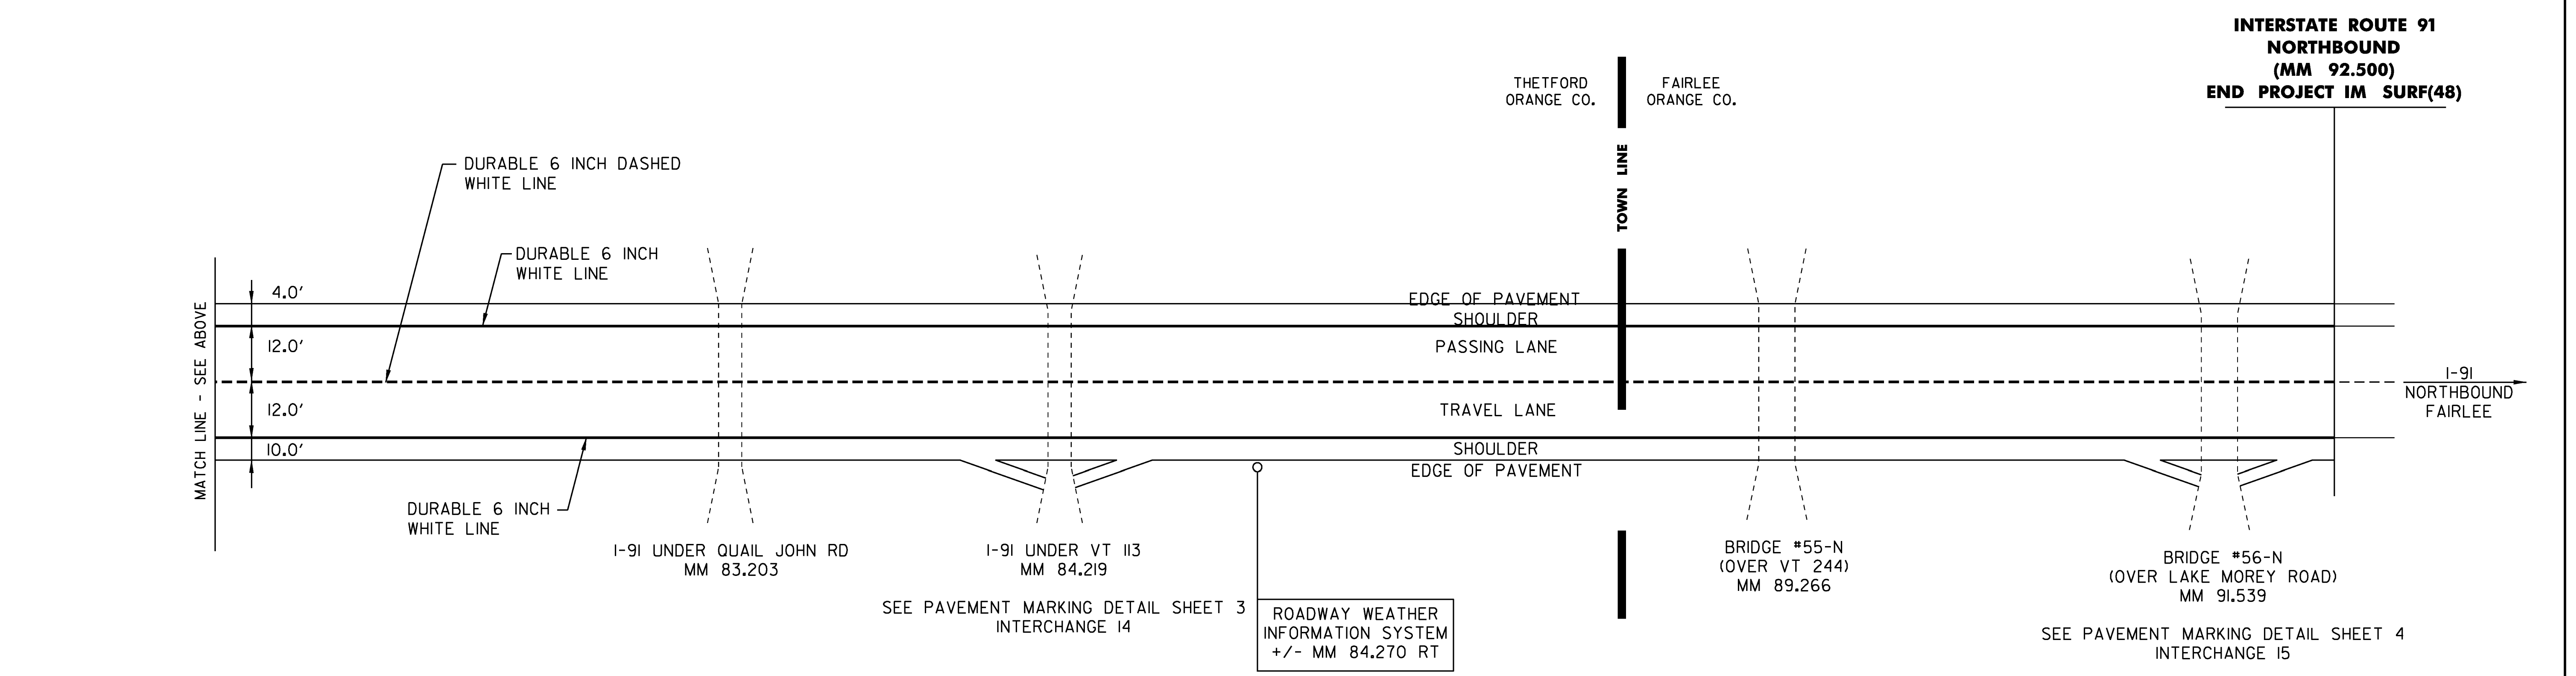

SEE PAVEMENT MARKING DETAIL SHEET 3  
 INTERCHANGE 14

ROADWAY WEATHER  
 INFORMATION SYSTEM  
 +/- MM 84.270 RT

SEE PAVEMENT MARKING DETAIL SHEET 4  
 INTERCHANGE 15

NOT TO SCALE

PROJECT NAME: NORWICH - FAIRLEE	
PROJECT NUMBER: IM SURF(48)	
FILE NAME: I4a144 Norwich-Fairlee.dgn	PLOT DATE: 15-DEC-2014
PROJECT LEADER: J. HARRINGTON	DRAWN BY: N. PAPPAS
DESIGNED BY: N. PAPPAS	CHECKED BY: J. HARRINGTON
PAVEMENT MARKING DETAIL SHEET 1	SHEET 14 OF 22

TEMPORARY 6 INCH YELLOW LINE, PAINT  
 EXIT 13  
 NB ON RAMP STA 0+00 TO 7+90 SOLID LT


DURABLE 6 INCH YELLOW LINE, POLYUREA  
 EXIT 13  
 NB ON RAMP STA 0+00 TO 7+90 SOLID LT

TEMPORARY 6 INCH WHITE LINE, PAINT  
 EXIT 13  
 NB ON RAMP STA 0+00 TO 16+12 SOLID RT  
 NB ON RAMP STA 11+17 TO 16+12 LT DOTTED LANE LINE

DURABLE 6 INCH WHITE LINE, POLYUREA  
 EXIT 13  
 NB ON RAMP STA 0+00 TO 16+12 SOLID RT  
 NB ON RAMP STA 11+17 TO 16+12 LT DOTTED LANE LINE

TEMPORARY 12 INCH WHITE LINE, PAINT  
 EXIT 13  
 NB ON RAMP STA 7+90 TO 11+17 SOLID LT

DURABLE 12 INCH WHITE LINE, POLYUREA  
 EXIT 13  
 NB ON RAMP STA 7+90 TO 11+17 SOLID LT

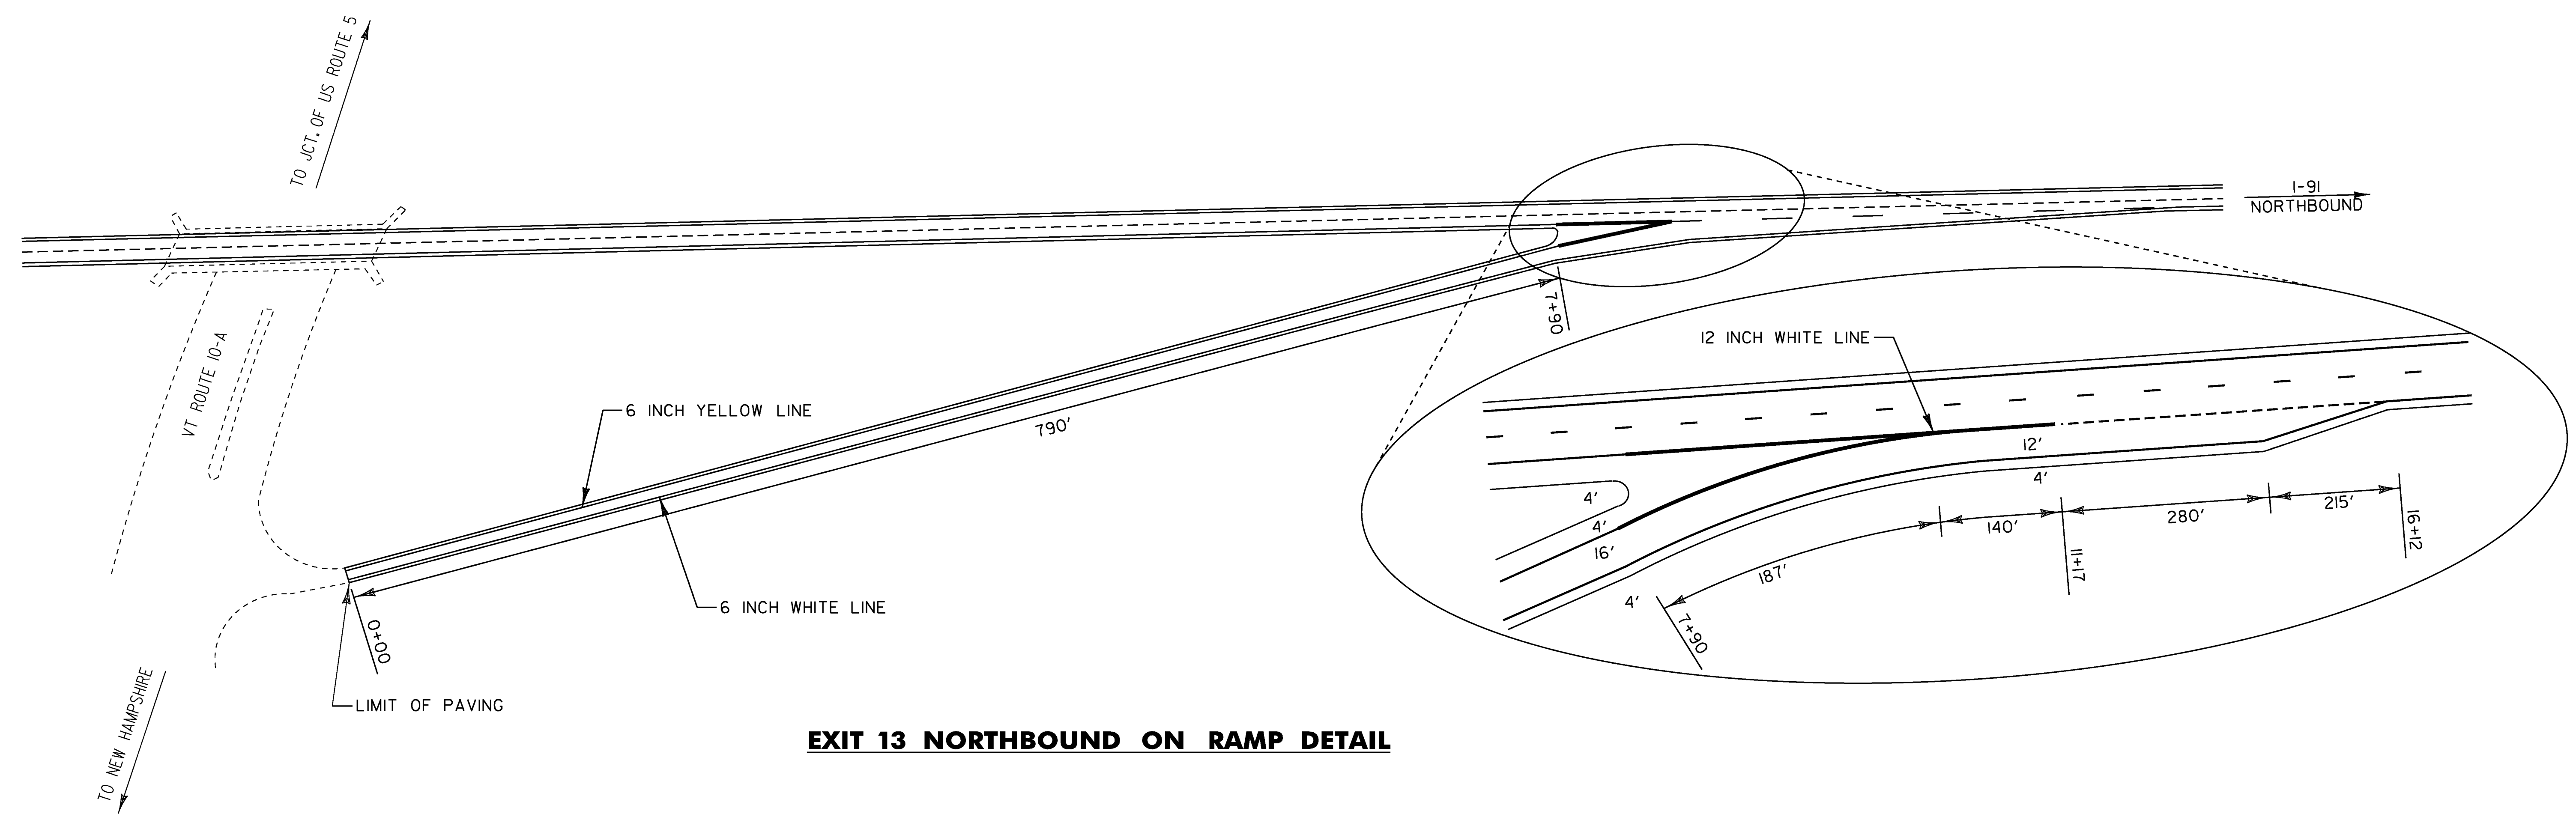

**EXIT 13 NORTHBOUND ON RAMP DETAIL**

NOTE: SEE PAVEMENT MARKING DETAIL SHEET 5 FOR ADDITIONAL MARKING DETAILS

**NOT TO SCALE**

PROJECT NAME: NORWICH - FAIRLEE	PLOT DATE: 15-DEC-2014
PROJECT NUMBER: IM SURF(48)	DRAWN BY: N. PAPPAS
FILE NAME: I4a144 Norwich-Fairlee.dgn	CHECKED BY: J. HARRINGTON
PROJECT LEADER: J. HARRINGTON	SHEET 15 OF 22
DESIGNED BY: N. PAPPAS	
PAVEMENT MARKING DETAIL SHEET 2	

TEMPORARY 6 INCH YELLOW LINE, PAINT  
 EXIT 14  
 NB OFF RAMP STA 9+40 TO 18+70 SOLID LT  
 NB ON RAMP STA 0+00 TO 11+00 SOLID LT  
 DURABLE 6 INCH YELLOW LINE, POLYUREA  
 EXIT 14  
 NB OFF RAMP STA 9+40 TO 18+70 SOLID LT  
 NB ON RAMP STA 0+00 TO 11+00 SOLID LT


TEMPORARY 6 INCH WHITE LINE, PAINT  
 EXIT 14  
 NB OFF RAMP STA 0+00 TO 17+55 LT DOTTED LANE LINE  
 NB OFF RAMP STA 0+00 TO 18+70 SOLID RT  
 NB ON RAMP STA 0+00 TO 19+05 SOLID RT  
 NB ON RAMP STA 11+00 TO 13+30 LT DOTTED LANE LINE  
 DURABLE 6 INCH WHITE LINE, POLYUREA  
 EXIT 14  
 NB OFF RAMP STA 0+00 TO 17+55 LT DOTTED LANE LINE  
 NB OFF RAMP STA 0+00 TO 18+70 SOLID RT  
 NB ON RAMP STA 0+00 TO 19+05 SOLID RT  
 NB ON RAMP STA 11+00 TO 13+30 LT DOTTED LANE LINE

TEMPORARY 12 INCH WHITE LINE, PAINT  
 EXIT 14  
 MAINLINE (GORE STRIPES) SOLID LT  
 NB OFF RAMP STA 7+55 TO 9+40 SOLID LT (GORE)  
 NB ON RAMP STA 11+00 TO 13+30 SOLID LT (GORE)  
 DURABLE 12 INCH WHITE LINE, POLYUREA  
 EXIT 14  
 MAINLINE (GORE STRIPES) SOLID LT  
 NB OFF RAMP STA 7+55 TO 9+40 SOLID LT (GORE)  
 NB ON RAMP STA 11+00 TO 13+30 SOLID LT (GORE)


TEMPORARY LETTER OR SYMBOL, PAINT  
 EXIT 14  
 NB OFF RAMP STA 8+47 "STOP"  
 NB OFF RAMP STA 8+63 "AHEAD"  
 NB OFF RAMP STA 11+42 "STOP"  
 NB OFF RAMP

TEMPORARY 24 INCH STOP BAR, PAINT  
 EXIT 14  
 NB OFF RAMP STA. 11+50  
 DURABLE 24 INCH STOP BAR (OPTION ITEM)  
 EXIT 14  
 NB OFF RAMP STA. 11+50

DURABLE LETTER OR SYMBOL (OPTION ITEM)  
 EXIT 14  
 NB OFF RAMP STA 8+47 "STOP"  
 NB OFF RAMP STA 8+63 "AHEAD"  
 NB OFF RAMP STA 11+42 "STOP"  
 NB OFF RAMP

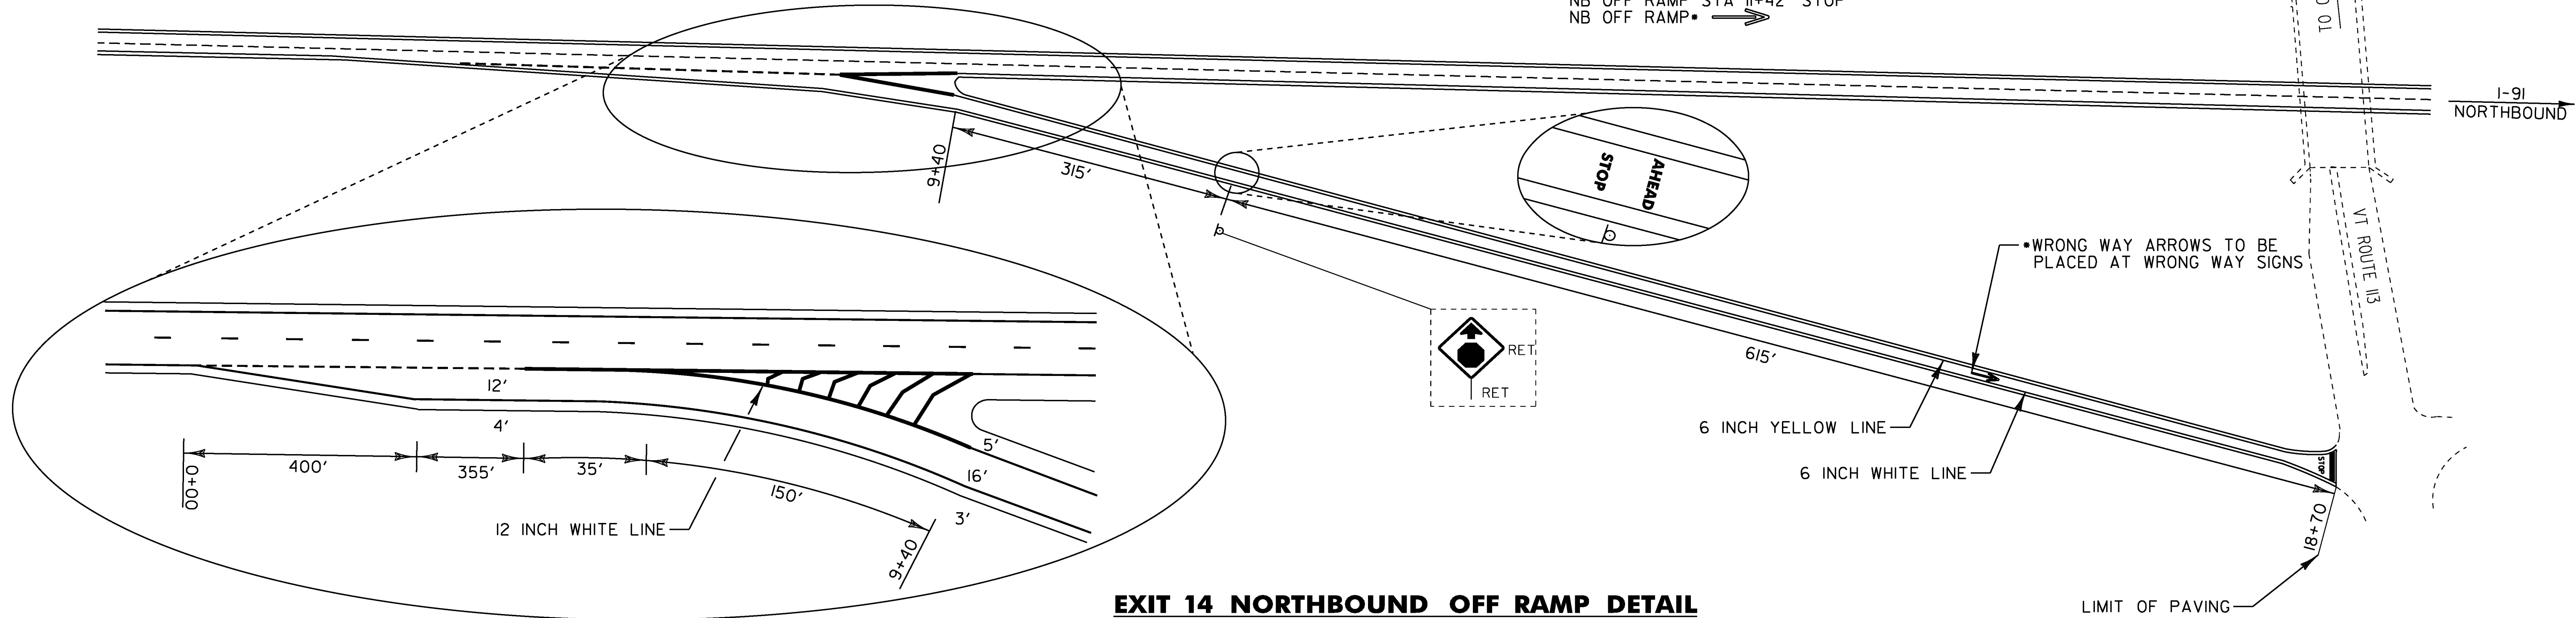

**EXIT 14 NORTHBOUND OFF RAMP DETAIL**

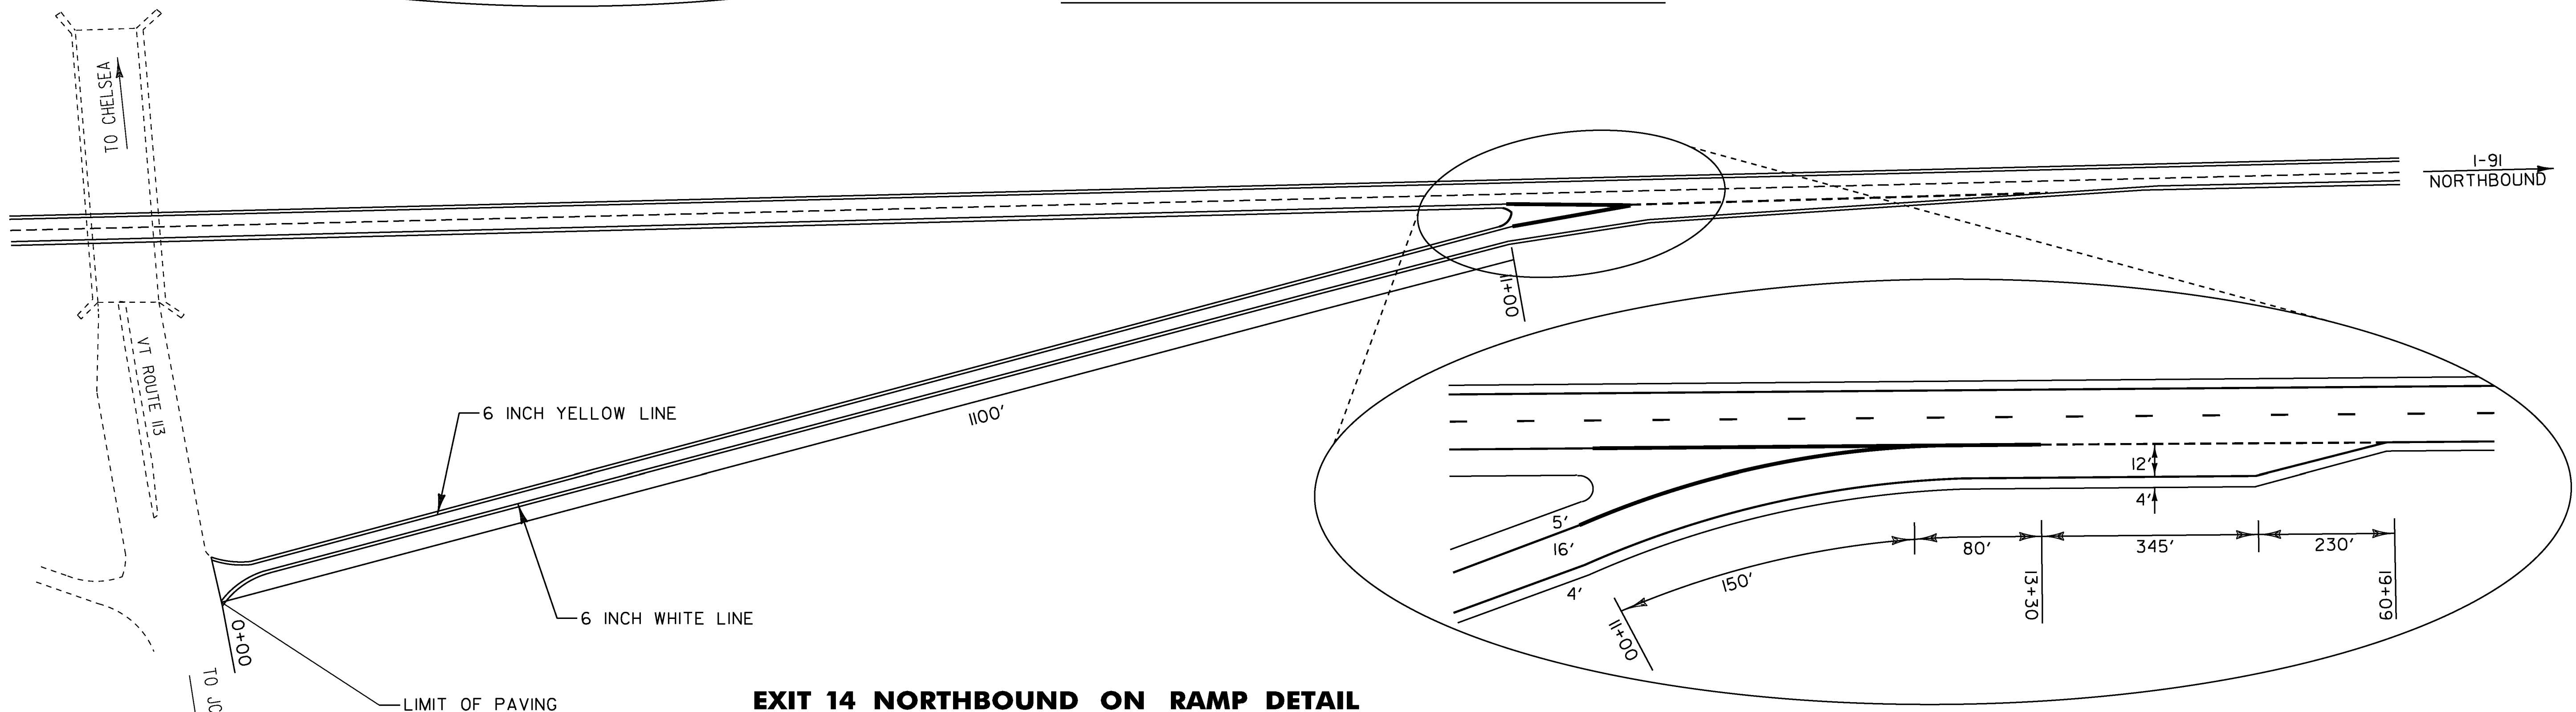

**EXIT 14 NORTHBOUND ON RAMP DETAIL**

NOTE: SEE PAVEMENT MARKING DETAIL SHEET 5 FOR ADDITIONAL MARKING DETAILS

**NOT TO SCALE**

PROJECT NAME: NORWICH - FAIRLEE	PLOT DATE: 19-DEC-2014
PROJECT NUMBER: IM SURF(48)	DRAWN BY: N. PAPPAS
FILE NAME: I4a144 Norwich-Fairlee.dgn	CHECKED BY: J. HARRINGTON
PROJECT LEADER: J. HARRINGTON	PAVEMENT MARKING DETAIL SHEET 3
DESIGNED BY: N. PAPPAS	SHEET 16 OF 22

TEMPORARY 6 INCH YELLOW LINE, PAINT  
 EXIT 15  
 NB OFF RAMP STA 6+75 TO 15+70 SOLID LT  
 NB ON RAMP STA 0+00 TO 15+60 SOLID LT  
 DURABLE 6 INCH YELLOW LINE, POLYUREA  
 EXIT 15  
 NB OFF RAMP STA 6+75 TO 15+70 SOLID LT  
 NB ON RAMP STA 0+00 TO 15+60 SOLID LT


TEMPORARY 6 INCH WHITE LINE, PAINT  
 EXIT 15  
 NB OFF RAMP STA 0+00 TO 4+25 LT DOTTED LANE LINE  
 NB OFF RAMP STA 0+00 TO 15+70 SOLID RT  
 NB ON RAMP STA 0+00 TO 15+60 SOLID RT  
 NB ON RAMP STA 8+95 TO 15+60 RT DOTTED LANE LINE  
 DURABLE 6 INCH WHITE LINE, POLYUREA  
 EXIT 15  
 NB OFF RAMP STA 0+00 TO 4+25 LT DOTTED LANE LINE  
 NB OFF RAMP STA 0+00 TO 15+70 SOLID RT  
 NB ON RAMP STA 0+00 TO 15+60 SOLID RT  
 NB ON RAMP STA 8+95 TO 15+60 RT DOTTED LANE LINE

TEMPORARY 12 INCH WHITE LINE, PAINT  
 EXIT 15  
 MAINLINE (GORE STRIPES) SOLID LT  
 NB OFF RAMP STA 4+65 TO 6+75 SOLID LT  
 NB ON RAMP STA 4+50 TO 8+95 SOLID LT  
 DURABLE 12 INCH WHITE LINE, POLYUREA  
 EXIT 15  
 MAINLINE (GORE STRIPES) SOLID LT  
 NB OFF RAMP STA 4+65 TO 6+75 SOLID LT  
 NB ON RAMP STA 4+50 TO 8+95 SOLID LT


TEMPORARY LETTER OR SYMBOL, PAINT  
 EXIT 15  
 NB OFF RAMP STA 10+42 - "STOP"  
 NB OFF RAMP STA 10+58 - "AHEAD"  
 NB OFF RAMP STA 15+56 - "STOP"  
 NB OFF RAMP\*

TEMPORARY 24 INCH STOP BAR, PAINT  
 EXIT 15  
 NB OFF RAMP STA 15+62  
 DURABLE 24 INCH STOP BAR (OPTION ITEM)  
 EXIT 15  
 NB OFF RAMP STA 15+62

DURABLE LETTER OR SYMBOL (OPTION ITEM)  
 EXIT 15  
 NB OFF RAMP STA 10+42 - "STOP"  
 NB OFF RAMP STA 10+58 - "AHEAD"  
 NB OFF RAMP STA 15+56 - "STOP"  
 NB OFF RAMP\*

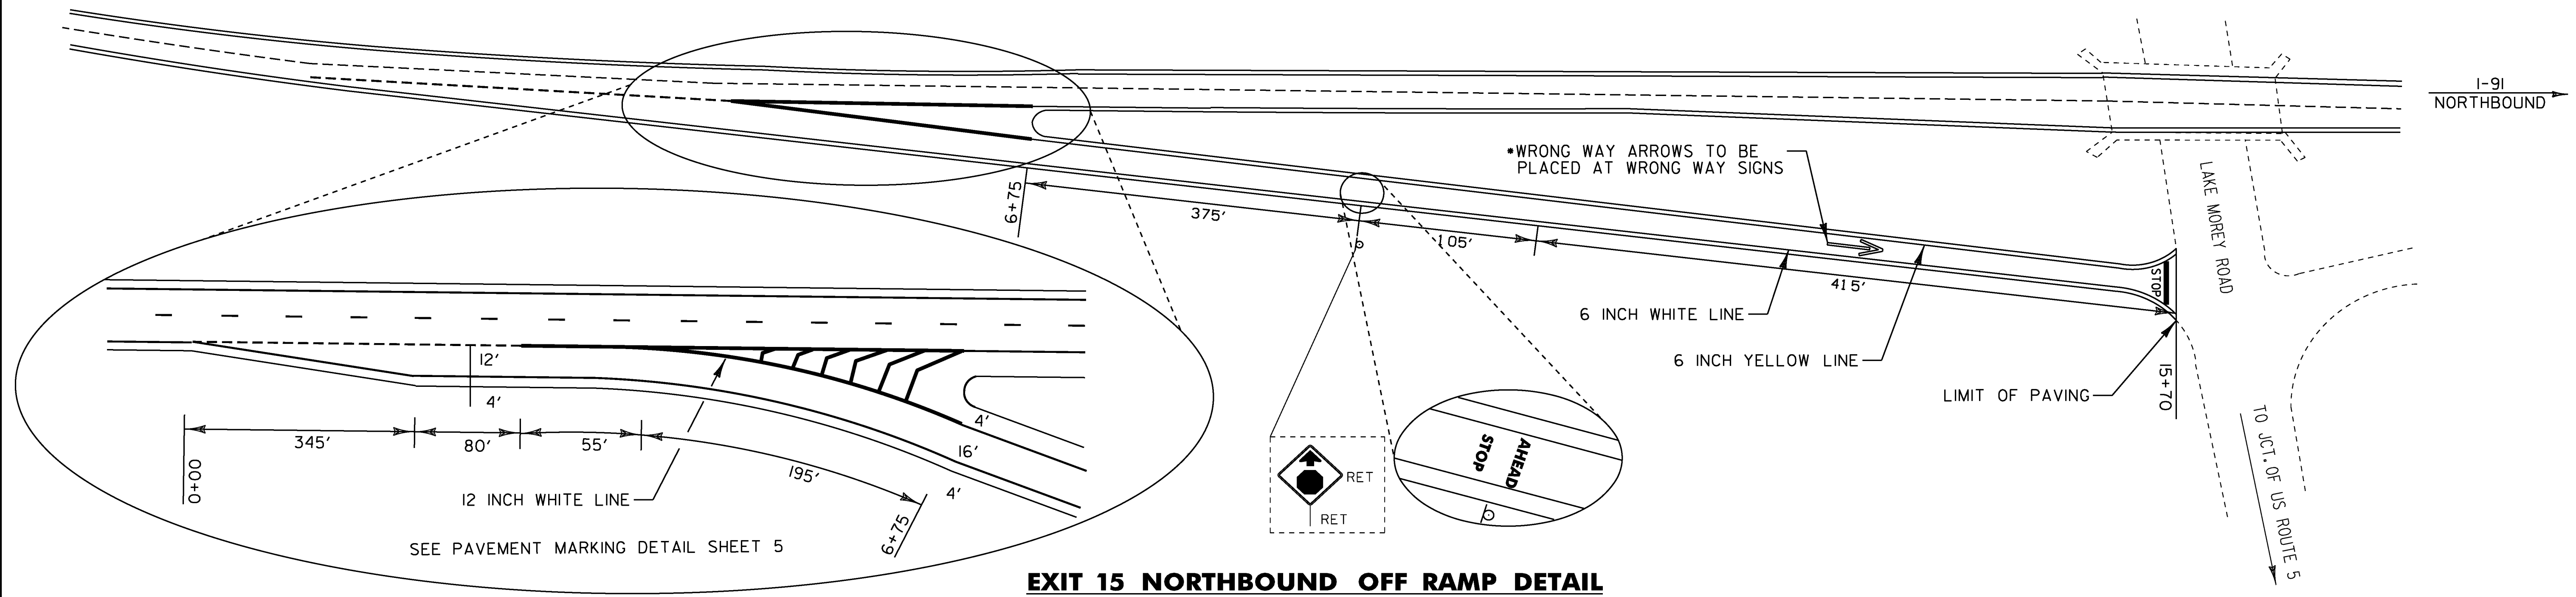

**EXIT 15 NORTHBOUND OFF RAMP DETAIL**

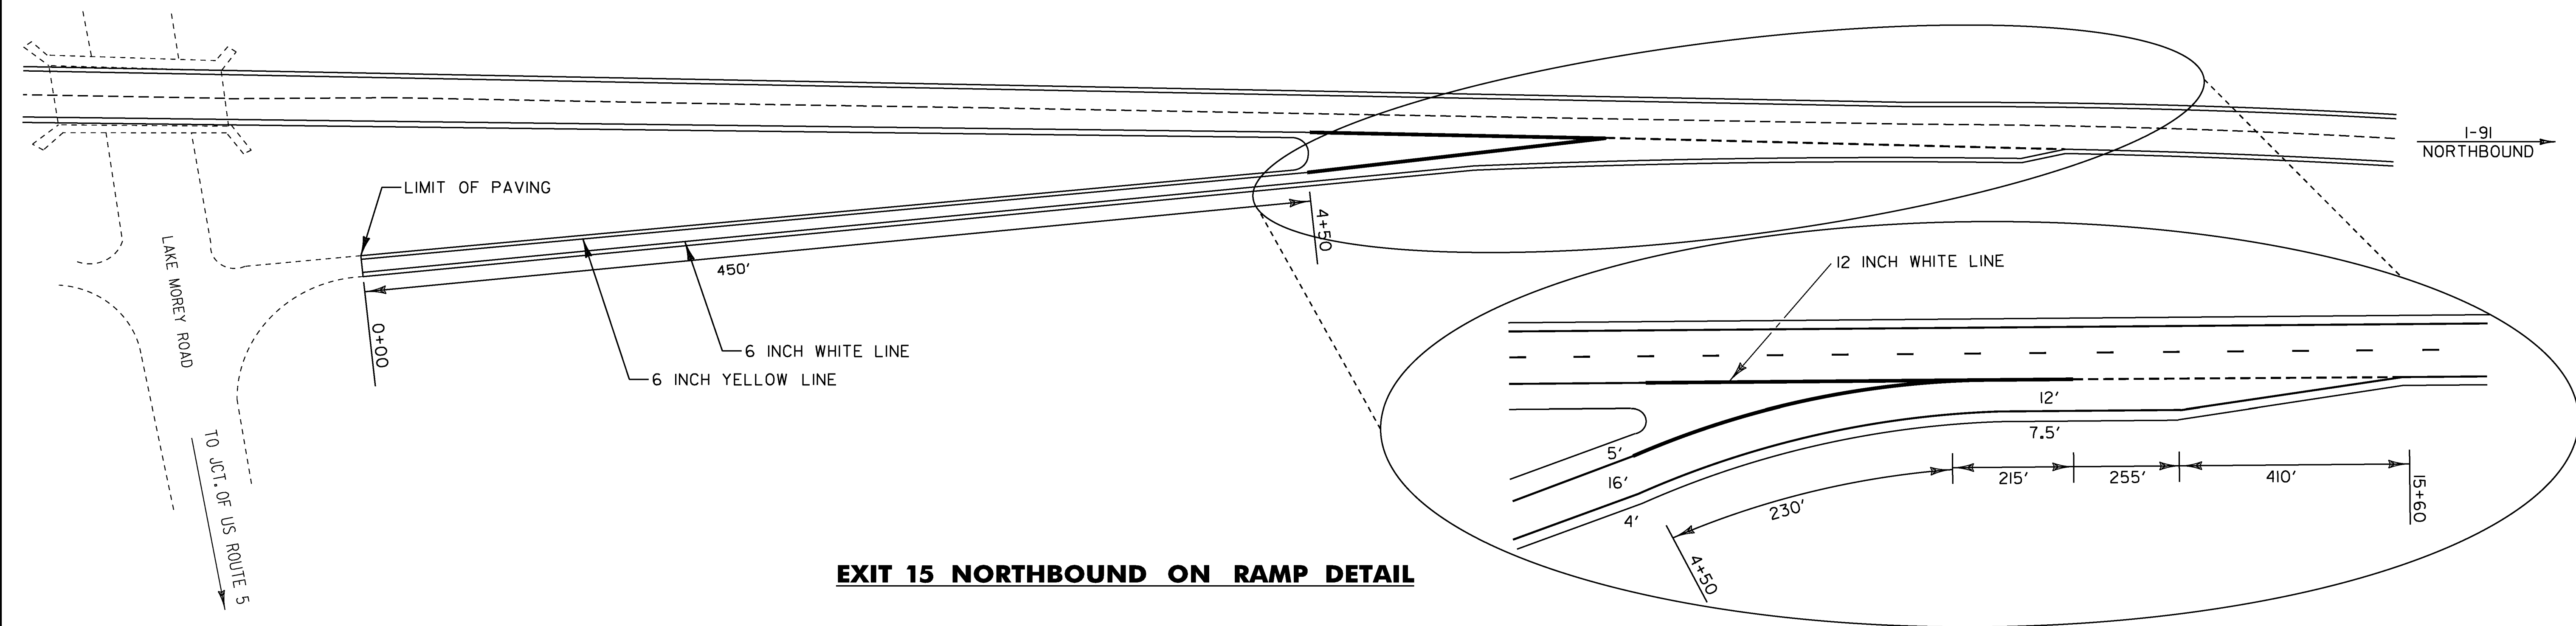


**EXIT 15 NORTHBOUND ON RAMP DETAIL**



NOTE: SEE PAVEMENT MARKING DETAIL SHEET 5 FOR ADDITIONAL MARKING DETAILS

**NOT TO SCALE**




PROJECT NAME: NORWICH - FAIRLEE	PLOT DATE: 19-DEC-2014
PROJECT NUMBER: IM SURF(48)	DRAWN BY: N. PAPPAS
FILE NAME: I4a144 Norwich-Fairlee.dgn	CHECKED BY: J. HARRINGTON
PROJECT LEADER: J. HARRINGTON	SHEET 17 OF 22
DESIGNED BY: N. PAPPAS	
PAVEMENT MARKING DETAIL SHEET 4	

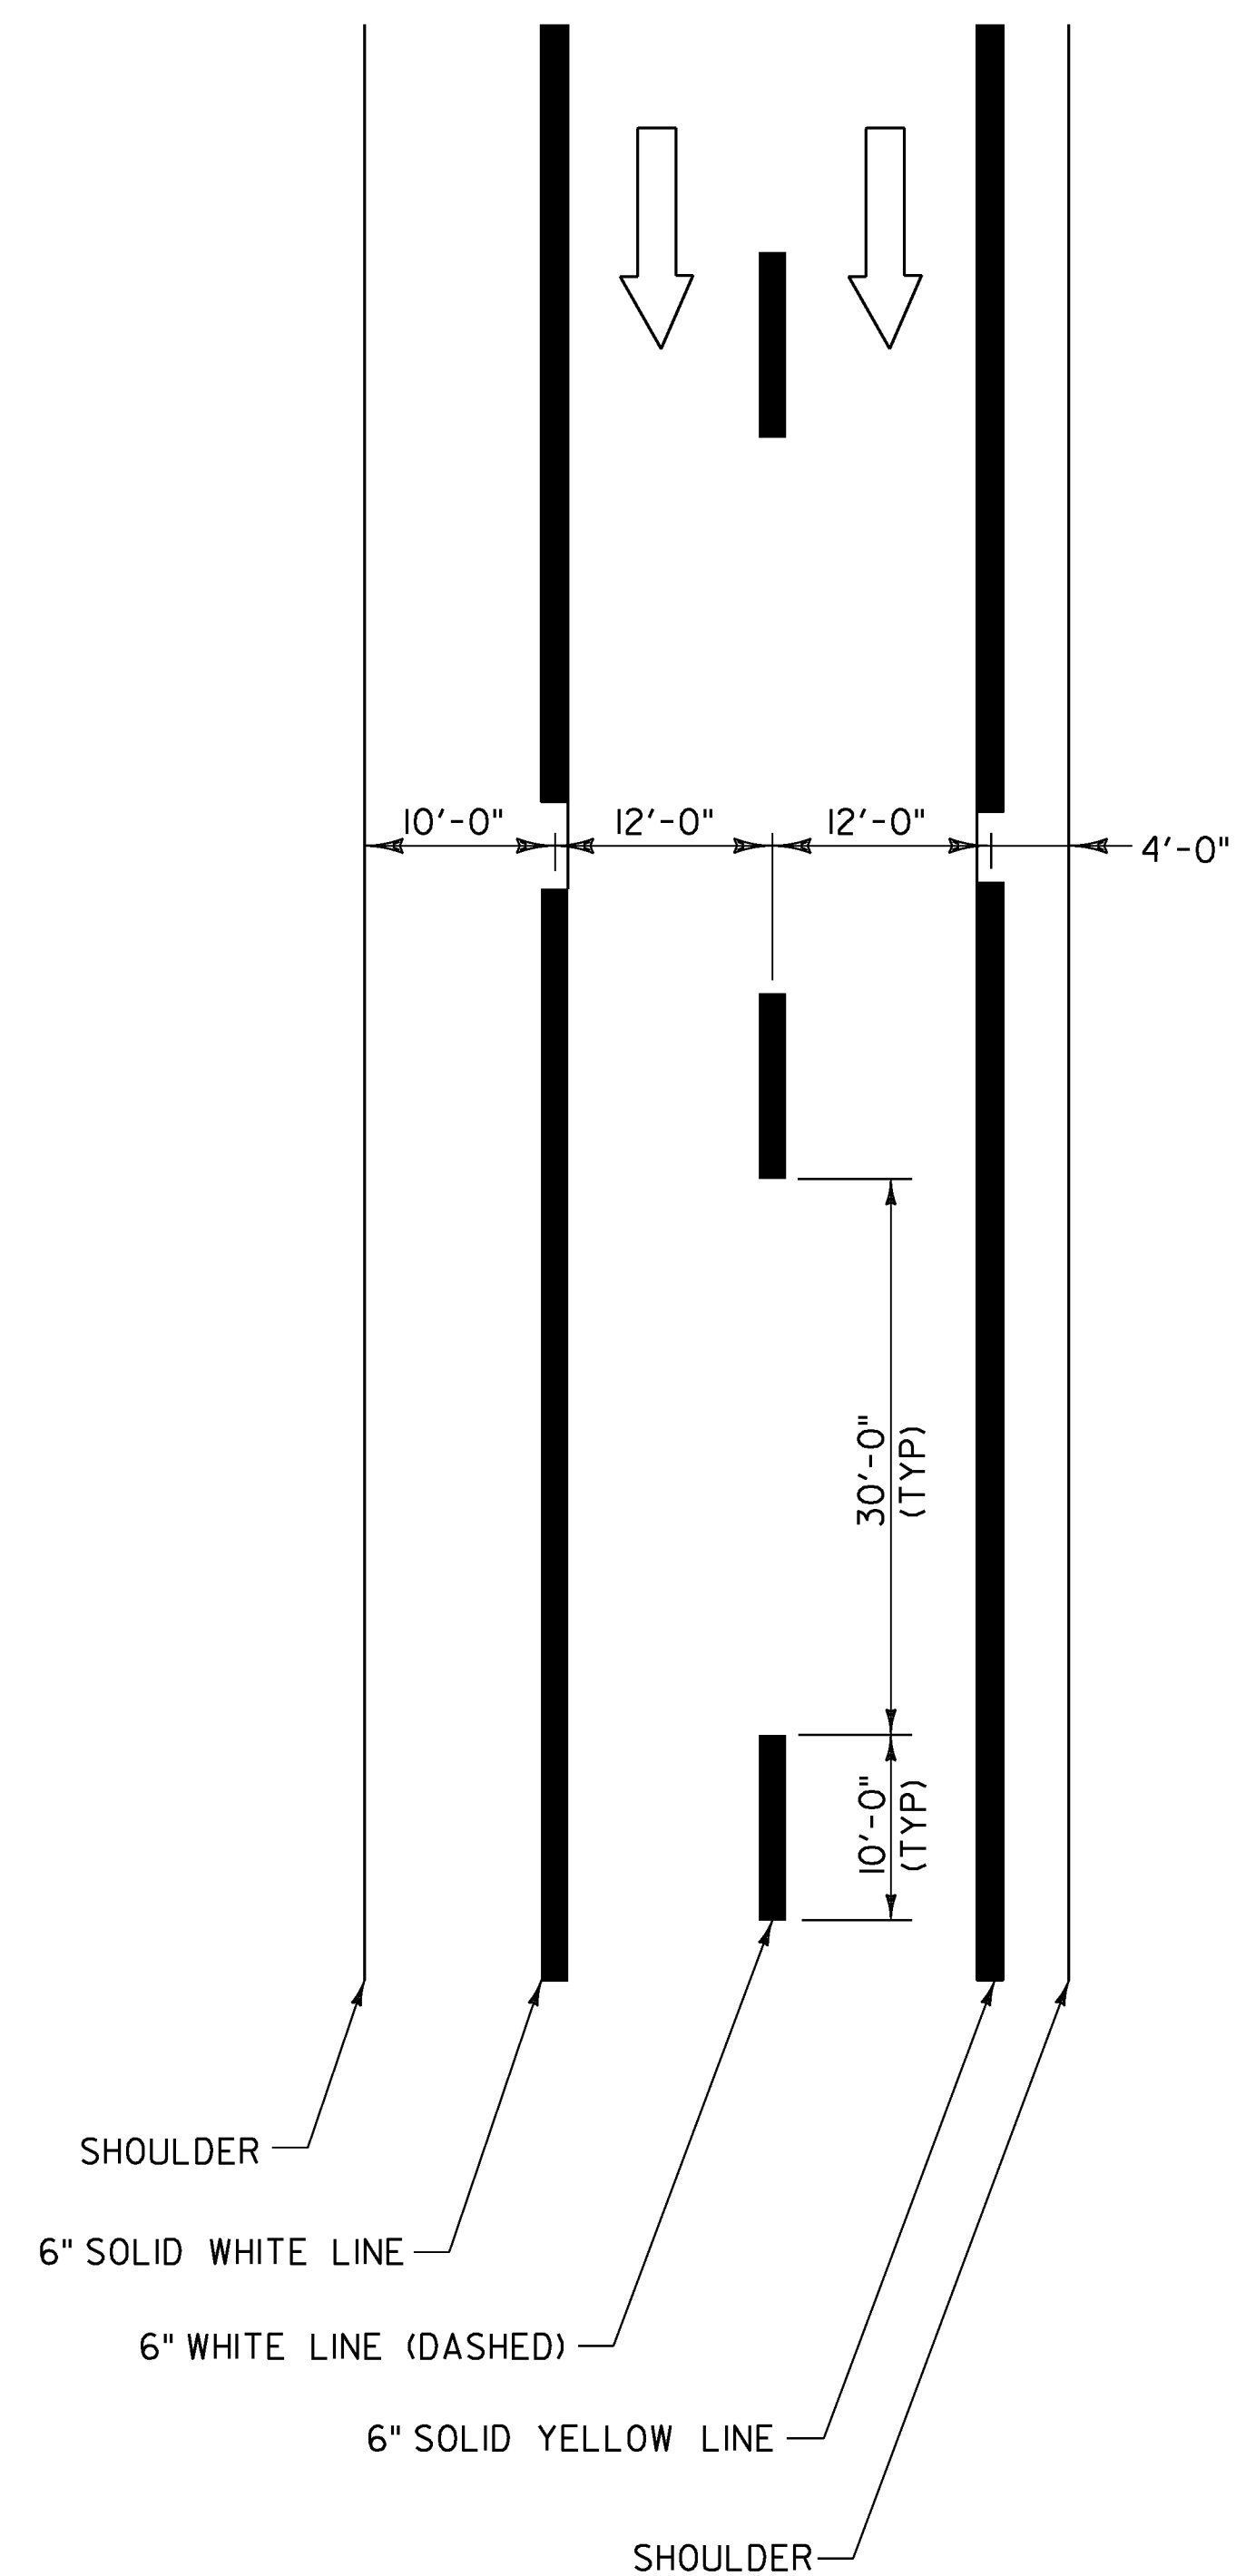

**TYPICAL MAINLINE MARKING PLAN**  
NOT TO SCALE

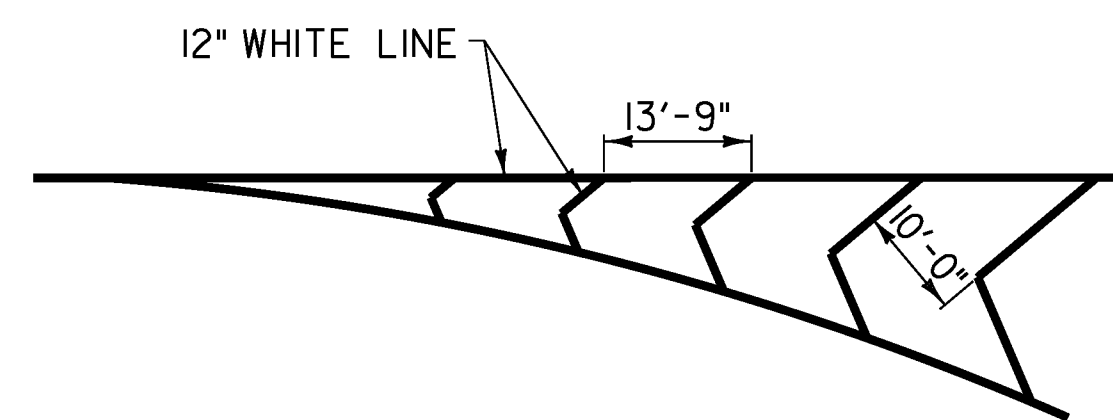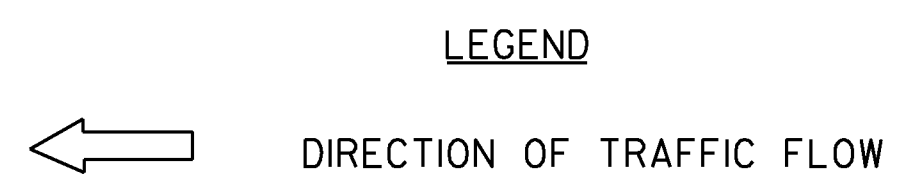


**GORE MARKING DETAIL**  
NOT TO SCALE

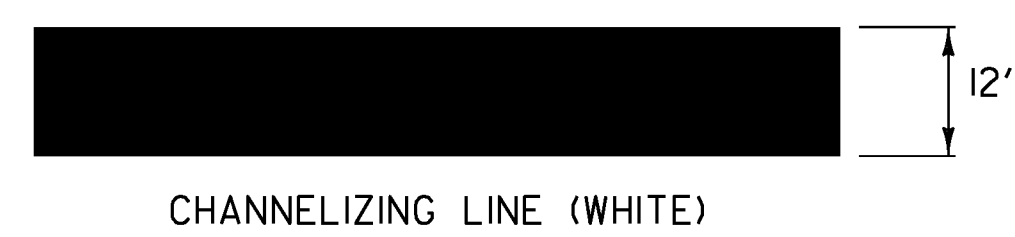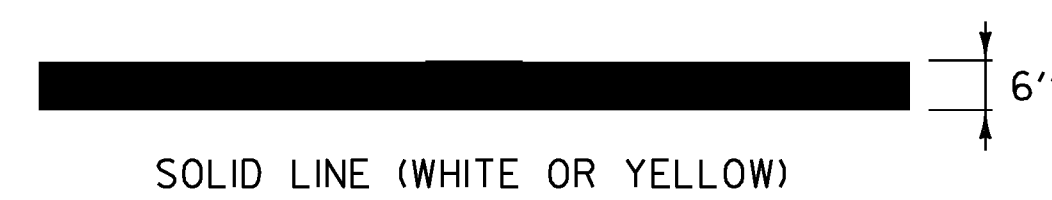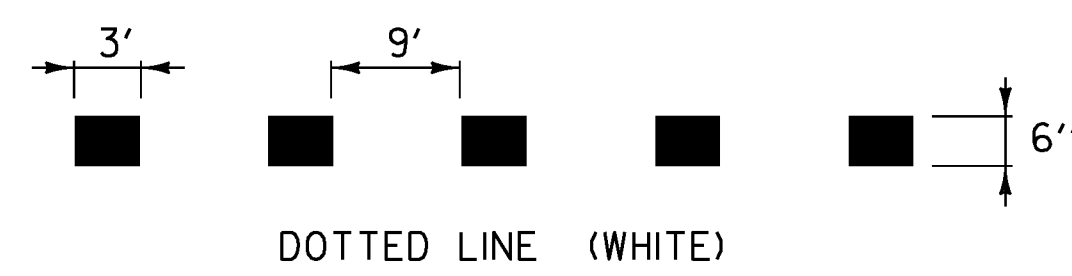

**PAVEMENT MARKING LINE DETAILS**  
NOT TO SCALE




**STOP BAR DETAIL**  
NOT TO SCALE

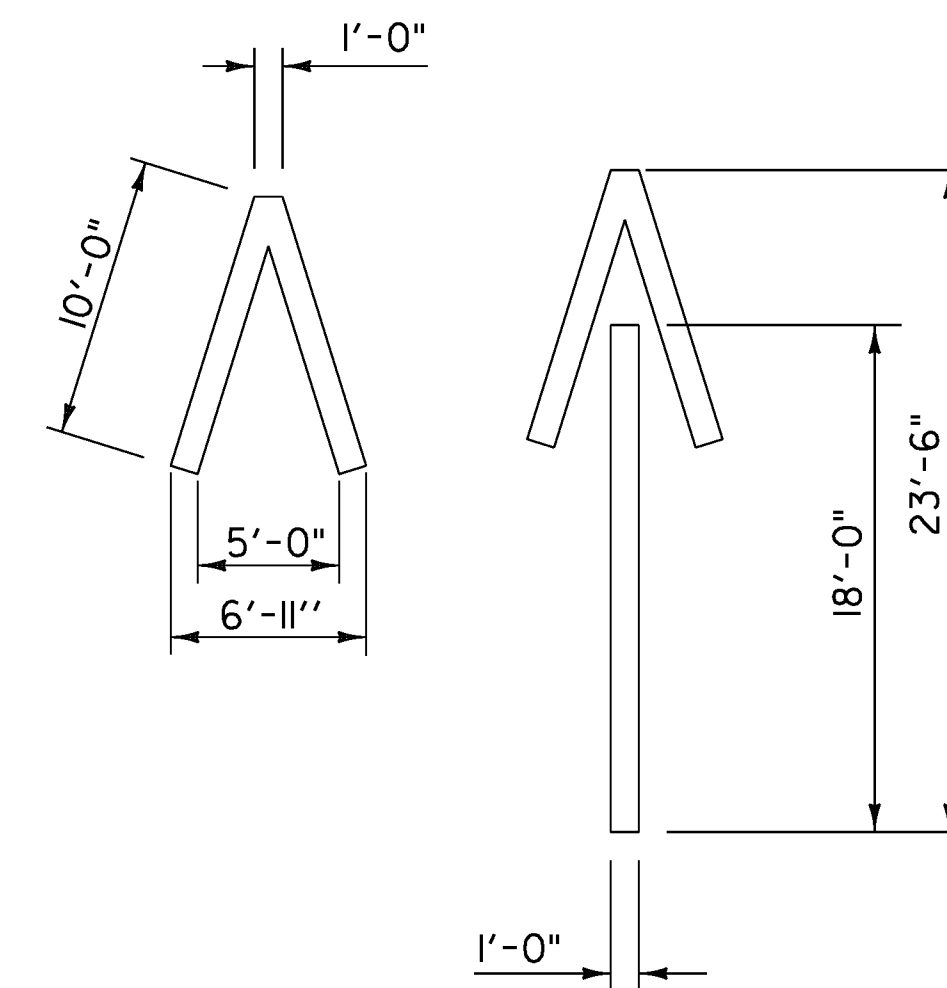

**WRONG WAY ARROW**  
NOT TO SCALE  
MARKINGS TO BE PLACED AT EXISTING WRONG WAY SIGN

**NOT TO SCALE**

PROJECT NAME: NORWICH - FAIRLEE	PLOT DATE: 15-DEC-2014
PROJECT NUMBER: IM SURF(48)	DRAWN BY: N. PAPPAS
FILE NAME: I4a144 Norwich-Fairlee.dgn	CHECKED BY: J. HARRINGTON
PROJECT LEADER: J. HARRINGTON	SHEET 18 OF 22
DESIGNED BY: N. PAPPAS	
PAVEMENT MARKING DETAIL SHEET 5	

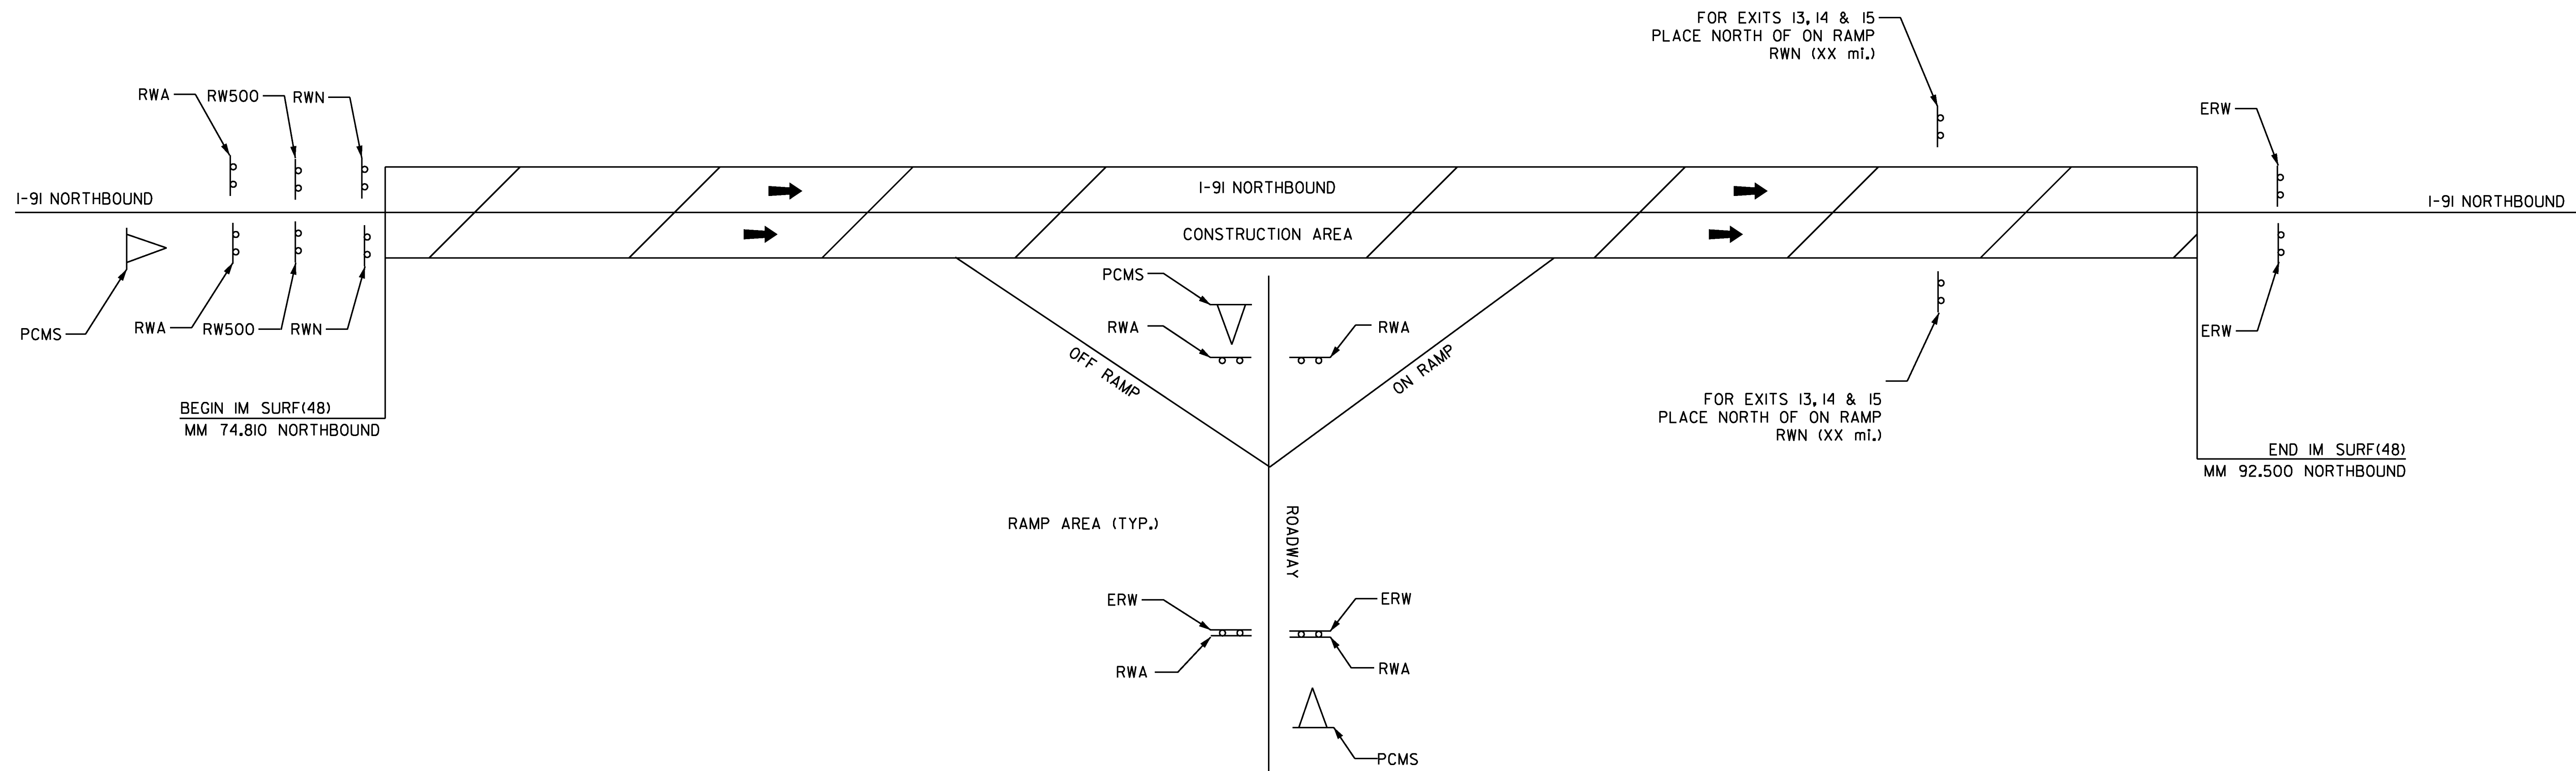

TOWN/STATE HIGHWAY NAME	ROAD WORK AHEAD	END ROAD WORK	ROAD WORK 500'	ROAD WORK NEXT XX MILES	PCMS
I-91 NORTHBOUND					
BEGINNING OF PROJECT	2		2	2	1
EXIT 13 INTERCHANGE	4	2		2	2
EXIT 14 INTERCHANGE	4	2		2	2
EXIT 15 INTERCHANGE	4	2		2	2
END OF PROJECT		2			
TOTAL	14	8	2	8	7

- LEGEND**
- RWA = ROAD WORK AHEAD
  - RW500 = ROAD WORK IN 500 FEET
  - RWN = ROAD WORK NEXT (XX MILES)
  - ERW = END ROAD WORK
  - △ = PORTABLE CHANGEABLE MESSAGE SIGN
  - [Hatched Box] = WORK AREA
  - ➔ = DIRECTION OF TRAFFIC FLOW

PROJECT NAME: NORWICH - FAIRLEE  
 PROJECT NUMBER: IM SURF(48)  
 FILE NAME: I4a144 Norwich-Fairlee.dgn PLOT DATE: 15-DEC-2014  
 PROJECT LEADER: J. HARRINGTON DRAWN BY: N. PAPPAS  
 DESIGNED BY: N. PAPPAS CHECKED BY: J. HARRINGTON  
 CONSTRUCTION APPROACH SIGNING SHEET 19 OF 22

1. THE CONTRACTOR SHALL SUBMIT A SITE SPECIFIC TRAFFIC CONTROL PLAN TO THE ENGINEER FOR APPROVAL PRIOR TO THE START OF CONSTRUCTION. THE COST OF PREPARING THIS PLAN (AND MAKING CHANGES IF NECESSARY) SHALL NOT BE PAID SEPARATELY BUT WILL BE INCLUDED IN THE UNIT PRICE BID FOR ITEM 641.10, "TRAFFIC CONTROL".
2. THE 2009 MUTCD, WITH REVISIONS SHALL BE THE STANDARD FOR ALL TRAFFIC CONTROL DEVICES. EXISTING SIGNS, SIGNALS AND MARKINGS SHALL BE VALID UNTIL SUCH TIME AS THEY ARE REPLACED OR RECONSTRUCTED. WHEN NEW TRAFFIC CONTROL DEVICES ARE ERECTED OR PLACED OR EXISTING TRAFFIC CONTROL DEVICES ARE REPLACED OR REPAIRED THE EQUIPMENT, DESIGN, METHOD OF INSTALLATION, PLACEMENT OR REPAIR SHALL CONFORM WITH THE MUTCD.
3. ADDITIONAL RAMP SIGNING MAY BE REQUIRED AS DIRECTED BY THE ENGINEER.
4. THE BID PRICE FOR "TRAFFIC CONTROL", ITEM 641.10, SHALL INCLUDE ALL APPROACH AND ON-PROJECT CONSTRUCTION SIGNING, PORTABLE ARROW BOARDS, BARRIERS, BARRELS, CONES, BARRICADES, TEMPORARY REGULATORY AND WARNING SIGNS, AND POSTS AS DETAILED IN VAOT STANDARDS. ALL ADJUSTING, RELOCATING, AND REMOVING OF THESE DEVICES AS DIRECTED BY THE ENGINEER SHALL ALSO BE INCLUDED. THE FOLLOWING ITEMS WILL BE PAID FOR SEPARATELY:
  - 630.10 AND 630.15 - UNIFORMED TRAFFIC OFFICERS AND FLAGGERS
  - 646.622 TEMPORARY 6 INCH WHITE LINE, PAINT
  - 646.632 TEMPORARY 6 INCH YELLOW LINE, PAINT
  - 646.662 TEMPORARY 12 INCH WHITE LINE, PAINT
  - 646.682 TEMPORARY 24 INCH STOP BAR, PAINT
  - 646.692 TEMPORARY LETTER OR SYMBOL, PAINT
  - 646.76 LINE STRIPING TARGETS
5. PORTABLE CHANGEABLE MESSAGE SIGNS (PCMS) SHALL BE PROVIDED FOR USE ALONG THIS PROJECT. THE PLACEMENT OF THESE UNITS AS WELL AS THE MESSAGE WILL BE APPROVED BY THE ENGINEER. THESE SIGNS WILL BE PAID FOR UNDER ITEM 641.15, "PORTABLE CHANGEABLE MESSAGE SIGN".
 


PCMS SHOULD NOT REPLACE ANY OF THE SIGNING DETAILED IN THE MUTCD AND SHOULD NOT BE USED IF STANDARD TRAFFIC CONTROL DEVICES ADEQUATELY PROVIDE THE INFORMATION THE MOTORISTS NEED TO TRAVEL SAFELY.

THE PCMS SHALL CONSIST OF EITHER ONE OR TWO PHASES. TYPICALLY, A PHASE SHALL CONSIST OF UP TO THREE LINES OF EIGHT CHARACTERS PER LINE. THE PCMS SHOULD BE USED AS A SUPPLEMENT AND NOT AS A SUBSTITUTE FOR CONVENTIONAL SIGNS AND PAVEMENT MARKINGS.

THE PCMS SHOULD COMMUNICATE WHAT INFORMATION MOTORISTS NEED TO KNOW. UNNECESSARY INFORMATION SHOULD BE AVOIDED. MESSAGES SHOULD BE UPDATED PERIODICALLY TO DESCRIBE THE WORK ACTIVITY OCCURRING SO THAT THE PCMS CONTINUES TO COMMAND THE ATTENTION OF MOTORISTS.
6. THE CONTRACTOR SHALL INCLUDE A CONSTRUCTION SIGN APPROACH PACKAGE FOR EXPECTED LANE CLOSURES AND WORK ZONE SPEED REDUCTIONS IN COMPLIANCE WITH VAOT STANDARDS. PAYMENT FOR PROVIDING THIS PACKAGE SHALL BE INCIDENTAL TO ITEM 641.10, "TRAFFIC CONTROL". ADD G20-5dP "WORK ZONE" PLAQUE AND R2-6dP "FINES DOUBLED" PLAQUE TO SPEED LIMIT SIGNS (SEE FIG. 6F-3 OF MUTCD). OMIT VR-355 "FINES DOUBLED FOR SPEEDING IN WORK ZONE" SIGN. IF LANE CLOSURES ARE USED THEY SHOULD NOT EXCEED THREE MILES AT ANY GIVEN PERIOD OF TIME. IF LANE CLOSURES REDUCE THE TRAVEL LANE WIDTH TO LESS THAN 12 FEET DMV MUST BE NOTIFIED TO DETOUR WIDE LOAD PERMITTED VEHICLES.
7. NO CONSTRUCTION SIGNS SHALL BE INSTALLED AS TO INTERFERE OR OBSTRUCT THE VIEW OF EXISTING TRAFFIC CONTROL DEVICES, STOPPING SIGHT DISTANCE, AND CORNER SIGHT DISTANCE FROM DRIVES AND INTERSECTING HIGHWAYS.

8. REFER TO VT. STATE STANDARDS, THE SPECIAL PROVISIONS, AND THE MUTCD FOR TEMPORARY TRAFFIC CONTROL SIGN DIMENSIONS AND COLORS.

9. SIGN W4-2 MAY BE REPLACED WITH W9-2:

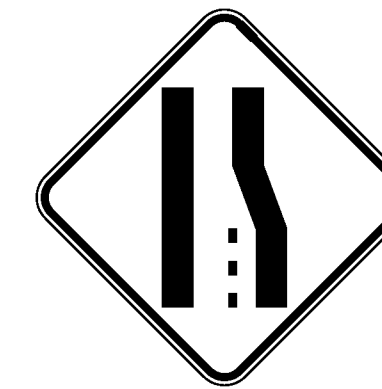

W4-2



W9-2



10. IN ADVANCE OF ANY PROPOSED INTERCHANGE RAMP CLOSURES THE CONTRACTOR SHALL SUBMIT A PLAN THAT WILL DEPICT HOW ADVANCED WARNING TO THE TRAVELING PUBLIC WILL BE ACCOMMODATED DURING THE CLOSURE. ADVANCED WARNING SHALL BE DEFINED AS PROVIDING ADVANCED WARNING SIGNS, BOTH STATIC AND PCMS, THAT PROVIDE INFORMATION FOR MOTORISTS TO SAFELY UTILIZE THE REGIONALLY ACCEPTABLE OPPORTUNITIES FOR SEEKING AN ALTERNATE ROUTE PRIOR TO APPROACHING THE INTERCHANGE INVOLVING RAMP CLOSURES. THE PLAN WILL NEED TO BE SUBMITTED FOR REVIEW AND COMMENT BY THE PROJECT MANAGER A MINIMUM OF 7 CALENDAR DAYS AHEAD OF ANY PLANNED CLOSURE. APPROVAL OF THE PLAN SHALL BE IN PLACE 72 HOURS BEFORE WORK MAY BEGIN.


INSTALLATION OF THE PCMS NETWORK SHALL BE DONE 48 HOURS BEFORE WORK MAY BEGIN. ELEMENTS OF THE PLAN SHALL INCLUDE BUT WILL NOT BE LIMITED TO THE LOCATION OF PCMS AND ASSOCIATED MESSAGES, ANY OTHER NECESSARY SIGNAGE, LOCATIONS FOR DEPLOYMENT OF UNIFORMED TRAFFIC OFFICERS AND FLAGGERS, AND SEQUENCING AND DURATION OF CLOSURE FOR EACH RAMP WITHIN THE RESPECTIVE INTERCHANGE. NO MORE THAN ONE INTERCHANGE PER WORK PERIOD MAY HAVE RAMP CLOSURES. THE COST OF PREPARING THIS PLAN (AND MAKING CHANGES IF NECESSARY) SHALL NOT BE PAID SEPARATELY BUT WILL BE INCLUDED IN THE UNIT PRICE BID FOR ITEM 641.10, TRAFFIC CONTROL.

PROJECT NAME: NORWICH - FAIRLEE	
PROJECT NUMBER: IM SURF(48)	
FILE NAME: I4a144 Norwich-Fairlee.dgn	PLOT DATE: 15-DEC-2014
PROJECT LEADER: J. HARRINGTON	DRAWN BY: N. PAPPAS
DESIGNED BY: N. PAPPAS	CHECKED BY: J. HARRINGTON
CONSTRUCTION APPROACH SIGNING NOTES	SHEET 20 OF 22

### I-91 NB Norwich-Fairlee IM SURF(48) PreCon IRI

Profiled 10/10/14

Travel Lane Avg. IRI = 44.7 Pass Lane Avg. IRI = 58.9

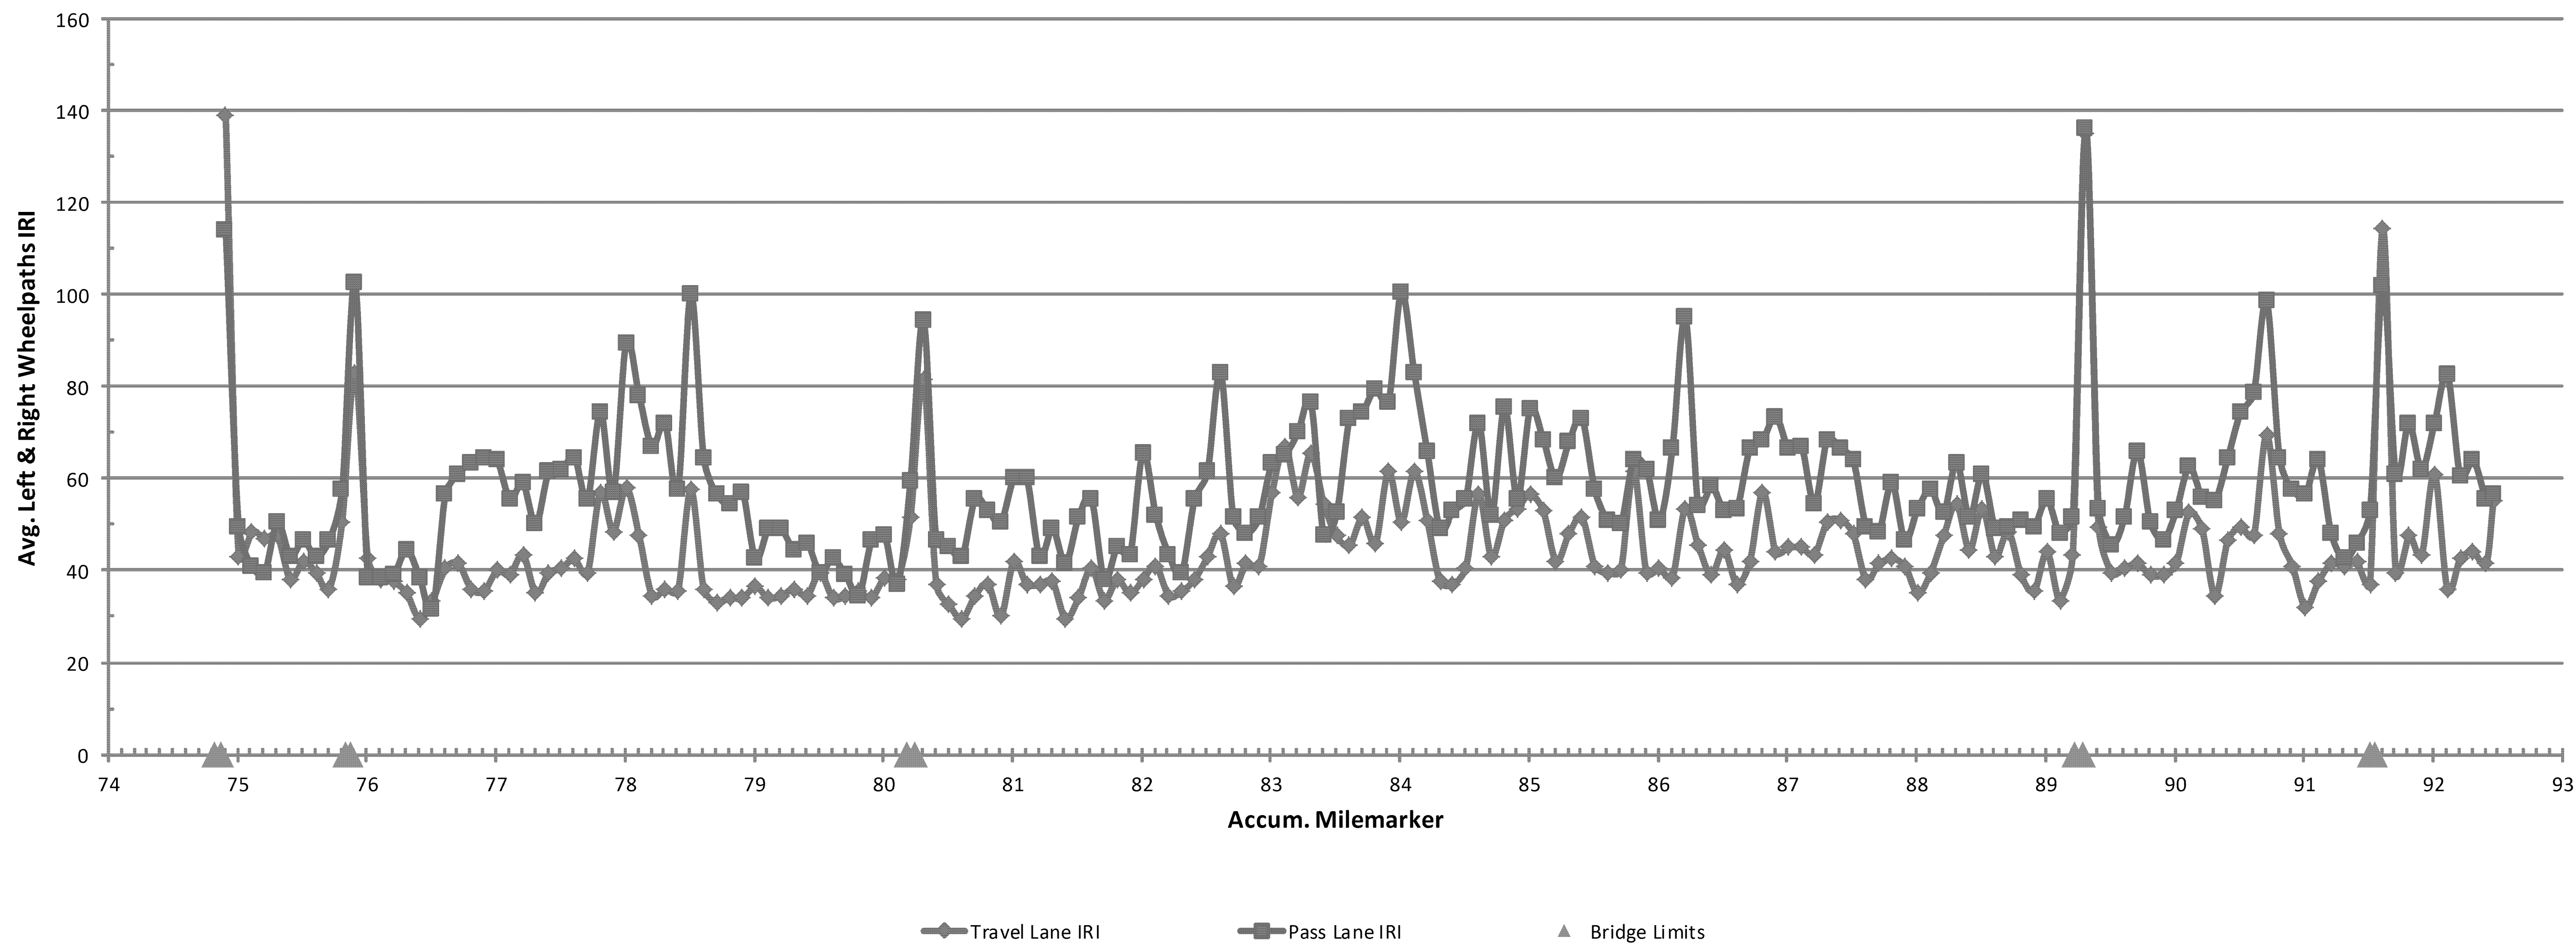


FOR INFORMATIONAL PURPOSES ONLY

PROJECT NAME:	NORWICH - FAIRLEE	PLOT DATE:	15-DEC-2014
PROJECT NUMBER:	IM SURF(48)	DRAWN BY:	N. PAPPAS
FILE NAME:	I4a144 Norwich-Fairlee.dgn	CHECKED BY:	J. HARRINGTON
PROJECT LEADER:	J. HARRINGTON	ROUGHNESS DATA INFORMATION SHEET	SHEET 21 OF 22
DESIGNED BY:	N. PAPPAS		

### I-91 NB Norwich-Fairlee IM SURF(48) PreCon Ruts

Profiled 10/10/2014

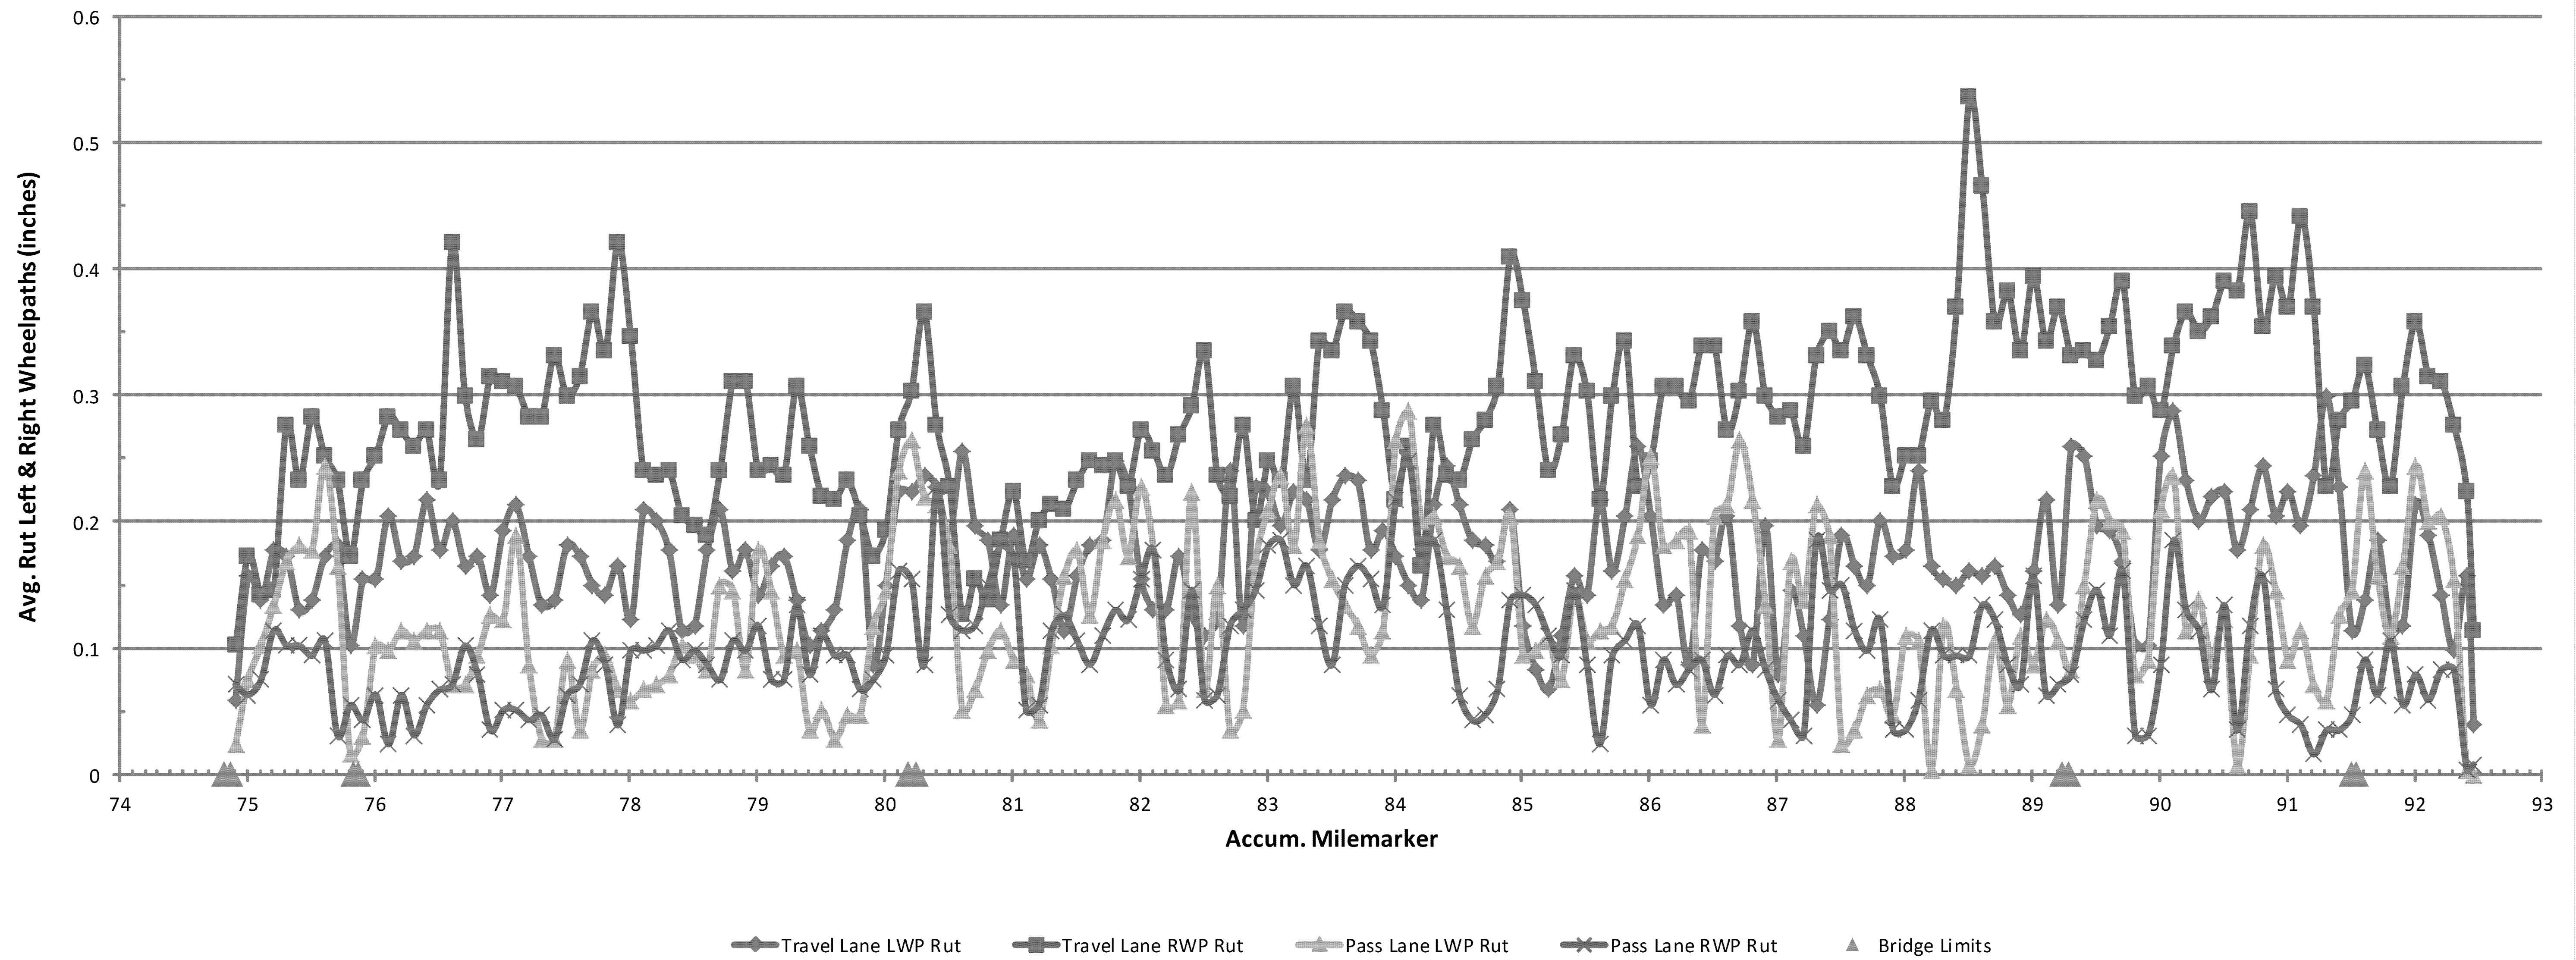

**FOR INFORMATIONAL PURPOSES ONLY**

PROJECT NAME: NORWICH - FAIRLEE	
PROJECT NUMBER: IM SURF(48)	
FILE NAME: I4a144 Norwich-Fairlee.dgn	PLOT DATE: 15-DEC-2014
PROJECT LEADER: J. HARRINGTON	DRAWN BY: N. PAPPAS
DESIGNED BY: N. PAPPAS	CHECKED BY: J. HARRINGTON
RUTTING DATA INFORMATION SHEET	SHEET 22 OF 22