

**INDEX OF SHEETS**

1	TITLE SHEET
2	QUANTITY SHEET
3-6	TYPICAL PAVEMENT MARKINGS SHEETS
7-8	TRAFFIC CONTROL PLAN SHEETS
9	TRAFFIC CONTROL DEVICES
10-16	INTERCHANGE QUANTITIES AND MATERIALS SHEETS
17-21	I-89 MAINLINE TREATMENT SCHEMATICS
22	SHARON REST AREA NORTHBOUND LAYOUT
23	HIGHGATE BORDER STATION SITE LAYOUT
24-29	I-91 MAINLINE TREATMENT SCHEMATICS
30	I-93 AND I-89 MAINLINE TREATMENT SCHEMATIC
31	US 4 DIVIDED HIGHWAY MAINLINE TREATMENT SCHEMATIC
32	MESSAGES FOR PCMS
33	MESSAGES FOR ADVANCED WARNING VEHICLES AND PROTECTION VEHICLES

**STANDARD DRAWINGS**

T-1	08-06-12
T-23	08-06-12
T-28	08-06-12


**PROJECT LOCATIONS:**

- I-91 FROM MM 0.00 TO MM 177.432
- I-89 FROM MM 0.00 TO MM 130.256
- I-93 FROM MM 0.00 TO MM 11.100
- I-89 FROM MM 0.00 TO MM 1.490
- US-4 DIVIDED HIGHWAY FROM MM 0.00 TO MM 18.82  
(NEW YORK STATE LINE TO JCT US-7)

# STATE OF VERMONT AGENCY OF TRANSPORTATION



## PROPOSED IMPROVEMENT STATEWIDE INTERSTATE MARKING

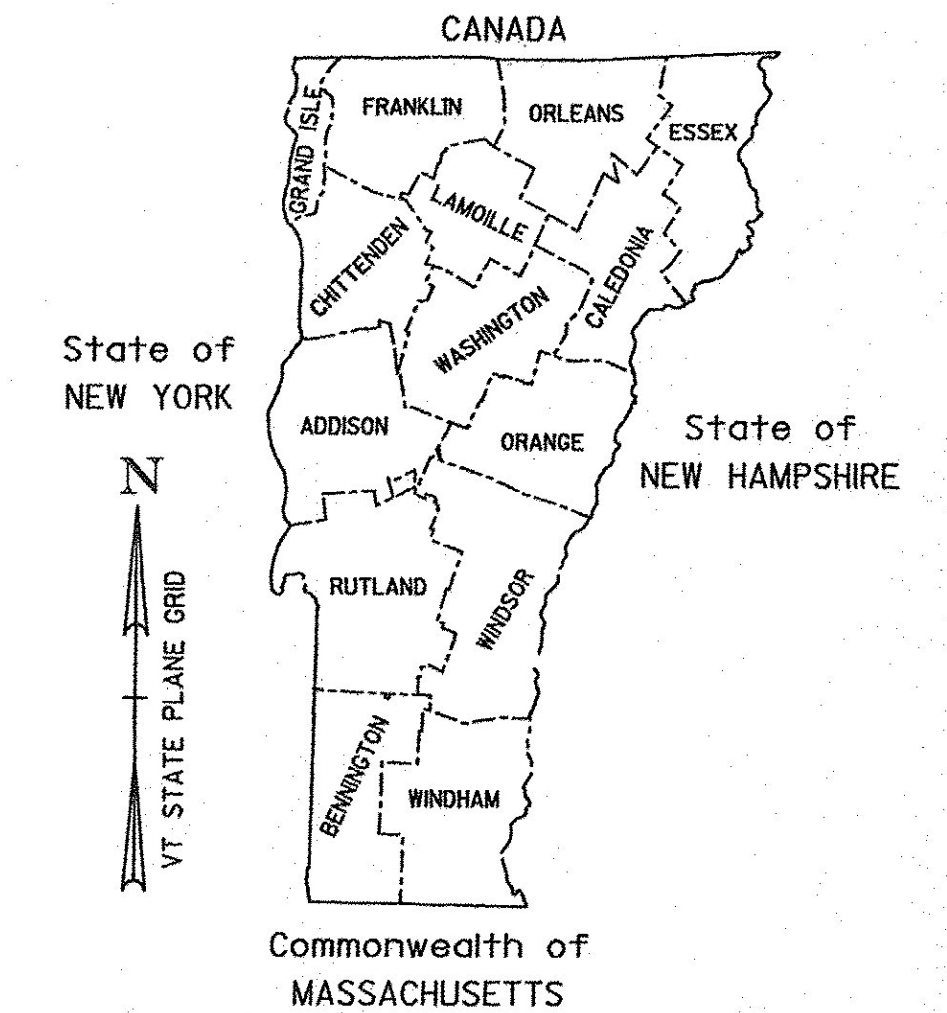

LENGTH OF PROJECT: 339.098 MILES

**END STATEWIDE IMG MARK(115)**  
MM 130.256 I-89  
CANADA VT  
BORDER LINE

**END STATEWIDE IMG MARK(115)**  
I-91 MM 177.432  
CANADA VT  
BORDER LINE

**BEGIN STATEWIDE IMG MARK(115)**  
I-189 MM 0.00

**END STATEWIDE IMG MARK(115)**  
I-189 MM 1.490

**BEGIN STATEWIDE IMG MARK(115)**  
I-93 MM 0.00  
NEW HAMPSHIRE VT  
STATE LINE

**END STATEWIDE IMG MARK(115)**  
I-93 MM 11.10  
JCT. I-91

**BEGIN STATEWIDE IMG MARK(115)**  
US-4 JCT NY LINE MM 0.00

**END END STATEWIDE IMG MARK(115)**  
JCT US 7 MM 18.82

**BEGIN STATEWIDE IMG MARK(115)**  
I-89 MM 0.00  
NEW HAMPSHIRE / VT  
STATE LINE

**BEGIN STATEWIDE IMG MARK(115)**  
I-91 MM 0.000  
MASSACHUSETTS / VT  
STATE LINE

**PROJECT DESCRIPTION**

WORK TO BE PERFORMED UNDER THIS PROJECT INCLUDES NEW PAVEMENT MARKINGS INCLUDING EDGE LINES, LANE LINES, DASHED AND DOTTED ACCELERATION LINES, RAMP EDGE LINES, STOP BARS, LETTERS AND SYMBOLS AND CROSSWALKS

BUILT AS DESIGNED

**RECORD PLANS**

CONTRACTOR: L&D SAFETY MARKINGS CORP. - BERLIN, VT

RESIDENT ENGINEER: JOSH HULETT

CONSTRUCTION BEGAN: MAY 13, 2015

CONSTRUCTION COMPLETE: OCTOBER 20, 2016

RECORD PLANS BY: JOSH HULETT & JESSE IVES

I HEREBY CERTIFY THAT ALL THE CONSTRUCTION REQUIRED BY THIS SET OF DRAWINGS HAS BEEN ACCOMPLISHED AS INDICATED HEREIN.

BY *Josh Hulett* RESIDENT ENGINEER

DATE NOVEMBER 3, 2017

NOTE: Any further information concerning final quantities, amounts or other details relative to this project may be found at Central Files in the electronic archives.

DIRECTOR OF PROJECT DELIVERY

APPROVED *[Signature]* DATE 1/29/2015


PROJECT MANAGER: PATRICIA COBURN, P.E.

PROJECT NAME: STATEWIDE

PROJECT NUMBER: IMG MARK (115)

SHEET 1 OF 33 SHEETS

CONSTRUCTION IS TO BE CARRIED ON IN ACCORDANCE WITH THESE PLANS AND THE STANDARD SPECIFICATIONS FOR CONSTRUCTION DATED 2011, AS APPROVED BY THE FEDERAL HIGHWAY ADMINISTRATION ON JULY 20, 2011 FOR USE ON THIS PROJECT, INCLUDING ALL SUBSEQUENT REVISIONS AND SUCH REVISED SPECIFICATIONS AND SPECIAL PROVISIONS AS ARE INCORPORATED IN THESE PLANS.

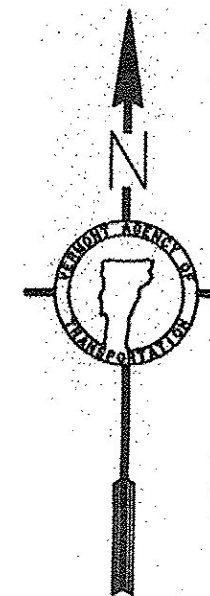

QUALITY ASSURANCE PROGRAM : LEVEL 1

SURVEYED BY : N/A  
SURVEYED DATE : N/A

DATUM

VERTICAL : N/A  
HORIZONTAL : N/A