



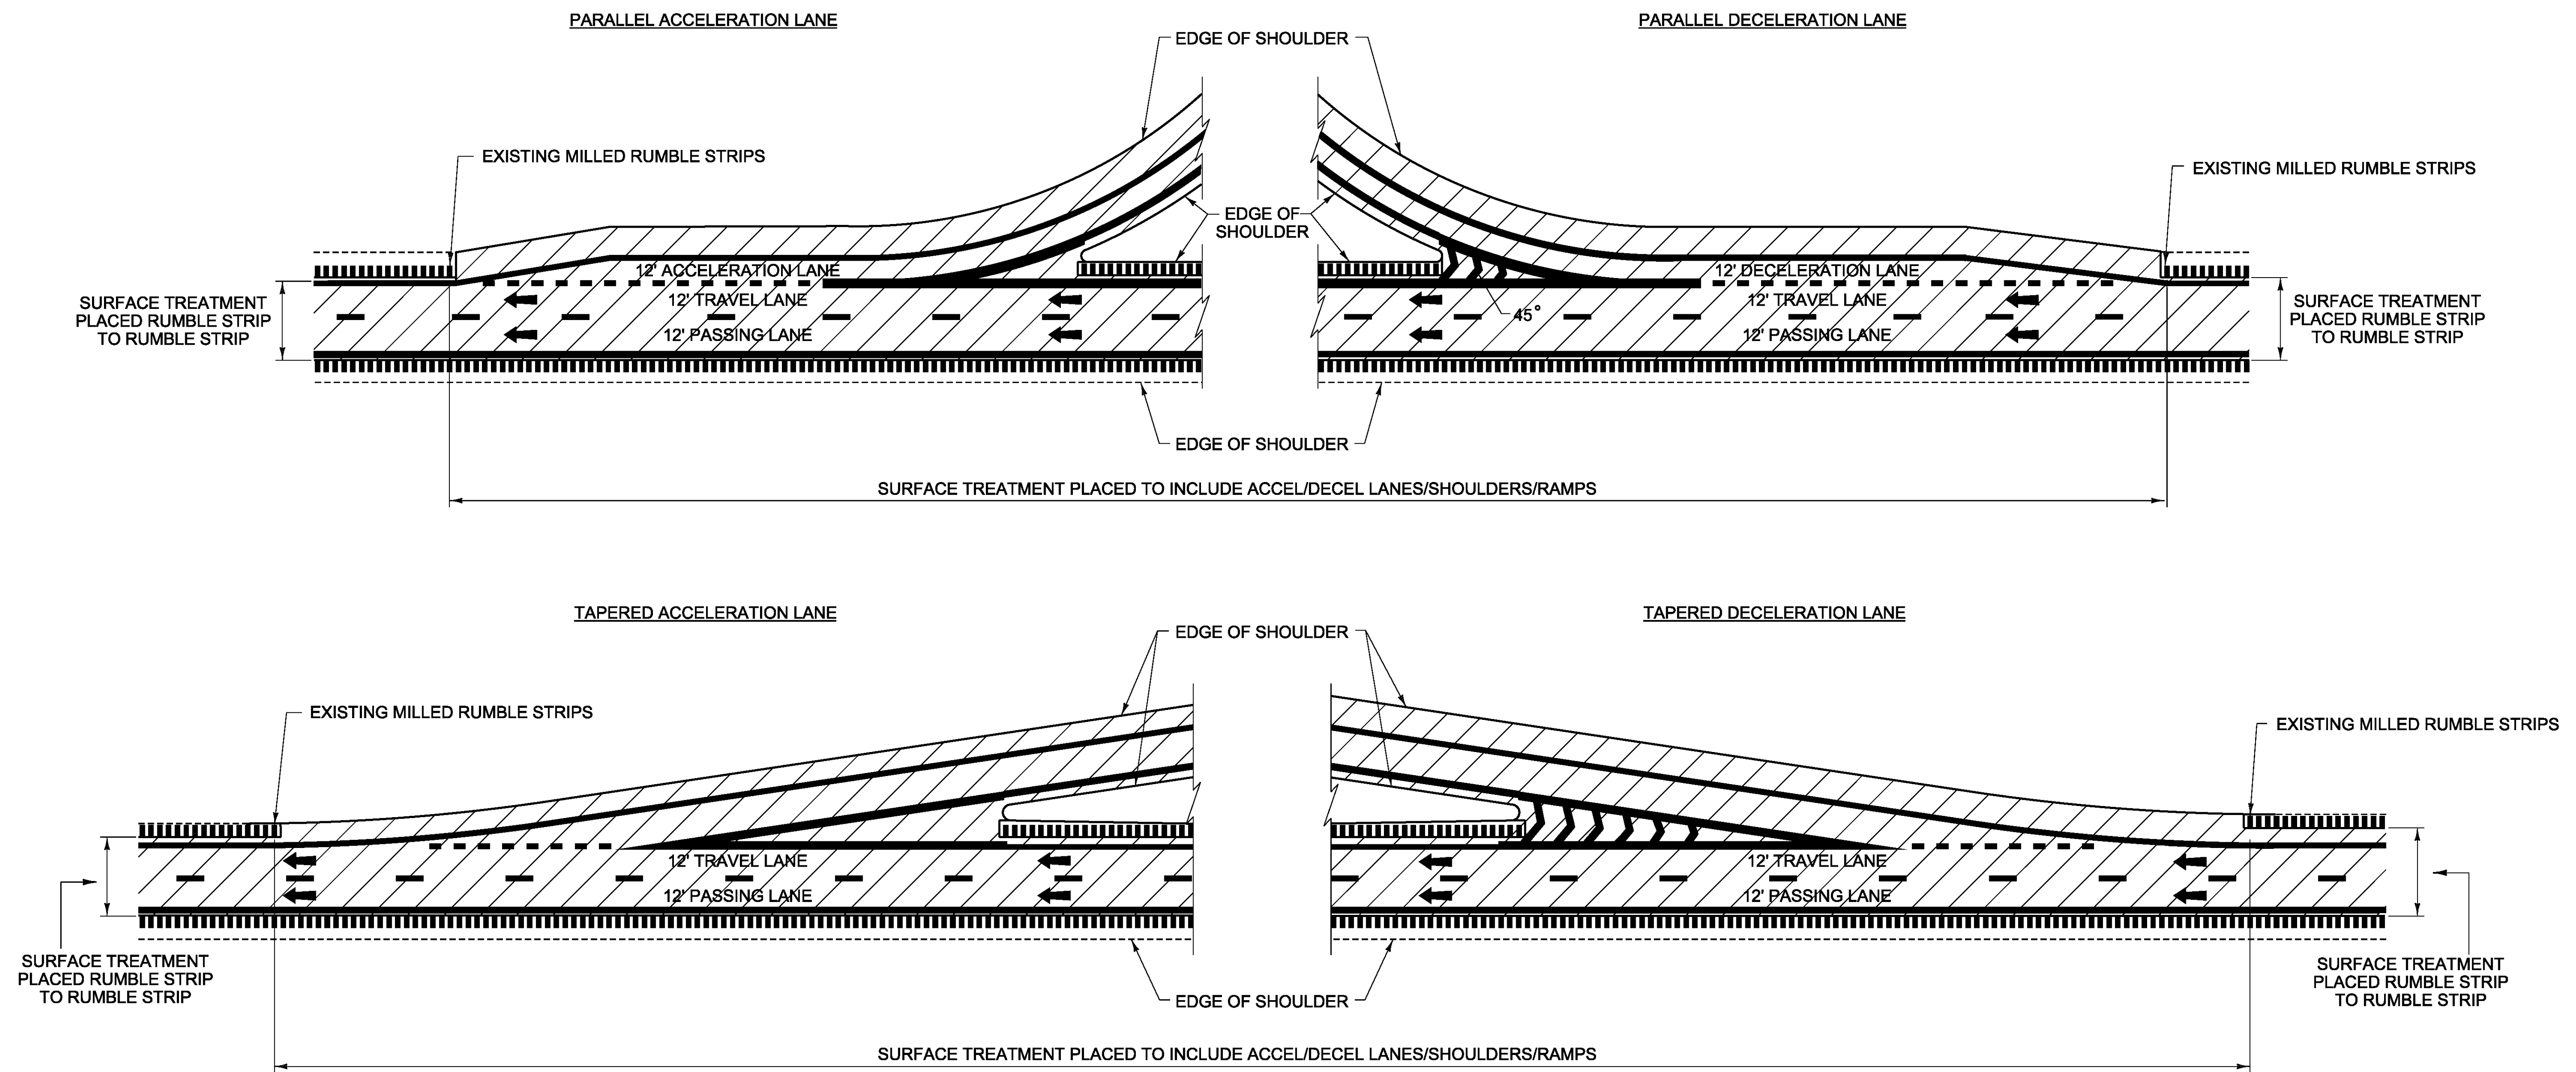

**TYPICAL INTERCHANGE CONSTRUCTION DETAILS # 1**

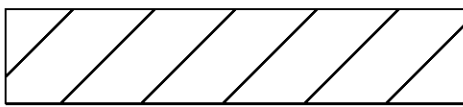

NOTES:  
1. LINE STRIPING SHOWN FOR REFERENCE ONLY.

**LEGEND**

-  SURFACE TREATMENT
-  DIRECTION OF TRAFFIC FLOW
-  EXISTING MILLED RUMBLE STRIPS

**NOT TO SCALE**

PROJECT NAME: BETHEL-BROOKFIELD	PLOT DATE: 2/10/2015
PROJECT NUMBER: IM SURF(54)	DRAWN BY: B. KIPP
FILE NAME: pl4v206wrk.dgn	CHECKED BY:
PROJECT LEADER: M. FOWLER	TYPICAL INTERCHANGE CONSTRUCTION DETAILS   SHEET 7 OF 22
DESIGNED BY: B. KIPP	