
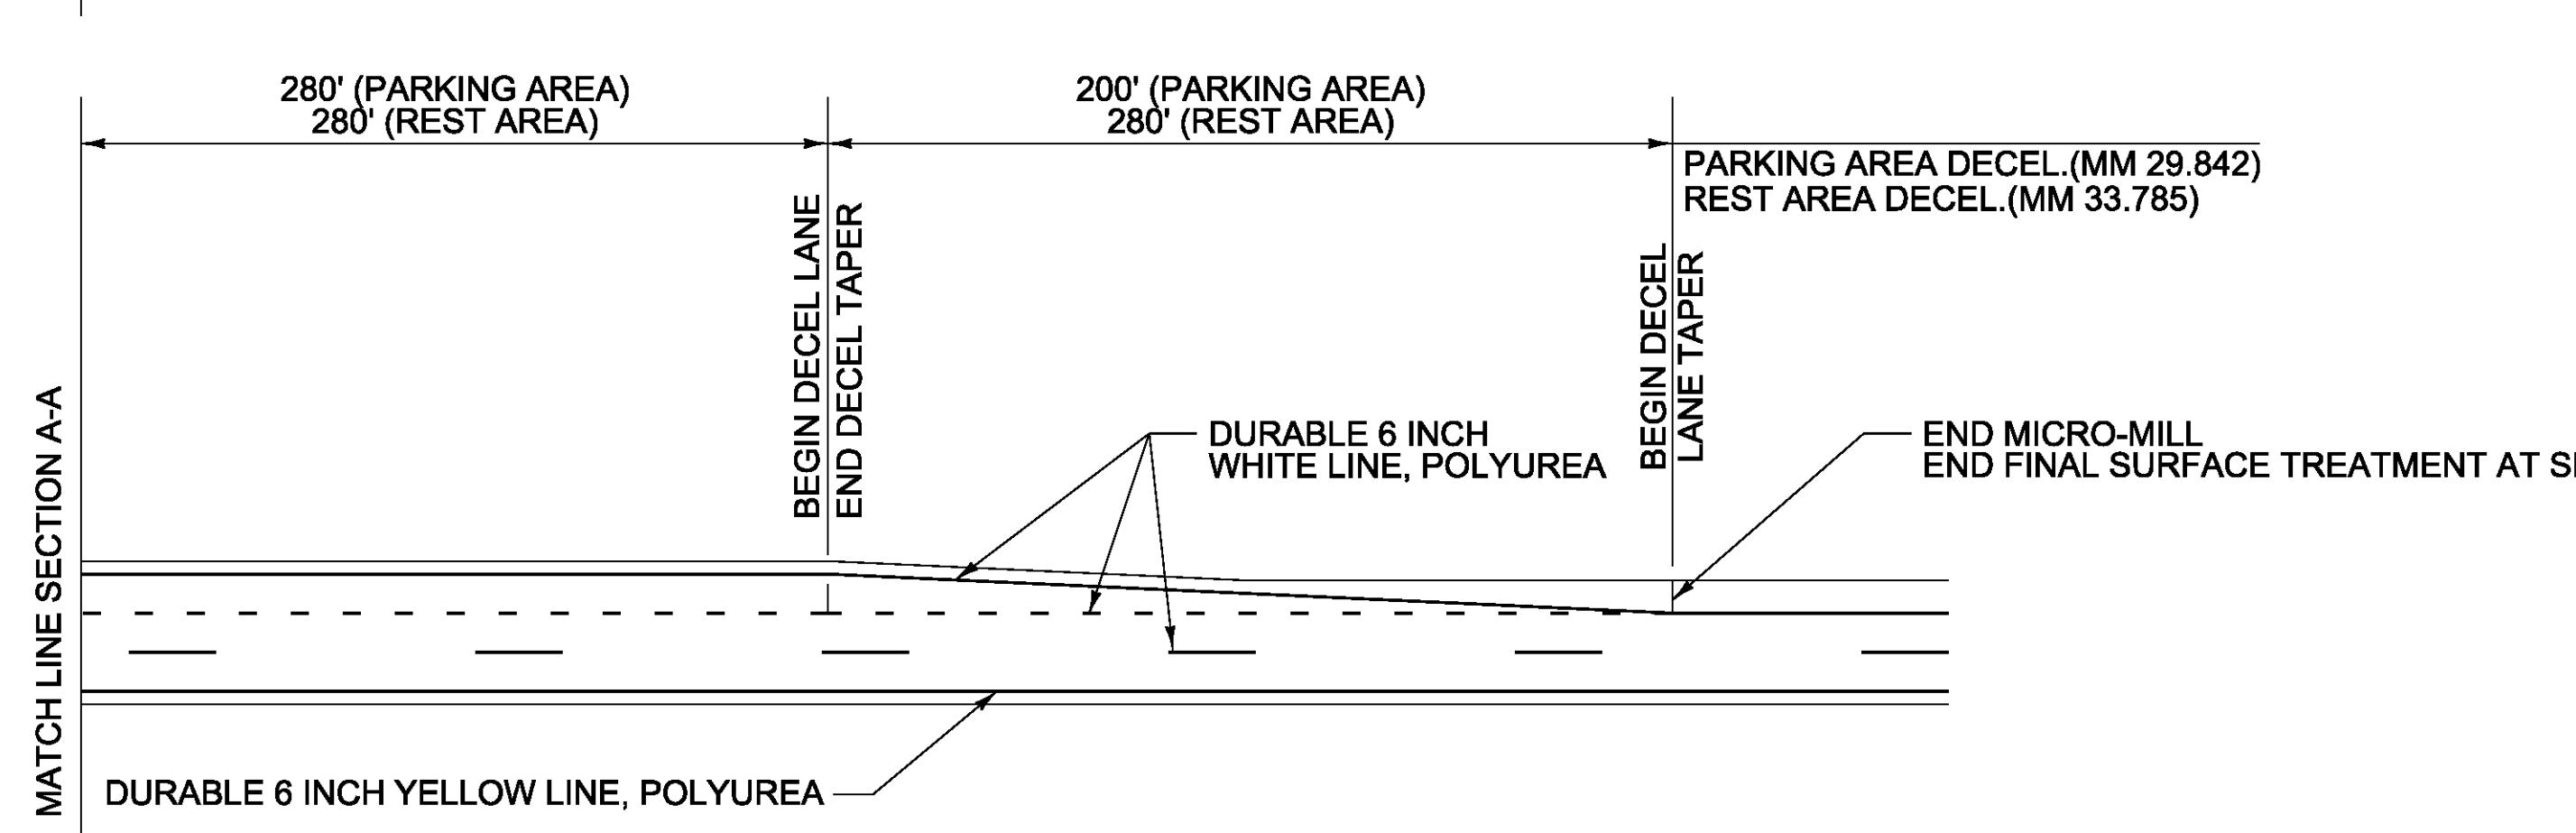
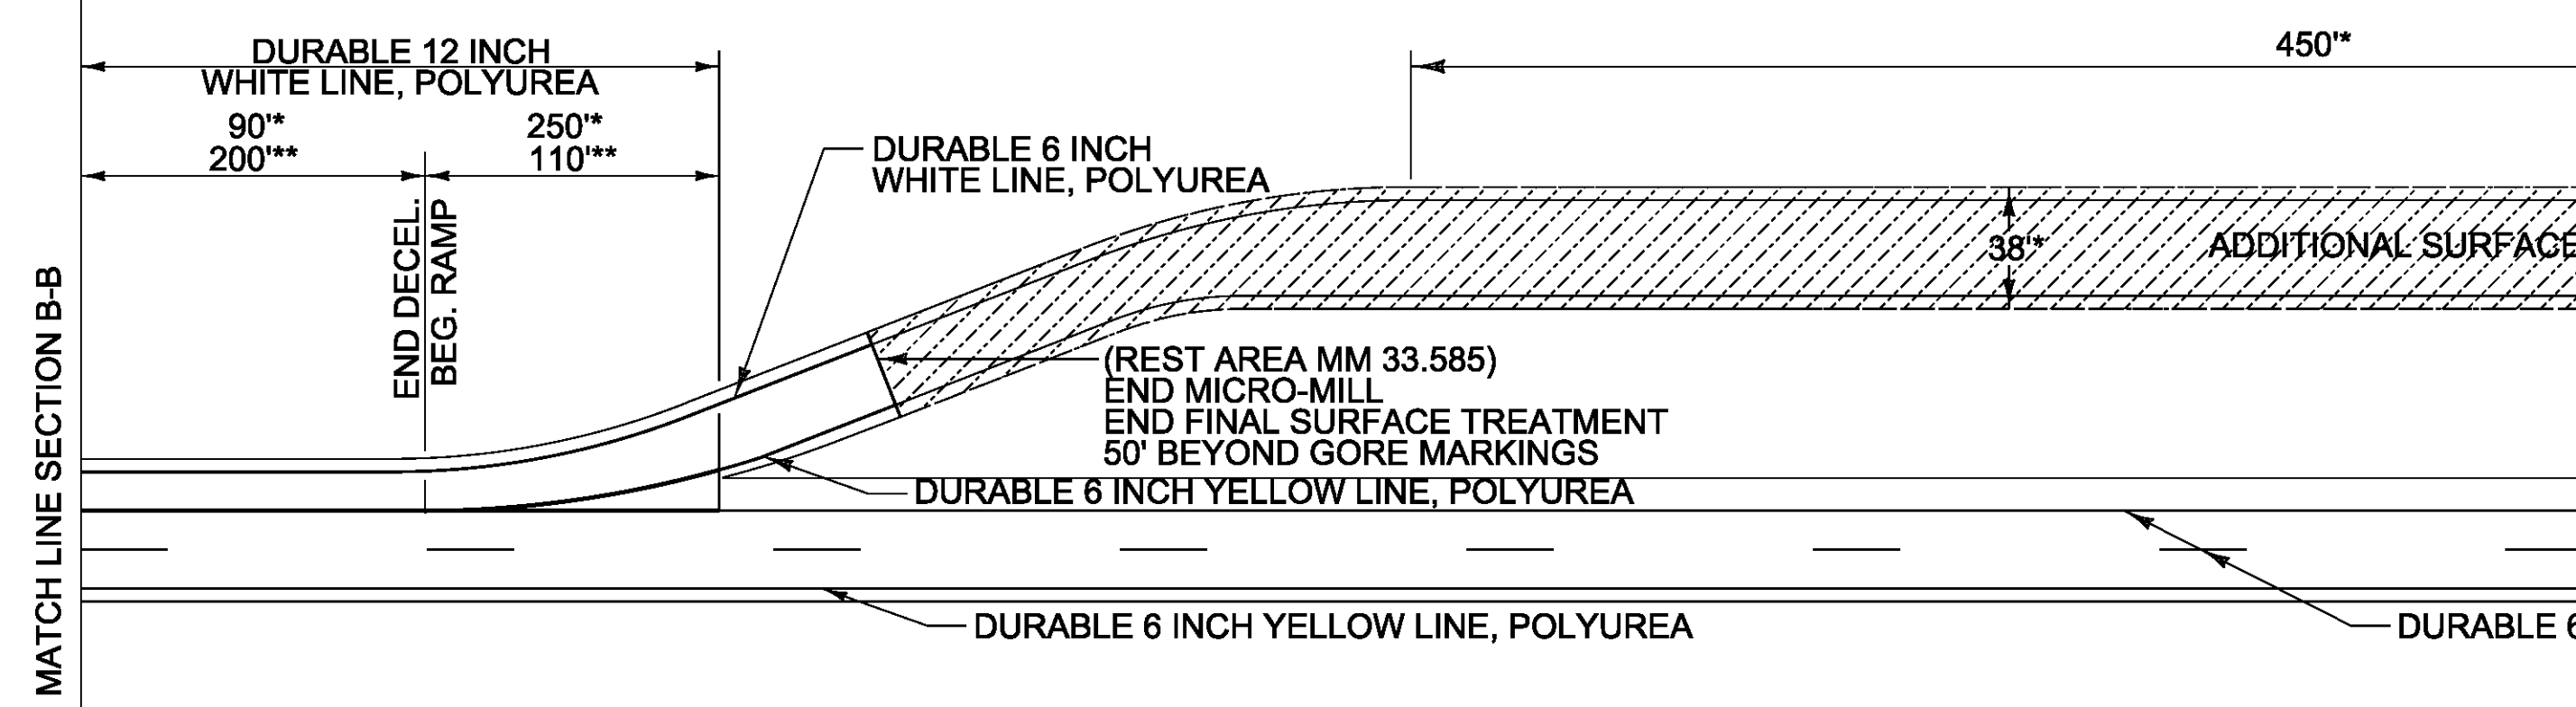
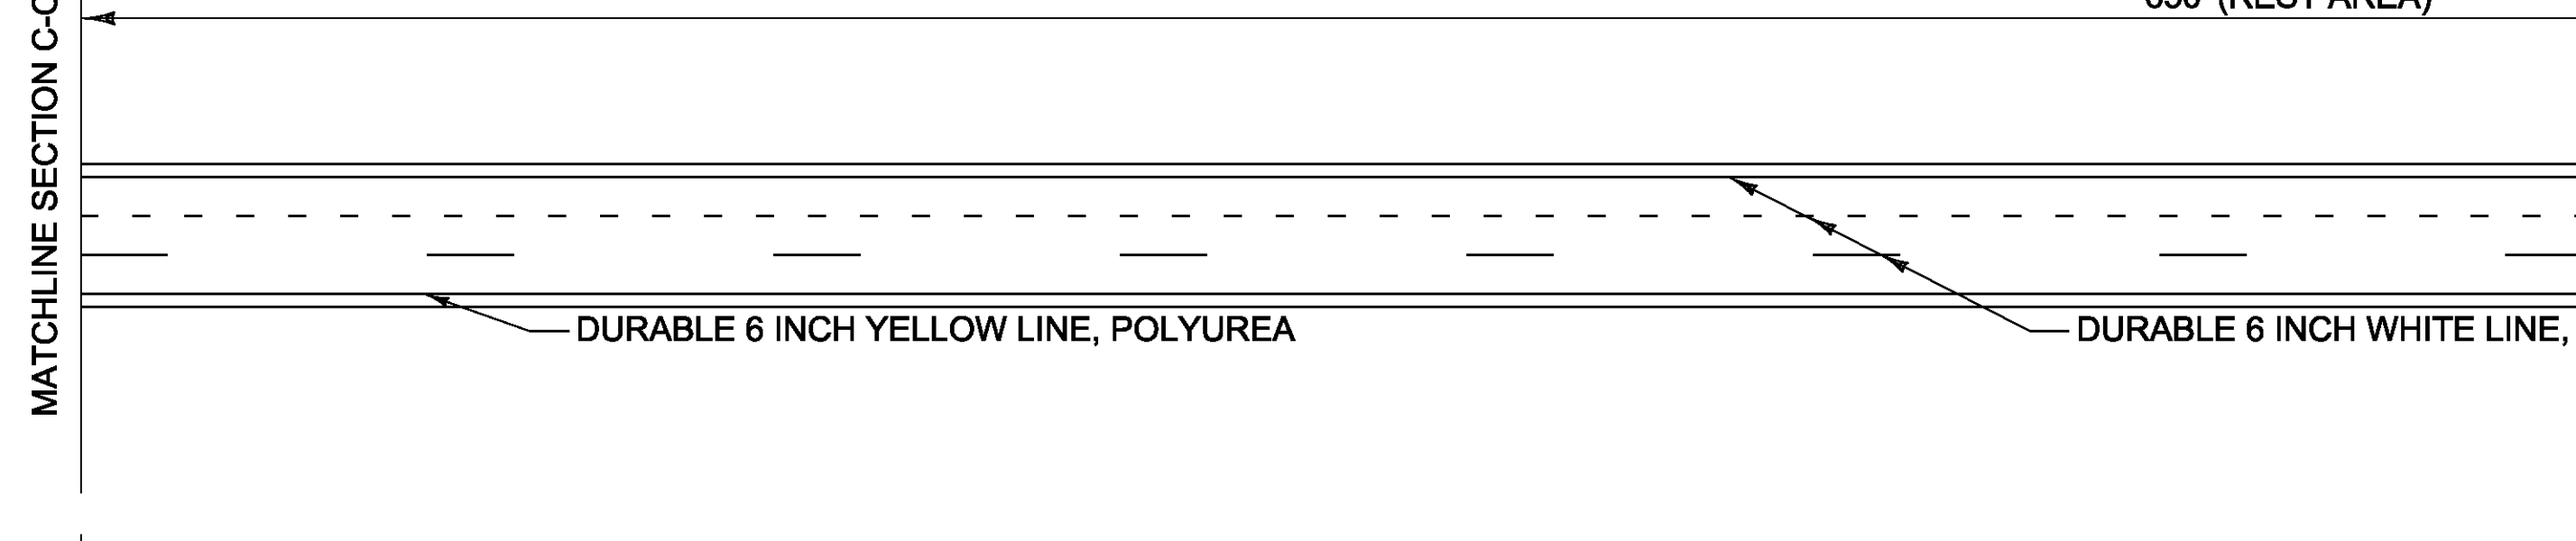


# PARKING AREA REST AREA SOUTHBOUND

MM 29.653 (PARKING AREA)  
MM 33.585 (REST AREA)

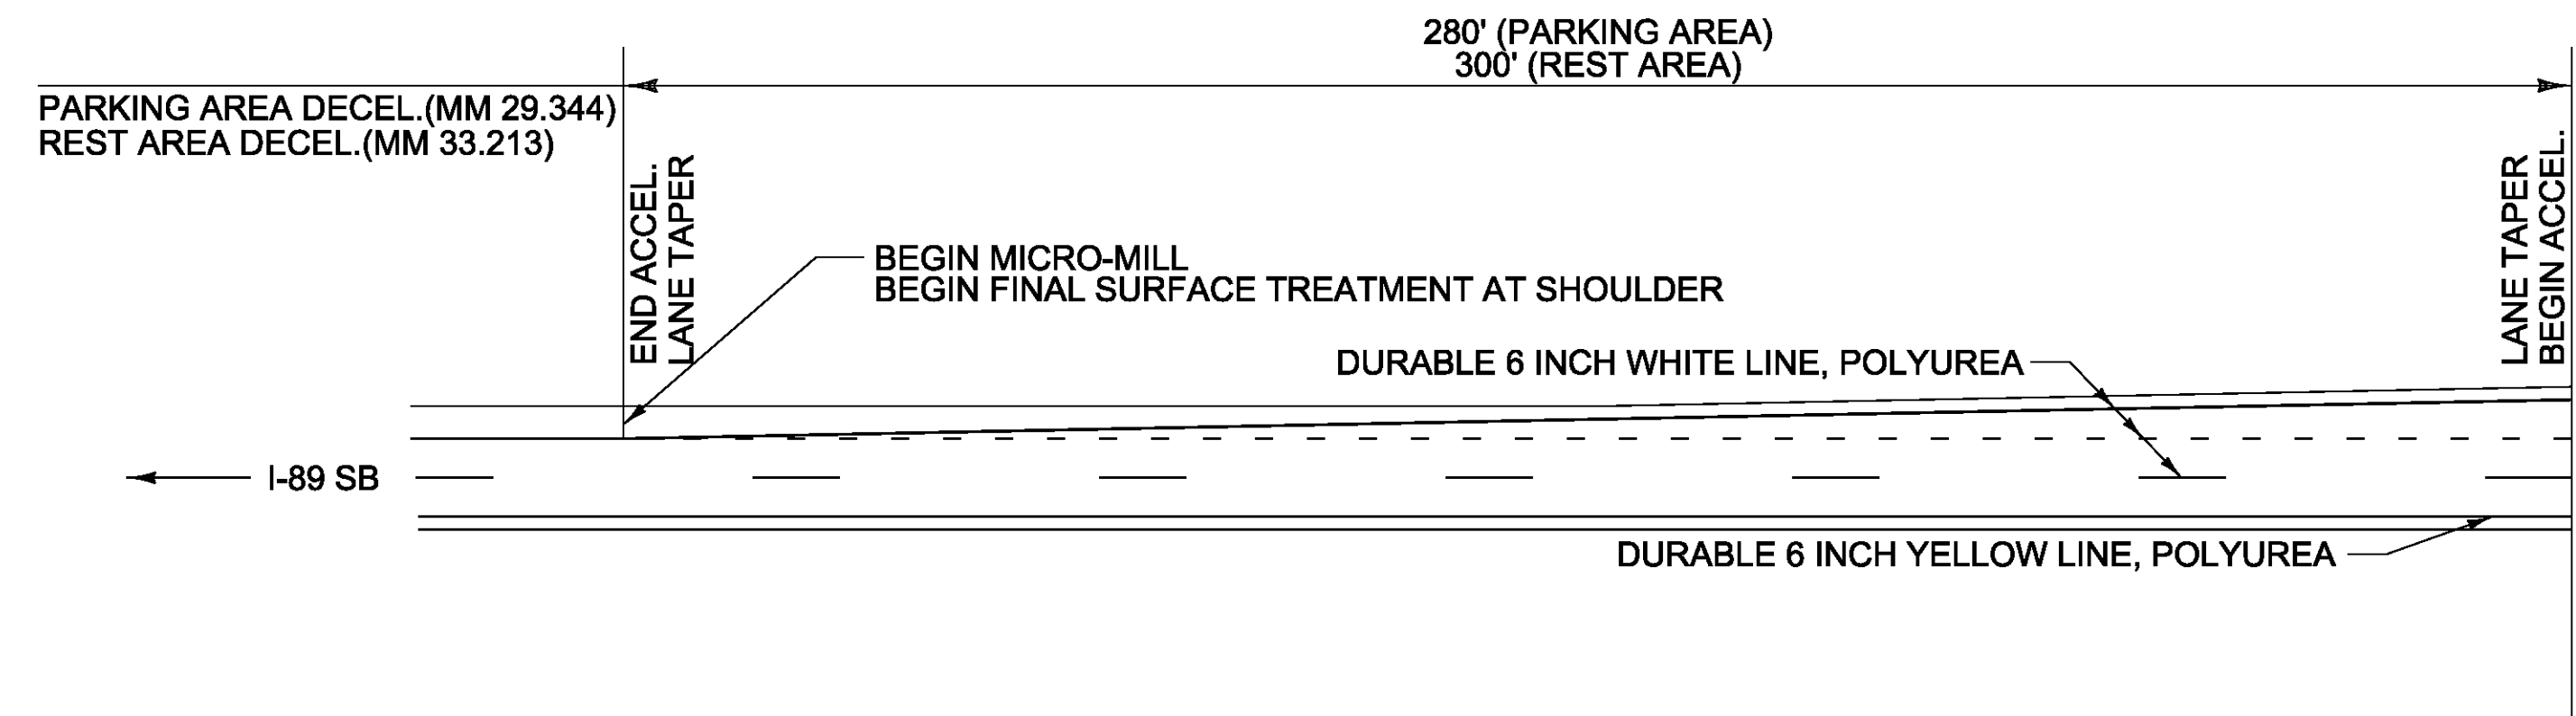

**DURABLE LETTER OR SYMBOL, POLYUREA**

PARKING AREA:			
SB OFF RAMP	WRONG WAY ARROW	(1 EA)	
REST AREA:			
SB OFF RAMP	WRONG WAY ARROW	(1 EA)	

**TEMPORARY LETTER OR SYMBOL, PAINT**

PARKING AREA:			
SB OFF RAMP	WRONG WAY ARROW	(1 EA)	
REST AREA:			
SB OFF RAMP	WRONG WAY ARROW	(1 EA)	

**DURABLE 6 INCH WHITE LINE, POLYUREA**

PARKING AREA:			
SOUTHBOUND OFF RAMP	SOLID LT EDGE LINE		
INTERSTATE 89	DOTTED LT LANE LINE		
PARKING AREA	SOLID LT EDGE LINE		
SOUTHBOUND ON RAMP	SOLID LT EDGE LINE		
INTERSTATE 89	DOTTED LT LANE LINE		

REST AREA:			
SOUTHBOUND OFF RAMP	SOLID LT EDGE LINE		
INTERSTATE 89	DOTTED LT LANE LINE		
SOUTHBOUND ON RAMP	SOLID LT EDGE LINE		
INTERSTATE 89	DOTTED LT LANE LINE		

**DURABLE 6 INCH YELLOW LINE, POLYUREA**

PARKING AREA:			
SOUTHBOUND OFF RAMP	SOLID LT EDGE LINE		
PARKING AREA	SOLID LT EDGE LINE		
SOUTHBOUND ON RAMP	SOLID LT EDGE LINE		

REST AREA:			
SOUTHBOUND OFF RAMP	SOLID LT EDGE LINE		
SOUTHBOUND ON RAMP	SOLID LT EDGE LINE		

**DURABLE 12 INCH WHITE LINE, POLYUREA**

PARKING AREA/REST AREA			
SOUTHBOUND OFF RAMP	SOLID LT GORE AREA		
INTERSTATE 89	SOLID LT GORE AREA		
SOUTHBOUND ON RAMP	SOLID LT GORE AREA		
INTERSTATE 89	SOLID LT GORE AREA		

**DURABLE 6 INCH WHITE LINE, POLYUREA**

PARKING AREA:			
SOUTHBOUND OFF RAMP	SOLID LT EDGE LINE		
INTERSTATE 89	DOTTED LT LANE LINE		
PARKING AREA	SOLID LT EDGE LINE		
SOUTHBOUND ON RAMP	SOLID LT EDGE LINE		
INTERSTATE 89	DOTTED LT LANE LINE		

REST AREA:			
SOUTHBOUND OFF RAMP	SOLID LT EDGE LINE		
INTERSTATE 89	DOTTED LT LANE LINE		
SOUTHBOUND ON RAMP	SOLID LT EDGE LINE		
INTERSTATE 89	DOTTED LT LANE LINE		

**DURABLE 6 INCH YELLOW LINE, POLYUREA**

PARKING AREA:			
SOUTHBOUND OFF RAMP	SOLID LT EDGE LINE		
PARKING AREA	SOLID LT EDGE LINE		
SOUTHBOUND ON RAMP	SOLID LT EDGE LINE		

REST AREA:			
SOUTHBOUND OFF RAMP	SOLID LT EDGE LINE		
SOUTHBOUND ON RAMP	SOLID LT EDGE LINE		

**DURABLE 12 INCH WHITE LINE, POLYUREA**

PARKING AREA/REST AREA			
SOUTHBOUND OFF RAMP	SOLID LT GORE AREA		
INTERSTATE 89	SOLID LT GORE AREA		
SOUTHBOUND ON RAMP	SOLID LT GORE AREA		
INTERSTATE 89	SOLID LT GORE AREA		

**KEY**

- \* PARKING AREA DIMENSION
- \*\* REST AREA DIMENSION
- PARKING AREA SURFACE TREATMENT AREA

PROJECT NAME: BETHEL-BROOKFIELD	
PROJECT NUMBER: IM SURF(54)	
FILE NAME: pl4v206wrk.dgn	PLOT DATE: 2/17/2015
PROJECT LEADER: M. FOWLER	DRAWN BY: B. KIPP
DESIGNED BY: B. KIPP	CHECKED BY:
PAVEMENT MARKING DETAIL SHEET 5	SHEET 15 OF 22

**NOT TO SCALE**