

# STATE OF VERMONT AGENCY OF TRANSPORTATION




## PROPOSED IMPROVEMENT BRIDGE PROJECT TOWN OF IRASBURG COUNTY OF ORLEANS

### INTERSTATE 91 (PRINCIPAL ARTERIAL) BRIDGE NO. 107N


**PROJECT LOCATION:** LOCATED IN THE TOWN OF IRASBURG, ON INTERSTATE 91, APPROXIMATELY 0.430 MILES SOUTHERLY OF THE IRASBURG/BROWNINGTON TOWN LINE.

**PROJECT DESCRIPTION:** WORK TO BE PERFORMED UNDER THIS PROJECT INCLUDES THE REPLACEMENT OF THE EXISTING BRIDGE DECK INCLUDING RELATED APPROACH WORK.

**LENGTH OF STRUCTURE:** 447.43 FEET  
**LENGTH OF ROADWAY:** 152.57 FEET  
**LENGTH OF PROJECT:** 600.00 FEET

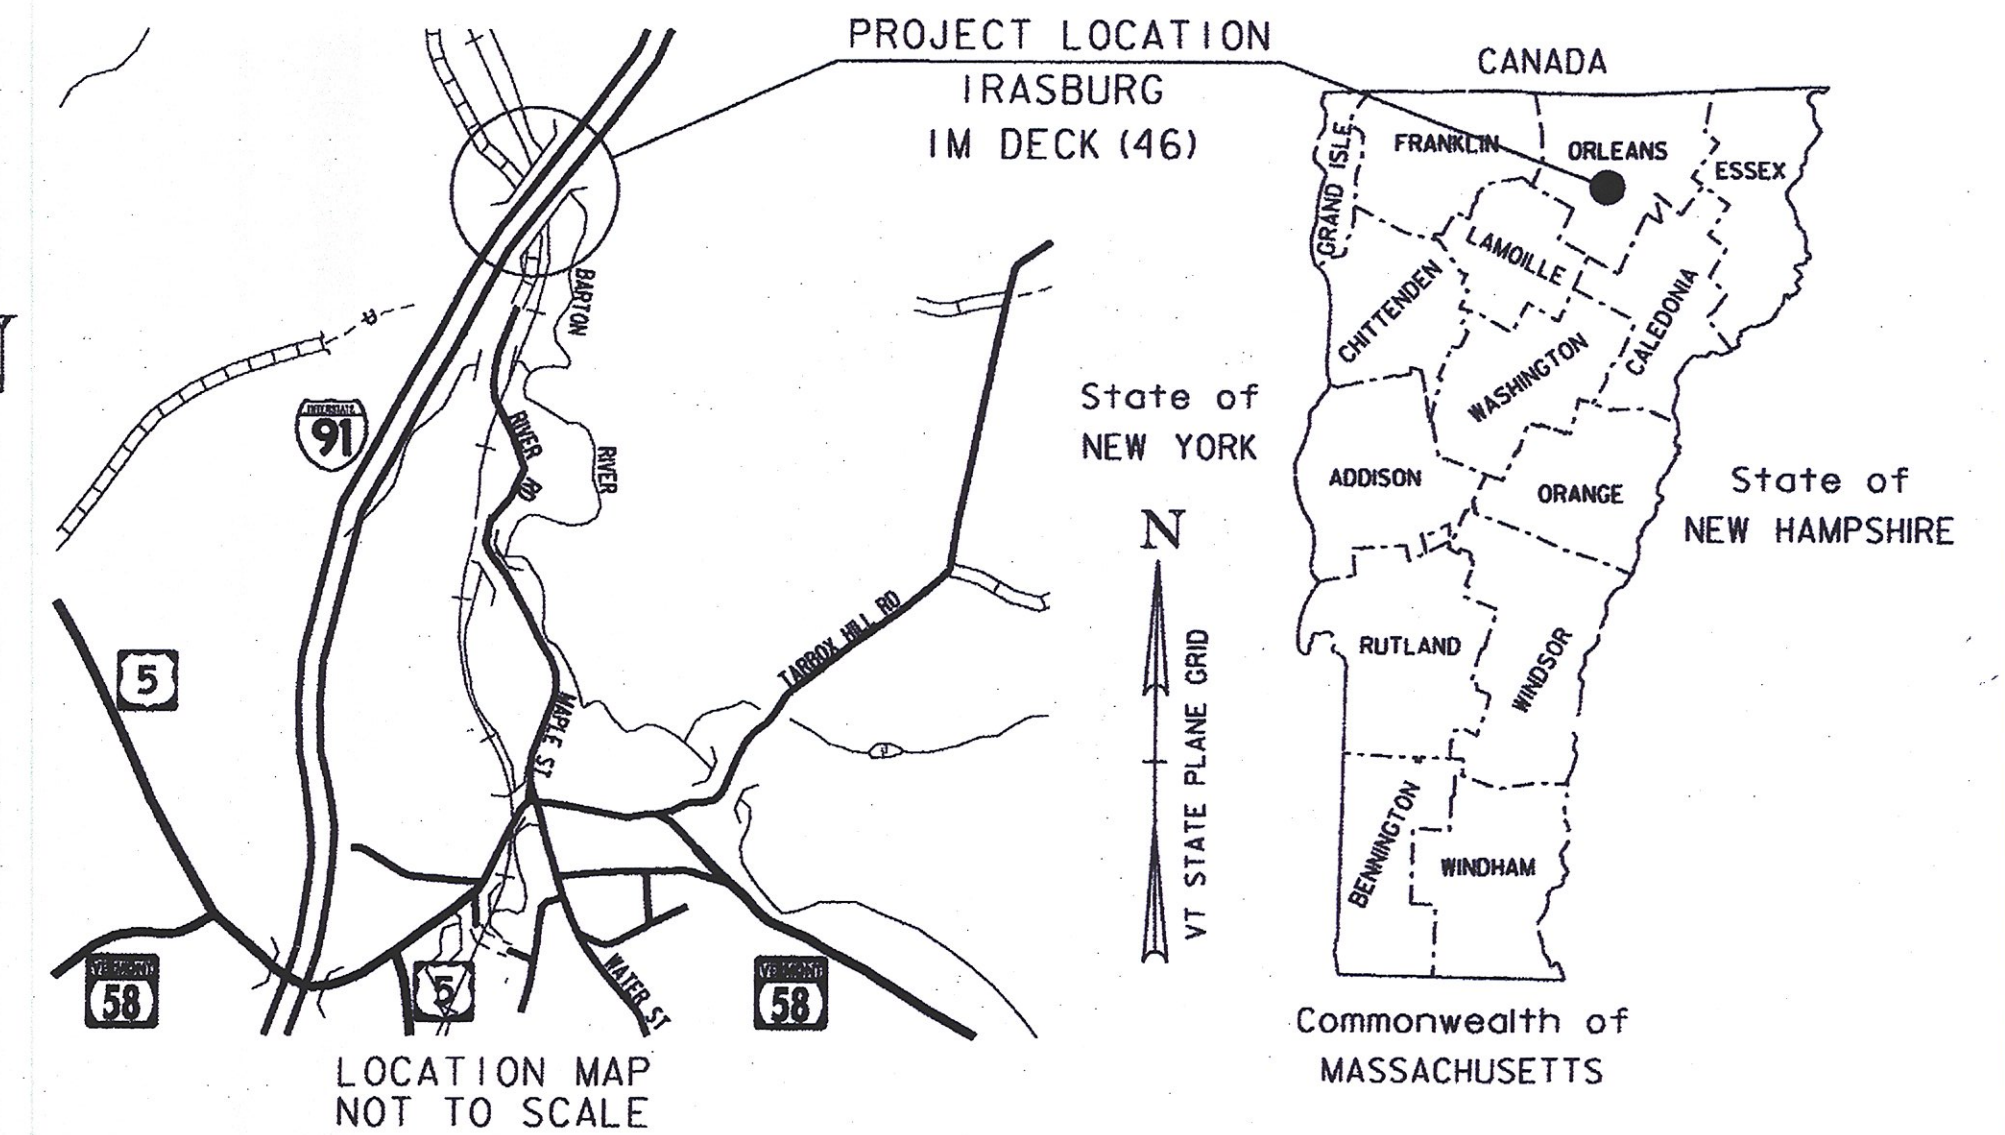

RECORD PLANS	
CONTRACTOR:	J.P. SICARD, INC. - BARTON, VT
RESIDENT ENGINEER:	SETH HISMAN
CONSTRUCTION BEGAN:	MAY 5, 2016
CONSTRUCTION COMPLETE:	OCTOBER 31, 2016
RECORD PLANS BY:	SETH HISMAN & JESSE IVES
I HEREBY CERTIFY THAT ALL THE CONSTRUCTION REQUIRED BY THIS SET OF DRAWINGS HAS BEEN ACCOMPLISHED AS INDICATED HEREIN.	
BY	RESIDENT ENGINEER
DATE	10/14/16
NOTE: Any further information concerning final quantities, amounts or other details relative to this project may be found by contacting Vtrans Records Management.	

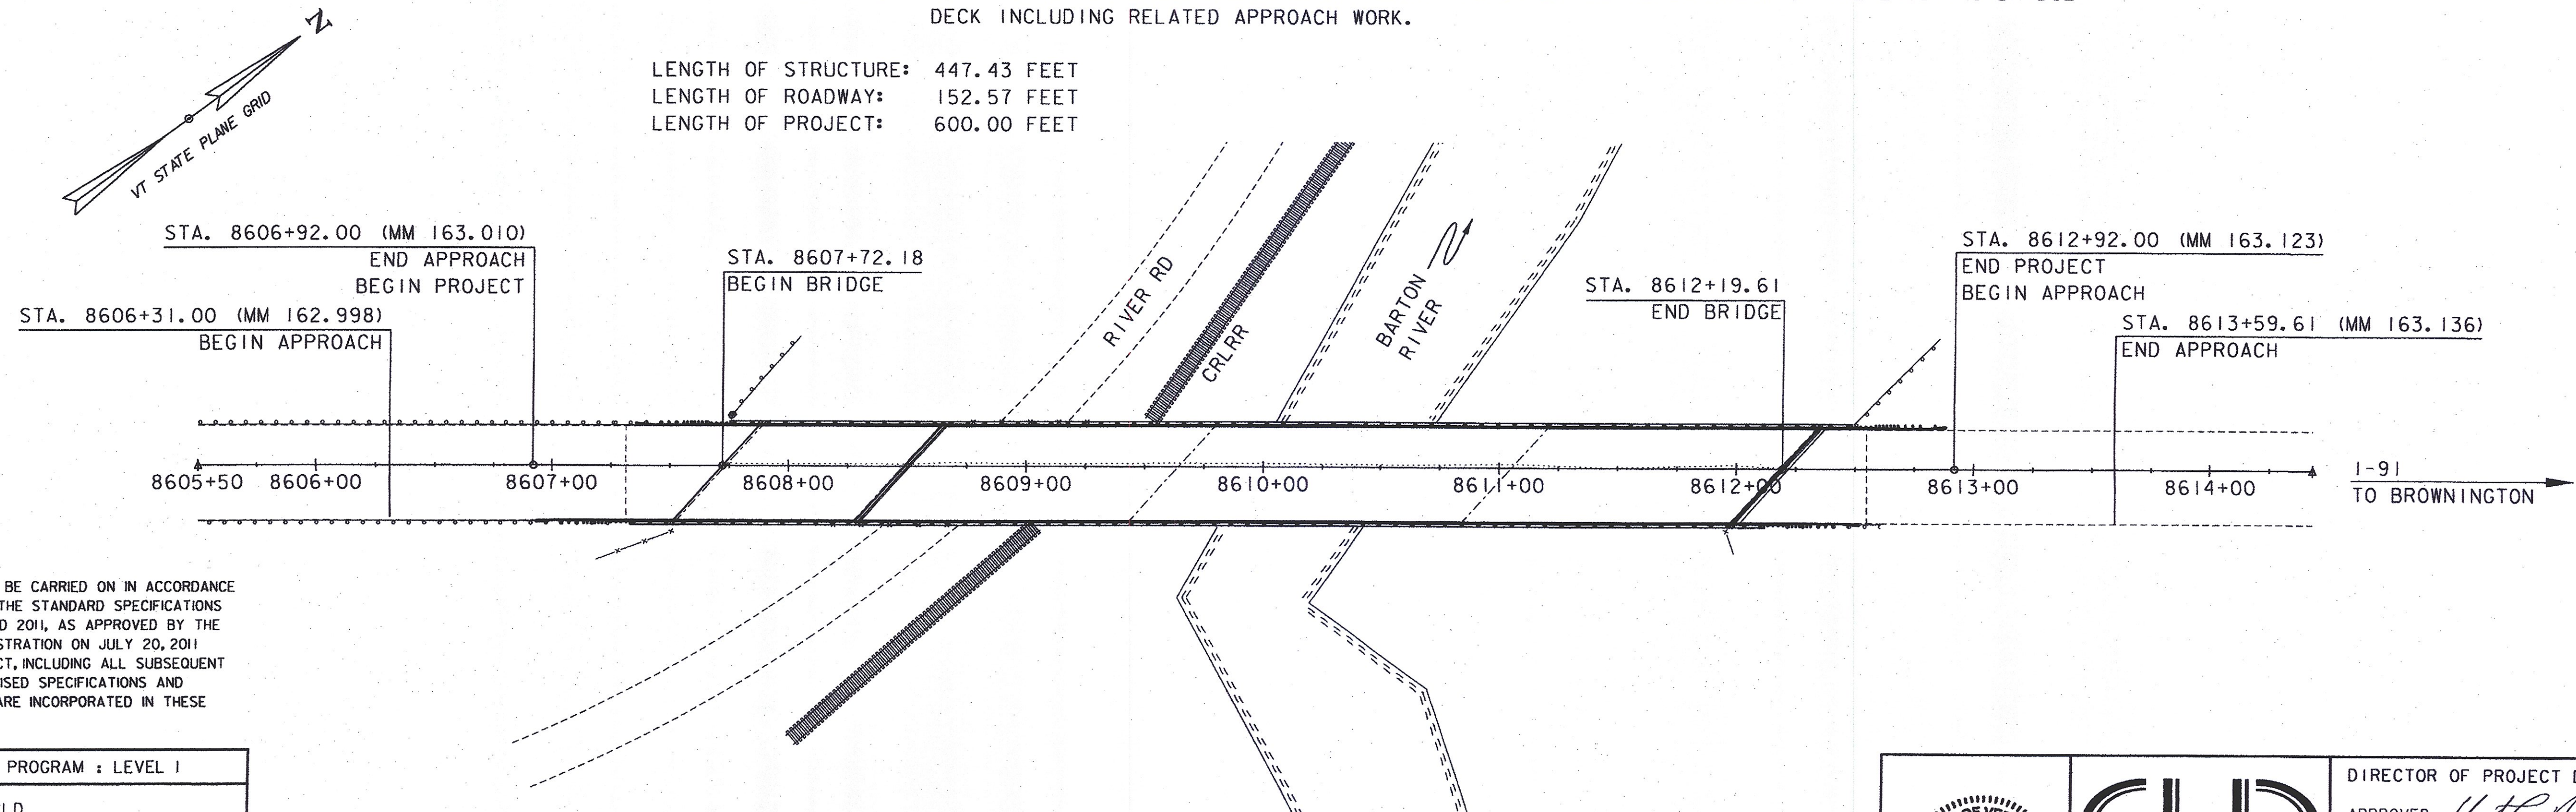

CONSTRUCTION IS TO BE CARRIED ON IN ACCORDANCE WITH THESE PLANS AND THE STANDARD SPECIFICATIONS FOR CONSTRUCTION DATED 2011, AS APPROVED BY THE FEDERAL HIGHWAY ADMINISTRATION ON JULY 20, 2011 FOR USE ON THIS PROJECT, INCLUDING ALL SUBSEQUENT REVISIONS AND SUCH REVISED SPECIFICATIONS AND SPECIAL PROVISIONS AS ARE INCORPORATED IN THESE PLANS.

QUALITY ASSURANCE PROGRAM : LEVEL I
SURVEYED BY : CLD
SURVEYED DATE : 09/21/2015
DATUM
VERTICAL NAVD 88
HORIZONTAL NAD 83

SCALE 1" = 40'-0"  
40 0 40

	<p>540 Commercial Street Manchester, NH 03101 (603) 668-8223 www.cldengineers.com</p>	DIRECTOR OF PROJECT DELIVERY
		APPROVED  DATE 2/4/2016
		PROJECT MANAGER : JENNIFER FITCH, P.E.
		PROJECT NAME : IRASBURG PROJECT NUMBER : IM DECK (46)
		SHEET 1 OF 49 SHEETS