


PLAN

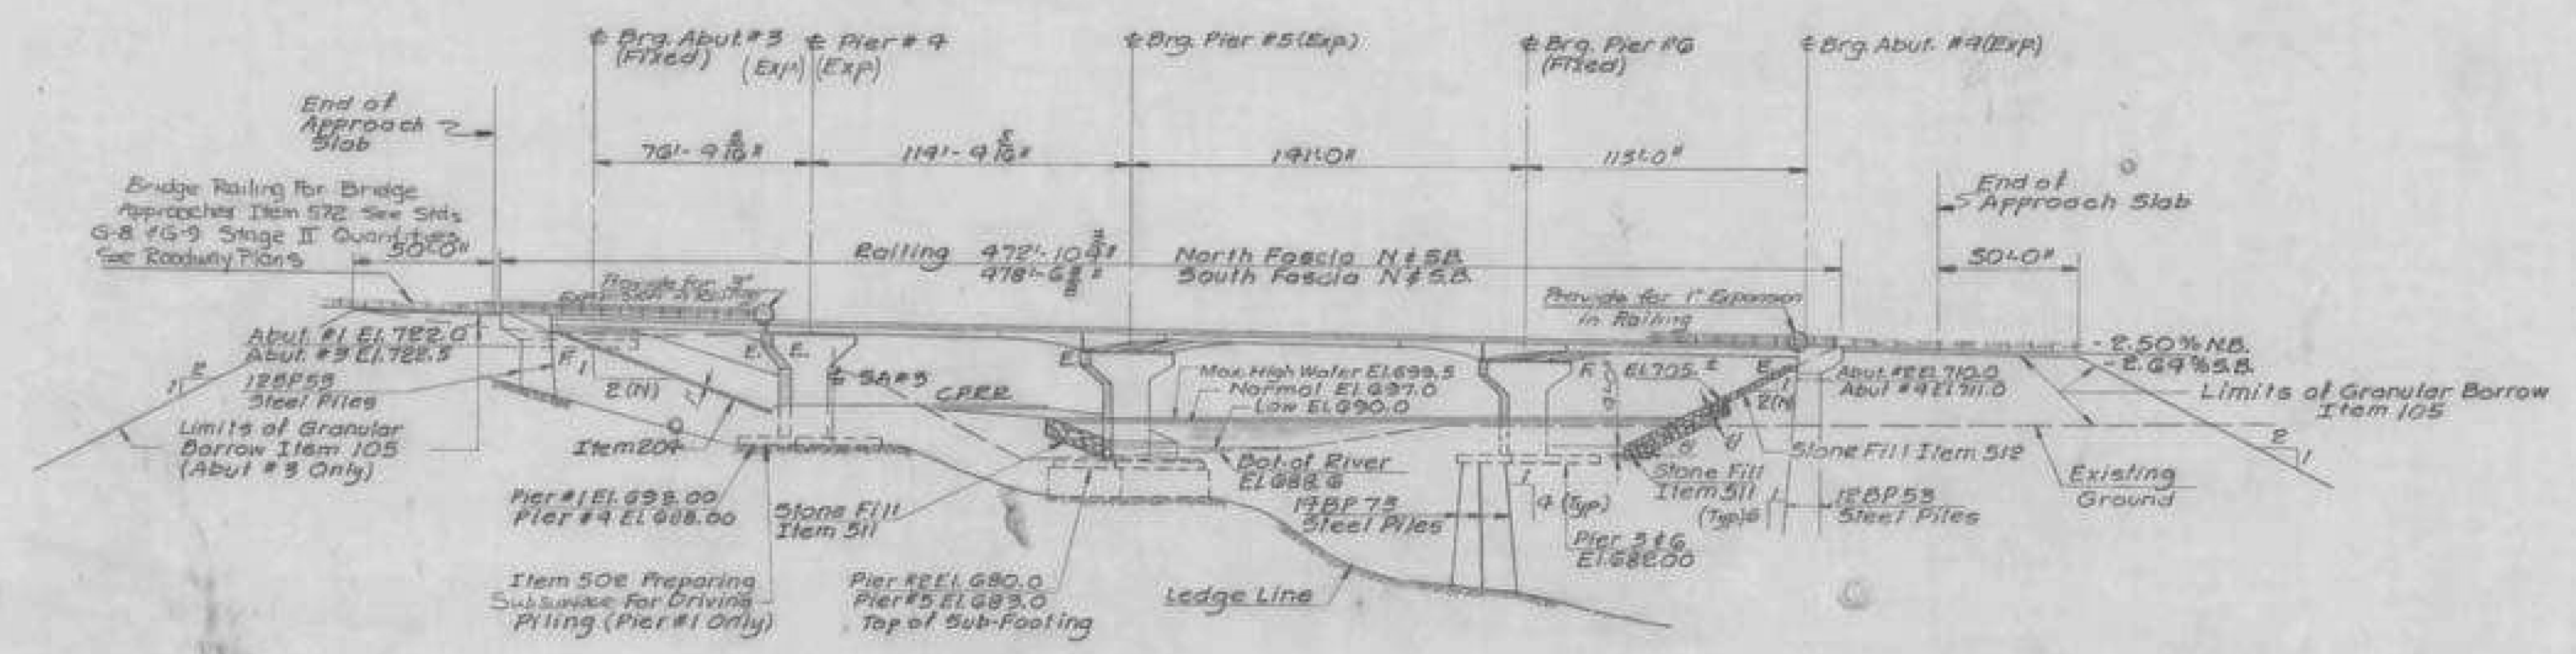

ELEVATION

LIST OF SHEETS

- Br.100 Plan & Elevation
- Br.101-102 Bridge Quantity Sheets
- Br.103 Preliminary Information Sheet
- Br.104-106 Borings Logs
- Br.107 Framing Plan & Girder Details
- Br.108 Girder Elevation & Conn. Details
- Br.109 Deck Section & Splice
- Br.110 Expansion Dam & Scupper Details
- Br.111 Rafter Bearings
- Br.112 Abutment #1
- Br.113 Abutment #2
- Br.114 Abutment #3
- Br.115 Abutment #4
- Br.116 Abutment #2 & #4 Details
- Br.117 Abutment #1 & #3 Approach Slab
- Br.118 Abutment #2 & #4 Approach Slab
- Br.119 Pier #1
- Br.120 Pier #2
- Br.121 Pier #3
- Br.122 Pier #4
- Br.123 Pier #5
- Br.124 Pier #6
- Br.125-128 Reinforcing Schedules
- Br.129 Channel sections

STANDARD SHEETS REQUIRED

- SCB D1 67 General Notes & Information Jan 24, 48
- SCB D2 67 Detail A&B'60 Jan 24, 48
- SCB D3 67 Drain Trough Details Jan 24, 48
- SCB D4 67 Reinforcing of Abutments Dec 17, 48
- SCB D5 67 Detail A&B May 23, 1949 R
- SCB D7 67 Intermediate Diaphragm Jan 24, 48
- SCB D8 67 Bearing Devices Jan 24, 48
- SCB D9 67 Detail A Jan 24, 48
- SB R1 64 Abutment Railing (3 Sheets) Sheet 1st, 2nd, 4th, 5th Nov 8, 44 R
- SB R2 65 Steel Bridge Railing Nov 8, 44 R

NOTE:

The channel excavation and stone fill shall be done between July 1 and October 1 so as not to interfere with the Bear bow Trout runs. Precautions shall be taken during construction to prevent siltation or pollution of the river.

| | |
|---|-----------------|
| 1. Changed roadway width from 36'0" to 39'4" with width from 15'6" to 17'0" quarter mile sheet R. Sheet 852 | |
| STATE OF VERMONT DEPARTMENT OF HIGHWAYS | |
| PROJECT IRASBURG - LEBEY | |
| TOWN OF | IRASBURG 827187 |
| ROUTE No. | I-91 STA. 25391 |
| I-91 OVER BARTON RIVER AND SA #3 | |
| PLAN AND ELEVATION | |
| SCALE 1" = 40' | |
| IN CHARGE S. IERENZIO | |
| DRAWN BY JMR CHECKED BY A. GENTORE | |
| PROJECT No. I-91-3(B) 9-57 | |
| SHEET 152 OF 852 BR 100 | |

IRASBURG
IM DECK(46)
BRIDGE NO. 107N
SHEET 34 OF 49
FOR REFERENCE ONLY