



SOUTHBOUND FRAMING PLAN
SCALE: 1/16" = 1'-0"

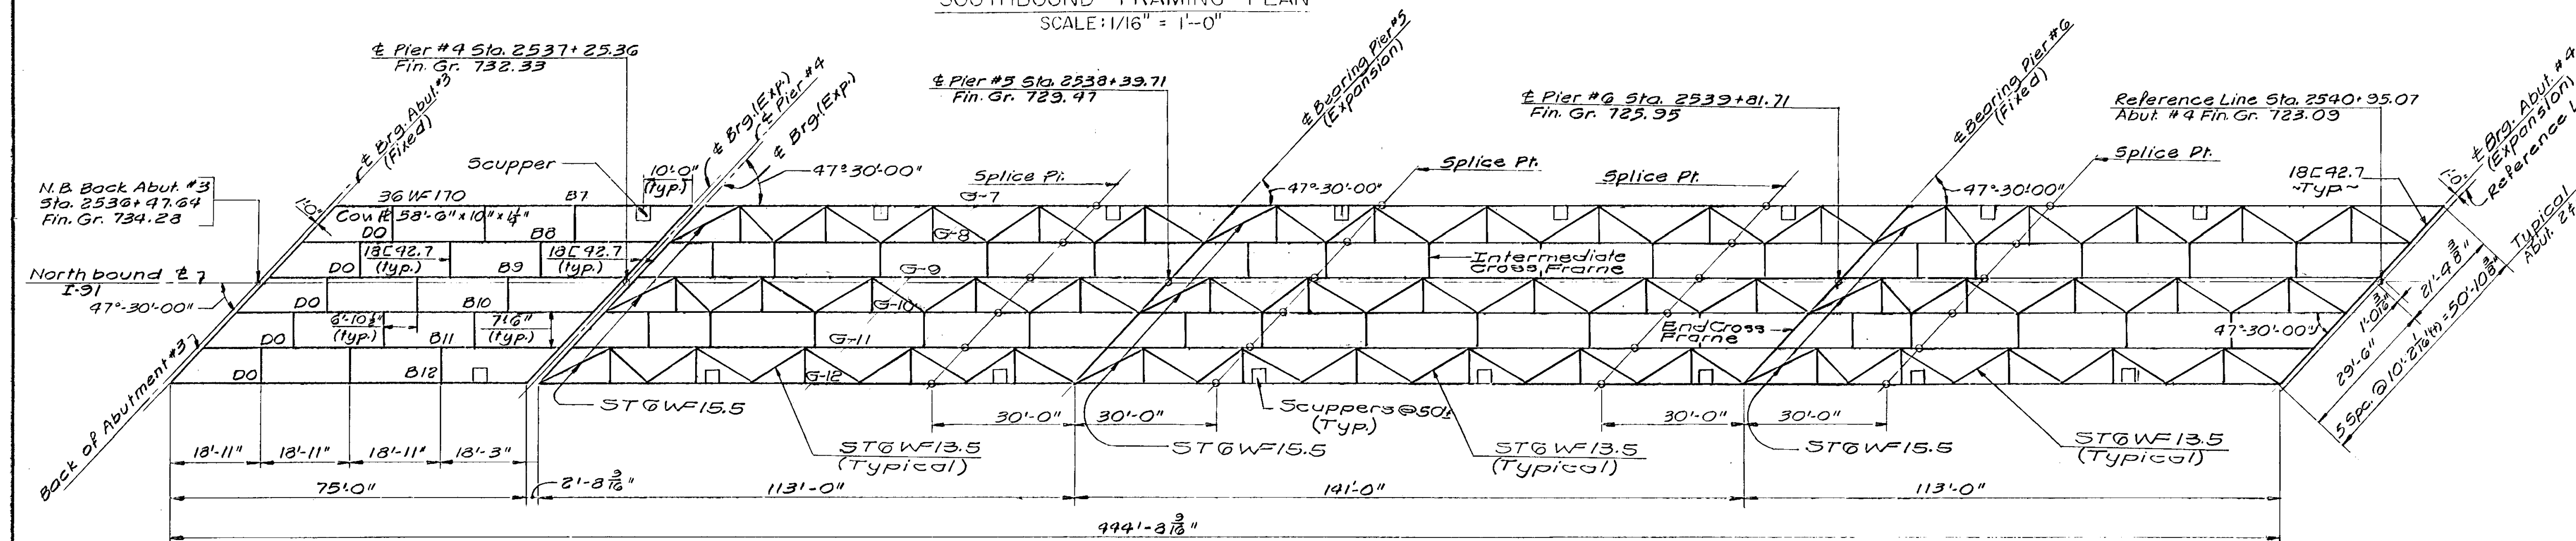


NORTHBOUND FRAMING PLAN
SCALE: 1/16" = 1'-0"


Note: See Southbound Framing Plan For Cross Frame and Lateral Bracing Dimensions.

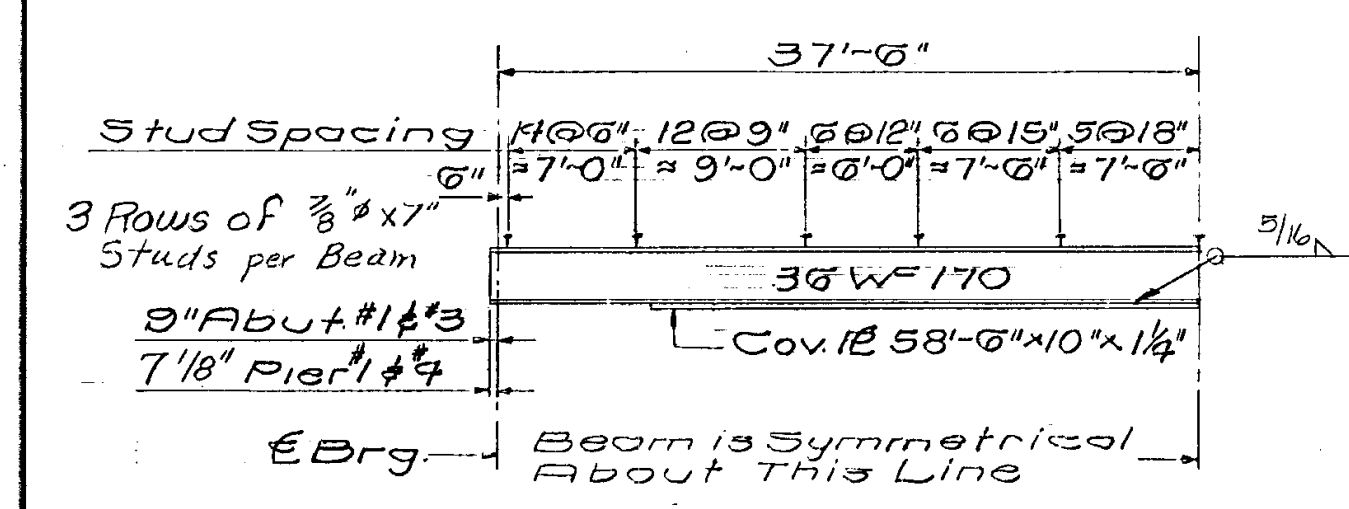

BEAM HALF ELEVATION B-1 THRU B-12
SCALE: 1/8" = 1'-0"

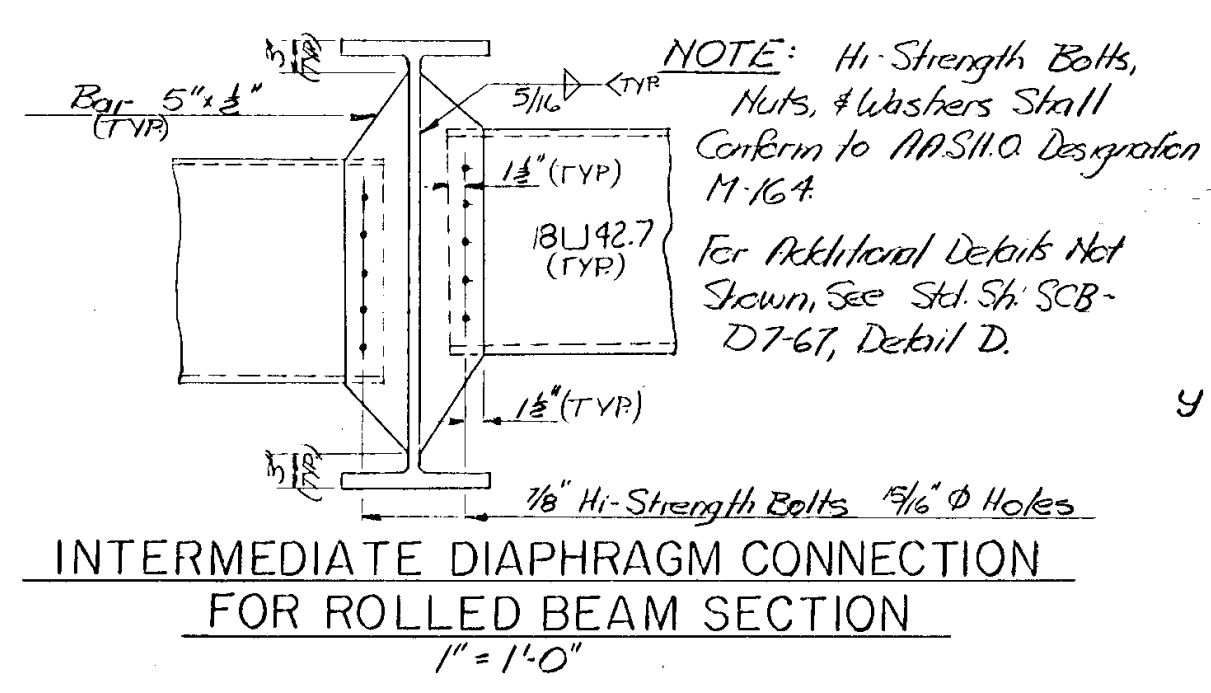

INTERMEDIATE DIAPHRAGM CONNECTION FOR ROLLED BEAM SECTION
SCALE: 1" = 1'-0"

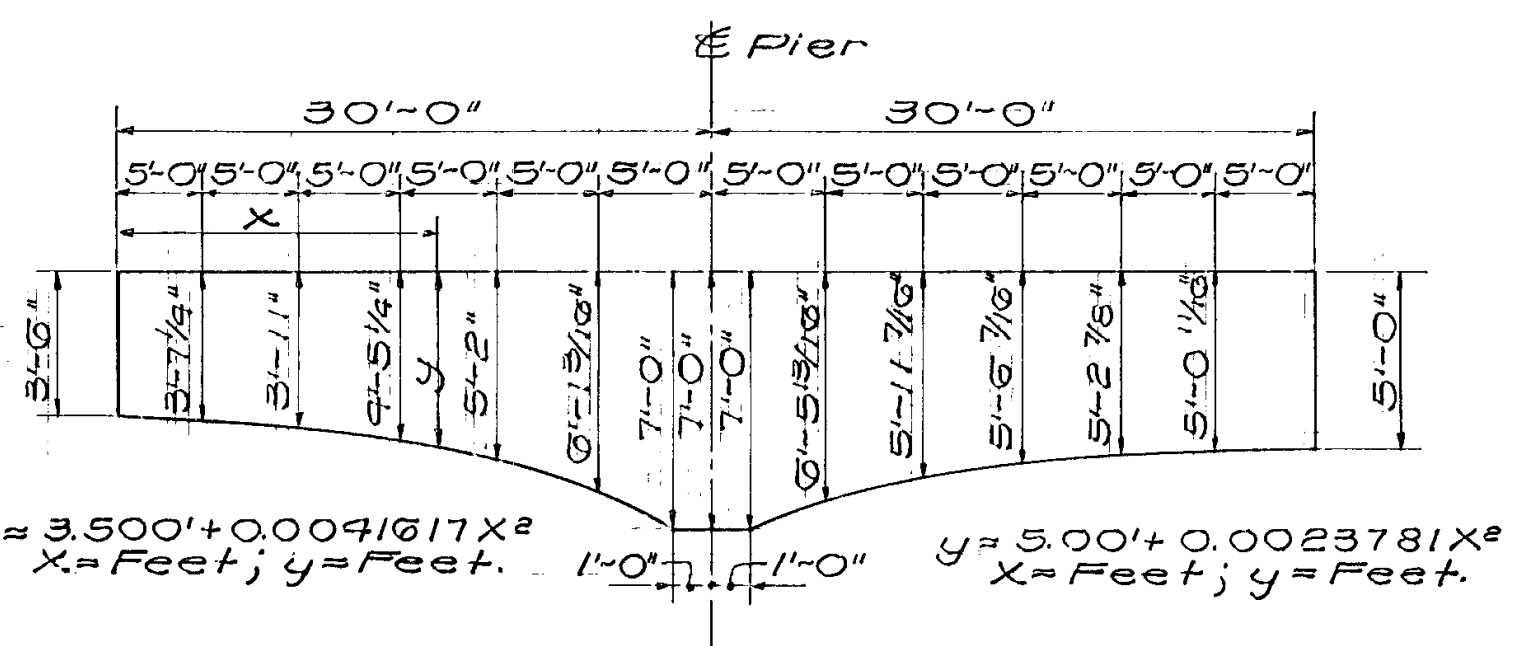

PARABOLIC HAUNCH DETAIL
N.T.S.

Dr. 107 of 129

STATE OF VERMONT	
DEPARTMENT OF HIGHWAYS	
PROJECT	IRASBURG-DERRY
TOWN OF	IRASBURG
ROUTE No.	I-91 STA. 2539±
I-91 OVER BARTON RIVER AND SA*3	
FRAMING PLAN AND GIRDER DETAILS	
SCALE AS NOTED	
IN CHARGE C. TERENCE	
DRAWN BY	JMB
CHECKED BY	A. CENTORE
PROJECT No.	191-3(8) 9-67
SHEET	176 OF 605 BR. 107

IRASBURG
IM DECK(46)
BRIDGE NO. 107N
SHEET 36 OF 49
FOR REFERENCE ONLY