


PLAN AT ABUTMENT

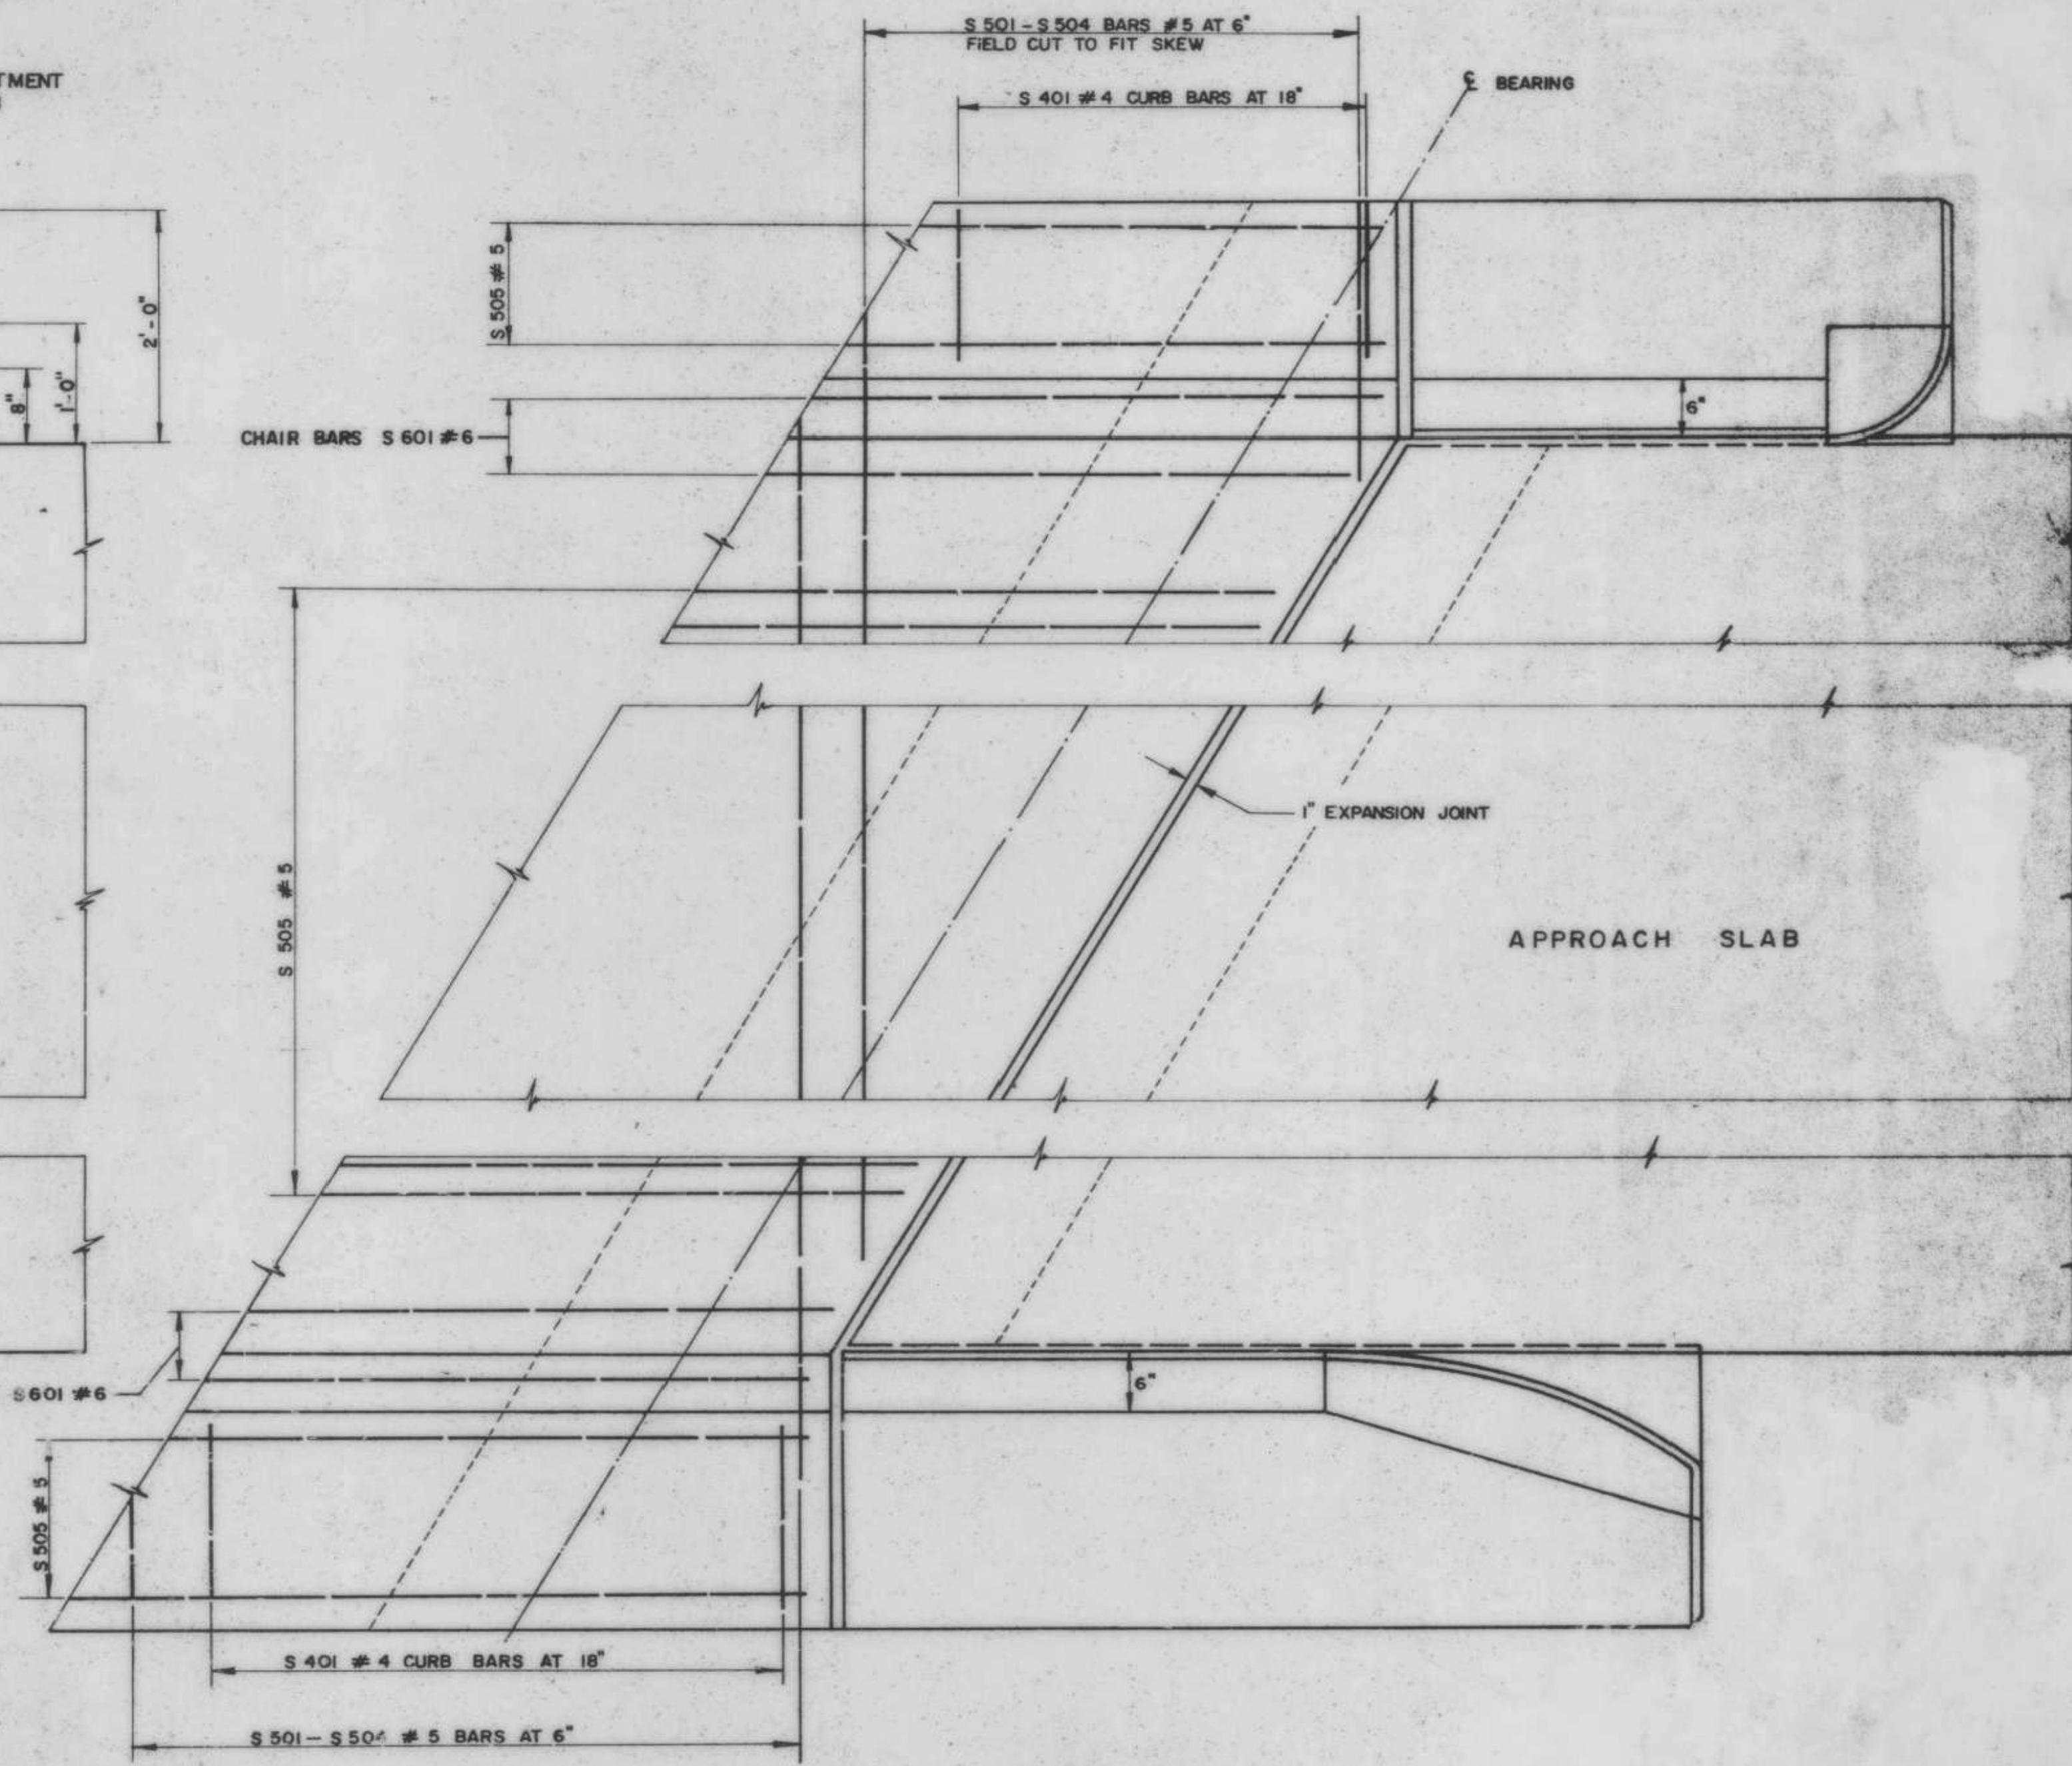

REINFORCEMENT LAYOUT AT ABUTMENT

* NOTE: DETAILS FOR "RAILING POST ON ABUTMENT WITH 2'-8\"/>

IRASBURG
IM DECK(46)
BRIDGE NO. 107N
SHEET 45 OF 49
FOR REFERENCE ONLY

REVISIONS AND CORRECTIONS
1. NOTE CONCERNING 2'-8" CURB SECTION ADDED DEC. 17, 1968 R.S.H.

DRAWN BY: A.V. DEC. 1962
 RETRACED BY: A.J.A. MAY 1967
 CHECKED BY: W. SMITH DEC. 1967
 RECOMMENDED FOR APPROVAL: [Signature] BRIDGE ENGINEER 1/24/68
 RECOMMENDED FOR APPROVAL: [Signature] CONSTRUCTION ENGINEER 1/24/68
 RECOMMENDED FOR APPROVAL: [Signature] ASST. CHIEF ENGINEER 1/24/68
 APPROVED BY: [Signature] CHIEF ENGINEER 1/24/68

DETAILS OF W F BEAM BRIDGES
PLAN AND REINFORCEMENT LAYOUT AT ABUTMENT

VERMONT
DEPARTMENT OF HIGHWAYS
STRUCTURE STANDARDS
SCB-D4-67