

RECORD PLANS

PREPARED BY TJW

Record Plans

Contractor: DIRT TECH COMPANY, LLC
 Resident Engineer: GREG WILCOX
 Construction Began: AUGUST 25, 2017
 Construction Complete: OCTOBER 23, 2018
 Record Plans By: TAYLOR WARING & JESSE IVES

I hereby certify that all construction required by this set of drawings has been accomplished as indicated herein.

E-SIGNED by Greg Wilcox on 2019-02-11 18:12:39 UTC Resident Engineer

Date: February 11, 2019

NOTE: Any further information concerning final quantities, amounts or other details relative to this project may be found at Central Files in the electronic archives.

STATE OF VERMONT AGENCY OF TRANSPORTATION





PROPOSED IMPROVEMENT CITY OF SOUTH BURLINGTON COUNTY OF CHITTENDEN I-189 (PRINCIPAL ARTERIAL - INTERSTATE - NHS)

BEGINNING IN THE CITY OF SOUTH BURLINGTON ON THE WESTBOUND LANES OF INTERSTATE 189 AT MM 1.184 (STA. 62+50) EXTENDING EASTERLY 0.028 MILES (150 FEET) TO MM 1.212 (STA. 64+00).


LENGTH OF PROJECT: 150.00 FT = 0.028 MILES

WORK TO BE PERFORMED UNDER THIS PROJECT INCLUDES REHABILITATION OF AN EXISTING CULVERT WITH AN ULTRAVIOLET CURED IN-PLACE PIPE LINER, SLOPE STABILIZATION, DRAINAGE IMPROVEMENTS, TRAFFIC CONTROL AND OTHER HIGHWAY RELATED ITEMS.

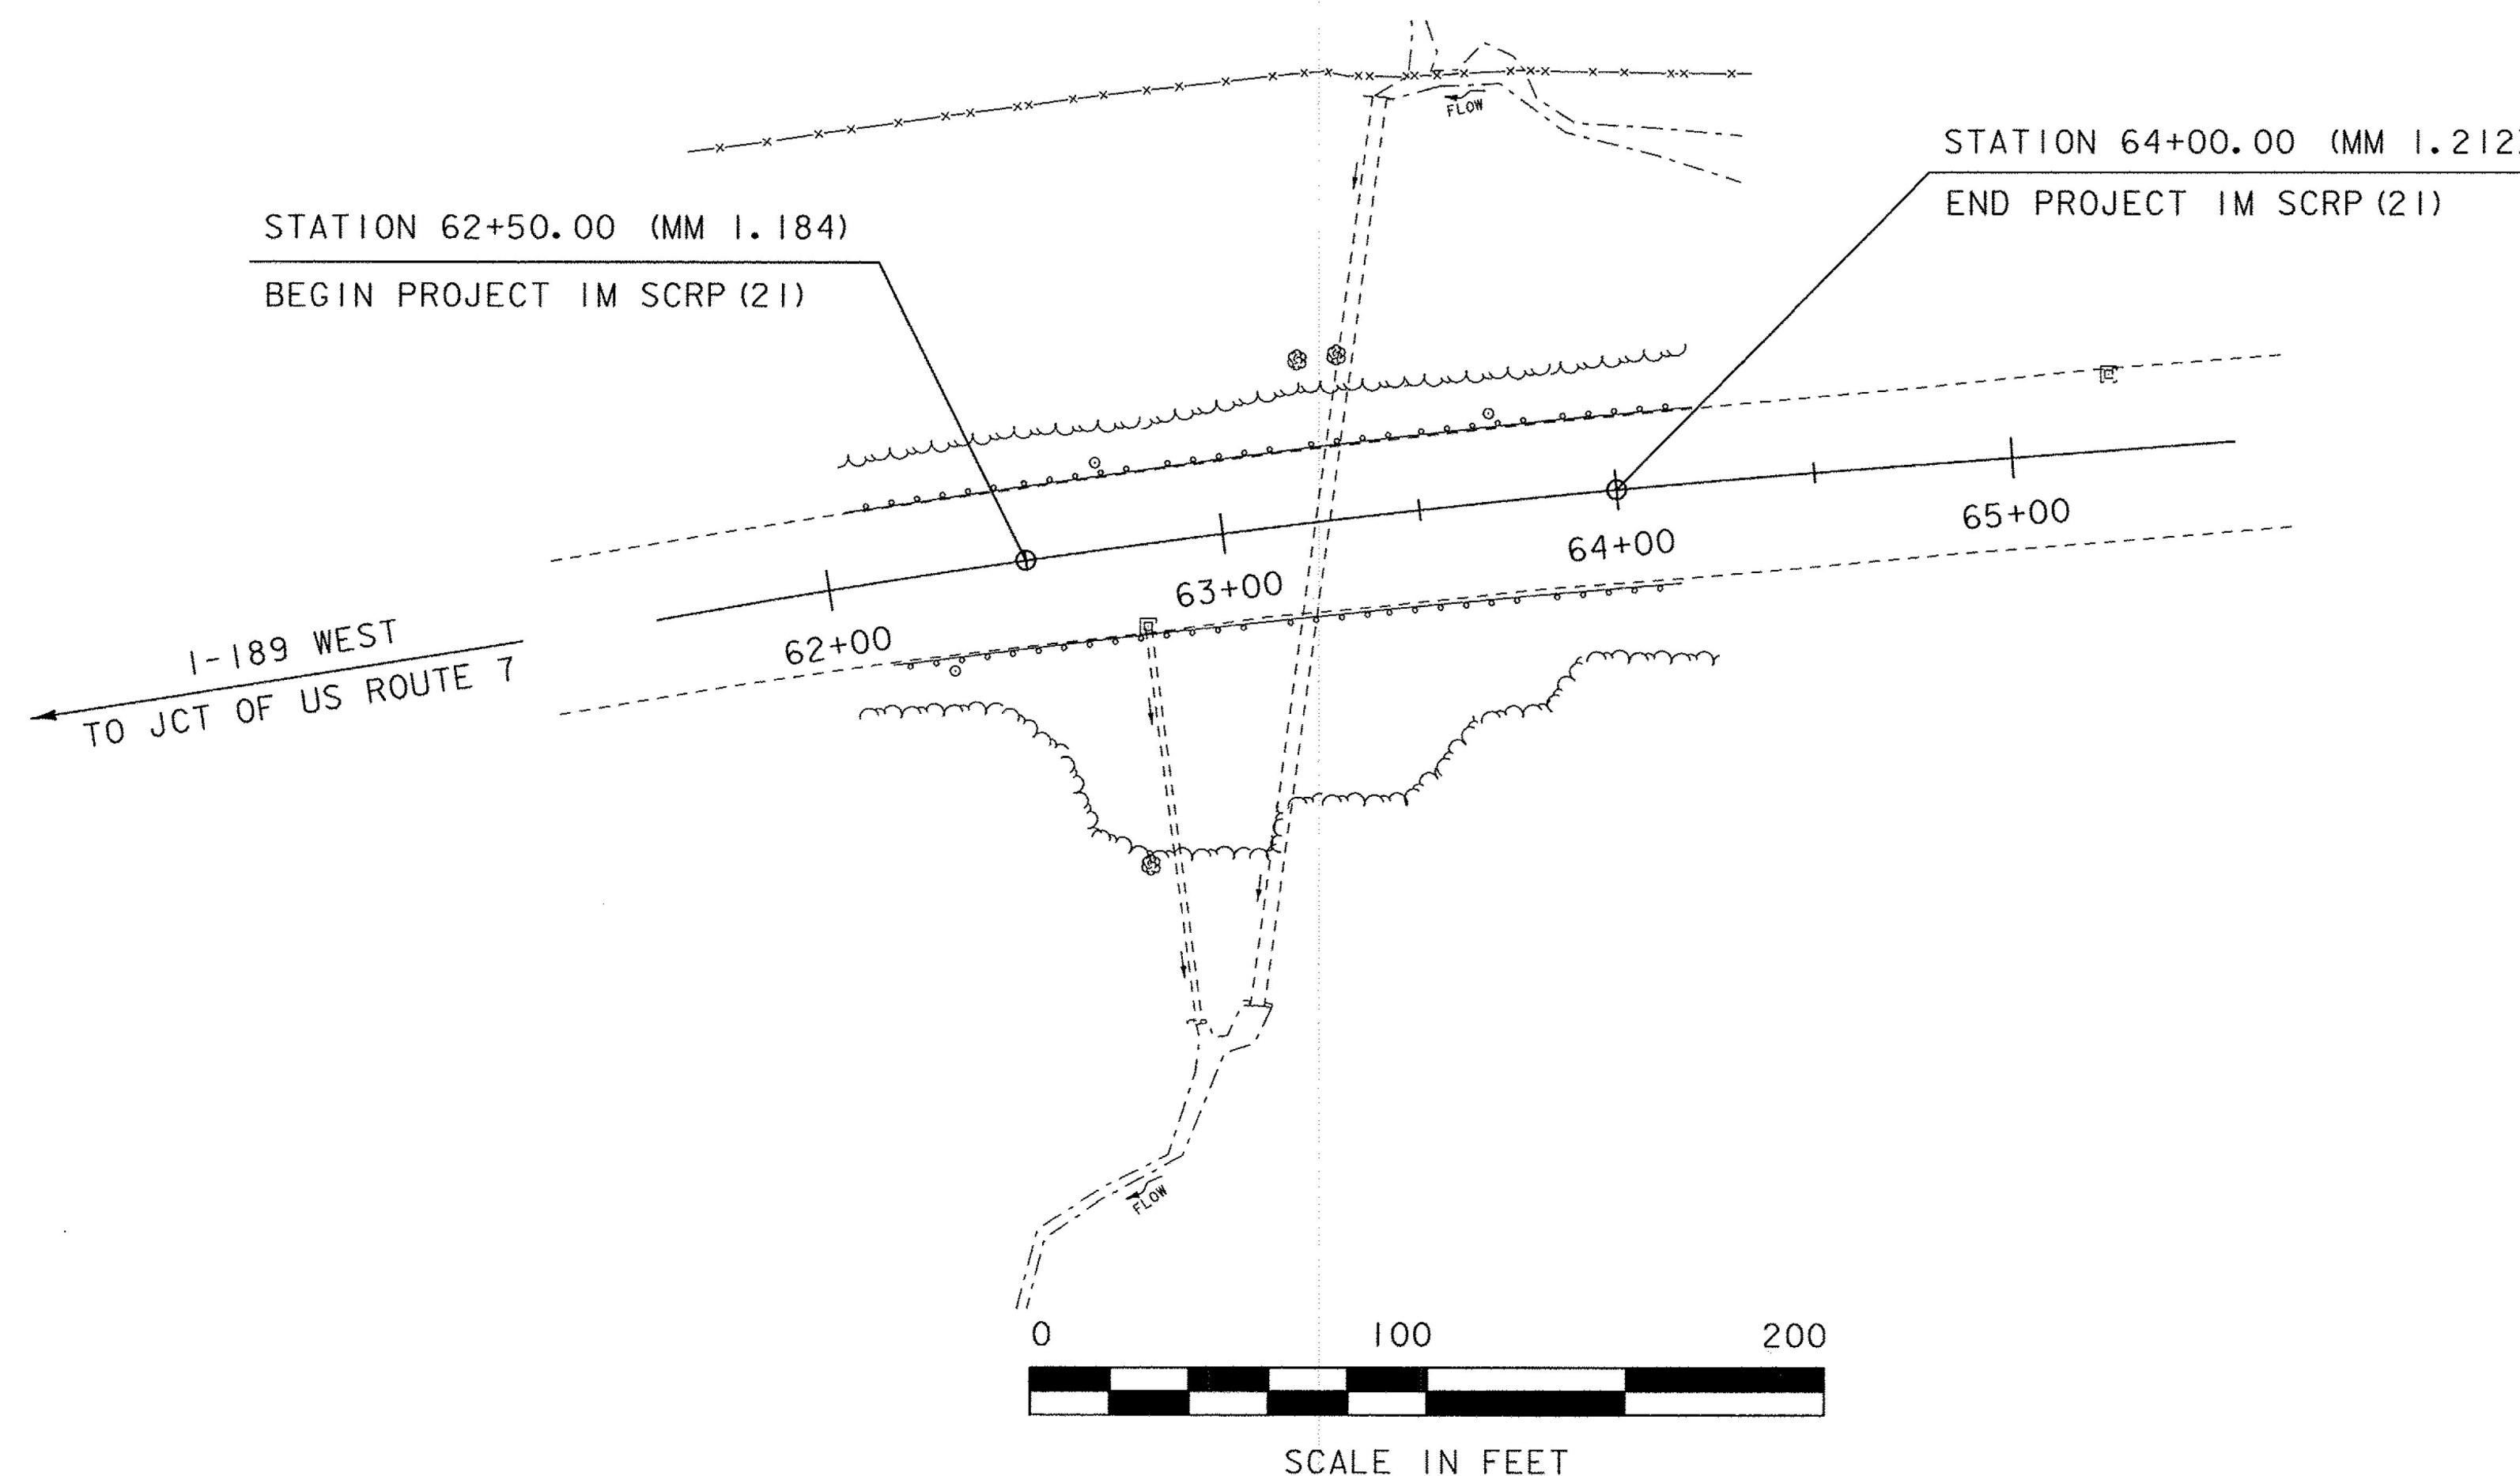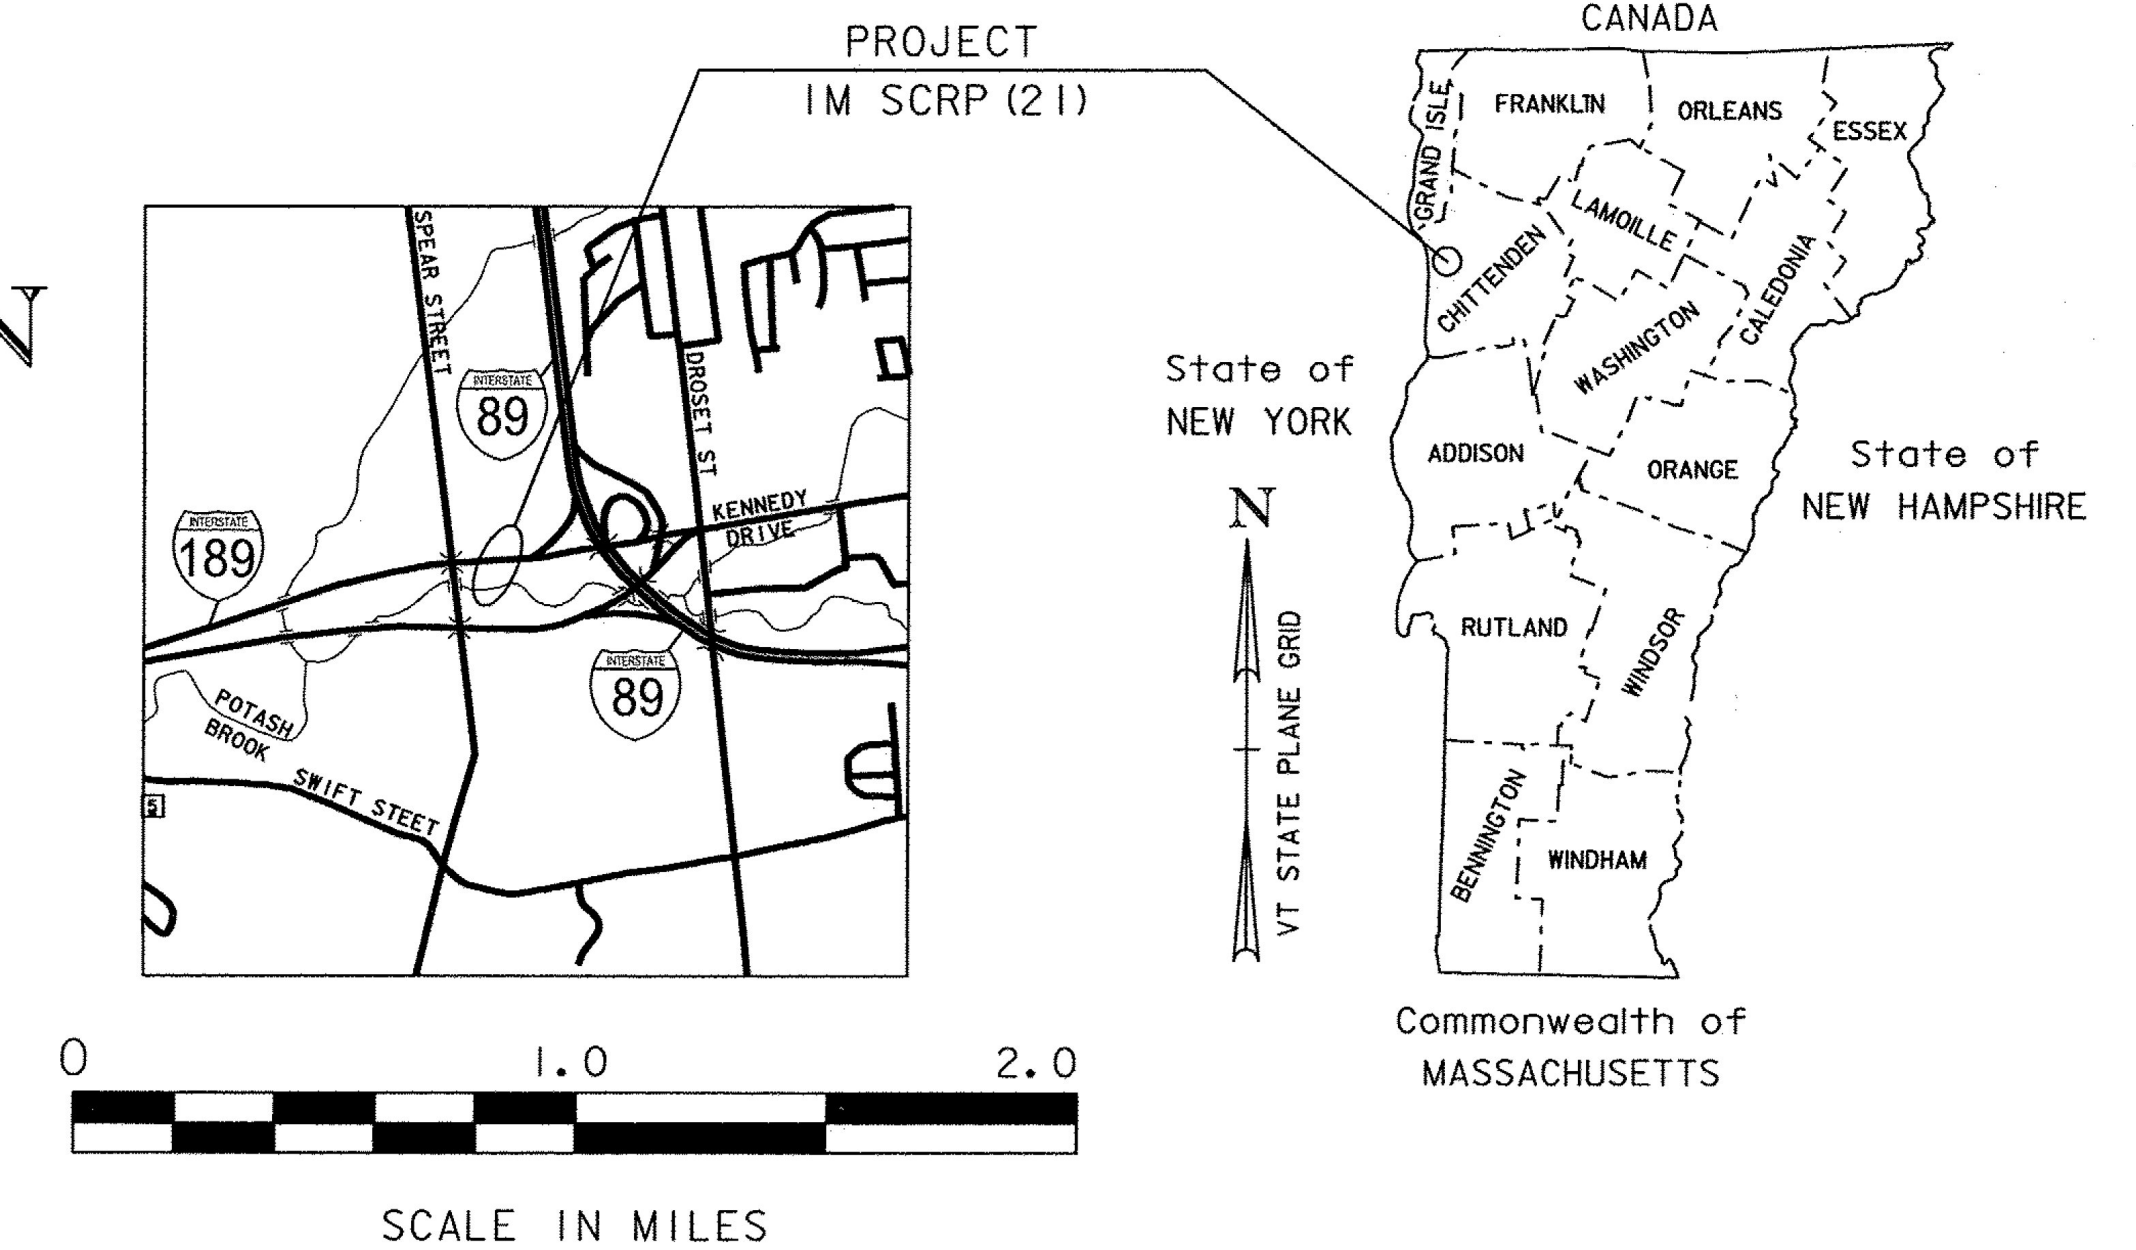

CONSTRUCTION IS TO BE CARRIED ON IN ACCORDANCE WITH THESE PLANS AND THE STANDARD SPECIFICATIONS FOR CONSTRUCTION DATED 2011, AS APPROVED BY THE FEDERAL HIGHWAY ADMINISTRATION ON JULY 20, 2011 FOR USE ON THIS PROJECT, INCLUDING ALL SUBSEQUENT REVISIONS AND SUCH REVISED SPECIFICATIONS AND SPECIAL PROVISIONS AS ARE INCORPORATED IN THESE PLANS.

| | |
|-------------------------------------|---------------|
| QUALITY ASSURANCE PROGRAM : LEVEL 1 | |
| SURVEYED BY : | VAOT |
| SURVEYED DATE : | 03/29/2016 |
| DATUM | |
| VERTICAL | NAVD88 |
| HORIZONTAL | NAD 83 (2011) |

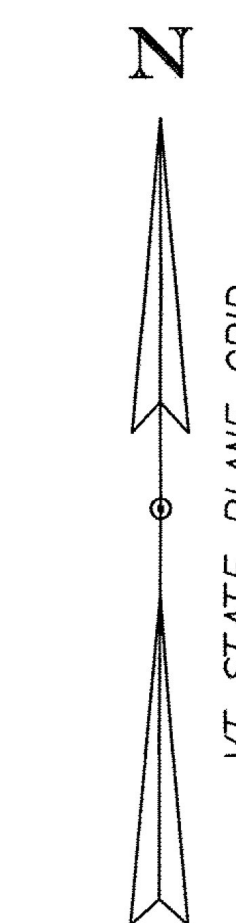

| | |
|------------------------------|------------------|
| DIRECTOR OF PROJECT DELIVERY | |
| APPROVED: | DATE 4/19/2017 |
| PROJECT MANAGER : | KEN UPMAL, P.E. |
| PROJECT NAME : | SOUTH BURLINGTON |
| PROJECT NUMBER : | IM SCR(21) |
| SHEET 1 OF 29 SHEETS | |