


BARRIER FENCE
 STA. 62+59 - 62+67 RT
 STA. 62+71 - 63+50 RT
 STA. 63+18 - 63+61 LT
 STA. 63+42 - 63+81 LT

TEMPORARY EROSION MATTING
 STA. 62+69 - 63+40 RT
 STA. 63+43 - 63+71 LT

LEGEND

STABILIZED CONSTRUCTION ENTRANCE

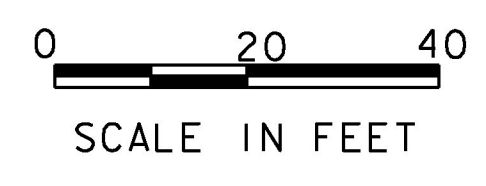

PROJECT NAME:	SOUTH BURLINGTON	PLOT DATE:	27-APR-2017
PROJECT NUMBER:	IM SCR(21)	DRAWN BY:	A. AGRAWAL
FILE NAME:	I6d064/Design/epsc.dgn	CHECKED BY:	C. LEACH
PROJECT LEADER:	K. UPMAL	SHEET	17 OF 30
DESIGNED BY:	C. LEACH		
EPSC CONSTRUCTION PLAN SHEET			