


AREA WITHIN THE WETLAND REQUIRING SEED WILL BE SEEDED WITH WET MEADOW DENTION MIX

LEGEND

■ DISTURBED AREA
REQUIRING RE-VEGETATION

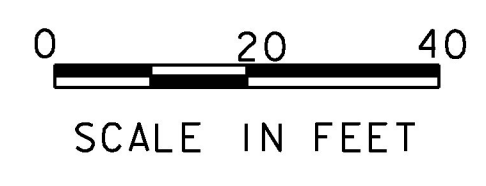

PROJECT NAME: SOUTH BURLINGTON	PLOT DATE: 27-APR-2017
PROJECT NUMBER: IM SCRP(21)	DRAWN BY: A. AGRAWAL
FILE NAME: I6d064/Design/epsc.dgn	CHECKED BY: C. LEACH
PROJECT LEADER: K. UPMAL	SHEET 18 OF 30
DESIGNED BY: C. LEACH	