




0+10
PIPE INLET

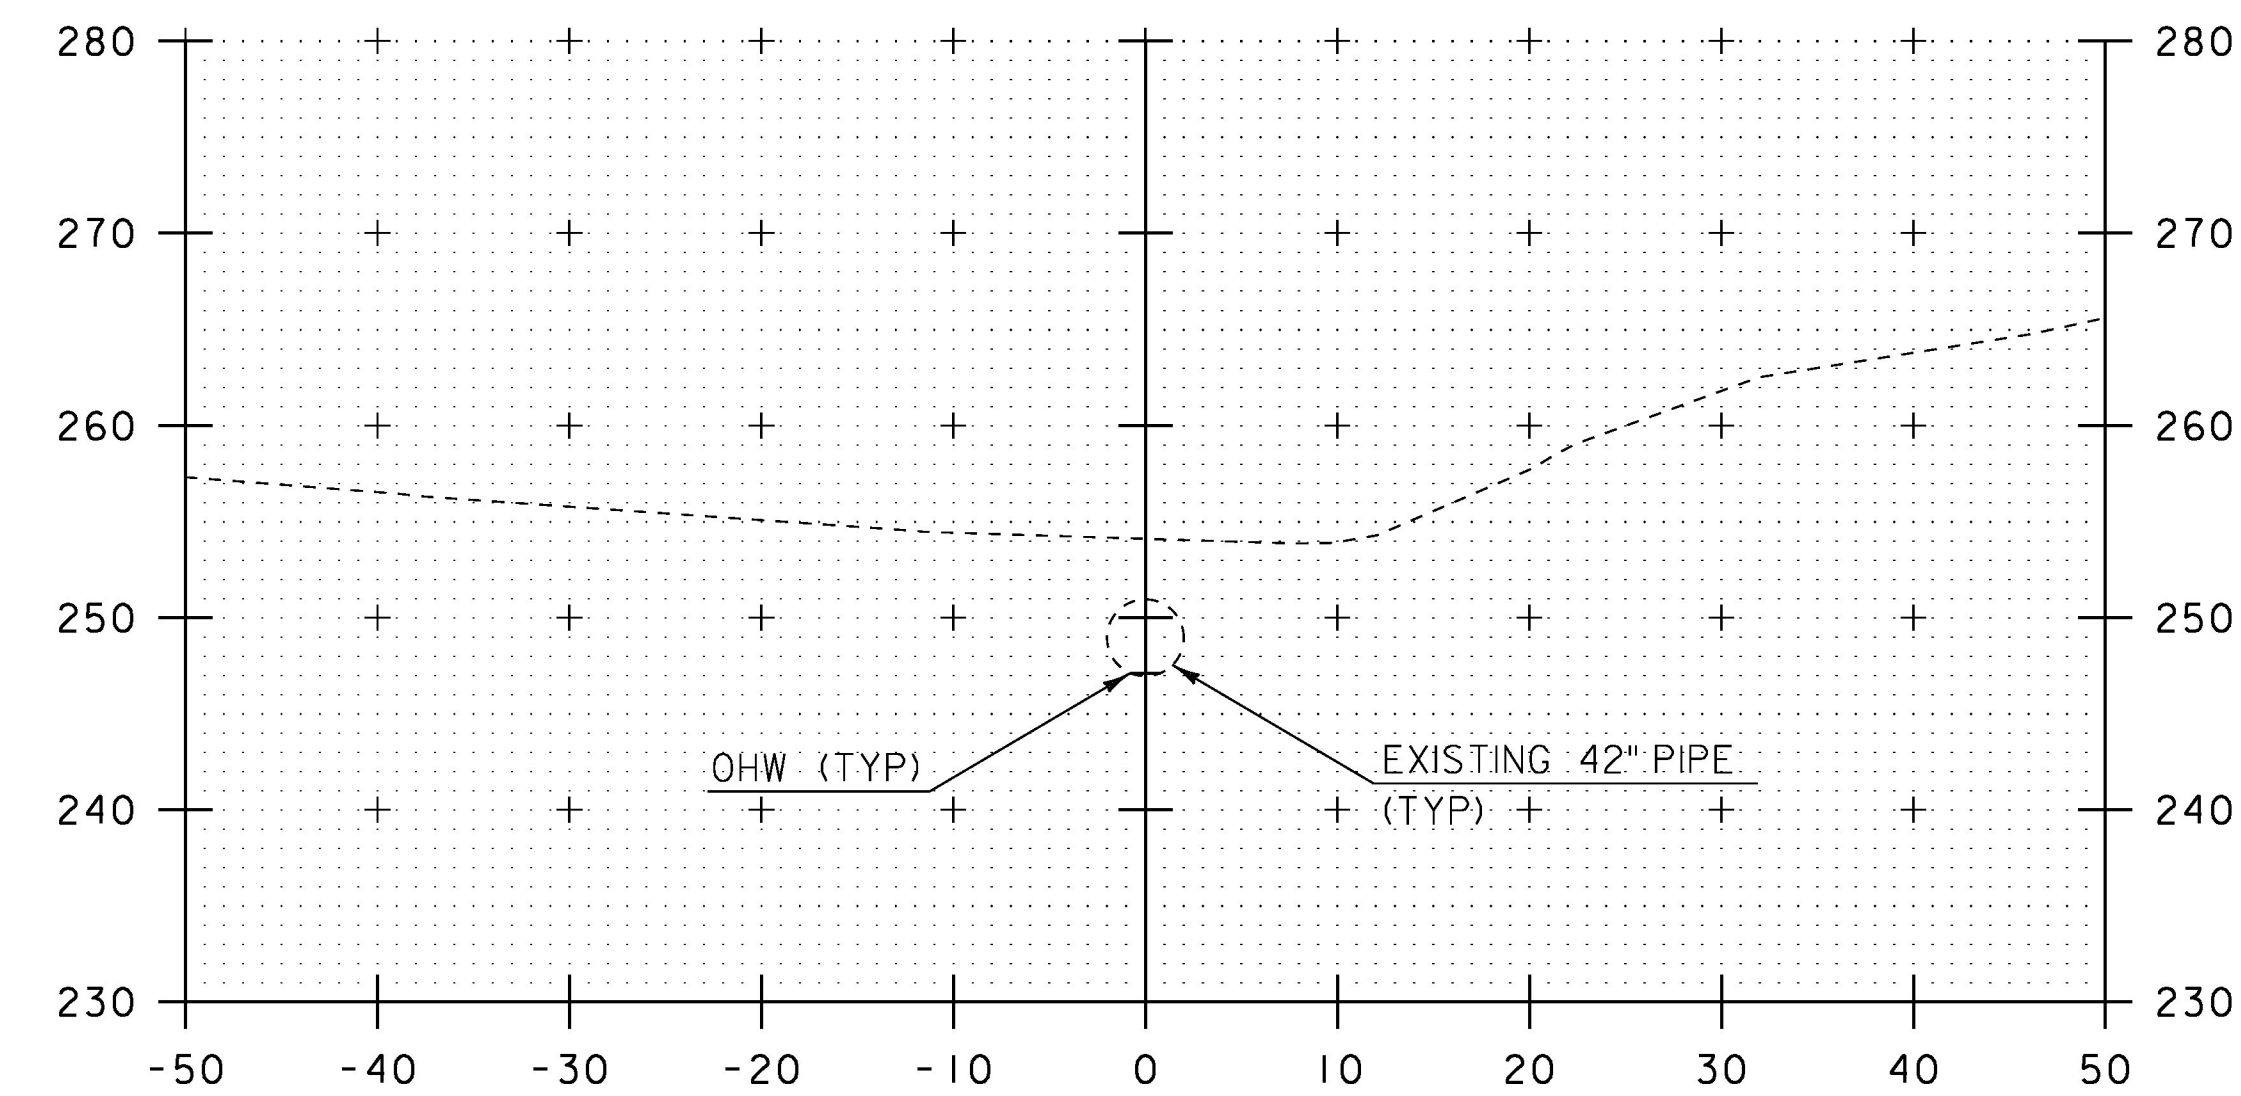

0+30

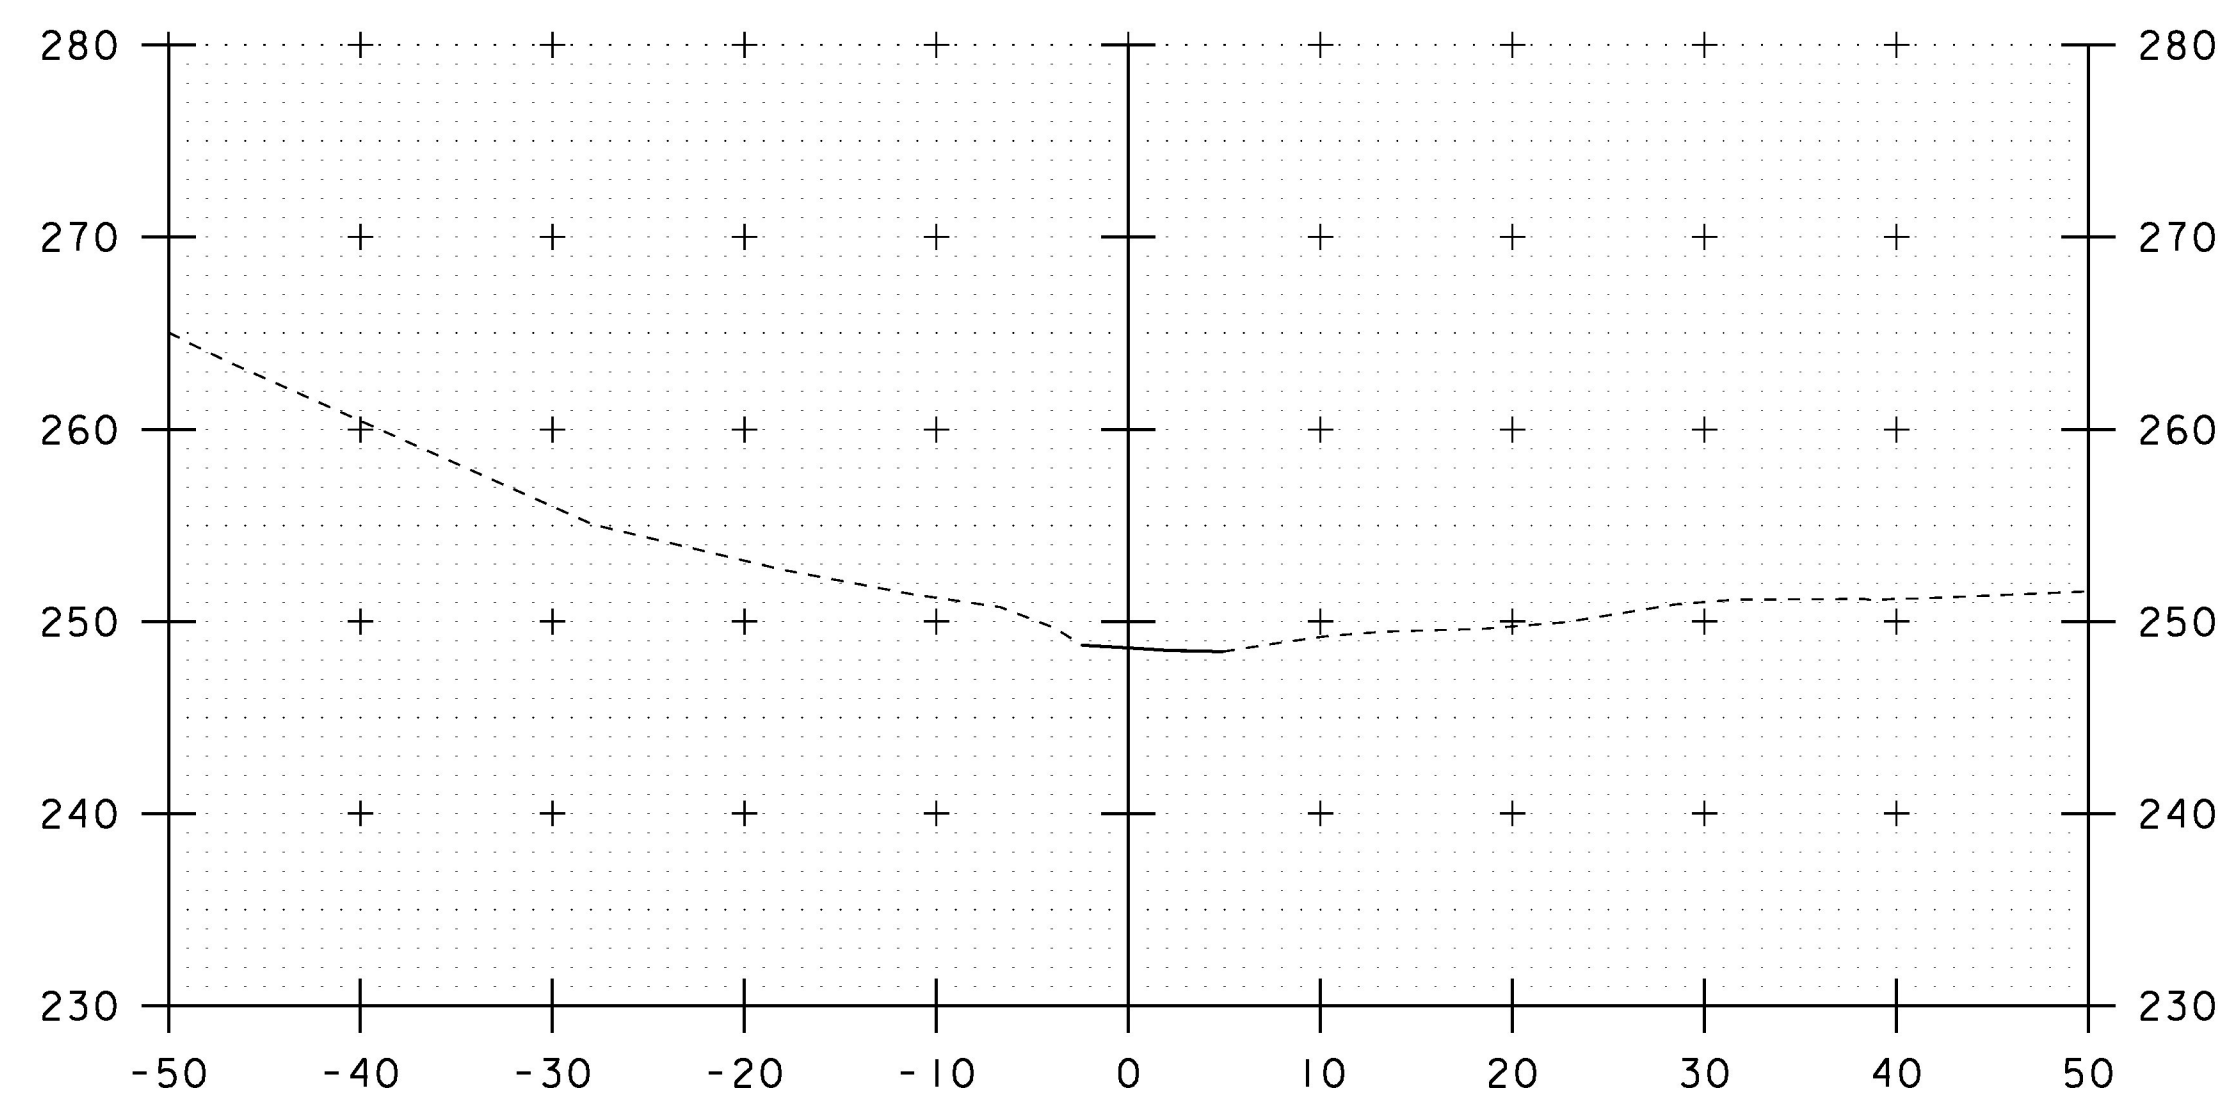

0+00

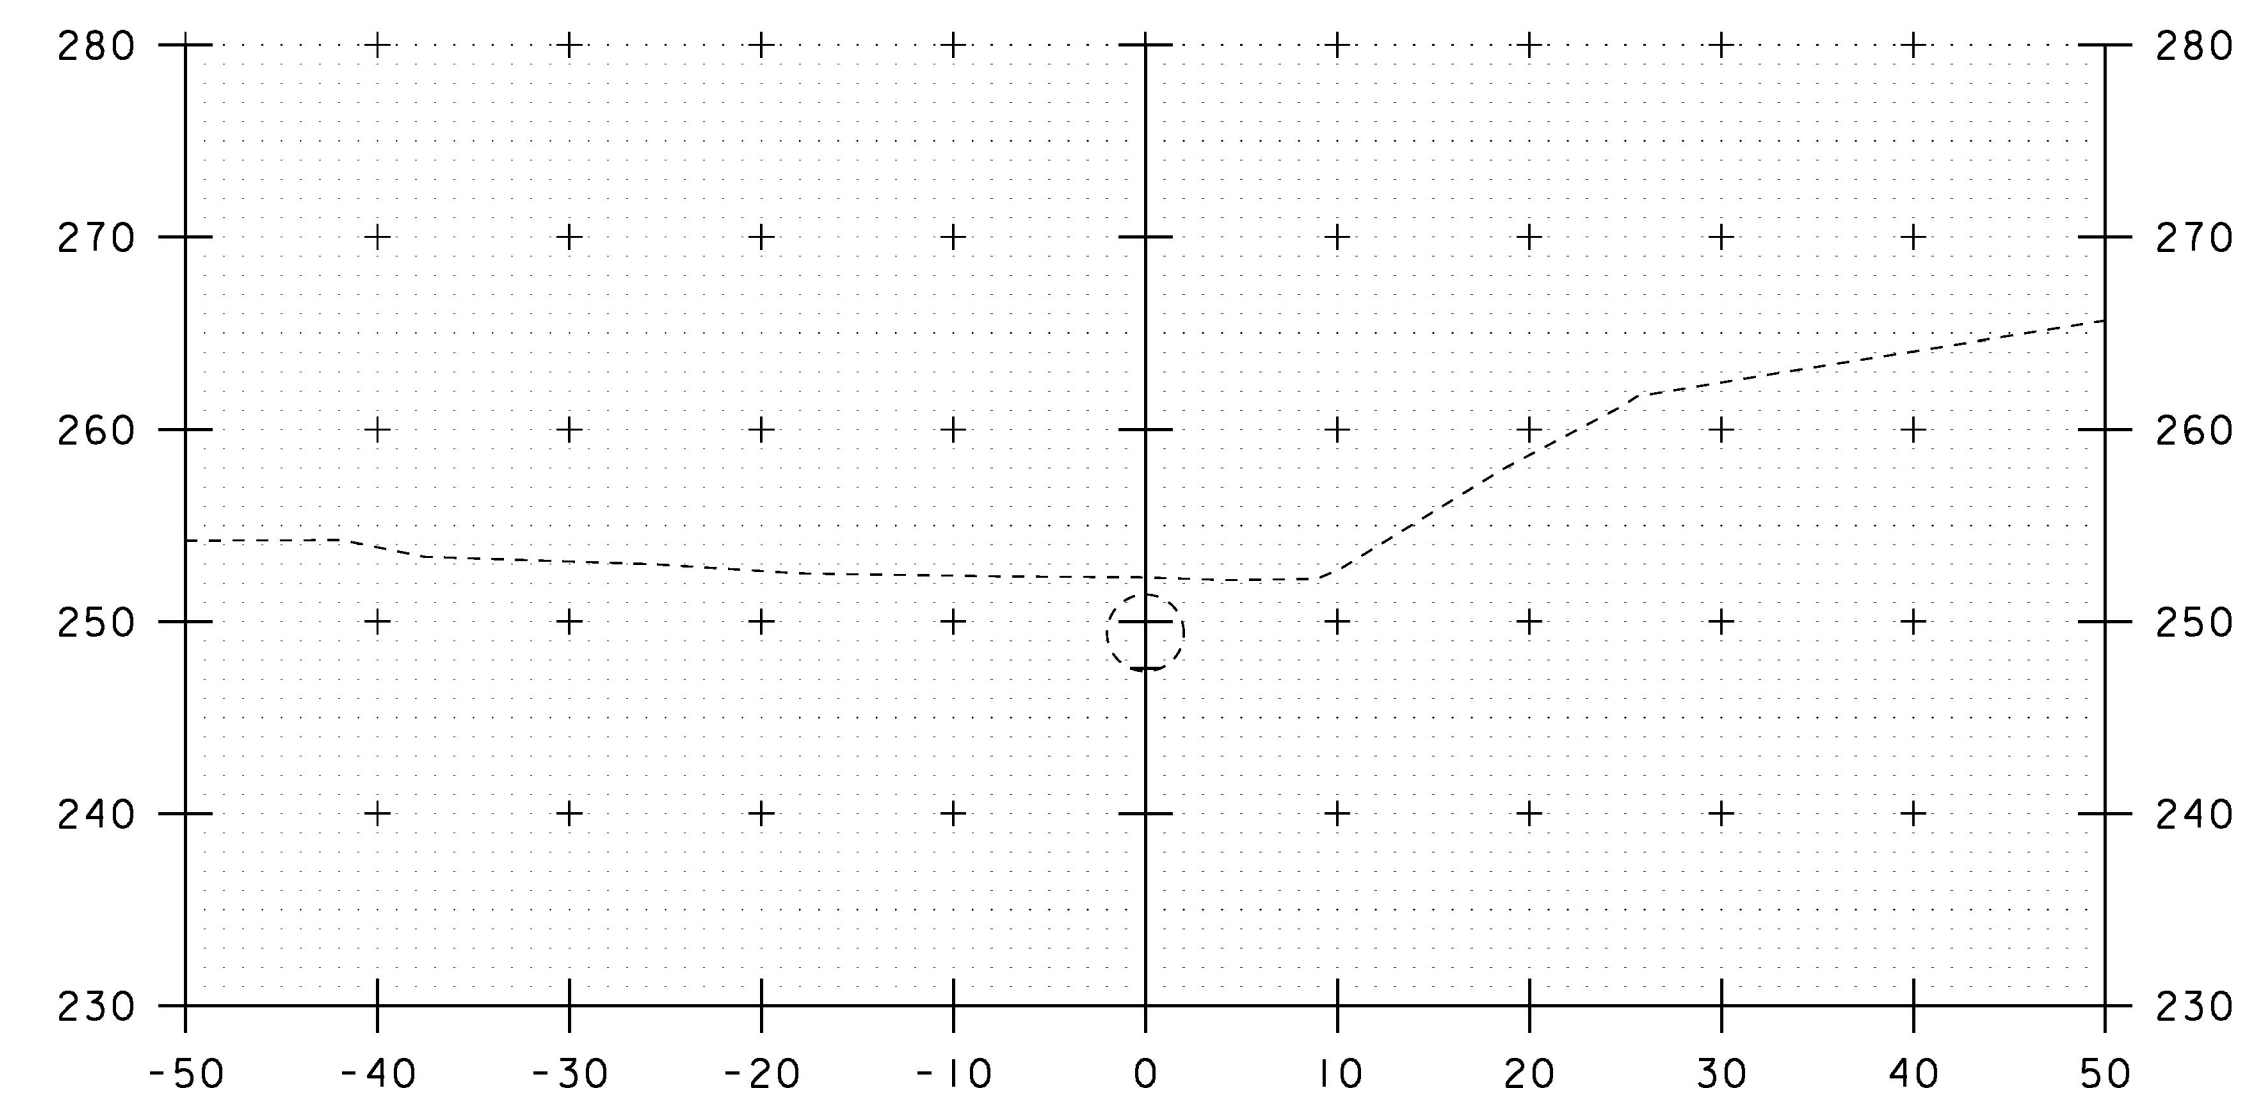

0+20

SCALE IN FEET

STA. 0+00 TO STA. 0+30

PROJECT NAME:	SOUTH BURLINGTON	PLOT DATE:	27-APR-2017
PROJECT NUMBER:	IM SCRP(21)	DRAWN BY:	C. LEACH
FILE NAME:	I6d064/Design/xs.dgn	CHECKED BY:	A. AGRAWAL
PROJECT LEADER:	K. UPMAL	SHEET	19 OF 30
DESIGNED BY:	C. LEACH		
PIPE CROSS SECTION SHEET I			