




0+50

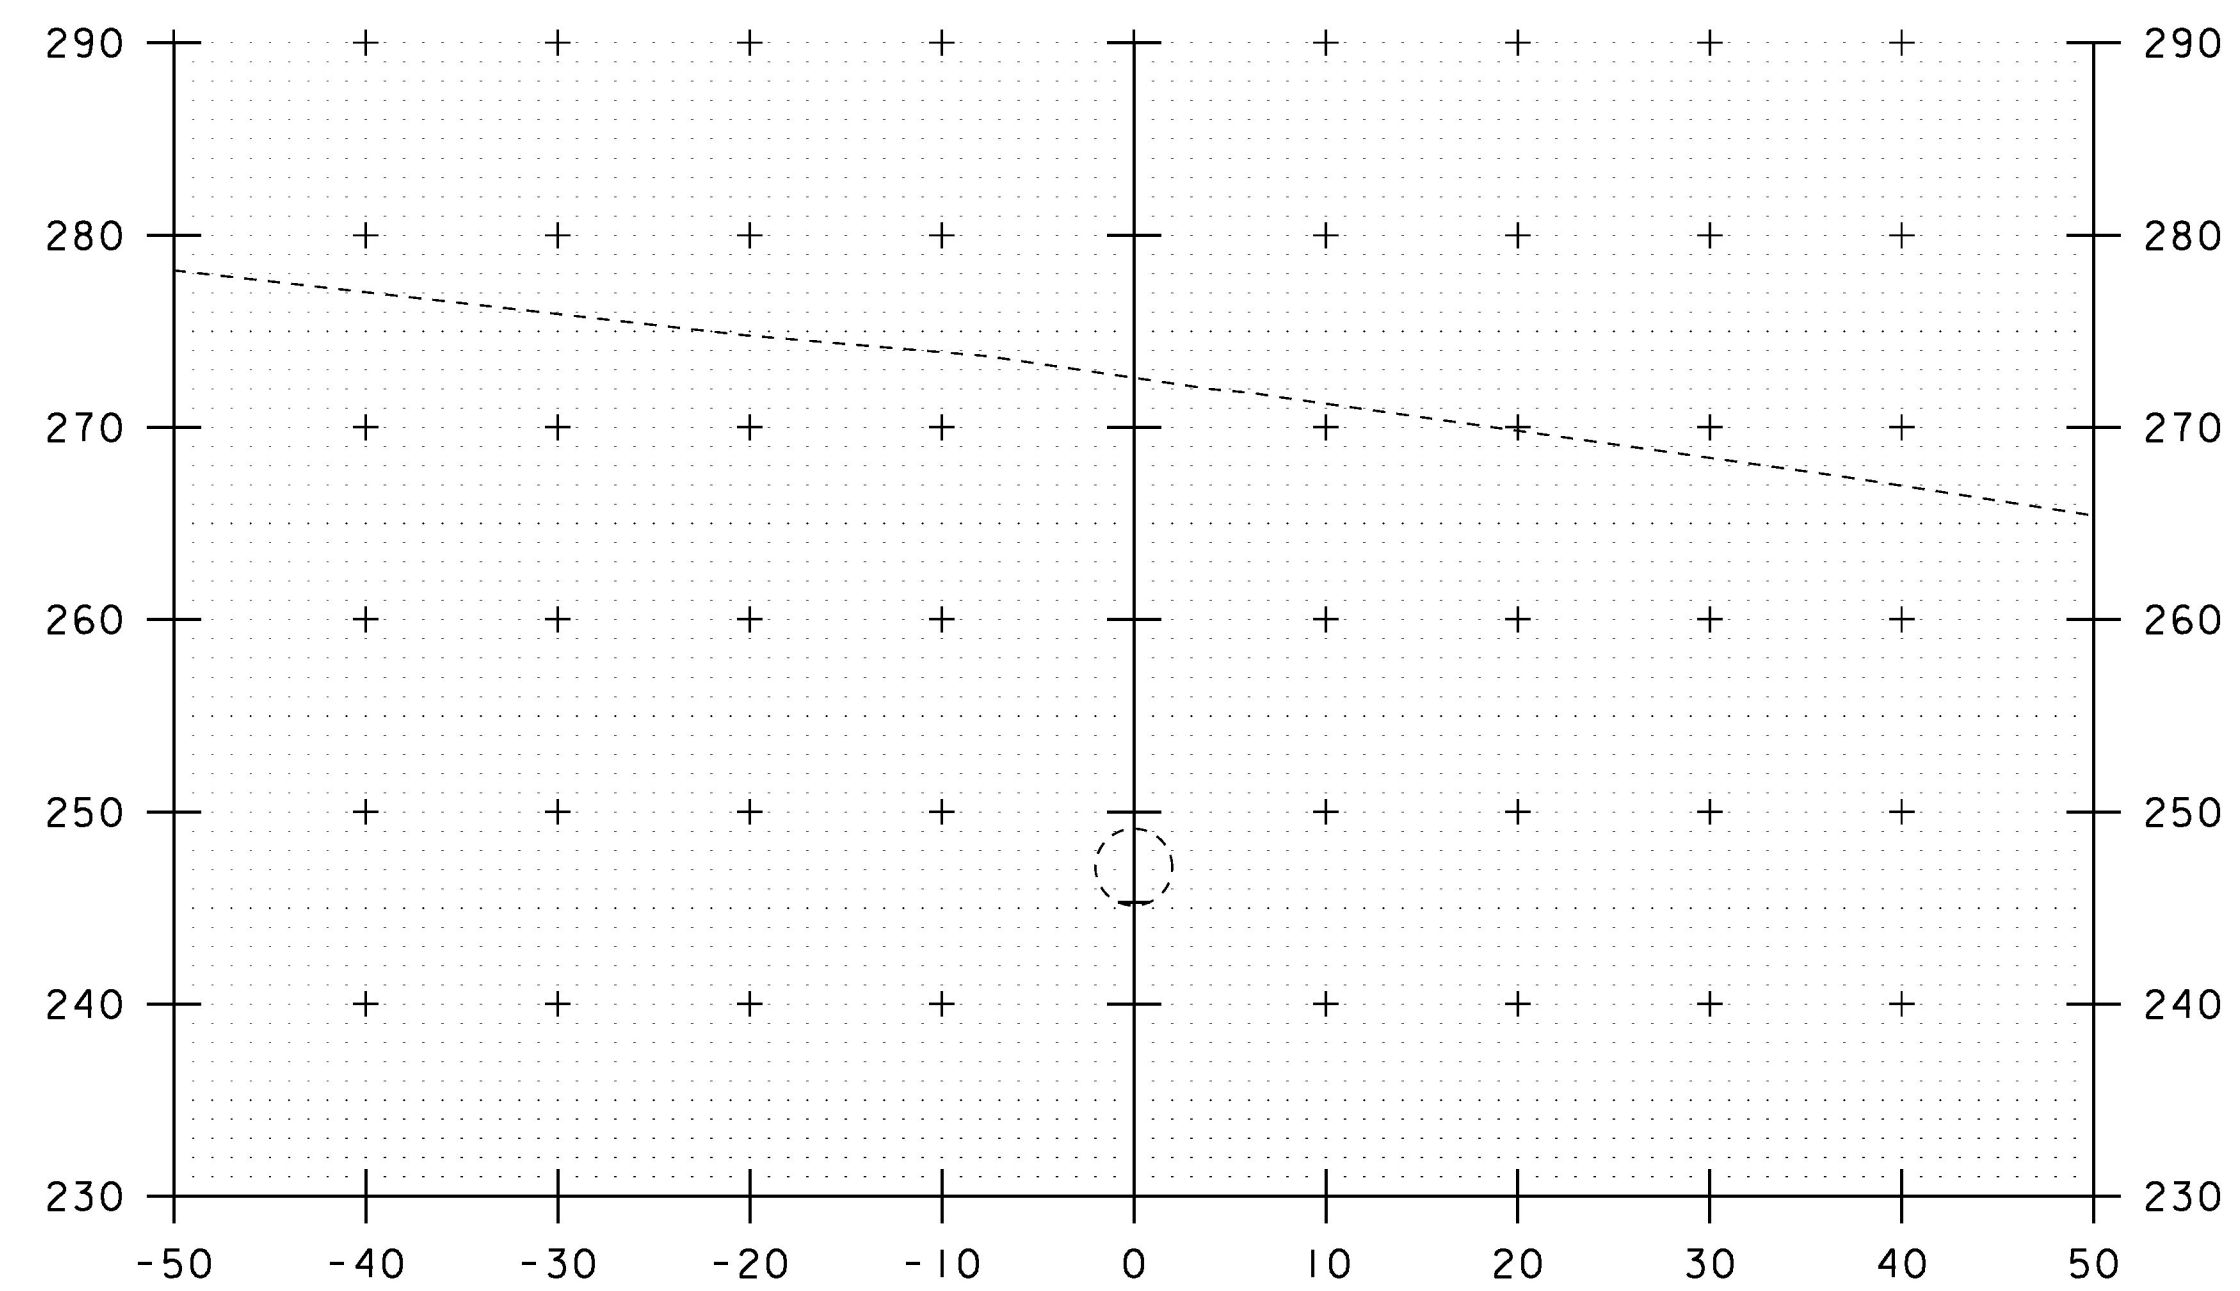

0+70

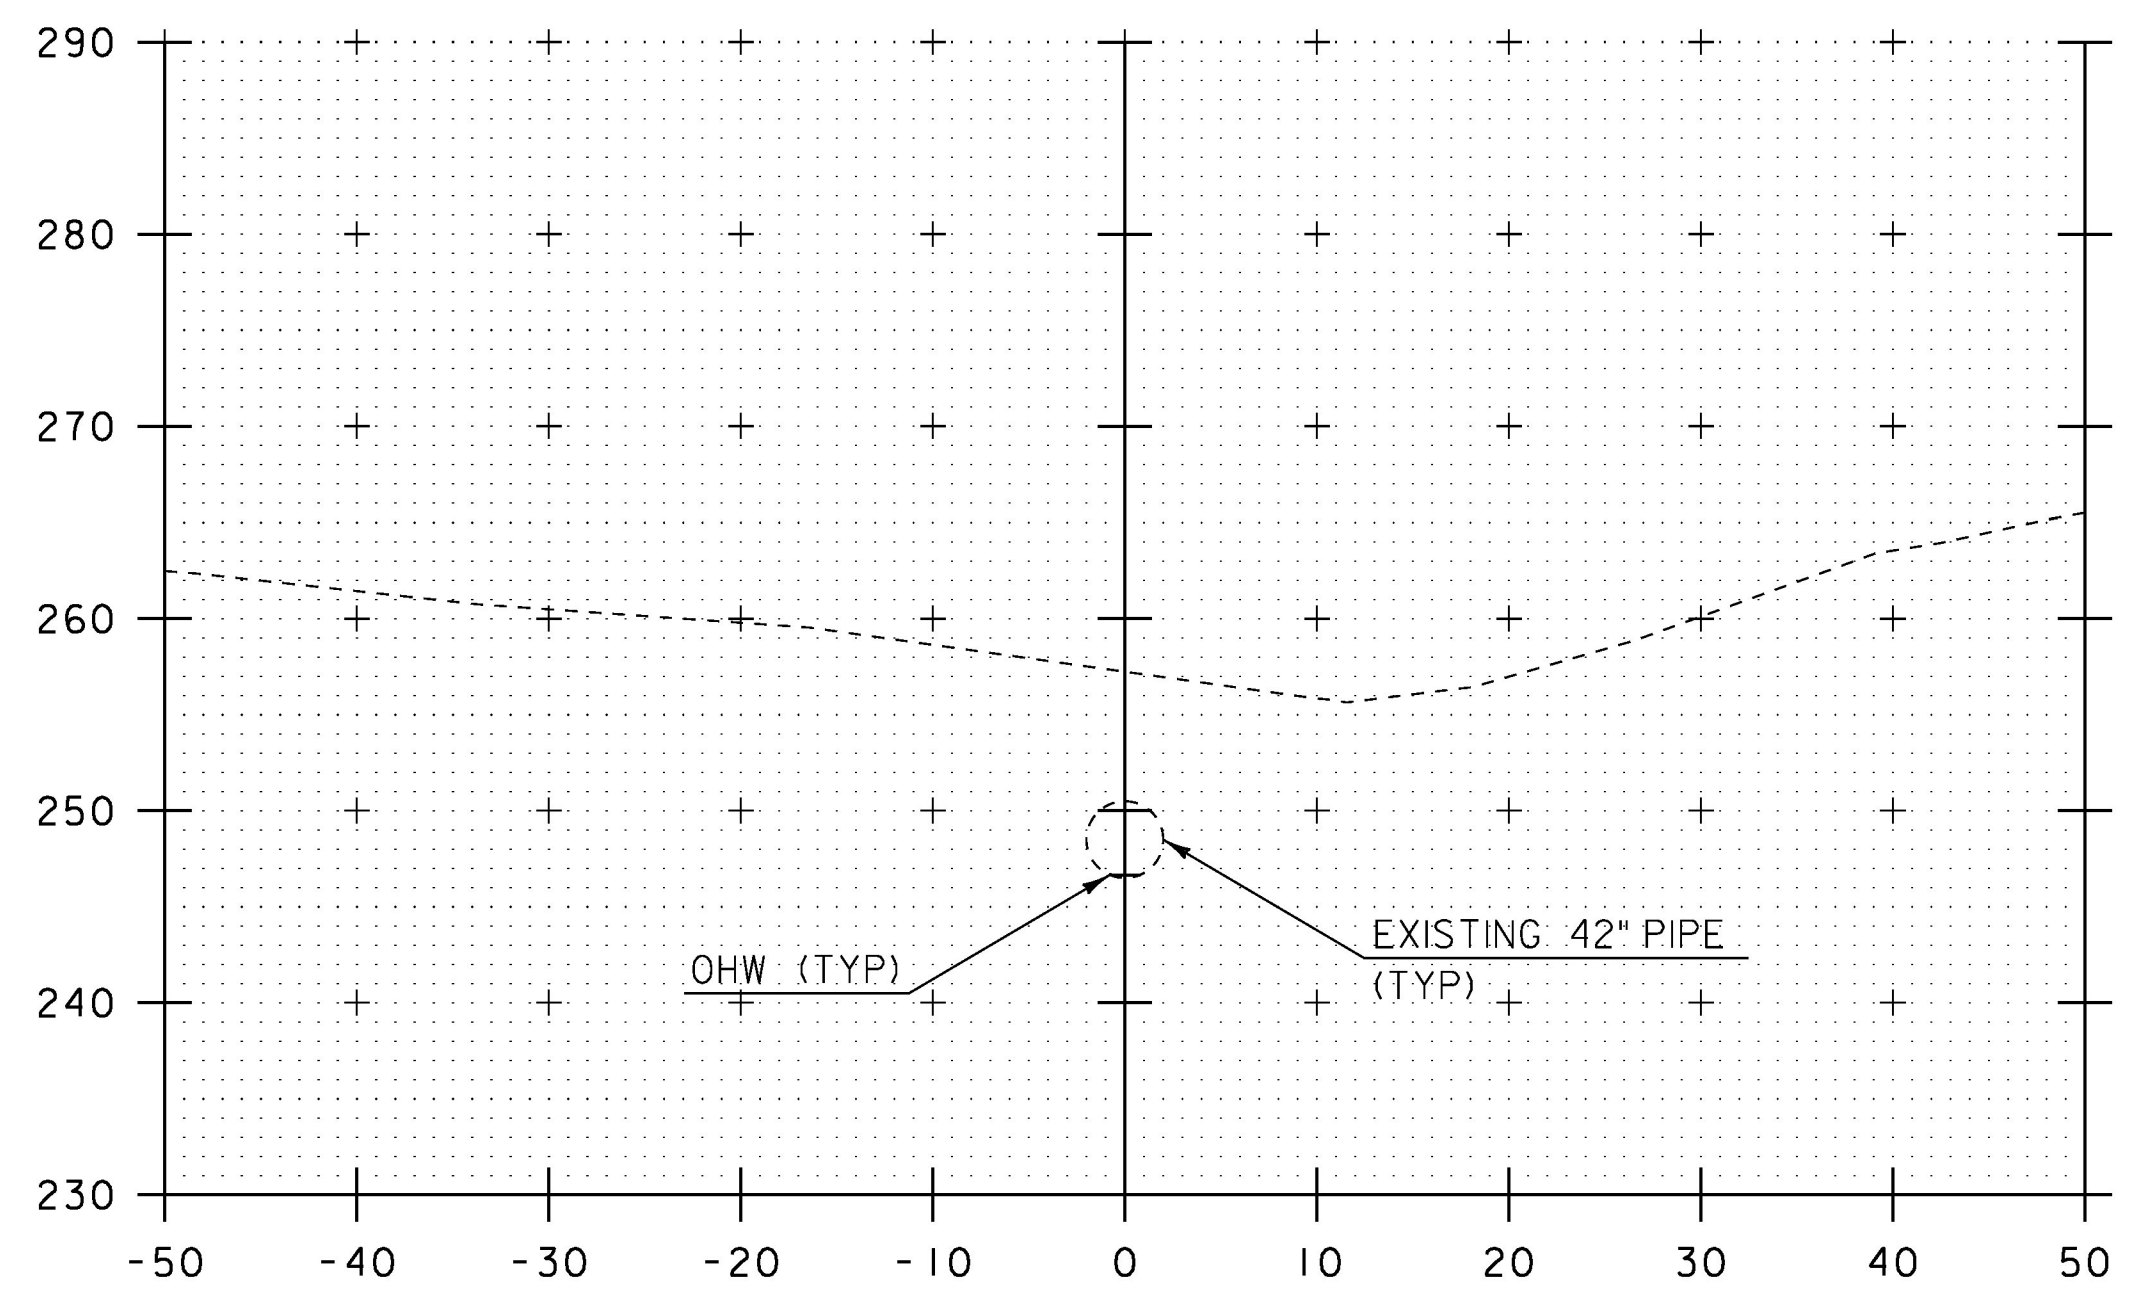

0+40

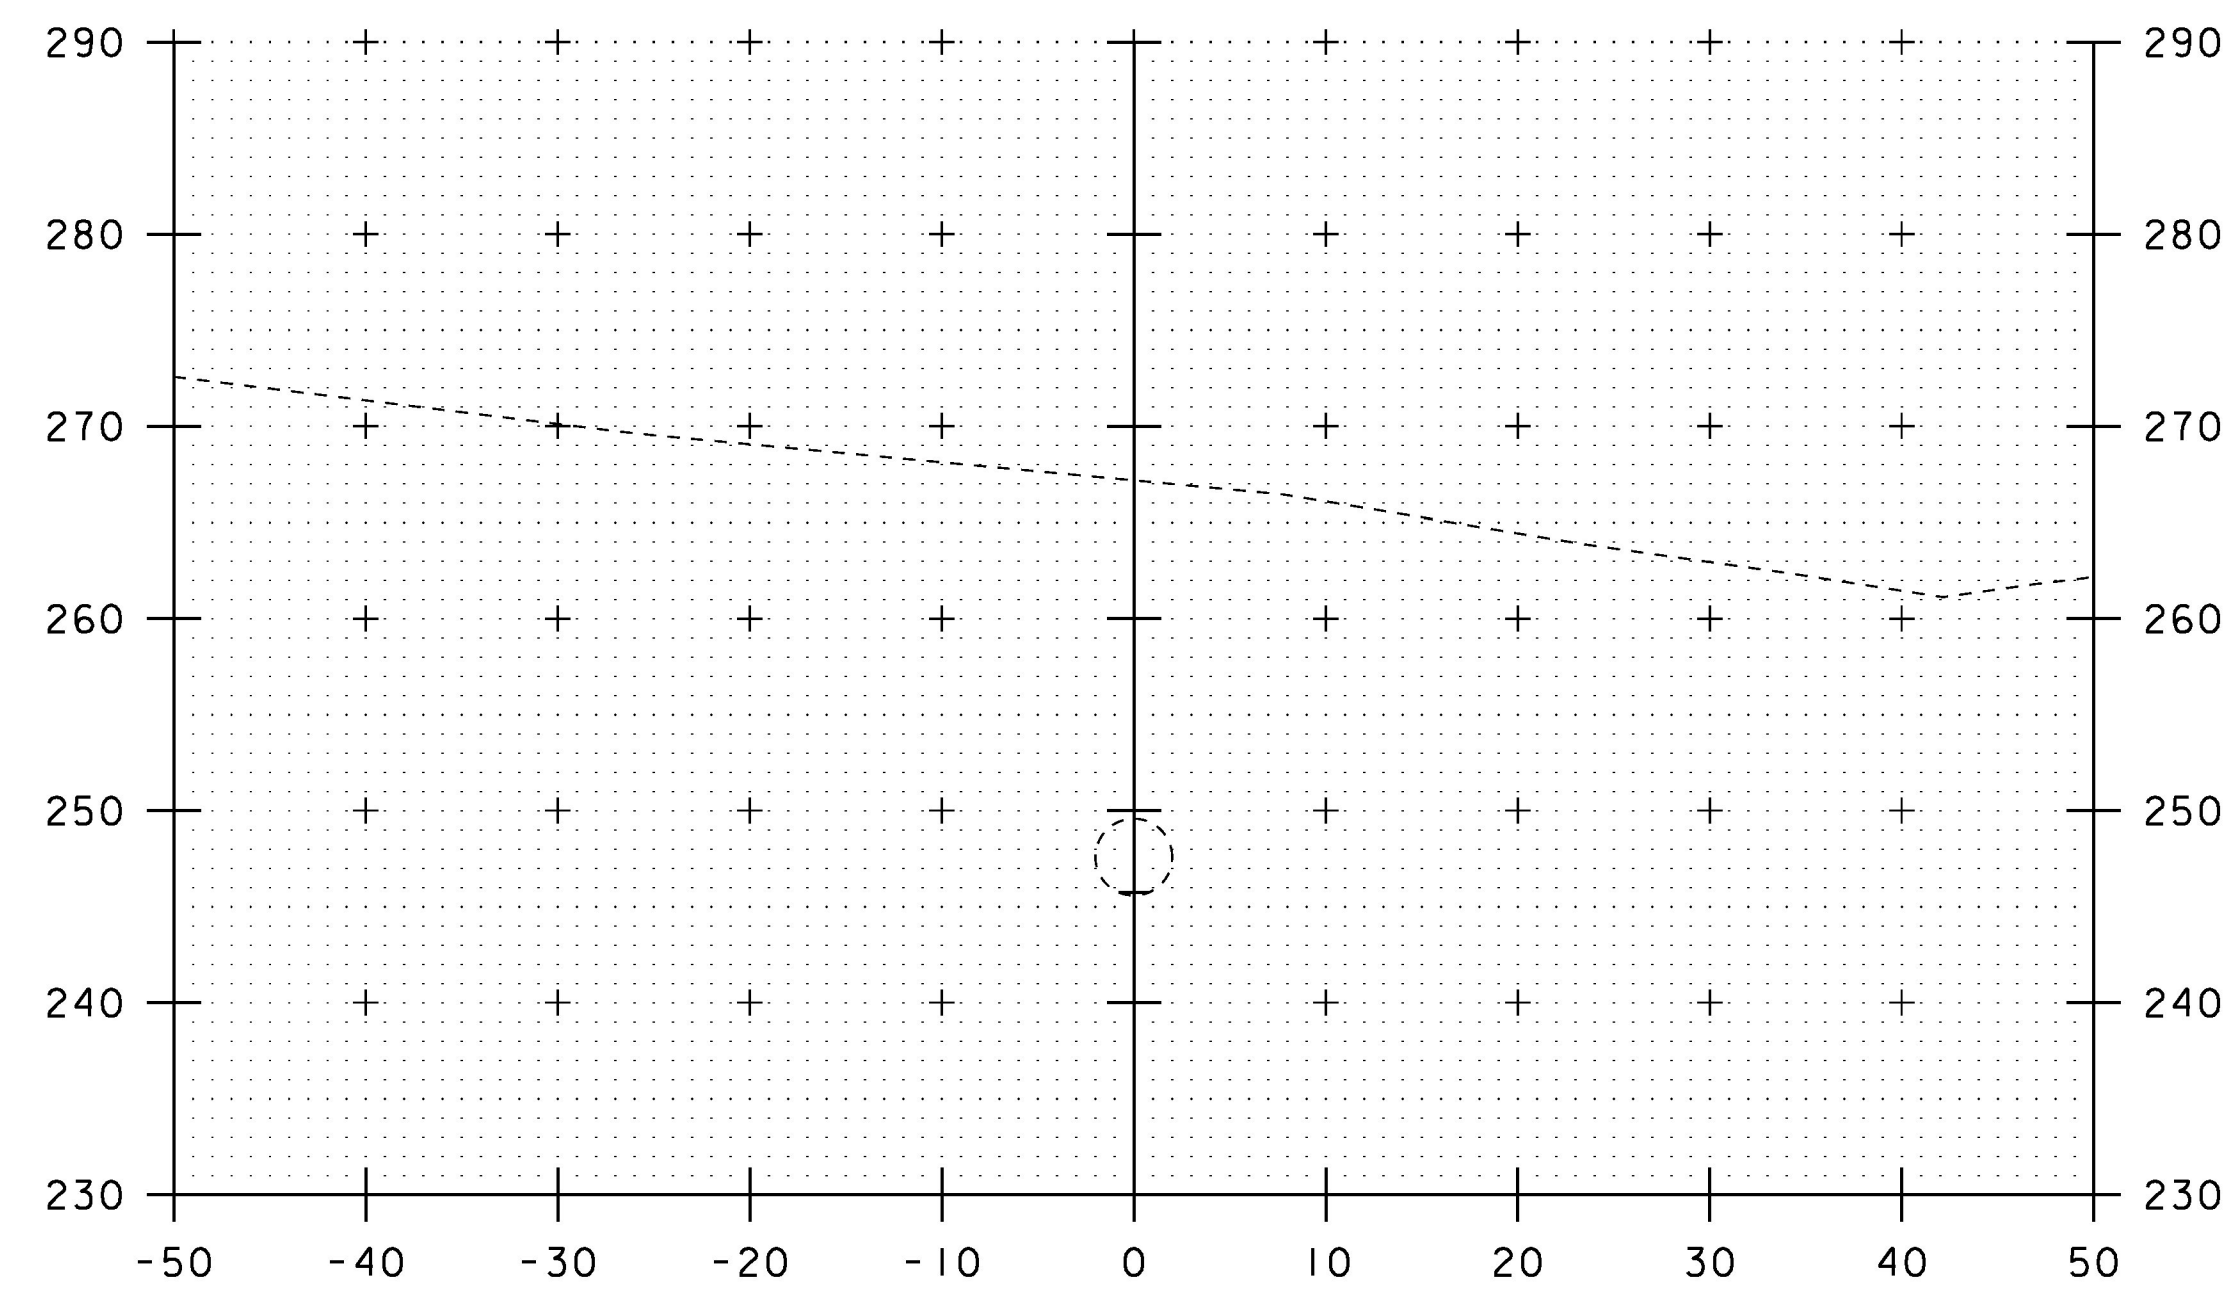

0+60

SCALE IN FEET

STA. 0+40 TO STA. 0+70

PROJECT NAME: SOUTH BURLINGTON	
PROJECT NUMBER: IM SCRP(21)	
FILE NAME: I6d064/Design/nul.dgn	PLOT DATE: 27-APR-2017
PROJECT LEADER: K. UPMAL	DRAWN BY: C. LEACH
DESIGNED BY: C. LEACH	CHECKED BY: A. AGRAWAL
PIPE CROSS SECTION SHEET 2	SHEET 20 OF 30