




I+30

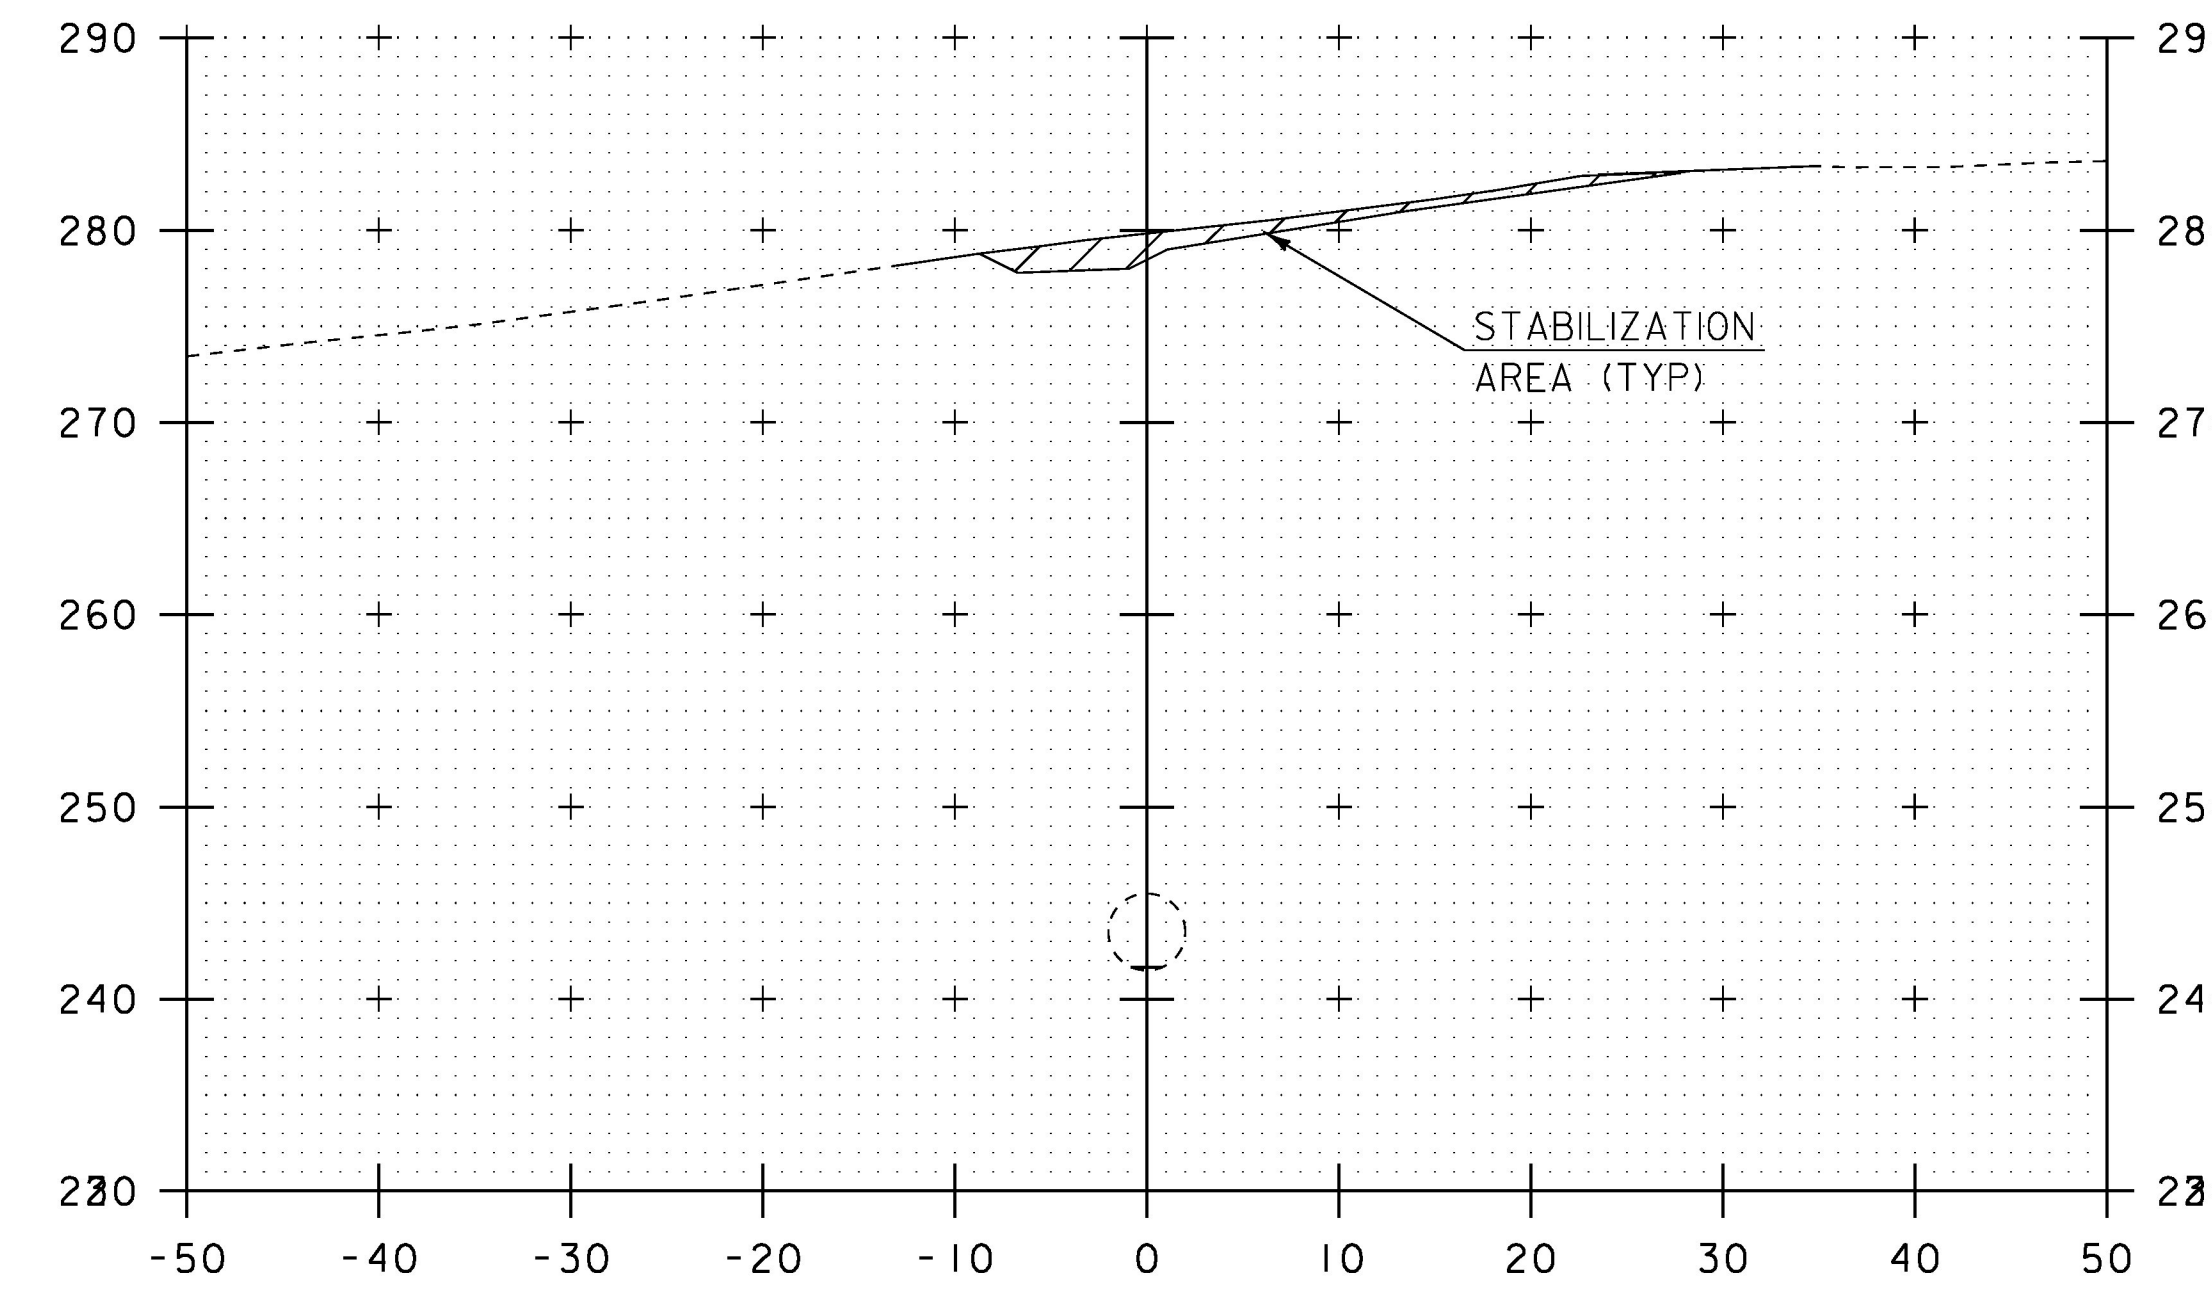

I+50

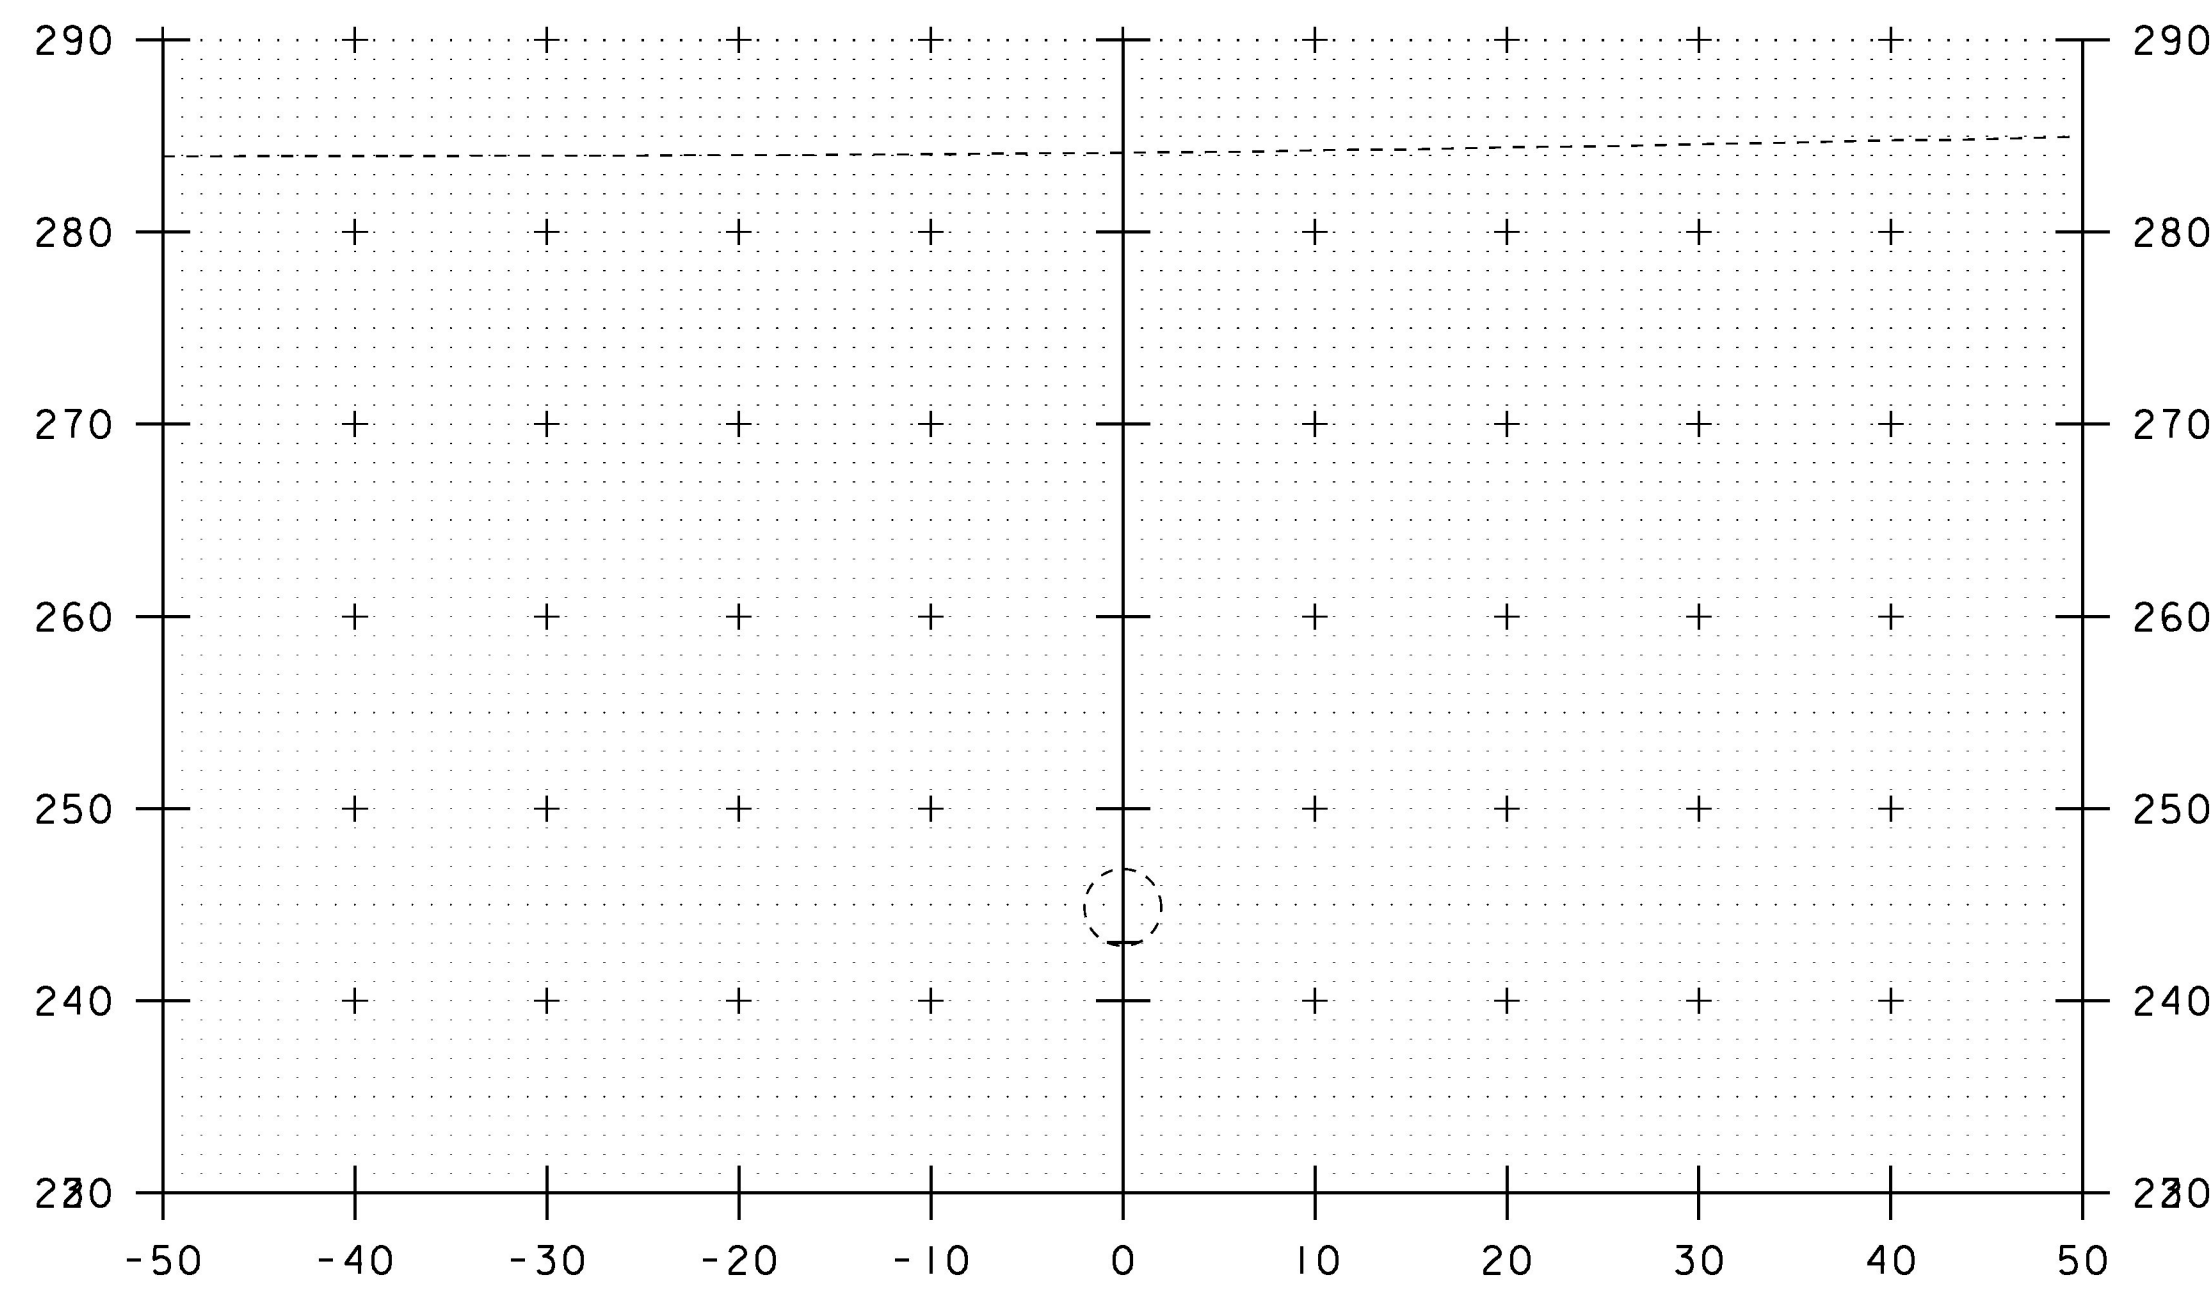

I+20

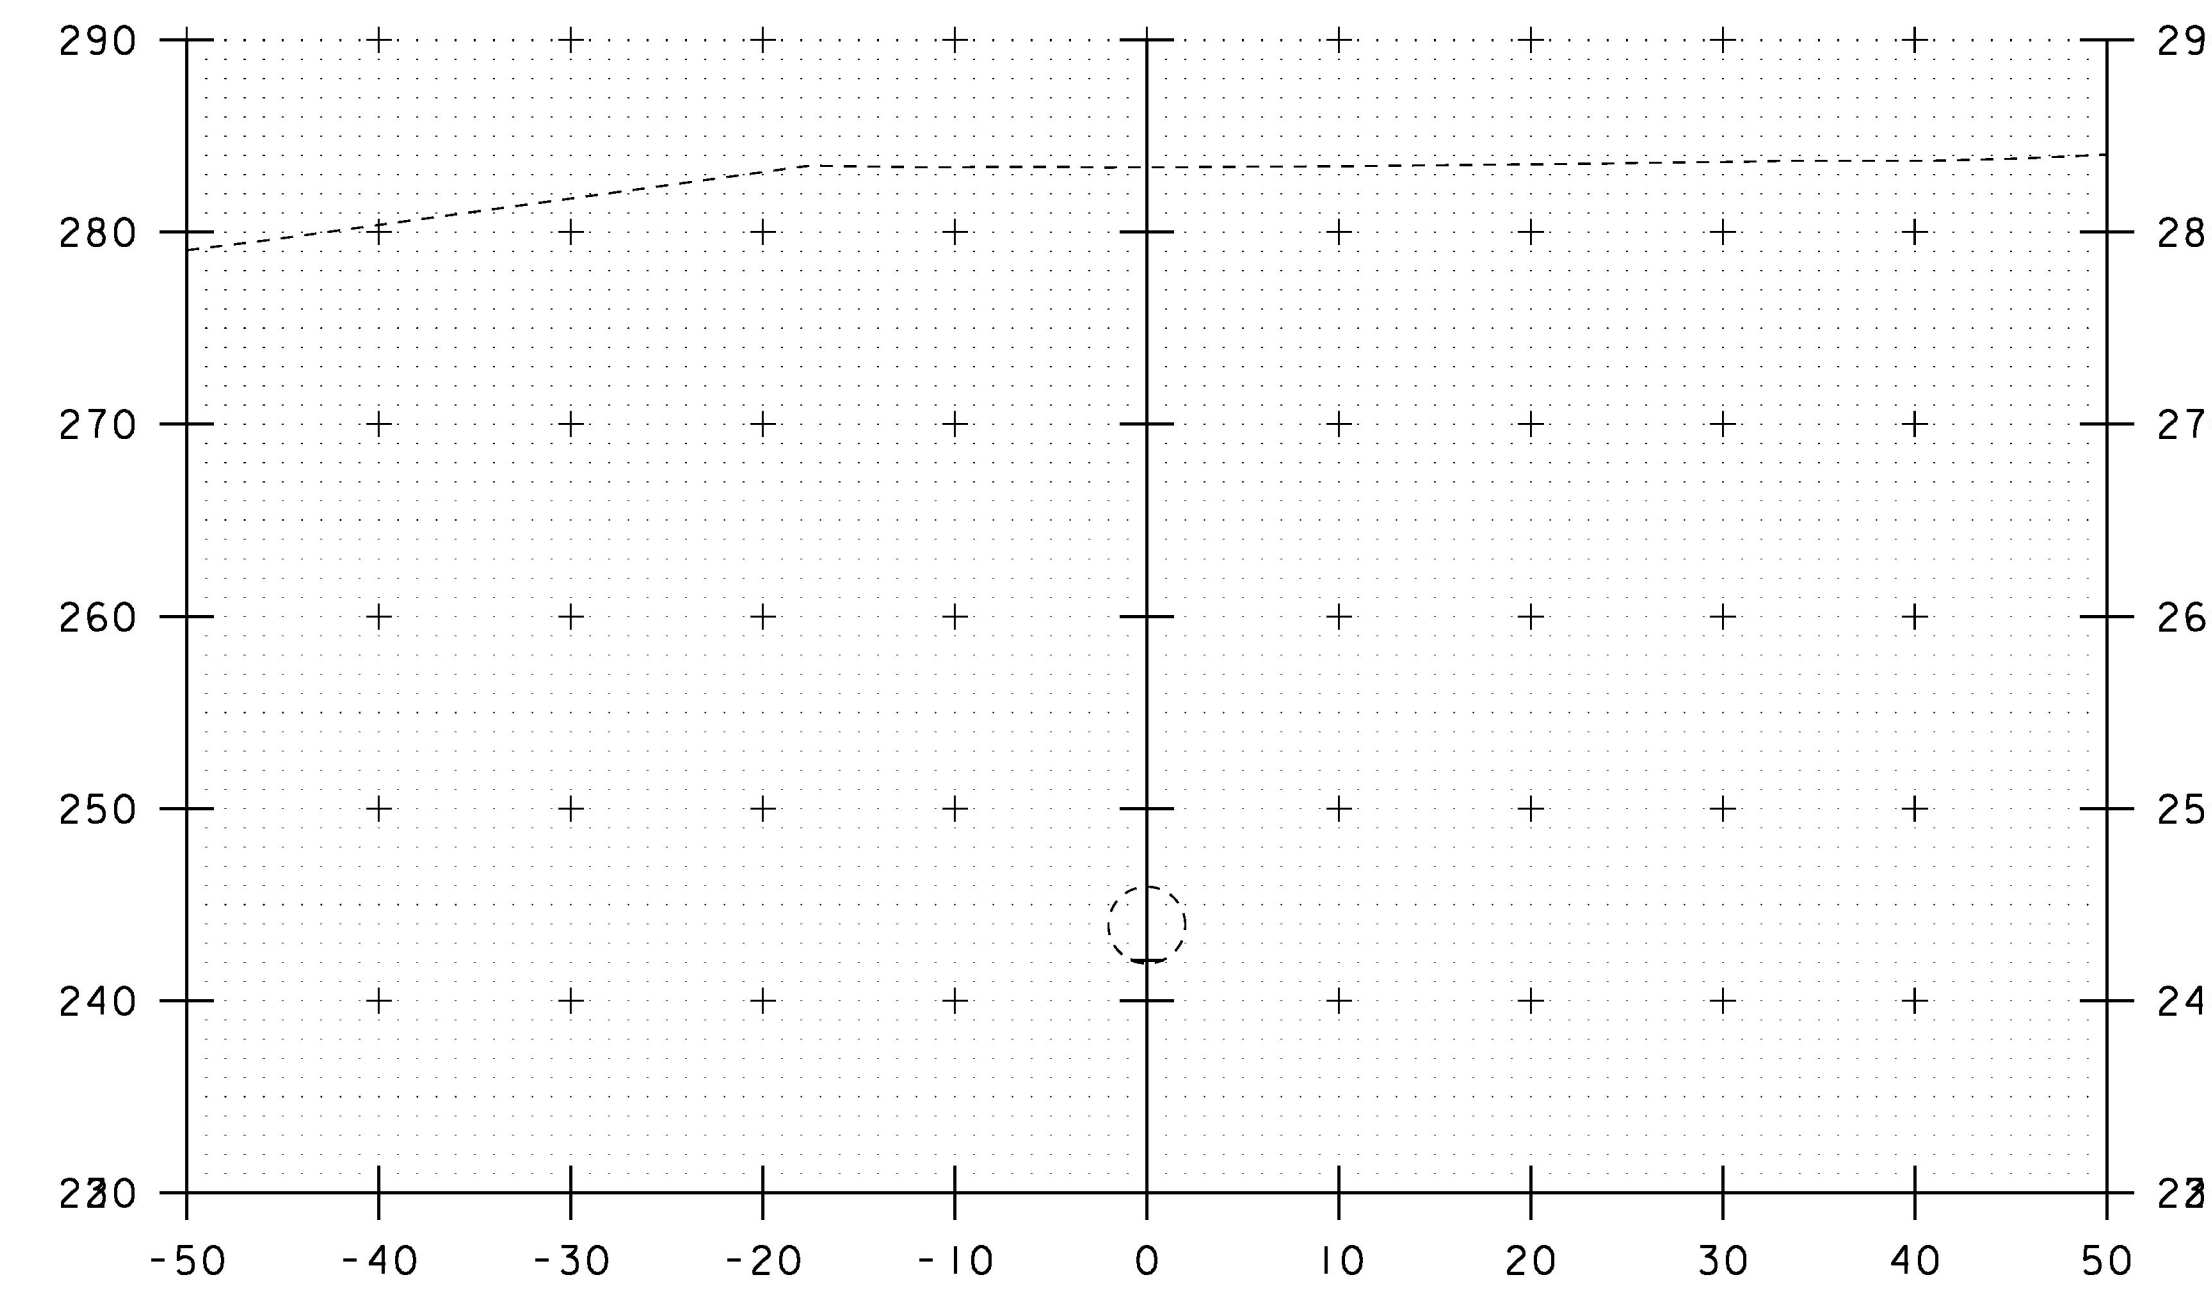

I+40

SCALE IN FEET

STA. I+20 TO STA. I+50

PROJECT NAME:	SOUTH BURLINGTON	PLOT DATE:	27-APR-2017
PROJECT NUMBER:	IM SCRP(21)	DRAWN BY:	C. LEACH
FILE NAME:	I6d064/Design/nul.dgn	CHECKED BY:	A. AGRAWAL
PROJECT LEADER:	K. UPMAL	SHEET	22 OF 30
DESIGNED BY:	C. LEACH	PIPE CROSS SECTION SHEET	4