




2+40

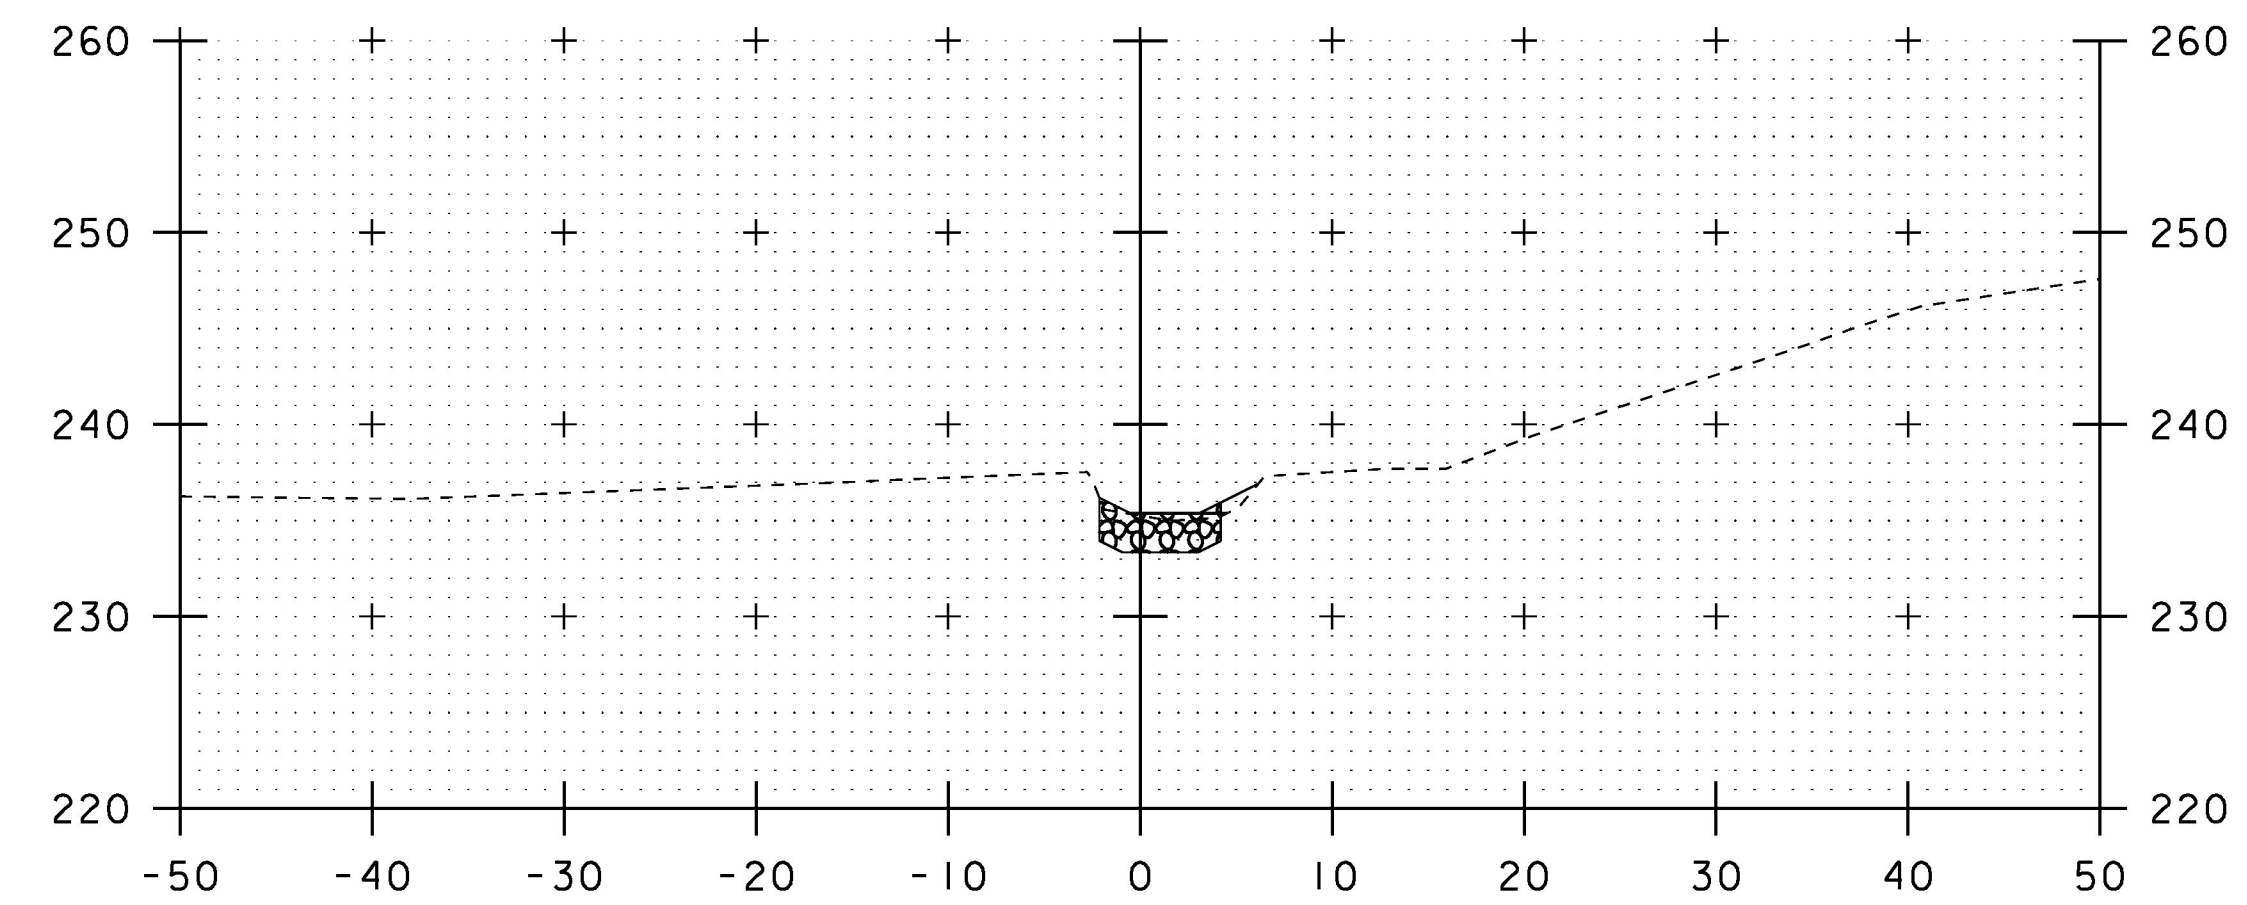

2+60

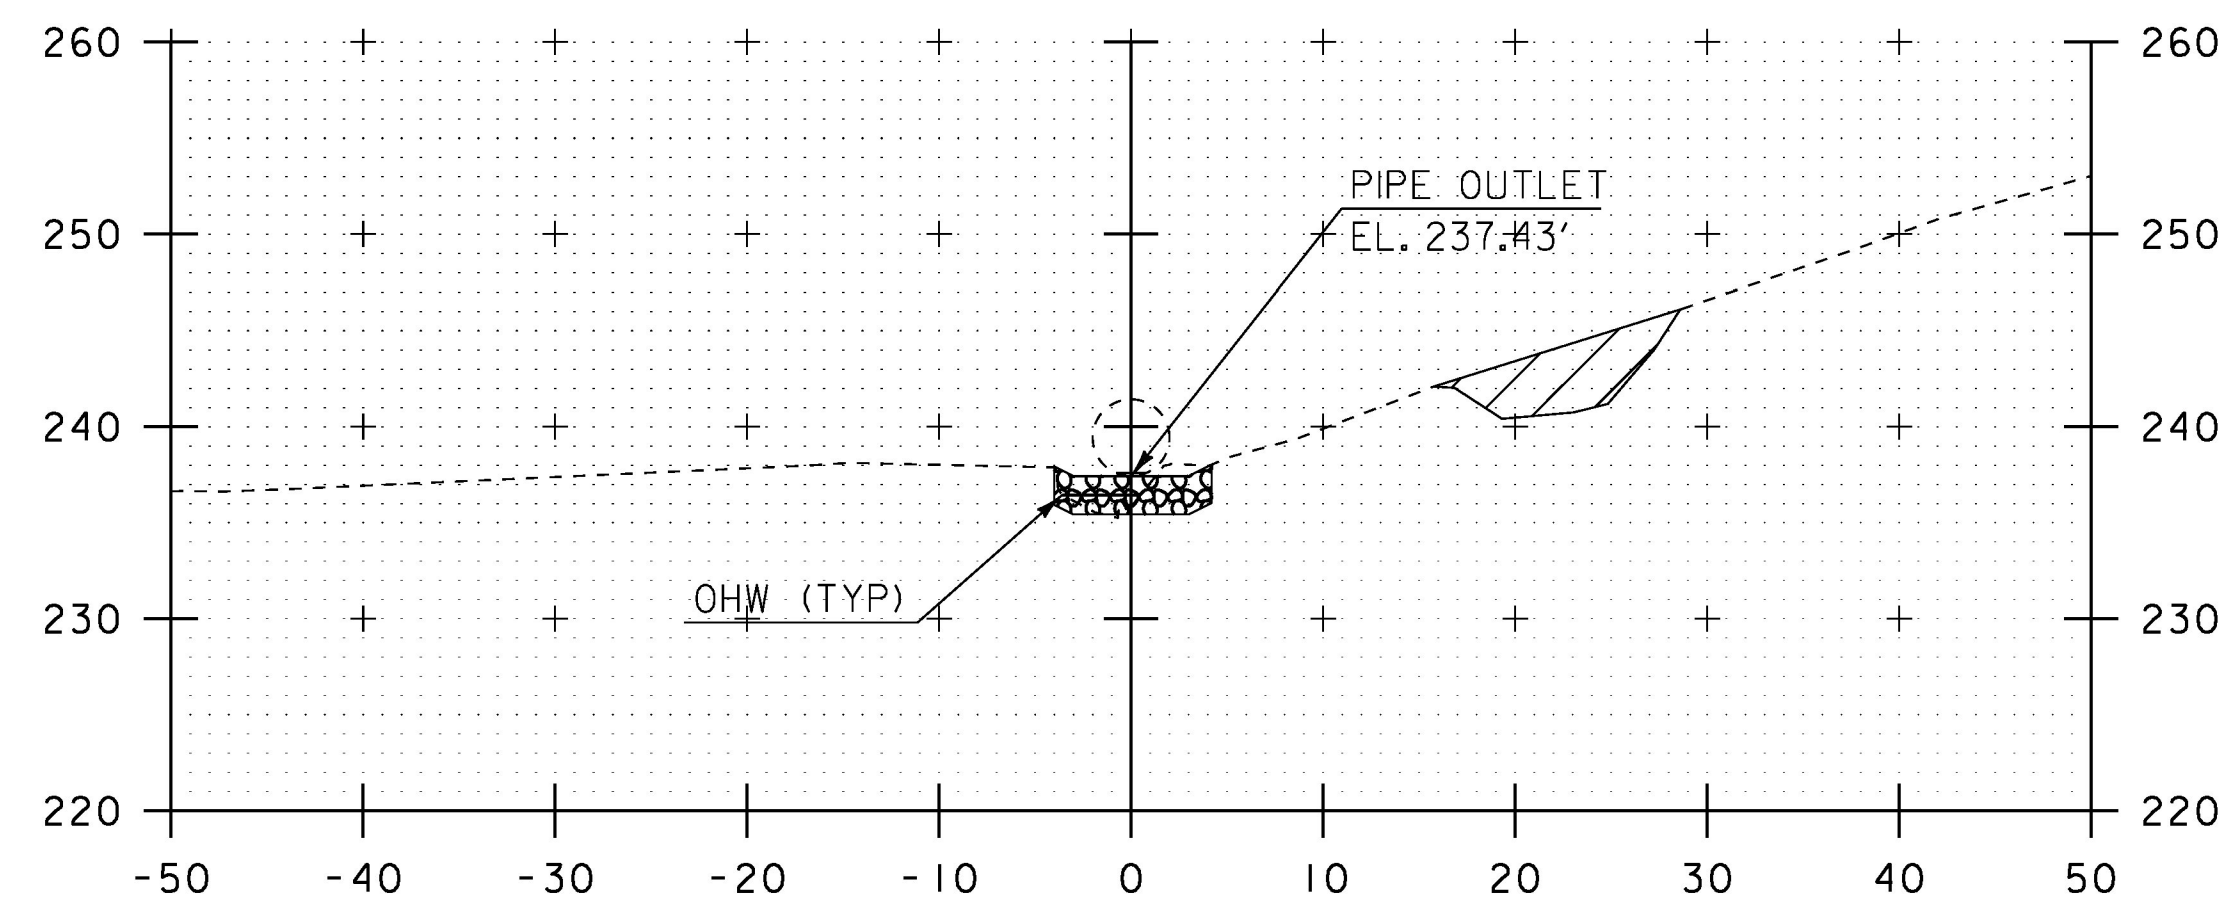

2+39.57  
PIPE OUTLET

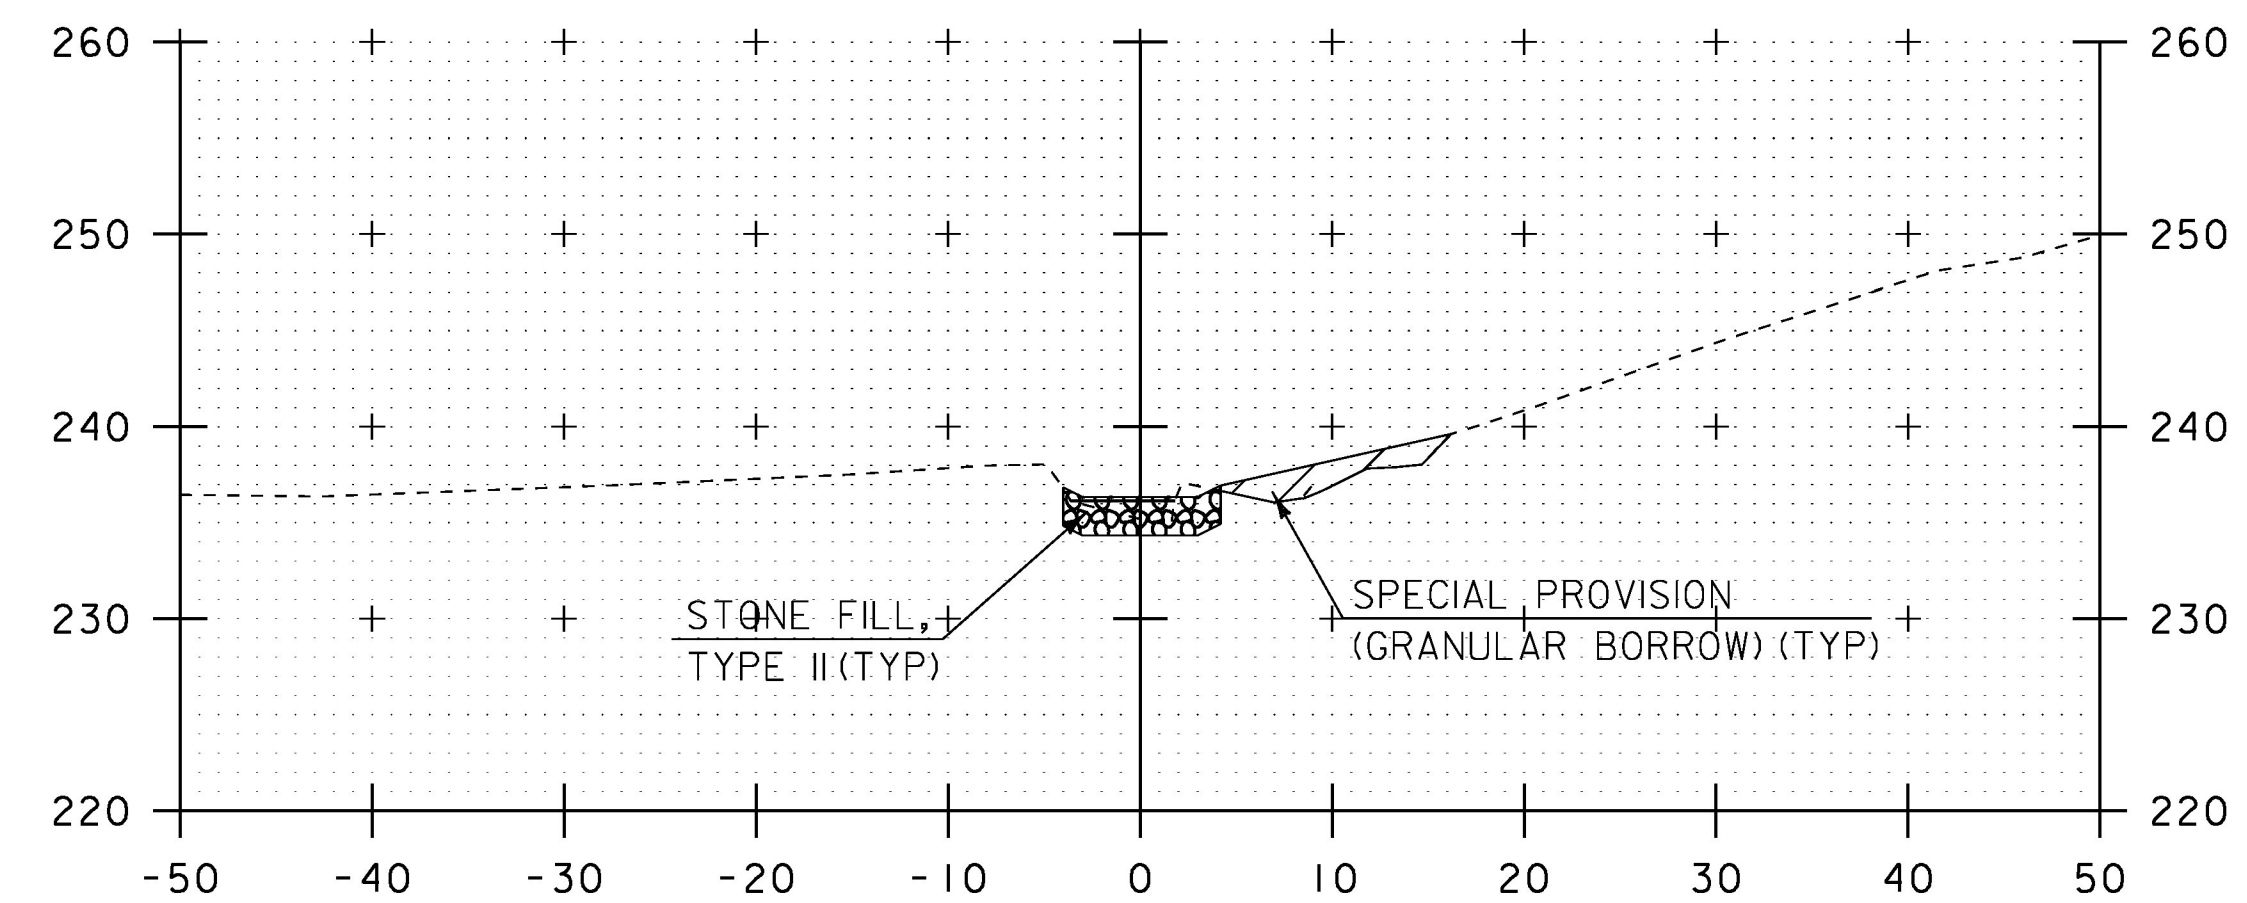

2+50

SCALE IN FEET

STA. 2+40 TO STA. 2+60

PROJECT NAME: SOUTH BURLINGTON	
PROJECT NUMBER: IM SCR(21)	
FILE NAME: I6d064/Design/nul.dgn	PLOT DATE: 27-APR-2017
PROJECT LEADER: K. UPMAL	DRAWN BY: C. LEACH
DESIGNED BY: C. LEACH	CHECKED BY: A. AGRAWAL
PIPE CROSS SECTION SHEET 7	SHEET 25 OF 30