


63+00

\* REPAIRS BY OPERATIONS ELIMINATED  
EMBANKMENT IRREGULARITIES, THEREFORE  
GRANULAR BORROW ITEM NOT USED

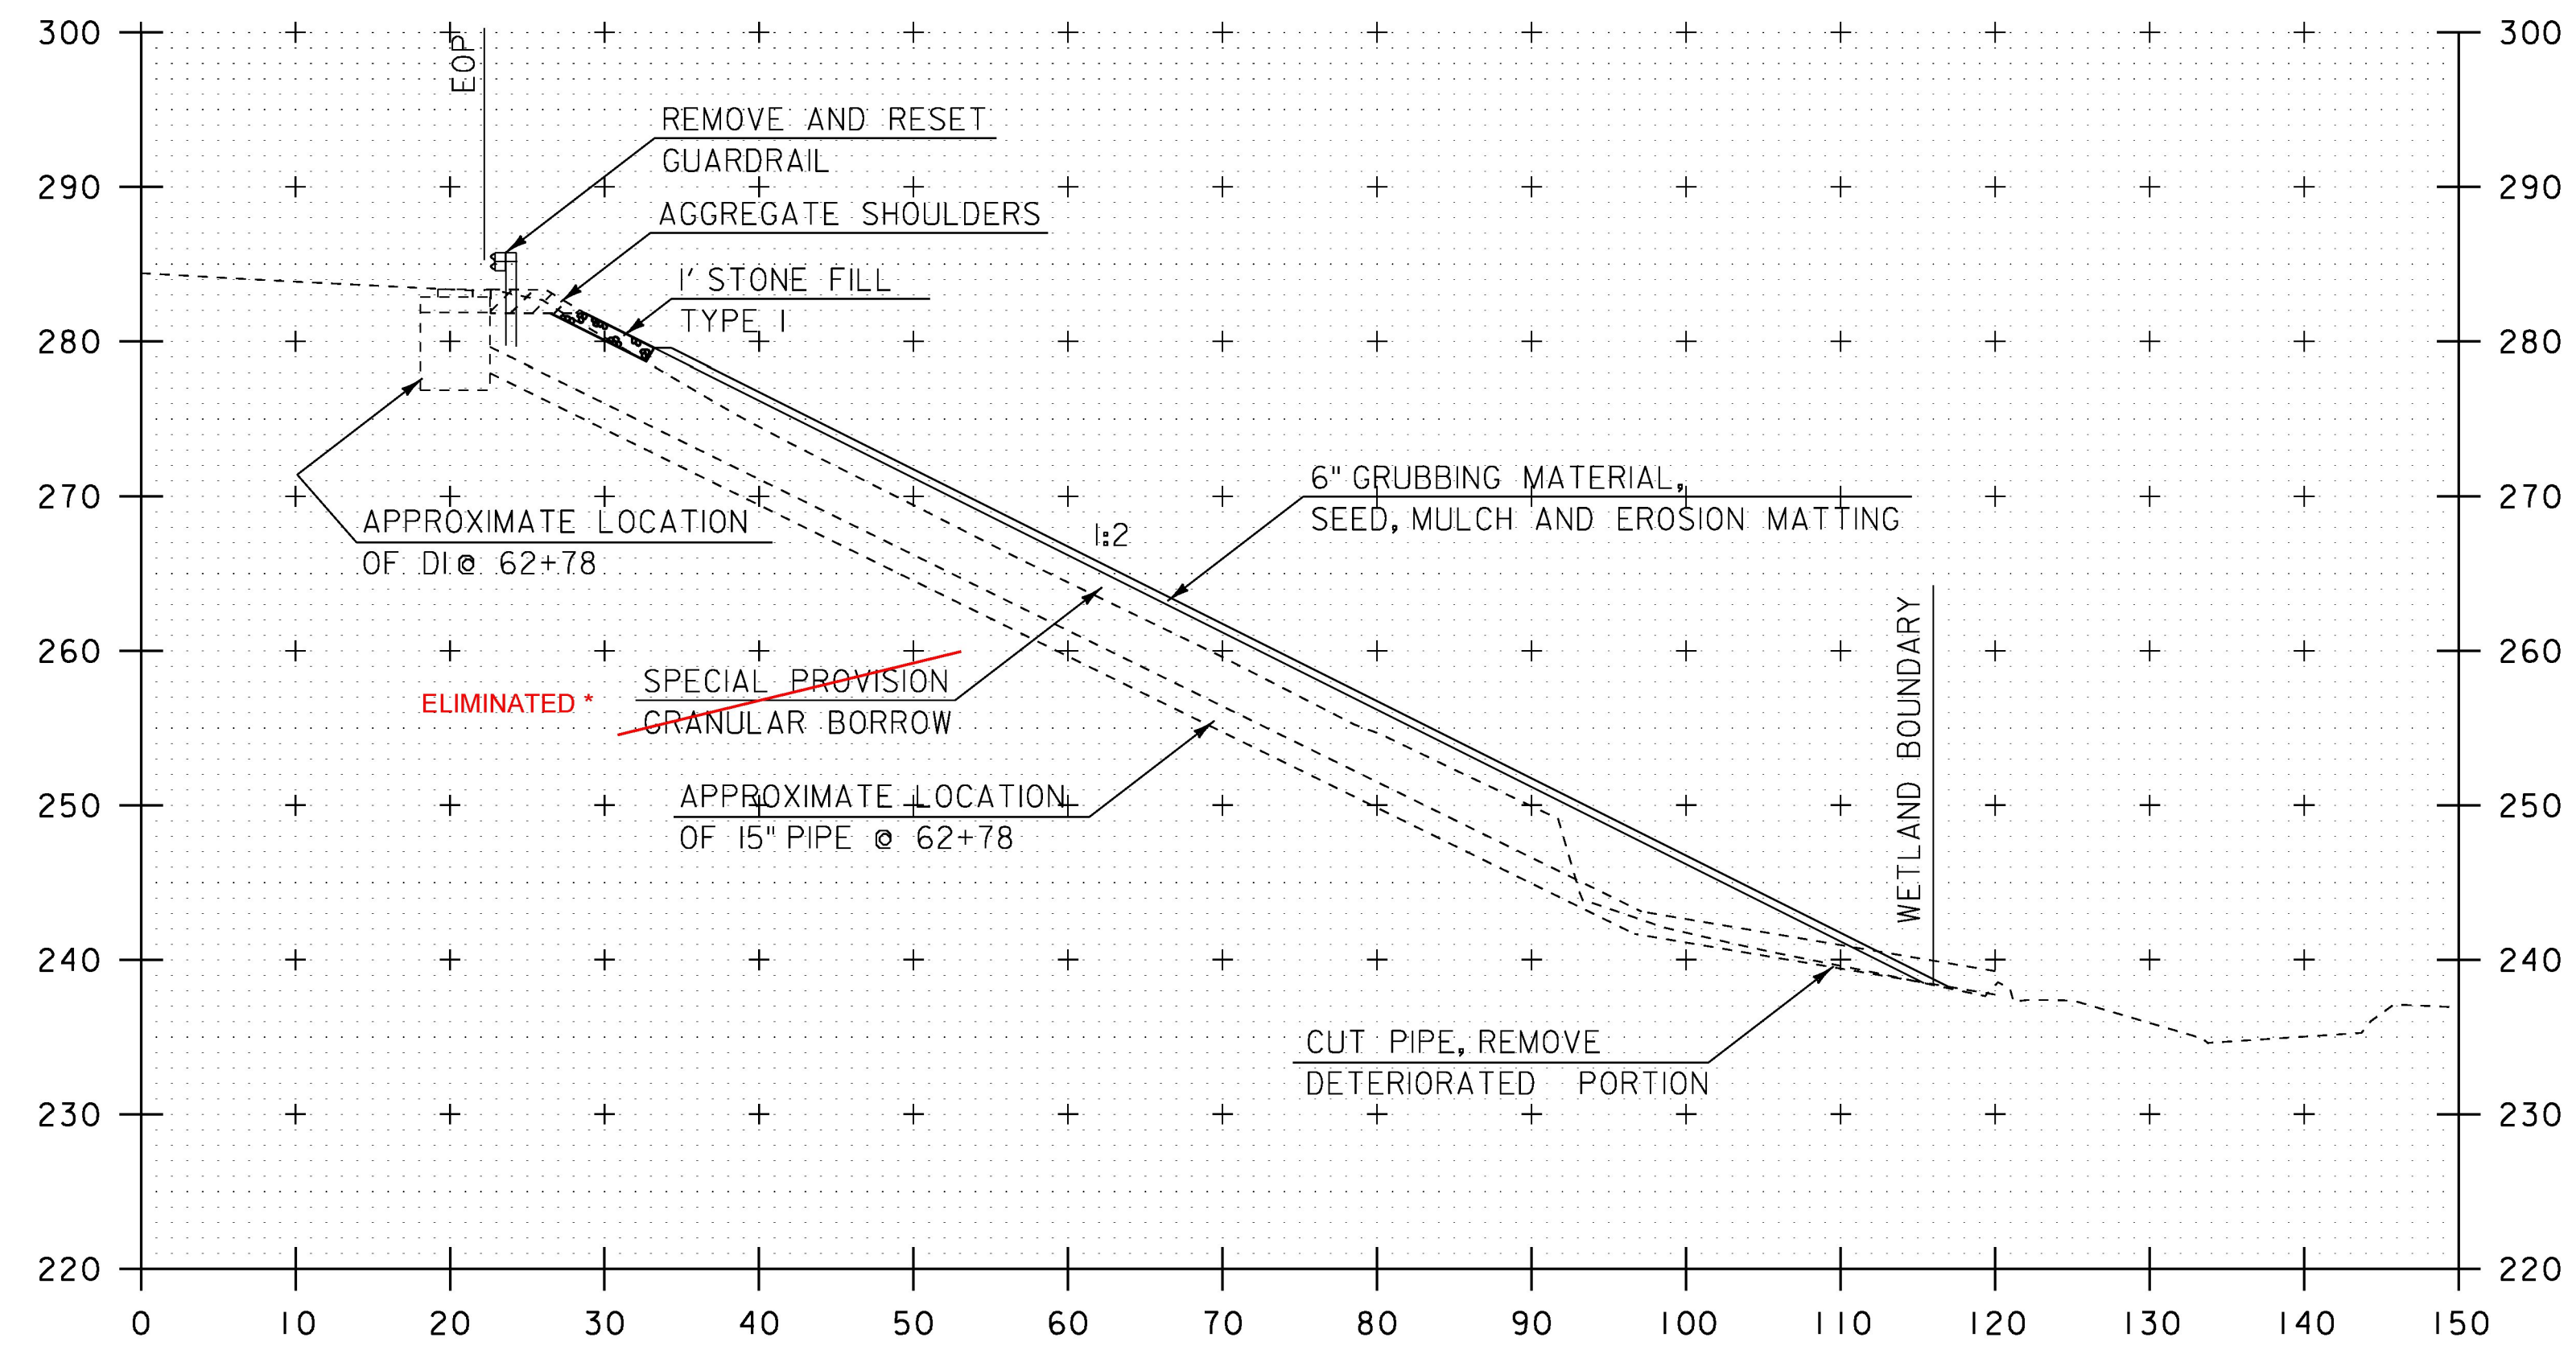

62+75

SCALE IN FEET STA. 62+75 TO STA. 63+00

PROJECT NAME: SOUTH BURLINGTON	
PROJECT NUMBER: IM SCRP(21)	
FILE NAME: I6d064/Design/xs.dgn	PLOT DATE: 27-APR-2017
PROJECT LEADER: K. UPMAL	DRAWN BY: C. LEACH
DESIGNED BY: C. LEACH	CHECKED BY: M. BOOKER
SLOPE CROSS SECTION SHEET 1	SHEET 27 OF 30